



WINGWALL 2 - PLAN

SCALE: 3/4" = 1'-0"

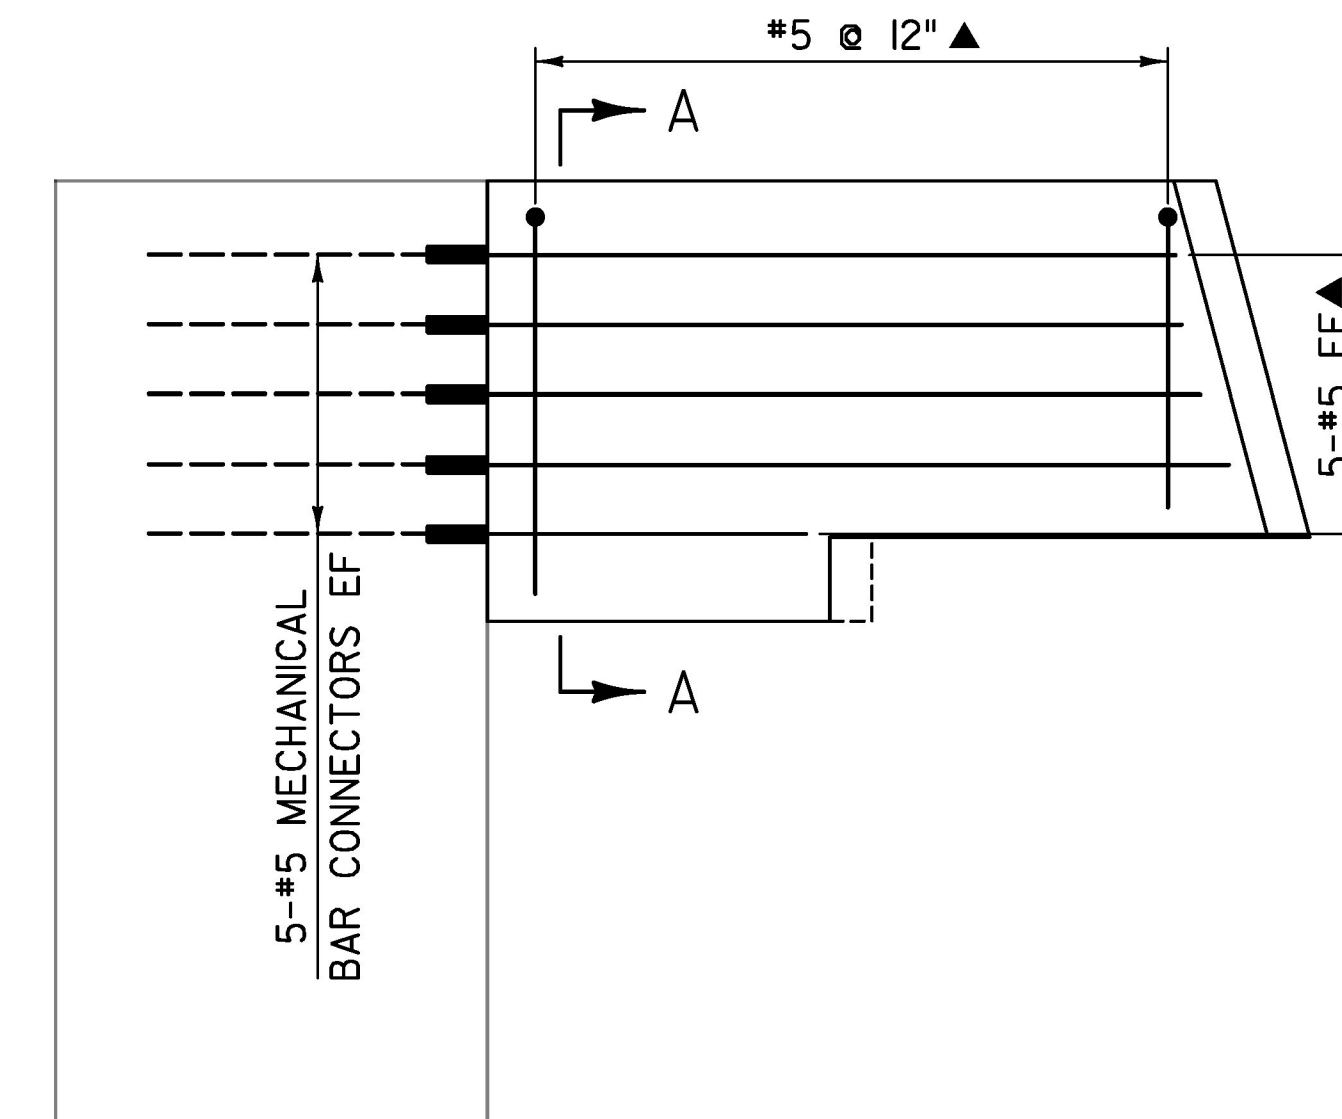


WINGWALL 2 REINFORCEMENT

SCALE: 3/4" = 1'-0"

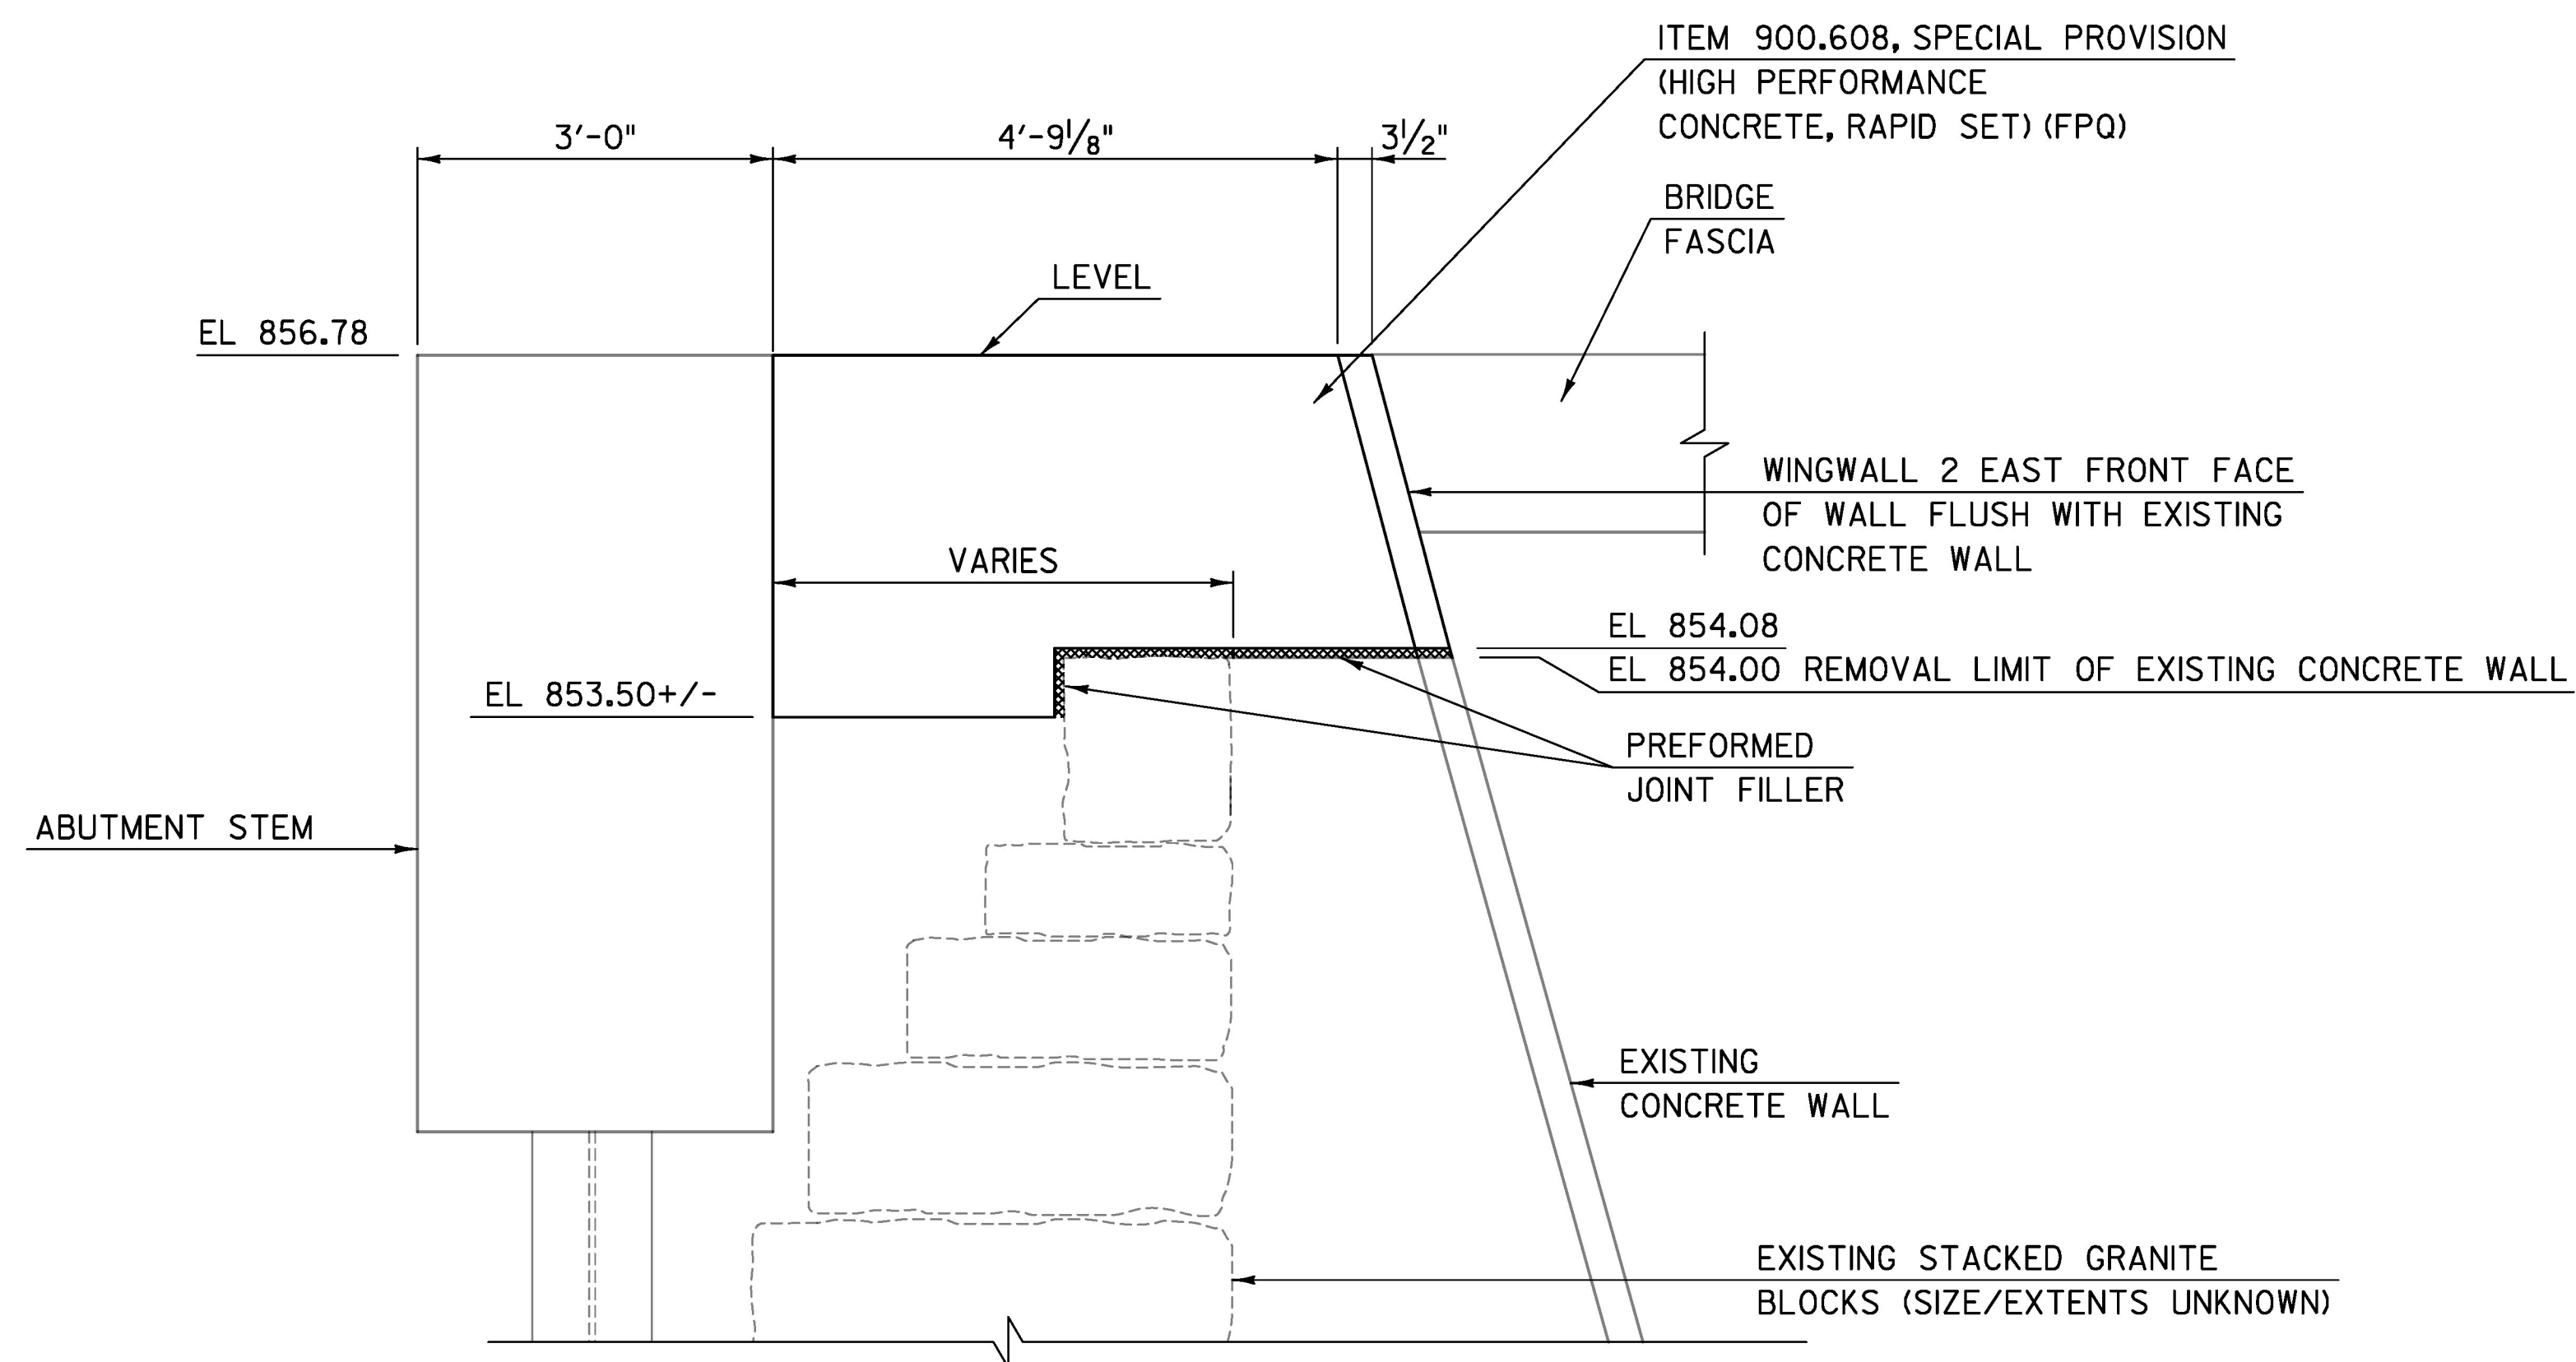

WINGWALL 2 - ELEVATION

SCALE: 3/4" = 1'-0"

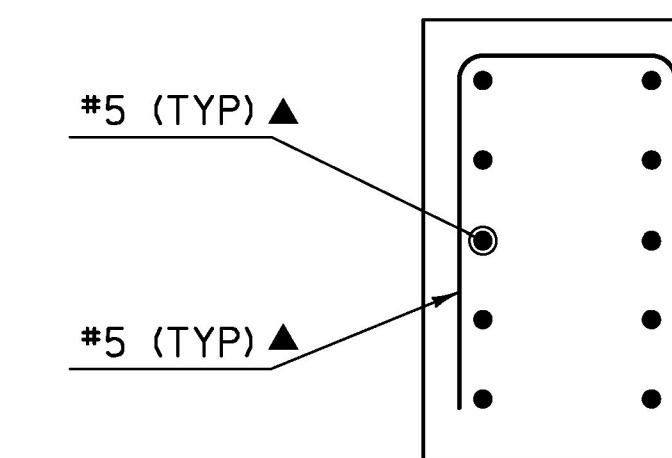

SECTION A-A

SCALE: 3/4" = 1'-0"

NOTE:

- NF = NEAR FACE
- FF = FAR FACE
- EF = EACH FACE
- ▲ = CUT TO FIT IN FIELD

TYLIN INTERNATIONAL	PROJECT NAME: BARTON VILLAGE	PLOT DATE: 7/26/2016
	PROJECT NUMBER: BHF 0286(5)	DRAWN BY: S. MORGAN
	FILE NAME: z12j172sub_4.dgn	CHECKED BY: C. TAYLOR
	DESIGNED BY: B. TOOTHAKER	SHEET 93 OF 110
	WINGWALL NO 2 DETAILS	