




11+63

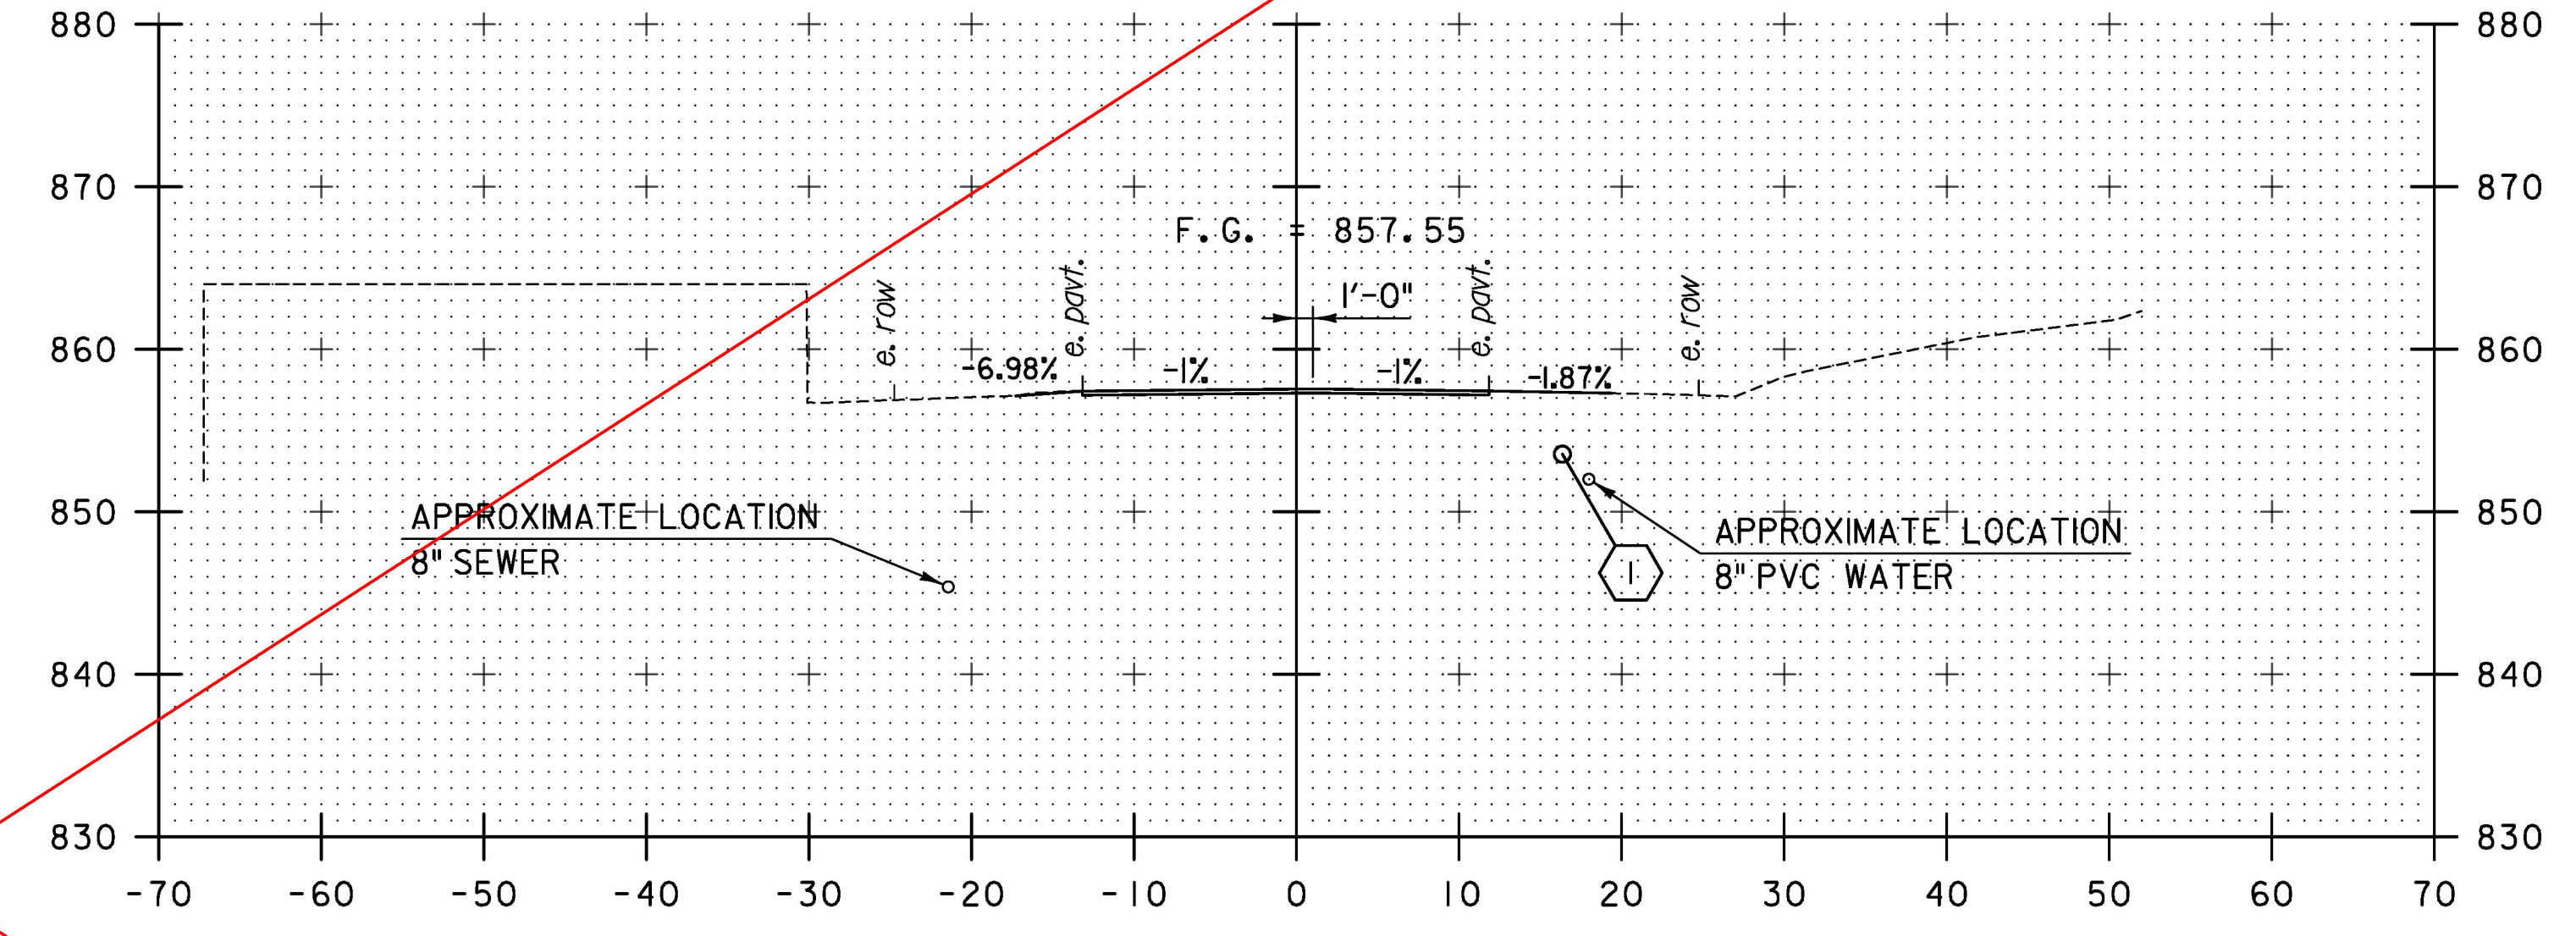

12+00

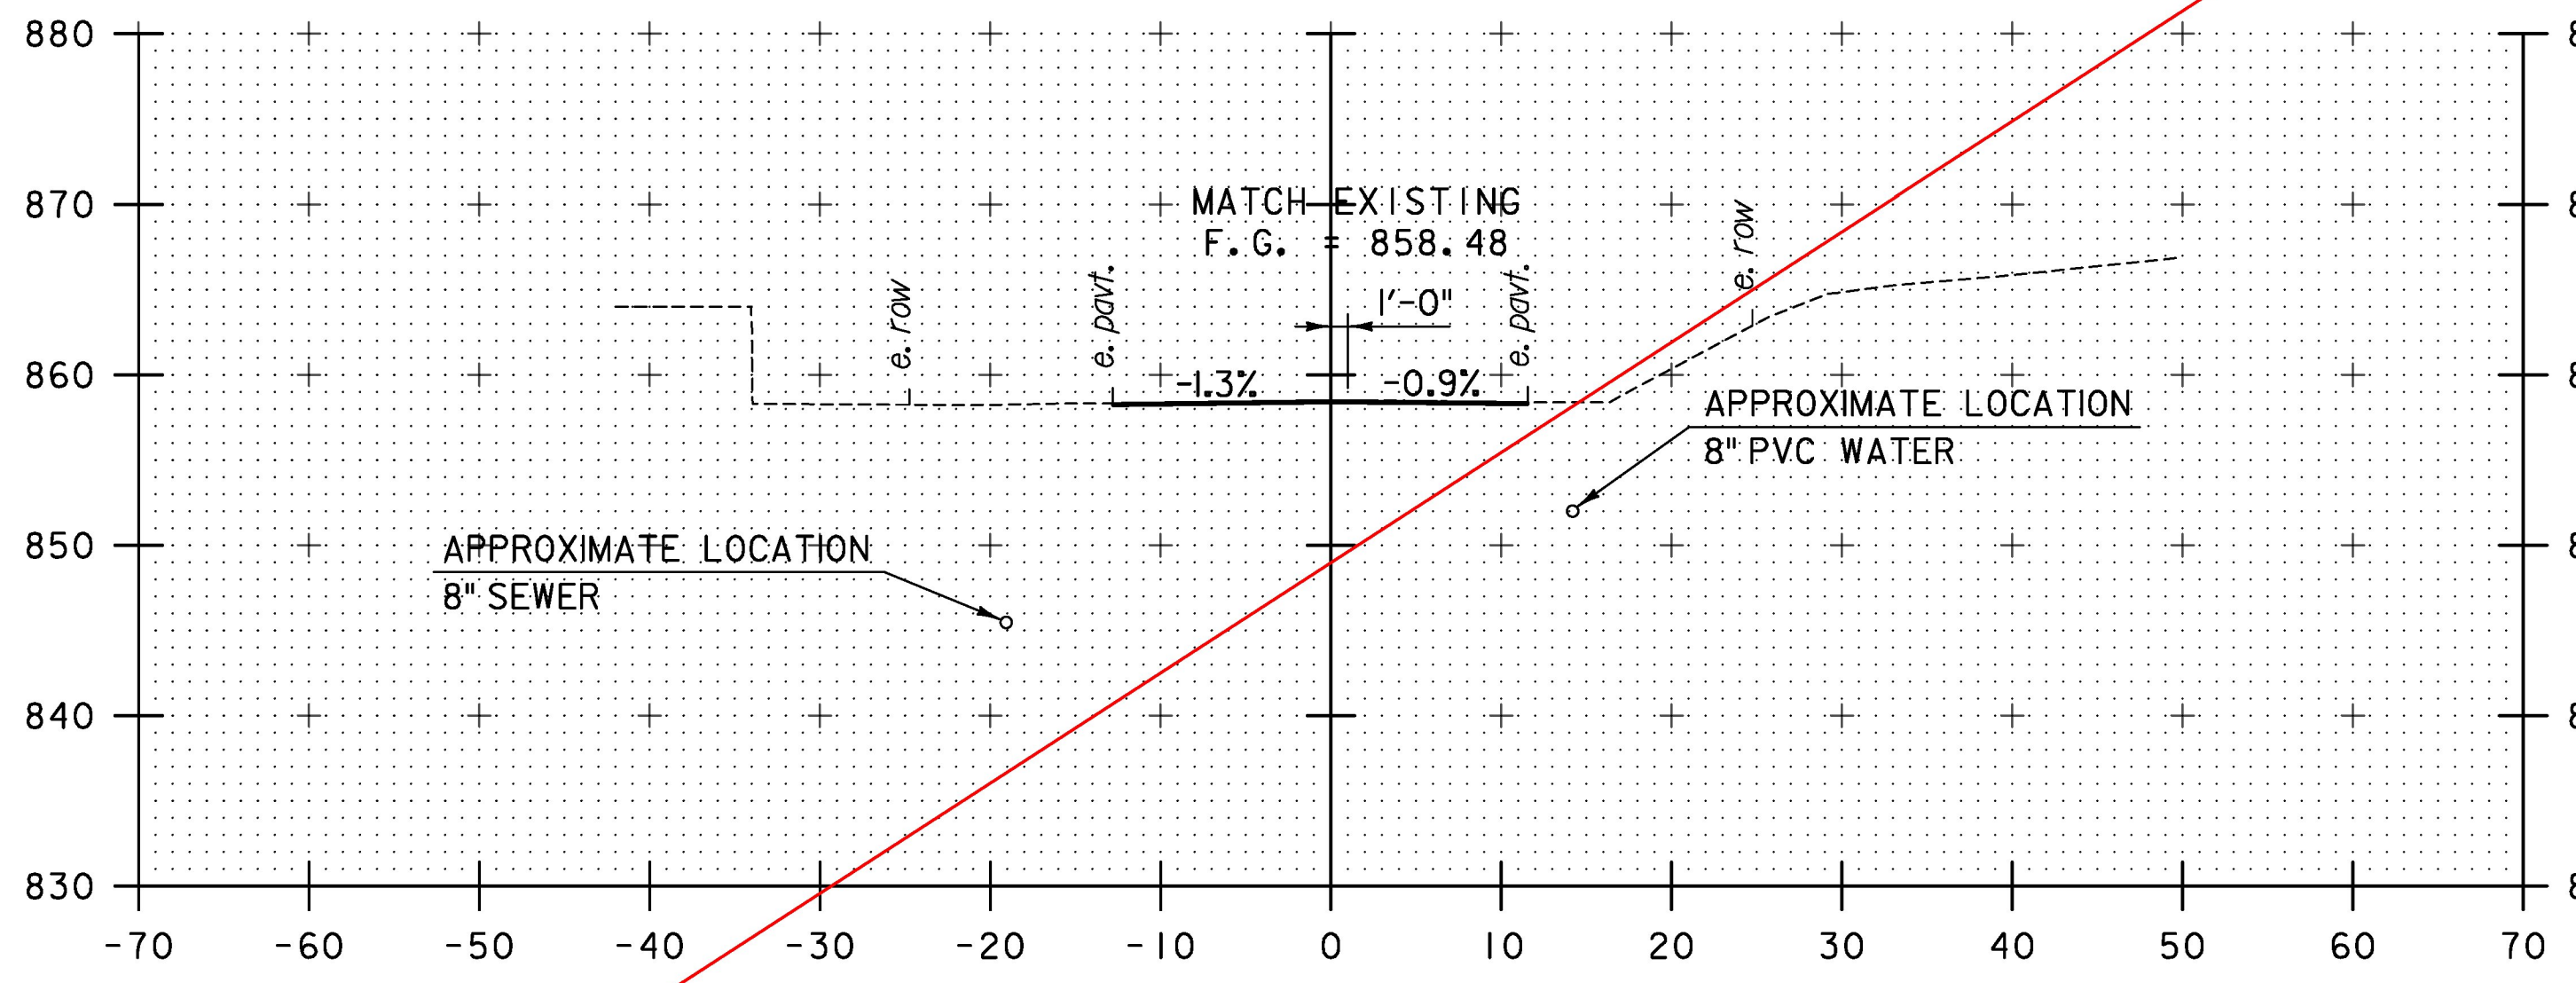

11+50
BEGIN APPROACH

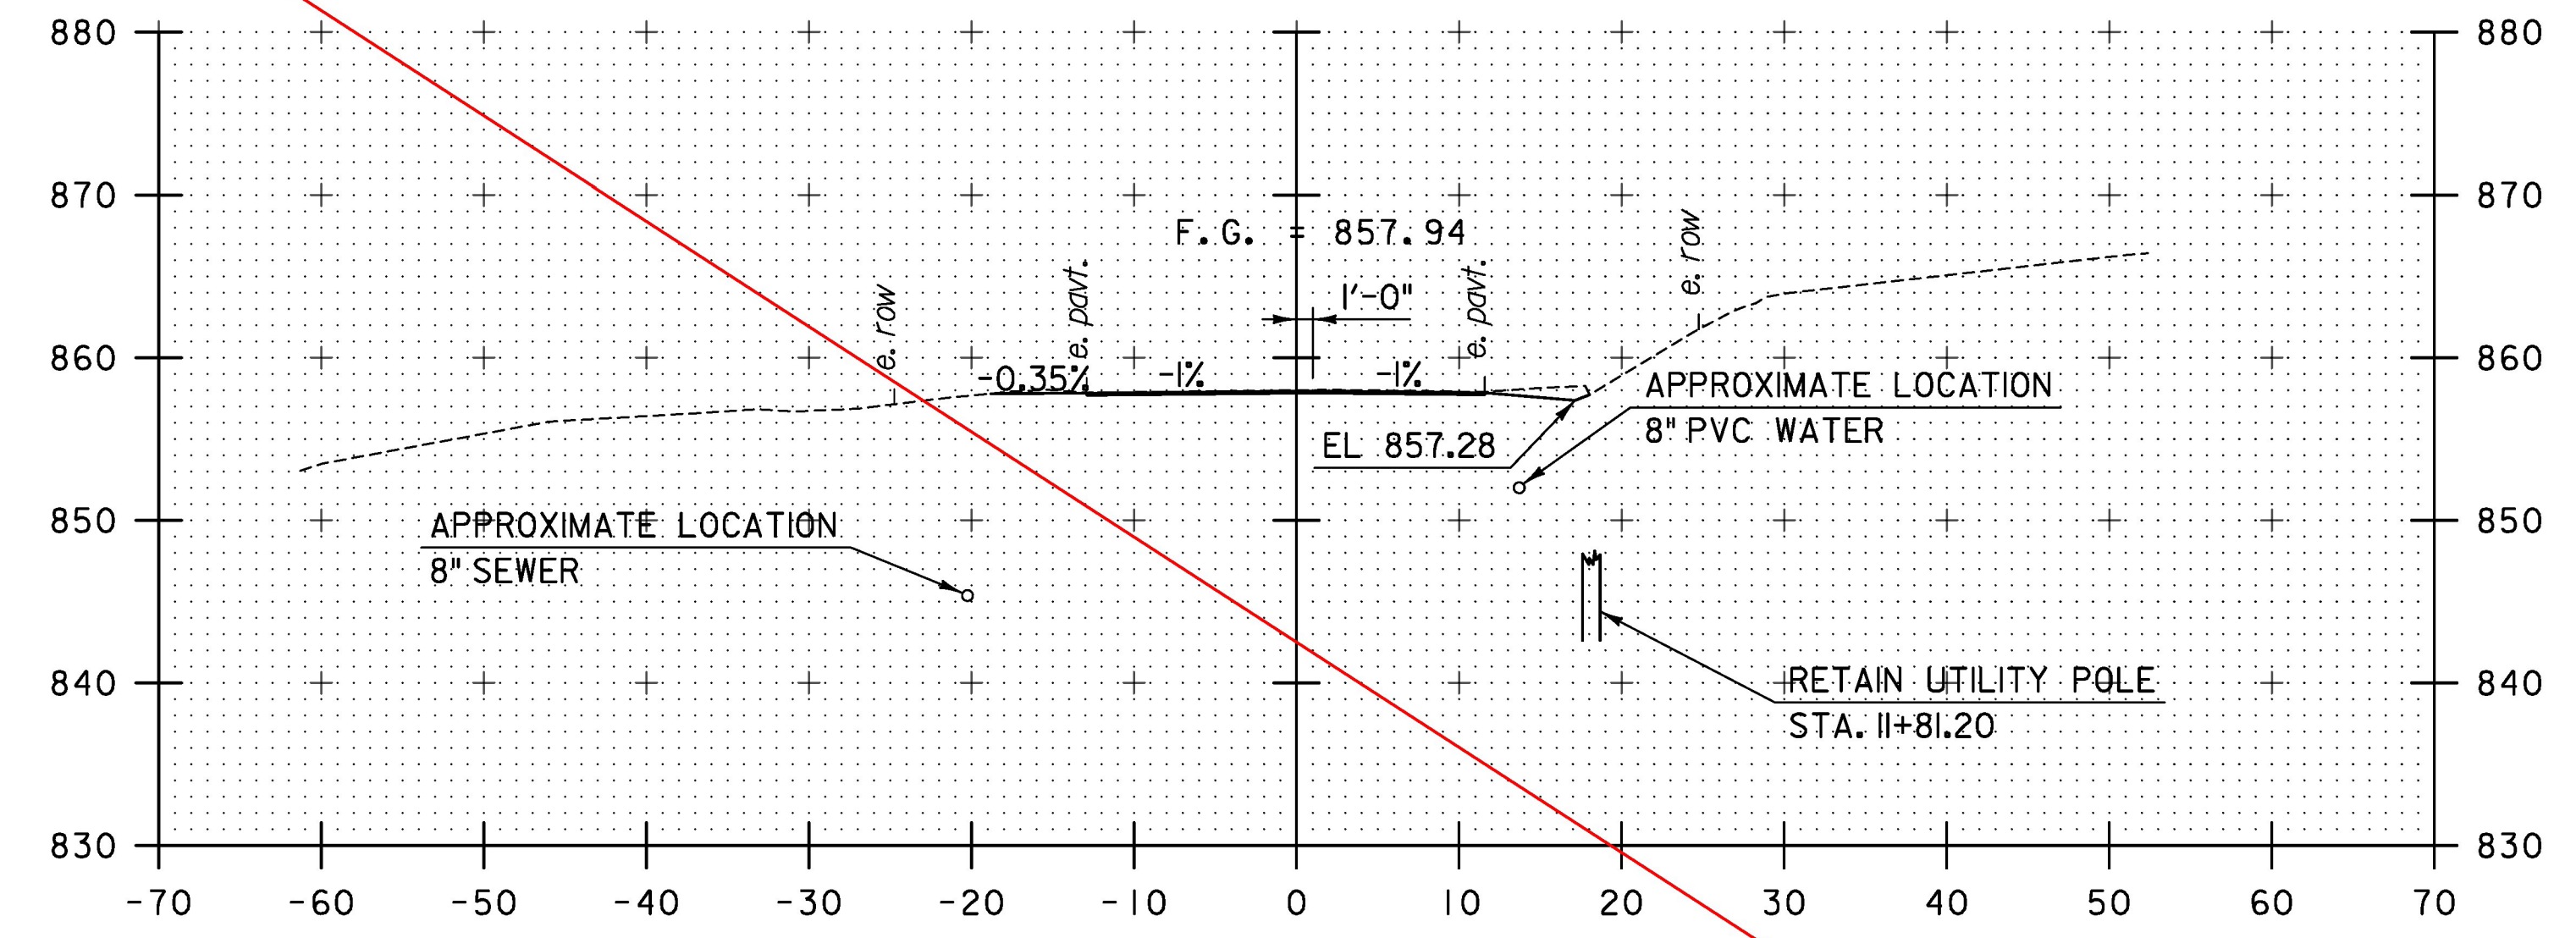

11+75

SEE REVISED SHEET 97A

TYL INTERNATIONAL	PROJECT NAME: BARTON VILLAGE	PLOT DATE: 7/26/2016
	PROJECT NUMBER: BHF 0286(5)	DRAWN BY: B. TOOTHAKER
	FILE NAME: z12j172xsl.dgn PROJECT LEADER: J. OLUND DESIGNED BY: B. TOOTHAKER TH2 CROSS SECTIONS I	CHECKED BY: J. HOWE SHEET 97 OF 110