
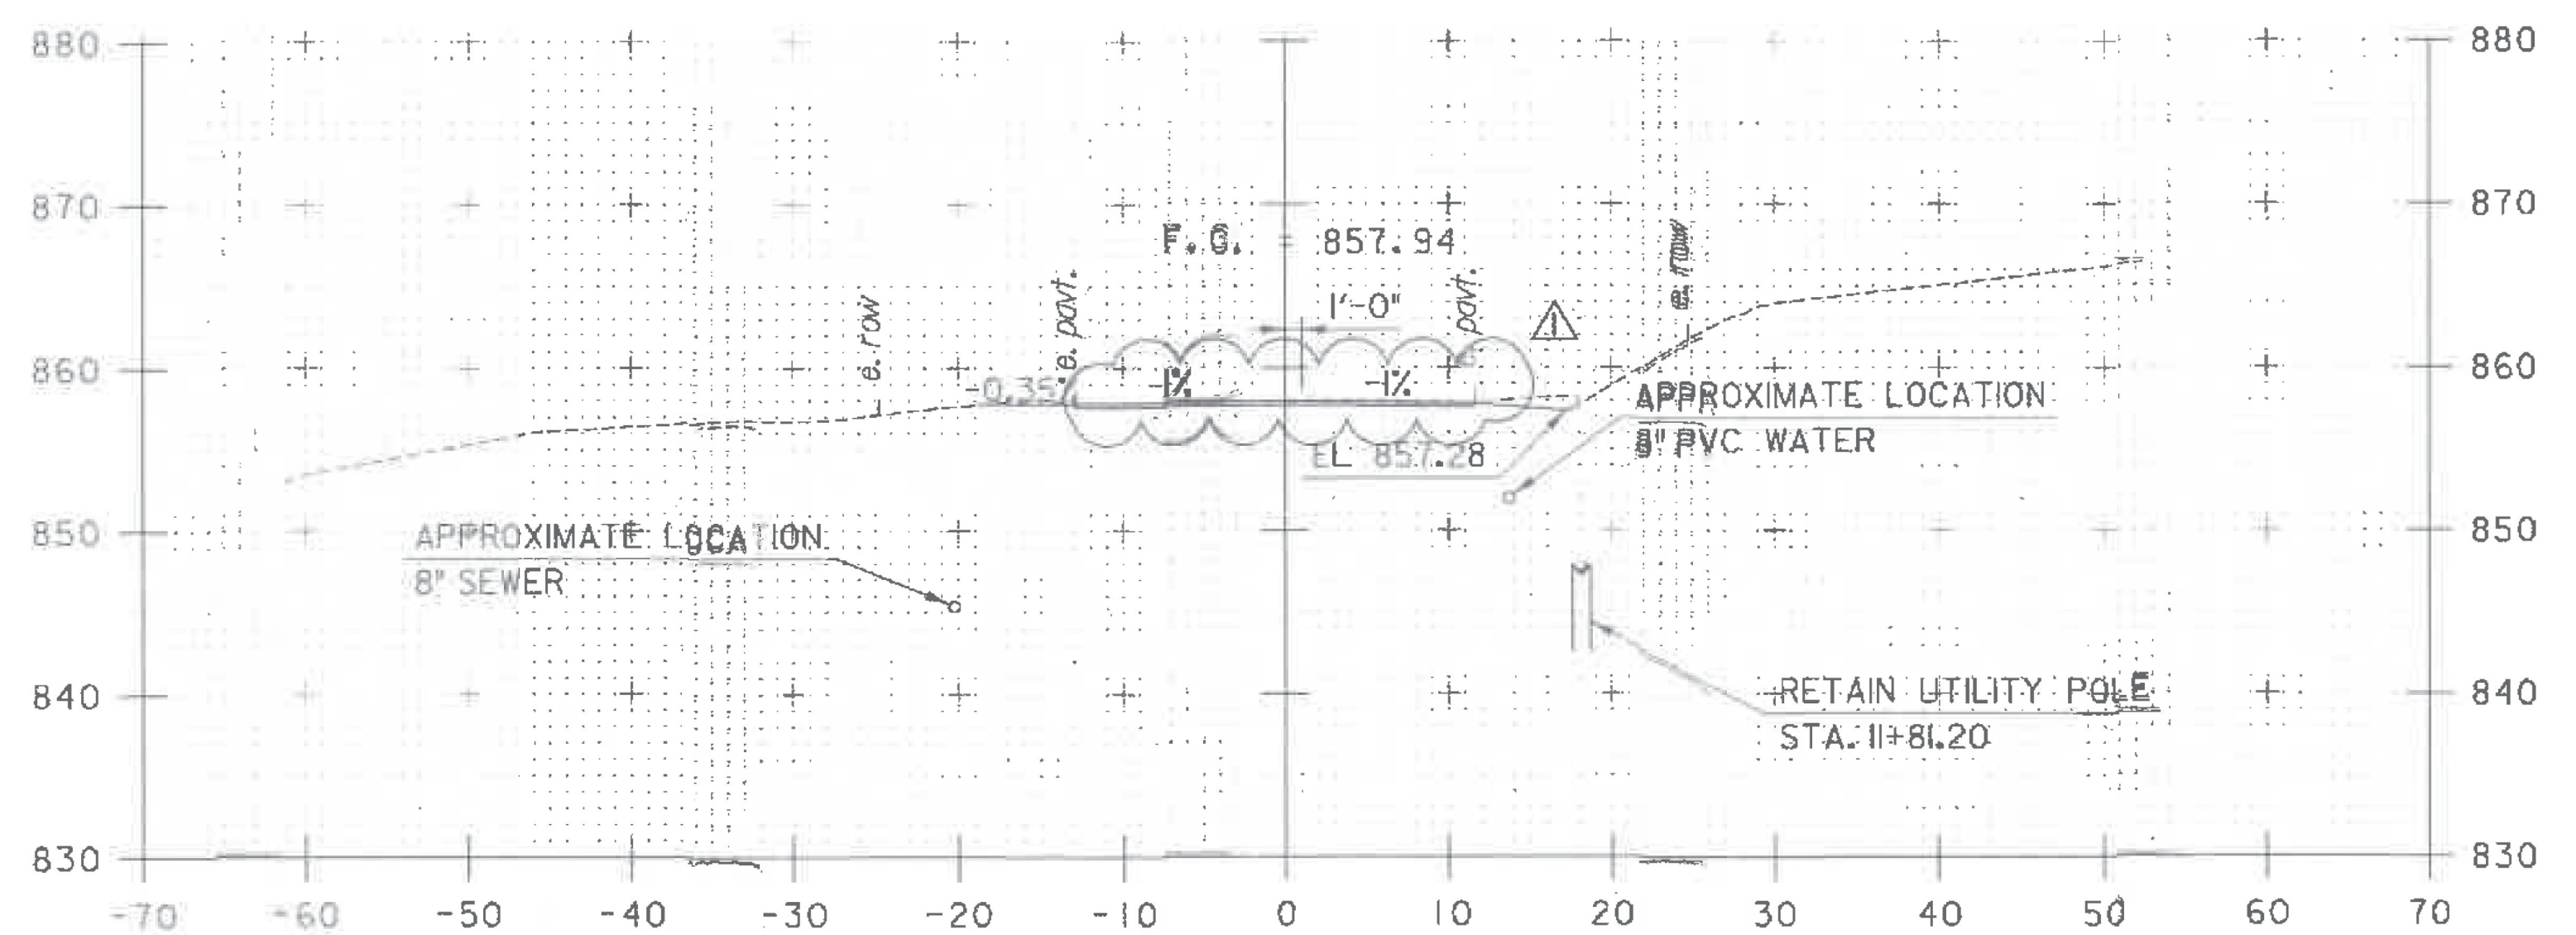


BEGIN PROJECT STA 11+80.00

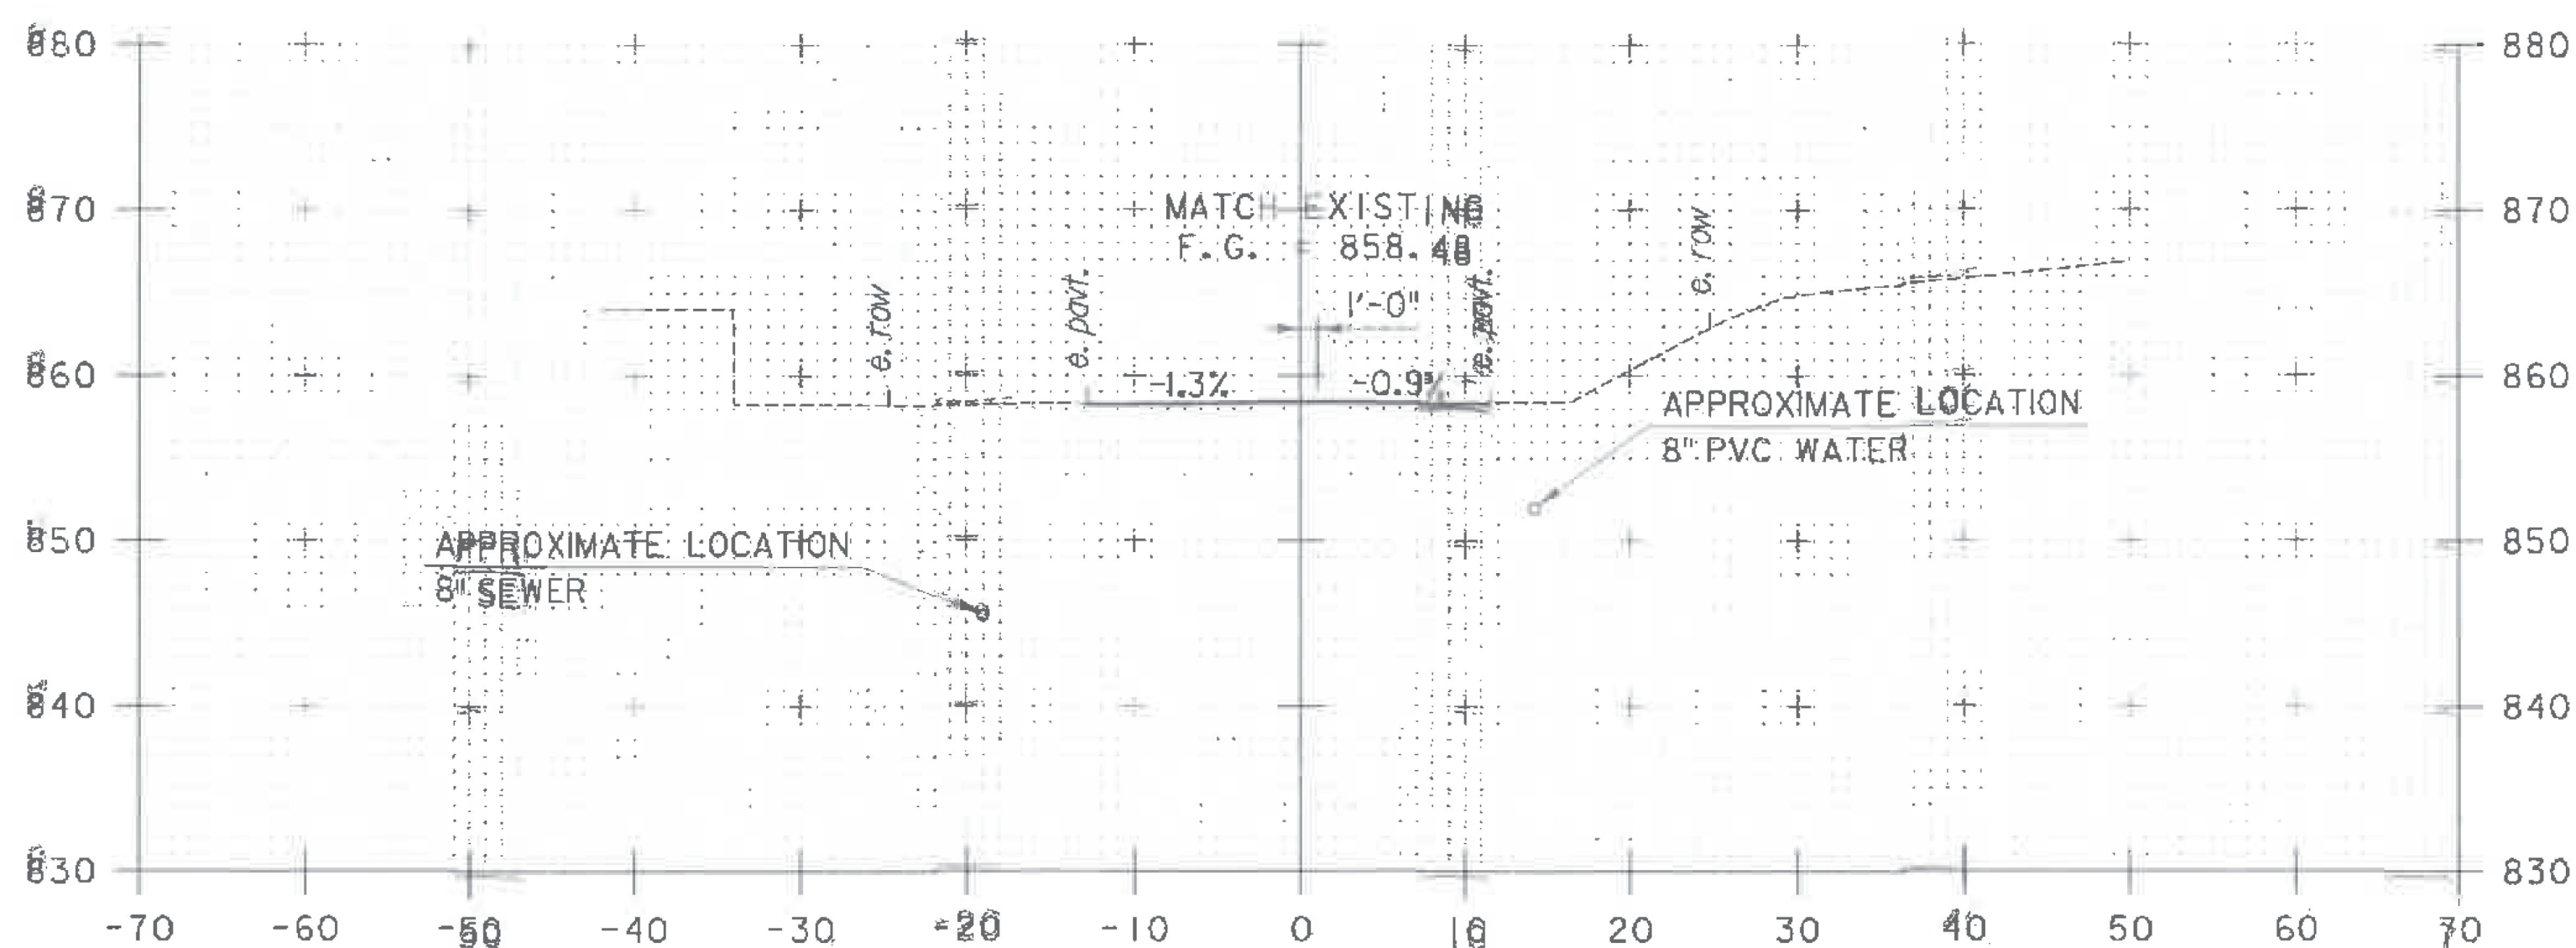

STA. 11+50 TO STA. 12+00

BEGIN APPROACH

PROJECT NAME:	BARTON VILLAGE
PROJECT NUMBER:	BHF 0286(5)
FILE NAME:	z121172xsl.dgn
PROJECT LEADER:	J. OLUND
DESIGNED BY:	B. TOOTHAKER
TH2 CROSS SECTIONS I	
PLOT DATE:	6/29/2017
DRAWN BY:	B. TOOTHAKER
CHECKED BY:	J. HOWE
SHEET	97A OF 110