


1 PRESTRESSED SOLID SLAB TRANSVERSE SECTION  
 F3 1/2" = 1'-0"

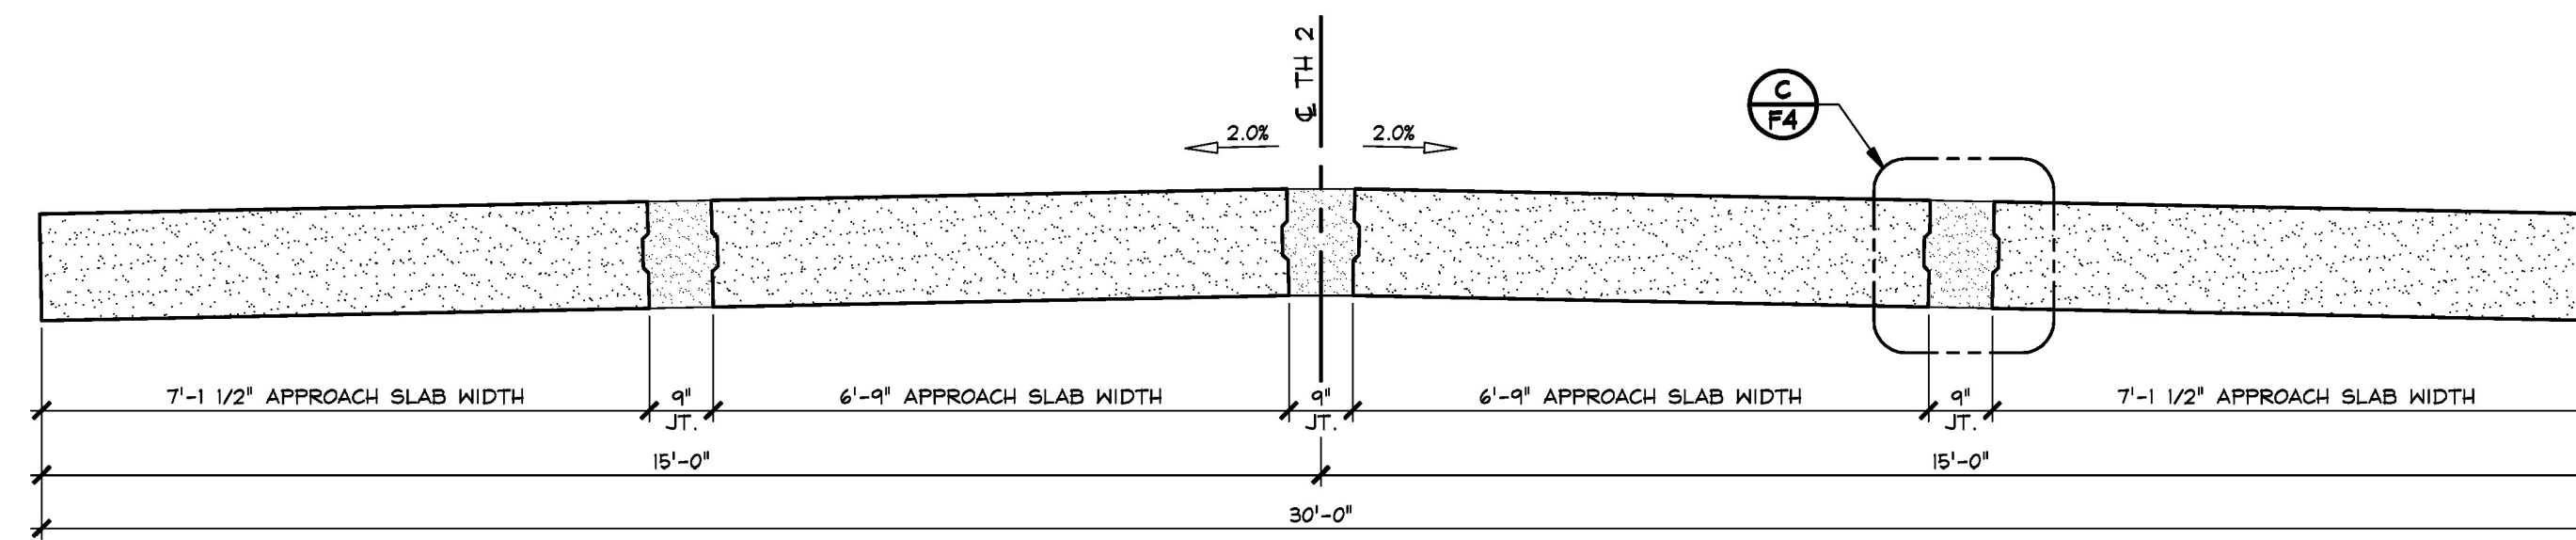

2 PRECAST APPROACH SLAB SECTION  
 F3 1/2" = 1'-0"

F:\VT-Bridges\23498-18 BartonGlover Road\Glover-F3.dwg, 1/23/17 4:57:11 PM

1-3-17 REVISED AS NOTED

Vermont Agency of Transportation  
**RECEIVED**  
 CK'D BY T.Y. Lin International OK'D BY J. Olund  
 January 24, 2017

RESUBMIT No Approved  
 BY D. Bonneau DATE 01/25/17

**T.Y. LIN INTERNATIONAL**  
 THE STAMPED DOCUMENTS ARE HEREBY:  
 -x APPROVED  
 - APPROVED AS NOTED  
 - REVISE AND RESUBMIT  
 SEE TRANSMITTAL FOR ADDITIONAL INFORMATION AS APPLICABLE.  
 THIS REVIEW IS FOR GENERAL CONFORMANCE WITH DESIGN CONCEPT ONLY. ANY DEVIATION FROM THE PLANS OR SPECIFICATIONS NOT CLEARLY NOTED BY THE CONTRACTOR HAS NOT BEEN REVIEWED. REVIEW BY THE ENGINEER SHALL NOT RELIEVE THE CONTRACTOR OF THE CONTRACTUAL RESPONSIBILITY FOR ANY ERRORS OR DEVIATION FROM THE CONTRACT REQUIREMENTS.  
 JOSH OLUND January 25, 2017  
 REVIEWER DATE

APPROVAL STAMP:	<b>J.P. CARRARA &amp; SONS INC.</b> Precast & Prestress Manufacturer 2464 GAGE ST., MIDDLEBURY, VERMONT 05750 Phone: (802)388-6361 Fax: (802)388-9010		<b>J.P. SICARD, INC.</b> CONTRACTOR BARTON, VERMONT	
	STATE OF VERMONT AGENCY OF TRANSPORTATION COUNTY OF ORLEANS		DATE: NOV. 18, 2016	
	VILLAGE OF BARTON TH 2 (GLOVER ROAD), RURAL MAJOR COLLECTOR BRIDGE NO.: 20 PROJECT NO.: BHF 0286(5)		SCALE: NOTED	
	TRANSVERSE SECTIONS		CHKD: A.S. DFTM: B.L. JOB NO: 23498-016 DWG. NO: <b>F3</b> GLOVER ROAD	