




1 DIMENSIONAL PLAN VIEW IN FORM  
ABI  
3/8" = 1'-0"

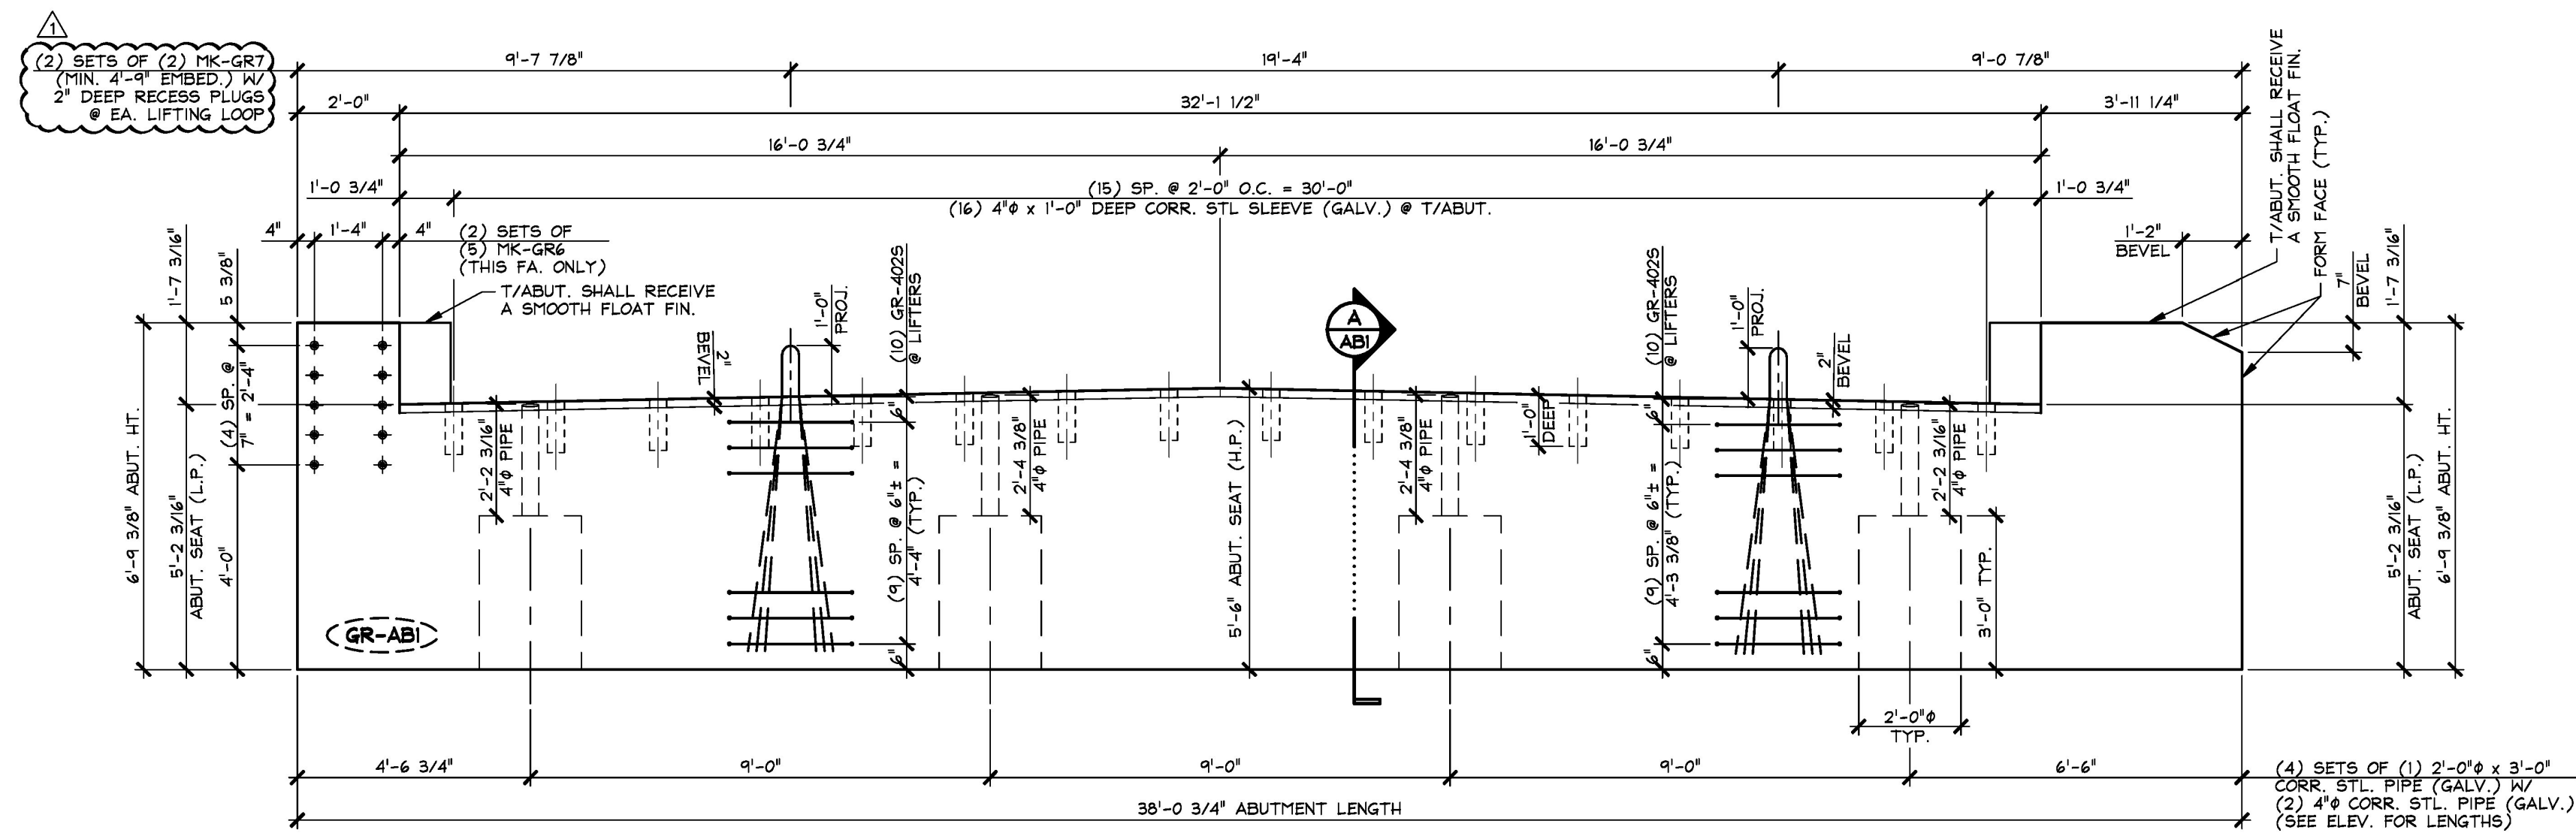

2 NON-MARK FACE ELEVATION  
ABI  
3/8" = 1'-0"

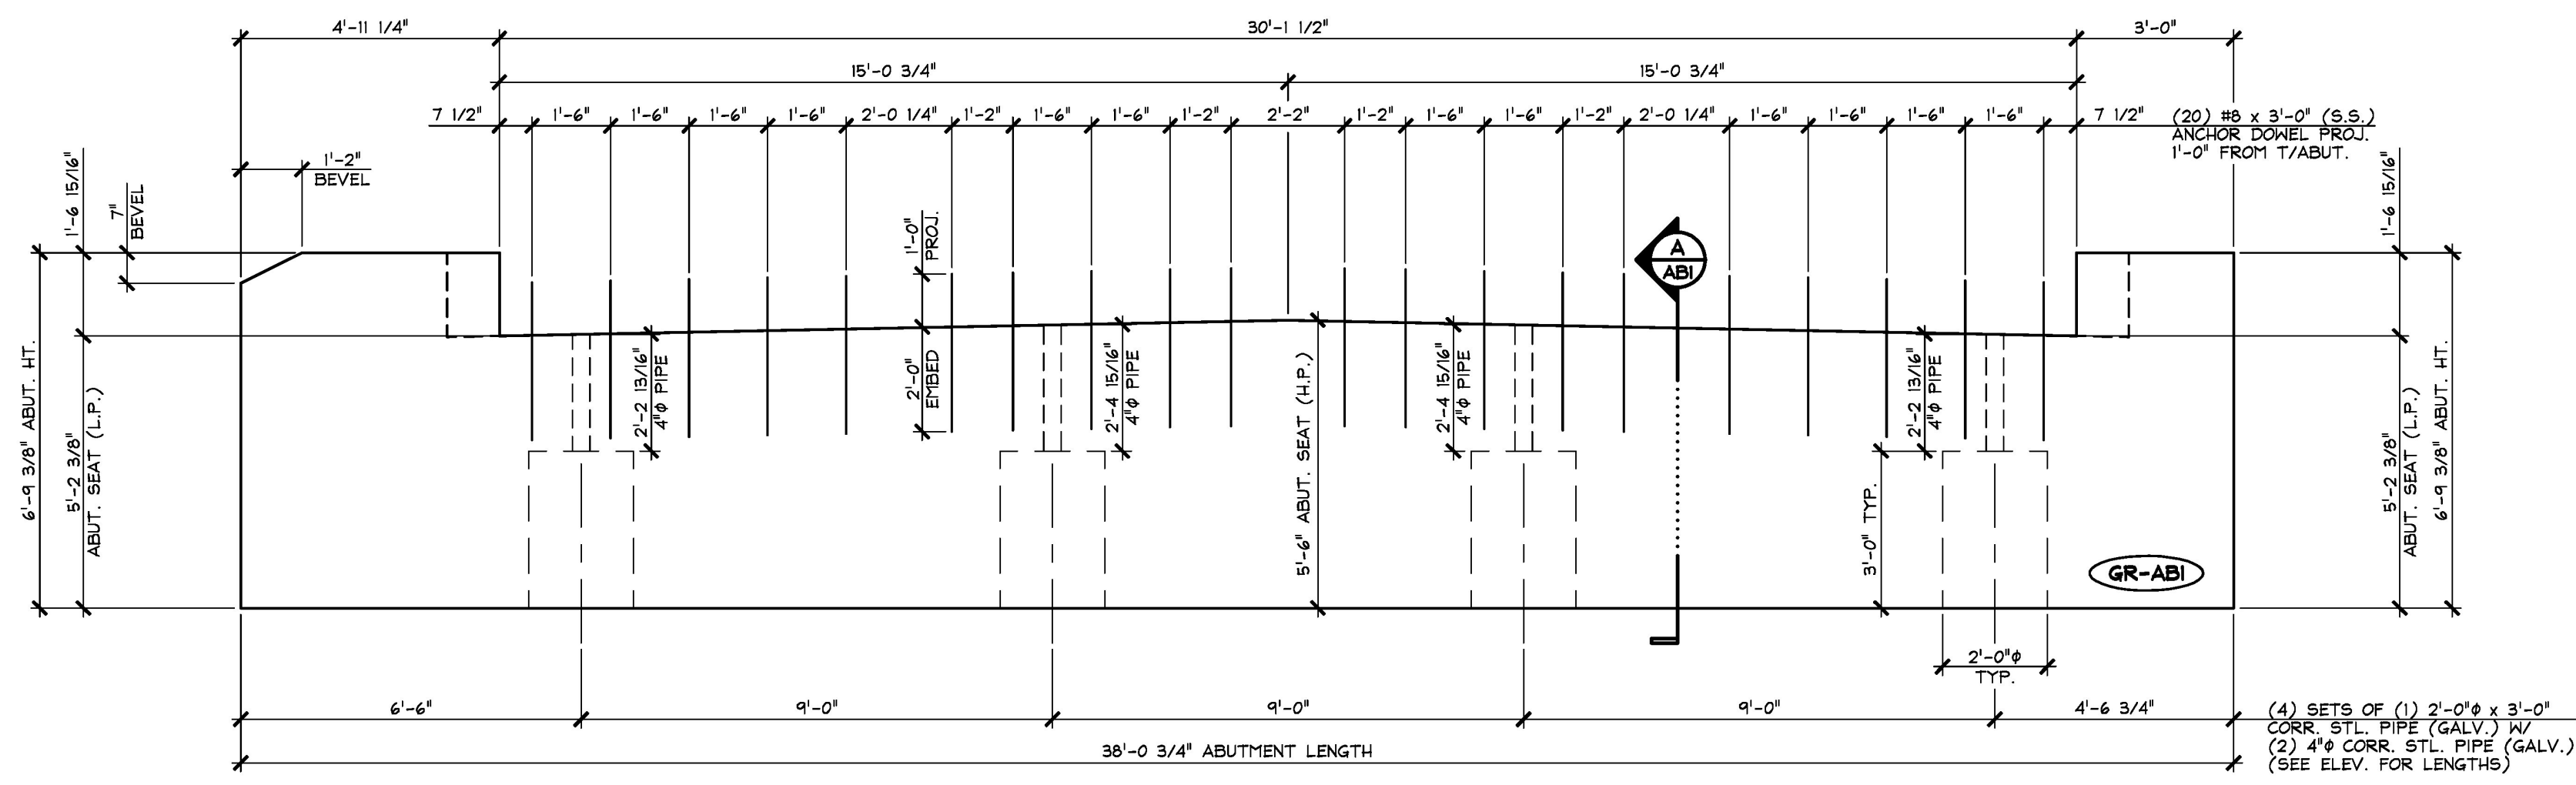

3 MARK FACE ELEVATION  
ABI  
3/8" = 1'-0"

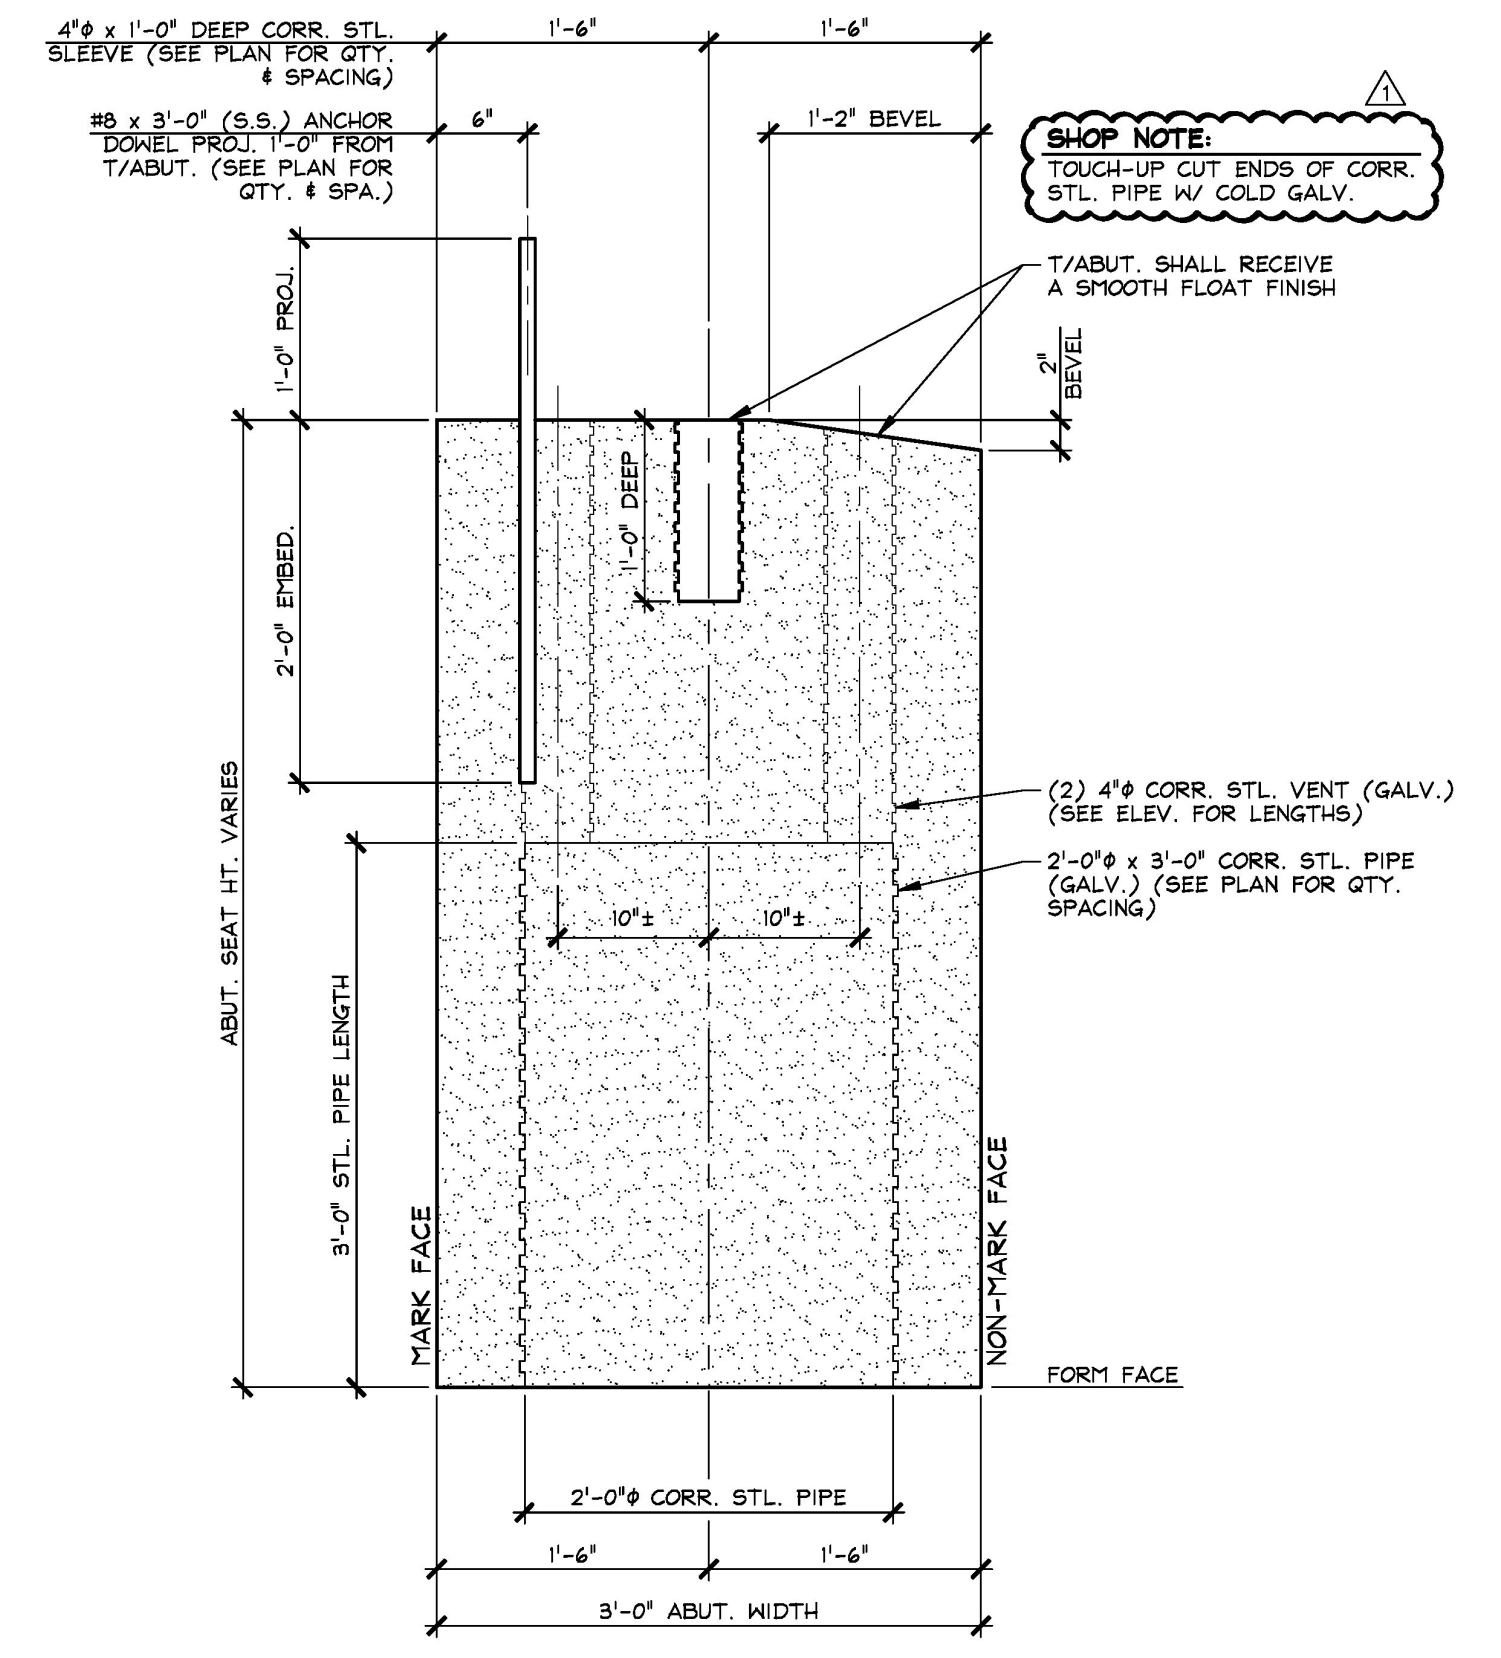

A SECTION  
ABI  
1" = 1'-0"

Vermont Agency of Transportation  
**RECEIVED**  
CK'D BY T.Y. Lin International OK'D BY J. Olund  
January 24, 2017  
RESUBMIT No Approved  
BY D. Bonneau DATE 01/25/17

SHOP NOTE:  
SEE DRAWING NO. 'ABI.1' FOR ABUTMENT REINFORCING DETAILS

SHOP NOTE:  
28-DAY STRENGTH = 5,000 PSI  
HANDLING STRENGTH = 3,500 PSI  
DESIGN MIX #44B15CC

**T.Y. LIN INTERNATIONAL**  
THE STAMPED DOCUMENTS ARE HEREBY:  
- APPROVED  
- APPROVED AS NOTED  
- REVISE AND RESUBMIT  
SEE TRANSMITTAL FOR ADDITIONAL INFORMATION AS APPLICABLE.  
THIS REVIEW IS FOR GENERAL CONFORMANCE WITH DESIGN CONCEPT ONLY. ANY DEVIATION FROM THE PLANS OR SPECIFICATIONS NOT CLEARLY NOTED BY THE CONTRACTOR HAS NOT BEEN REVIEWED. REVIEW BY THE ENGINEER SHALL NOT RELIEVE THE CONTRACTOR OF THE CONTRACTUAL RESPONSIBILITY FOR ANY ERRORS OR DEVIATION FROM THE CONTRACT REQUIREMENTS.  
JOSH OLUND  
REVIEWER  
January 25, 2017  
DATE

MARK: GR-ABI QTY.: 1 WT.: 44.52 T VOL.: 21.98 cy			
MATERIAL LIST / ABUTMENT			
ITEM	MARK	DESCRIPTION	QTY.
1	MK-GR6	DAYTON #5 x 2'-2" D10A DONEL BAR (STAINLESS STEEL)	10
2	MK-GR7	SET OF (3) 0.60" STRANDS LIFTING LOOPS	4
3		2'-0" x 3'-0" CORRUGATED STEEL PIPE (GALV.)	4
4		4" x 1'-0" CORRUGATED STEEL SLEEVE (GALV.)	16
5		4" x 2'-2 3/16" CORRUGATED STEEL PIPE (GALV.)	2
6		4" x 2'-4 3/8" CORRUGATED STEEL PIPE (GALV.)	2
7		4" x 2'-2 13/16" CORRUGATED STEEL PIPE (GALV.)	2
8		4" x 2'-4 15/16" CORRUGATED STEEL PIPE (GALV.)	2
9	GR-4025	#4 BENT BAR (STAINLESS STEEL)	20
10		#8 x 3'-0" (STAINLESS STEEL)	20

1-3-17 REVISED AS NOTED

APPROVAL STAMP:	<b>J.P. CARRARA &amp; SONS INC.</b> Precast & Prestress Manufacturer 244 GAGE STR., WOODSBURY, VERMONT 05750 Phone: (802)388-6361 Fax: (802)388-9010	J.P. SICARD, INC. CONTRACTOR BARTON, VERMONT
STATE OF VERMONT AGENCY OF TRANSPORTATION COUNTY OF ORLEANS		DATE: NOV. 18, 2016
VILLAGE OF BARTON TH 2 (GLOVER ROAD), RURAL MAJOR COLLECTOR BRIDGE NO.: 20 PROJECT NO.: BHF 0286(5)		SCALE: NOTED
PRECAST ABUTMENT DIMENSIONAL DETAILS		CHKD: A.S. DFTM: B.L. JOB NO: 23498-016
		DWG. NO: <b>ABI</b> GLOVER ROAD