


**INDEX OF SHEETS**

- 1. TITLE SHEET
- 2-3. TYPICAL SECTIONS
- 4-5. QUANTITY SHEETS
- 6. GENERAL NOTES
- 7. DRY MASONRY NOTES
- 8. LAYOUT SHEET
- 9. BLANK
- 10. ROOF REPAIR DETAILS
- 11. NORTH TRUSS DETAILS
- 12. SOUTH TRUSS DETAILS
- 13. LATTICE SISTER DETAILS
- 14. SUBSTRUCTURE DETAILS
- 15. BLANK
- 16. STEEL-BACKED TIMBER GUARDRAIL DETAILS
- 17. BLANK
- 18. TRAFFIC SIGN SUMMARY SHEET
- 19. REINFORCING STEEL SCHEDULE
- 20-23. REFERENCE SHEETS

**VTRANS STANDARD SHEETS**

E-121	STANDARD SIGN PLACEMENT	08/08/95
G-4	PLANK RAIL DETAILS	06/01/94
T-45	SQUARE TUBE SIGN POST & ANCHOR	01/02/13

STATE OF VERMONT  
AGENCY OF TRANSPORTATION

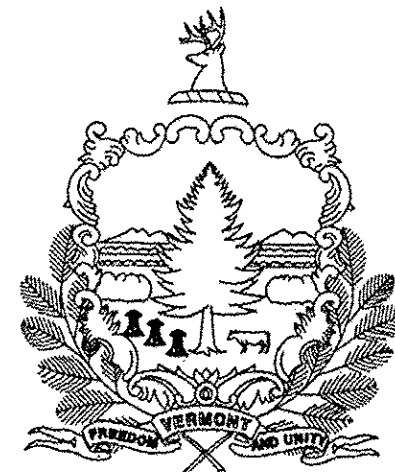



PROPOSED IMPROVEMENT  
BRIDGE PROJECT

TOWN OF SHREWSBURY COUNTY OF RUTLAND  
ROUTE NO. TH 6 (CLASS 3) BROWN COVERED BRIDGE - NO. 34

PROJECT LOCATION: BEGINNING AT A POINT ON TH 6 IN THE TOWN OF SHREWSBURY, APPROXIMATELY 0.10 MILE WEST OF ITS INTERSECTION WITH TH 1, BROWN COVERED BRIDGE, OVER THE COLD RIVER.

PROJECT DESCRIPTION: REHABILITATION OF EXISTING STONE ABUTMENTS AND WINGWALLS, PERFORMING SUPERSTRUCTURE REPAIRS, PROVIDING APPROACH RAILINGS, SIGNS, AND OTHER MISCELLANEOUS WORK.

LENGTH OF STRUCTURE: 112.20 FEET  
LENGTH OF PROJECT: 112.20 FEET

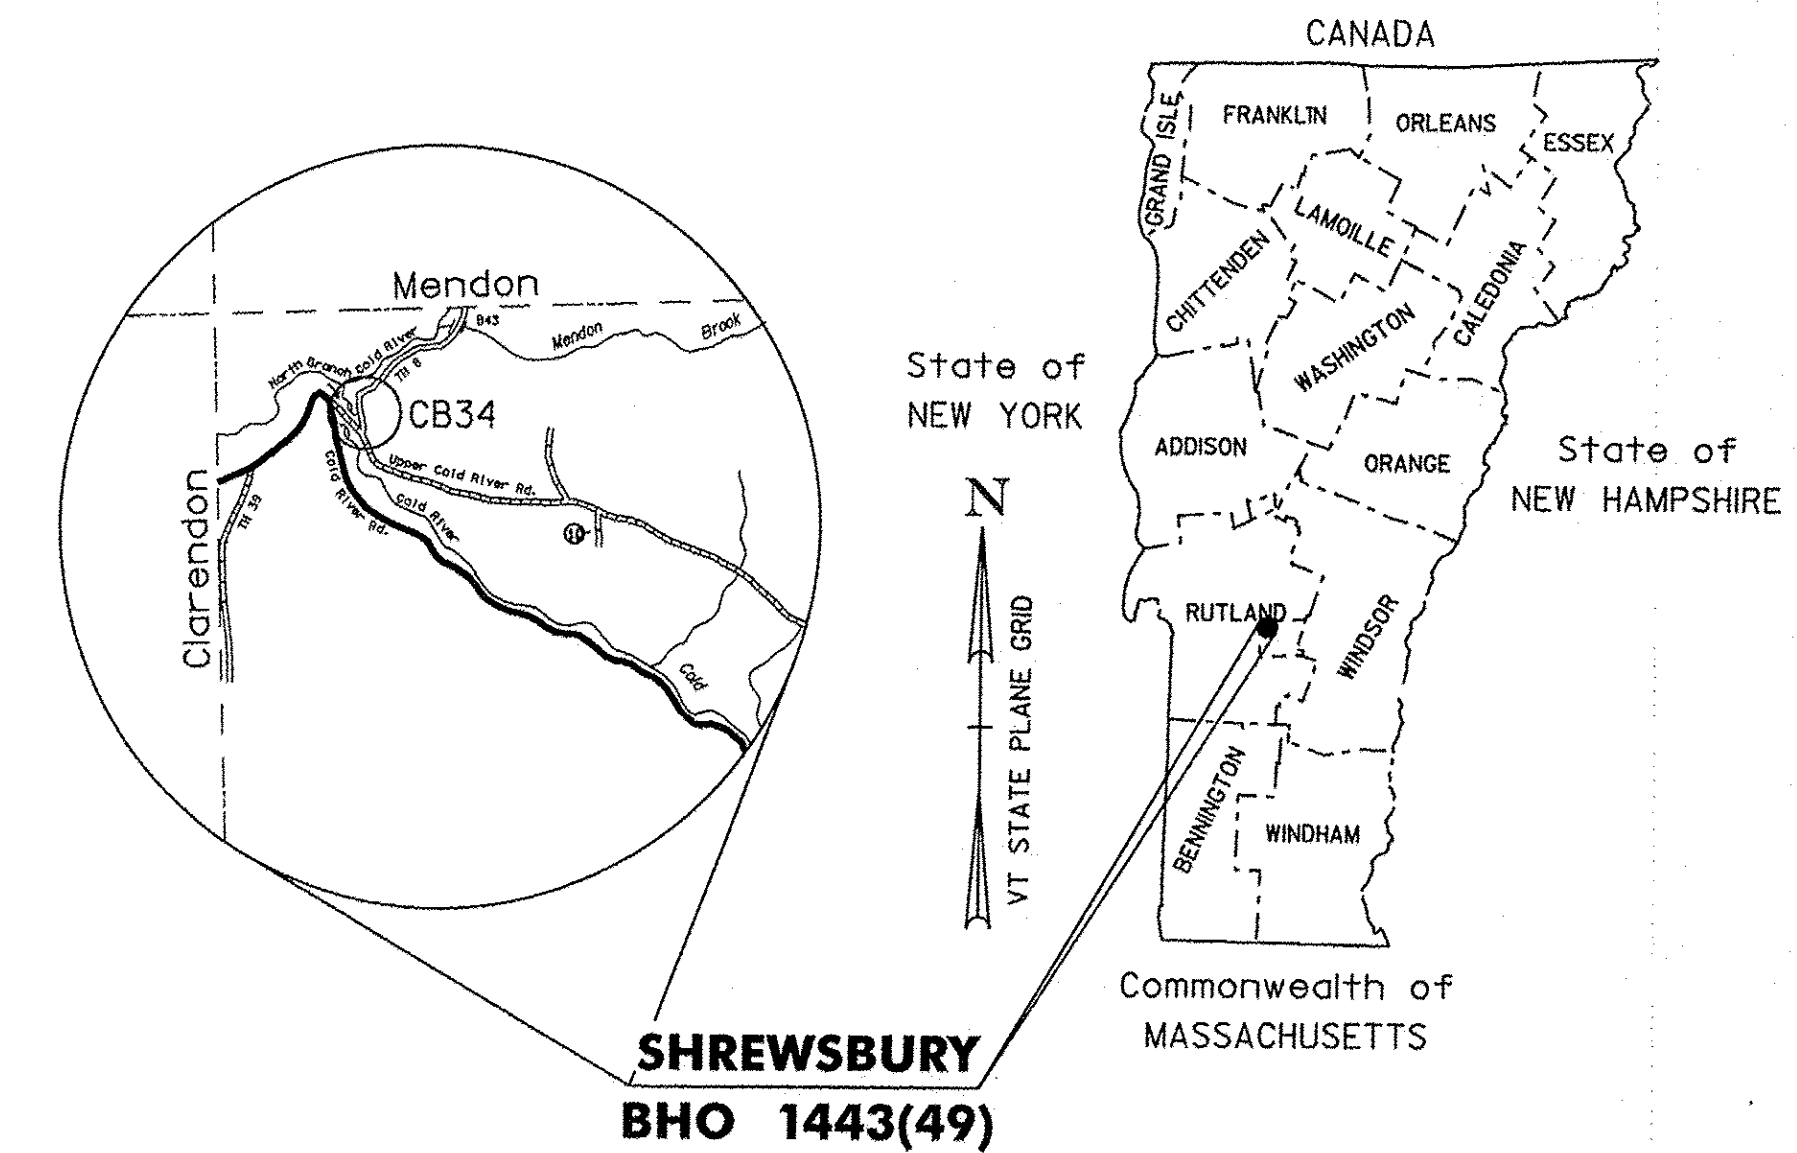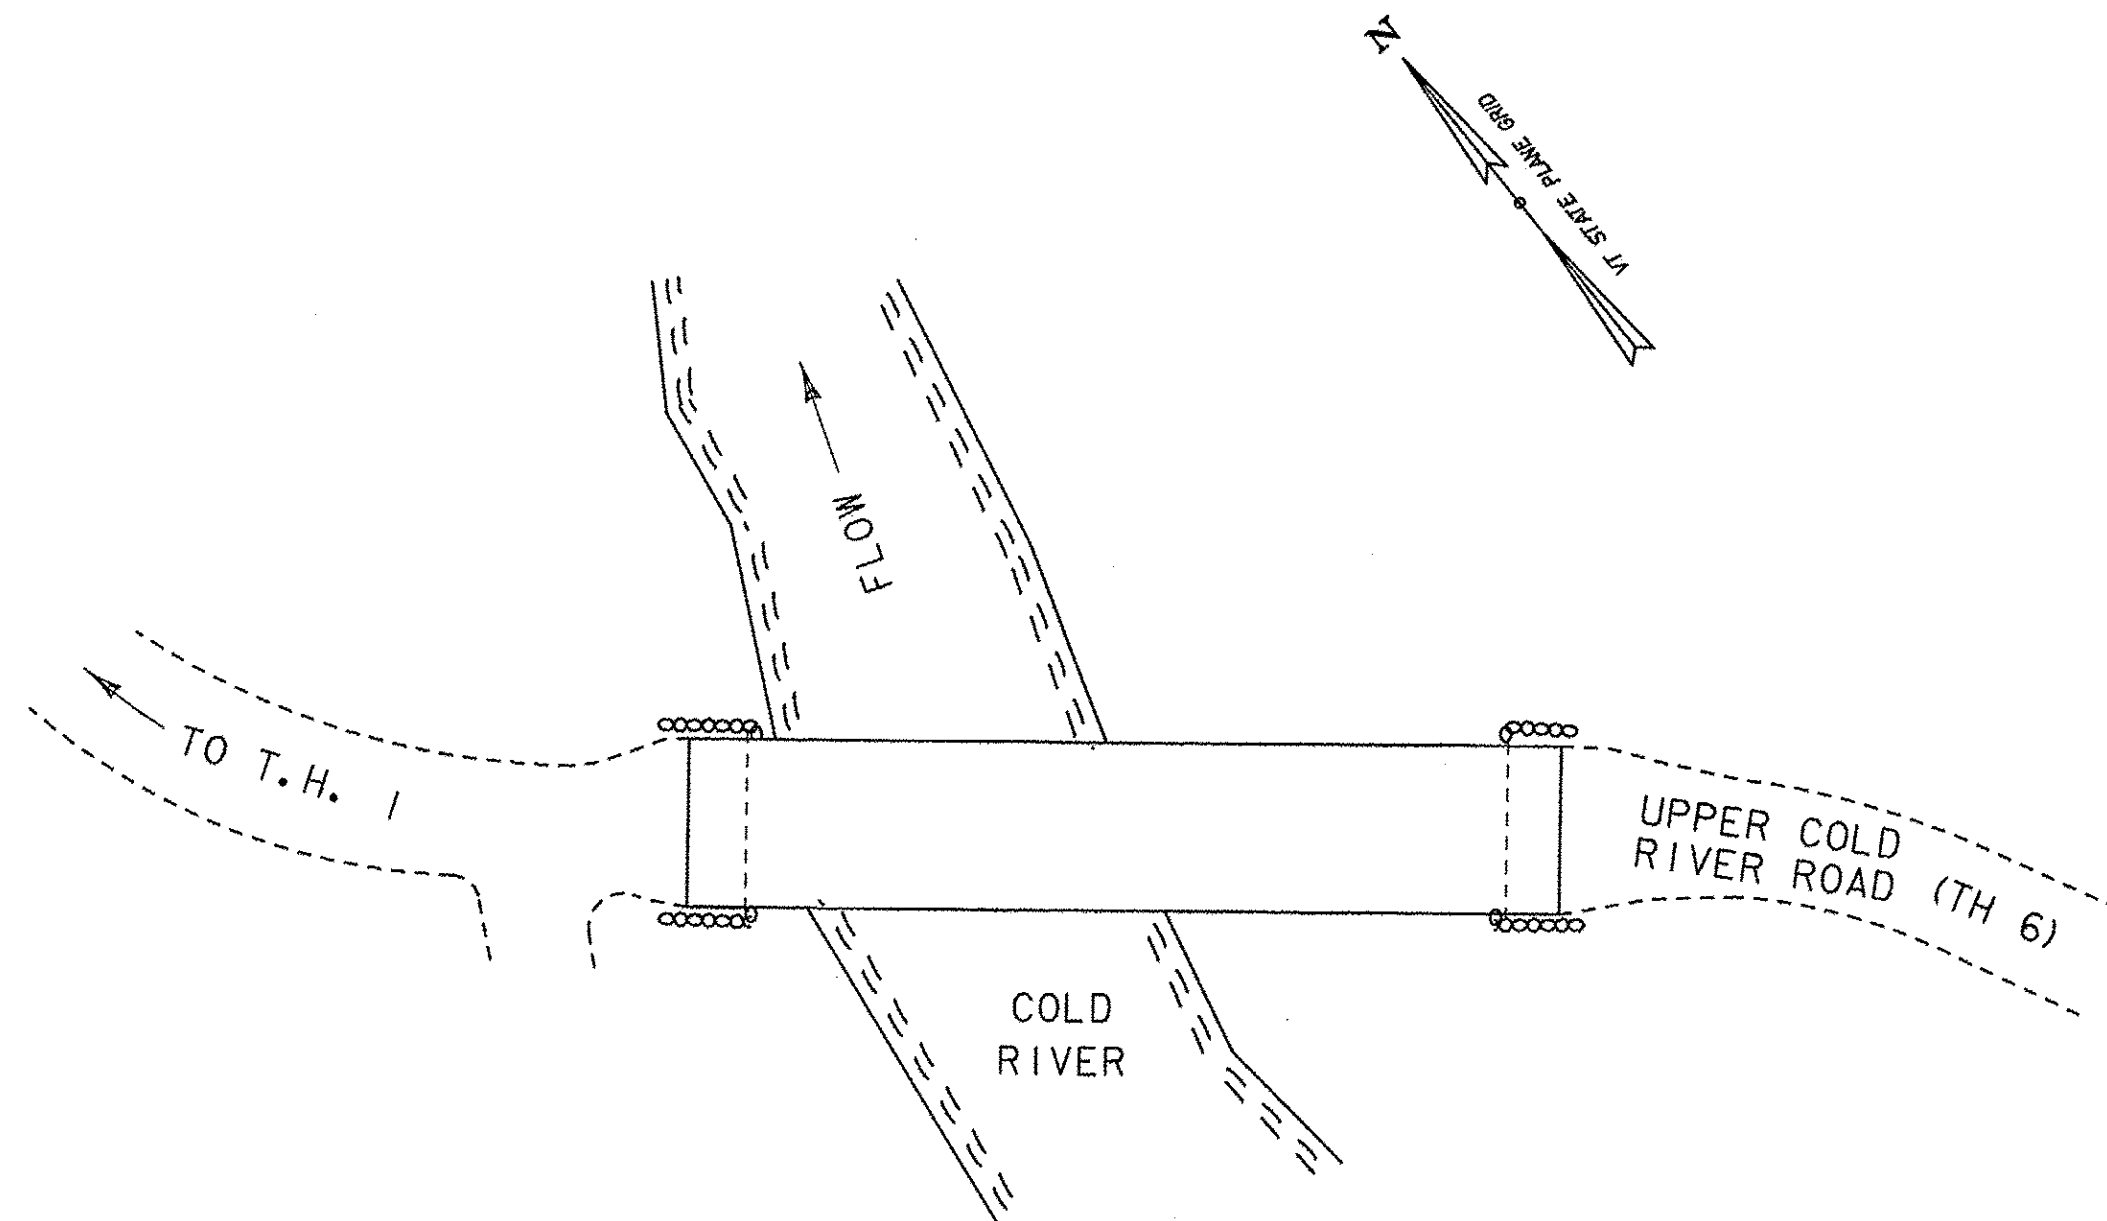

RECORD PLANS	
CONTRACTOR:	A.L. ST. ONGE CONTRACTOR, INC. - MONTGOMERY, VT.
RESIDENT ENGINEER:	SCOTT WHEATLEY
CONSTRUCTION BEGAN:	APRIL 23, 2014
CONSTRUCTION COMPLETE:	NOVEMBER 14, 2014
RECORD PLANS BY:	SCOTT WHEATLEY & KEVIN KING
I HEREBY CERTIFY THAT ALL THE CONSTRUCTION REQUIRED BY THIS SET OF DRAWINGS HAS BEEN ACCOMPLISHED AS INDICATED HEREIN.	
BY:	<i>[Signature]</i> RESIDENT ENGINEER
DATE:	06-30-16
NOTE: Any further information concerning final quantities, amounts or other details relative to this project may be found at Central Files in the electronic archives.	

CONSTRUCTION IS TO BE CARRIED ON IN ACCORDANCE WITH THESE PLANS AND THE STANDARD SPECIFICATIONS FOR CONSTRUCTION DATED 2011, AS APPROVED BY THE FEDERAL HIGHWAY ADMINISTRATION ON JULY 20, 2011 FOR USE ON THIS PROJECT, INCLUDING ALL SUBSEQUENT REVISIONS AND SUCH REVISED SPECIFICATIONS AND SPECIAL PROVISIONS AS ARE INCORPORATED IN THESE PLANS.

QUALITY ASSURANCE PROGRAM : LEVEL
SURVEYED BY :
SURVEYED DATE :
DATUM
VERTICAL
HORIZONTAL

DIRECTOR OF PROJECT DELIVERY	
APPROVED: <i>[Signature]</i>	DATE: 11/20/2014
PROJECT MANAGER :	MARK SARGENT
PROJECT NAME :	SHREWSBURY
PROJECT NUMBER :	BHO 1443 (49)
SHEET 1 OF 23 SHEETS	