



EXISTING
CROSS SECTION
NOT TO SCALE

REPAIR SLATE ROOF
AS SPECIFIED IN
CONTRACT (TYP)

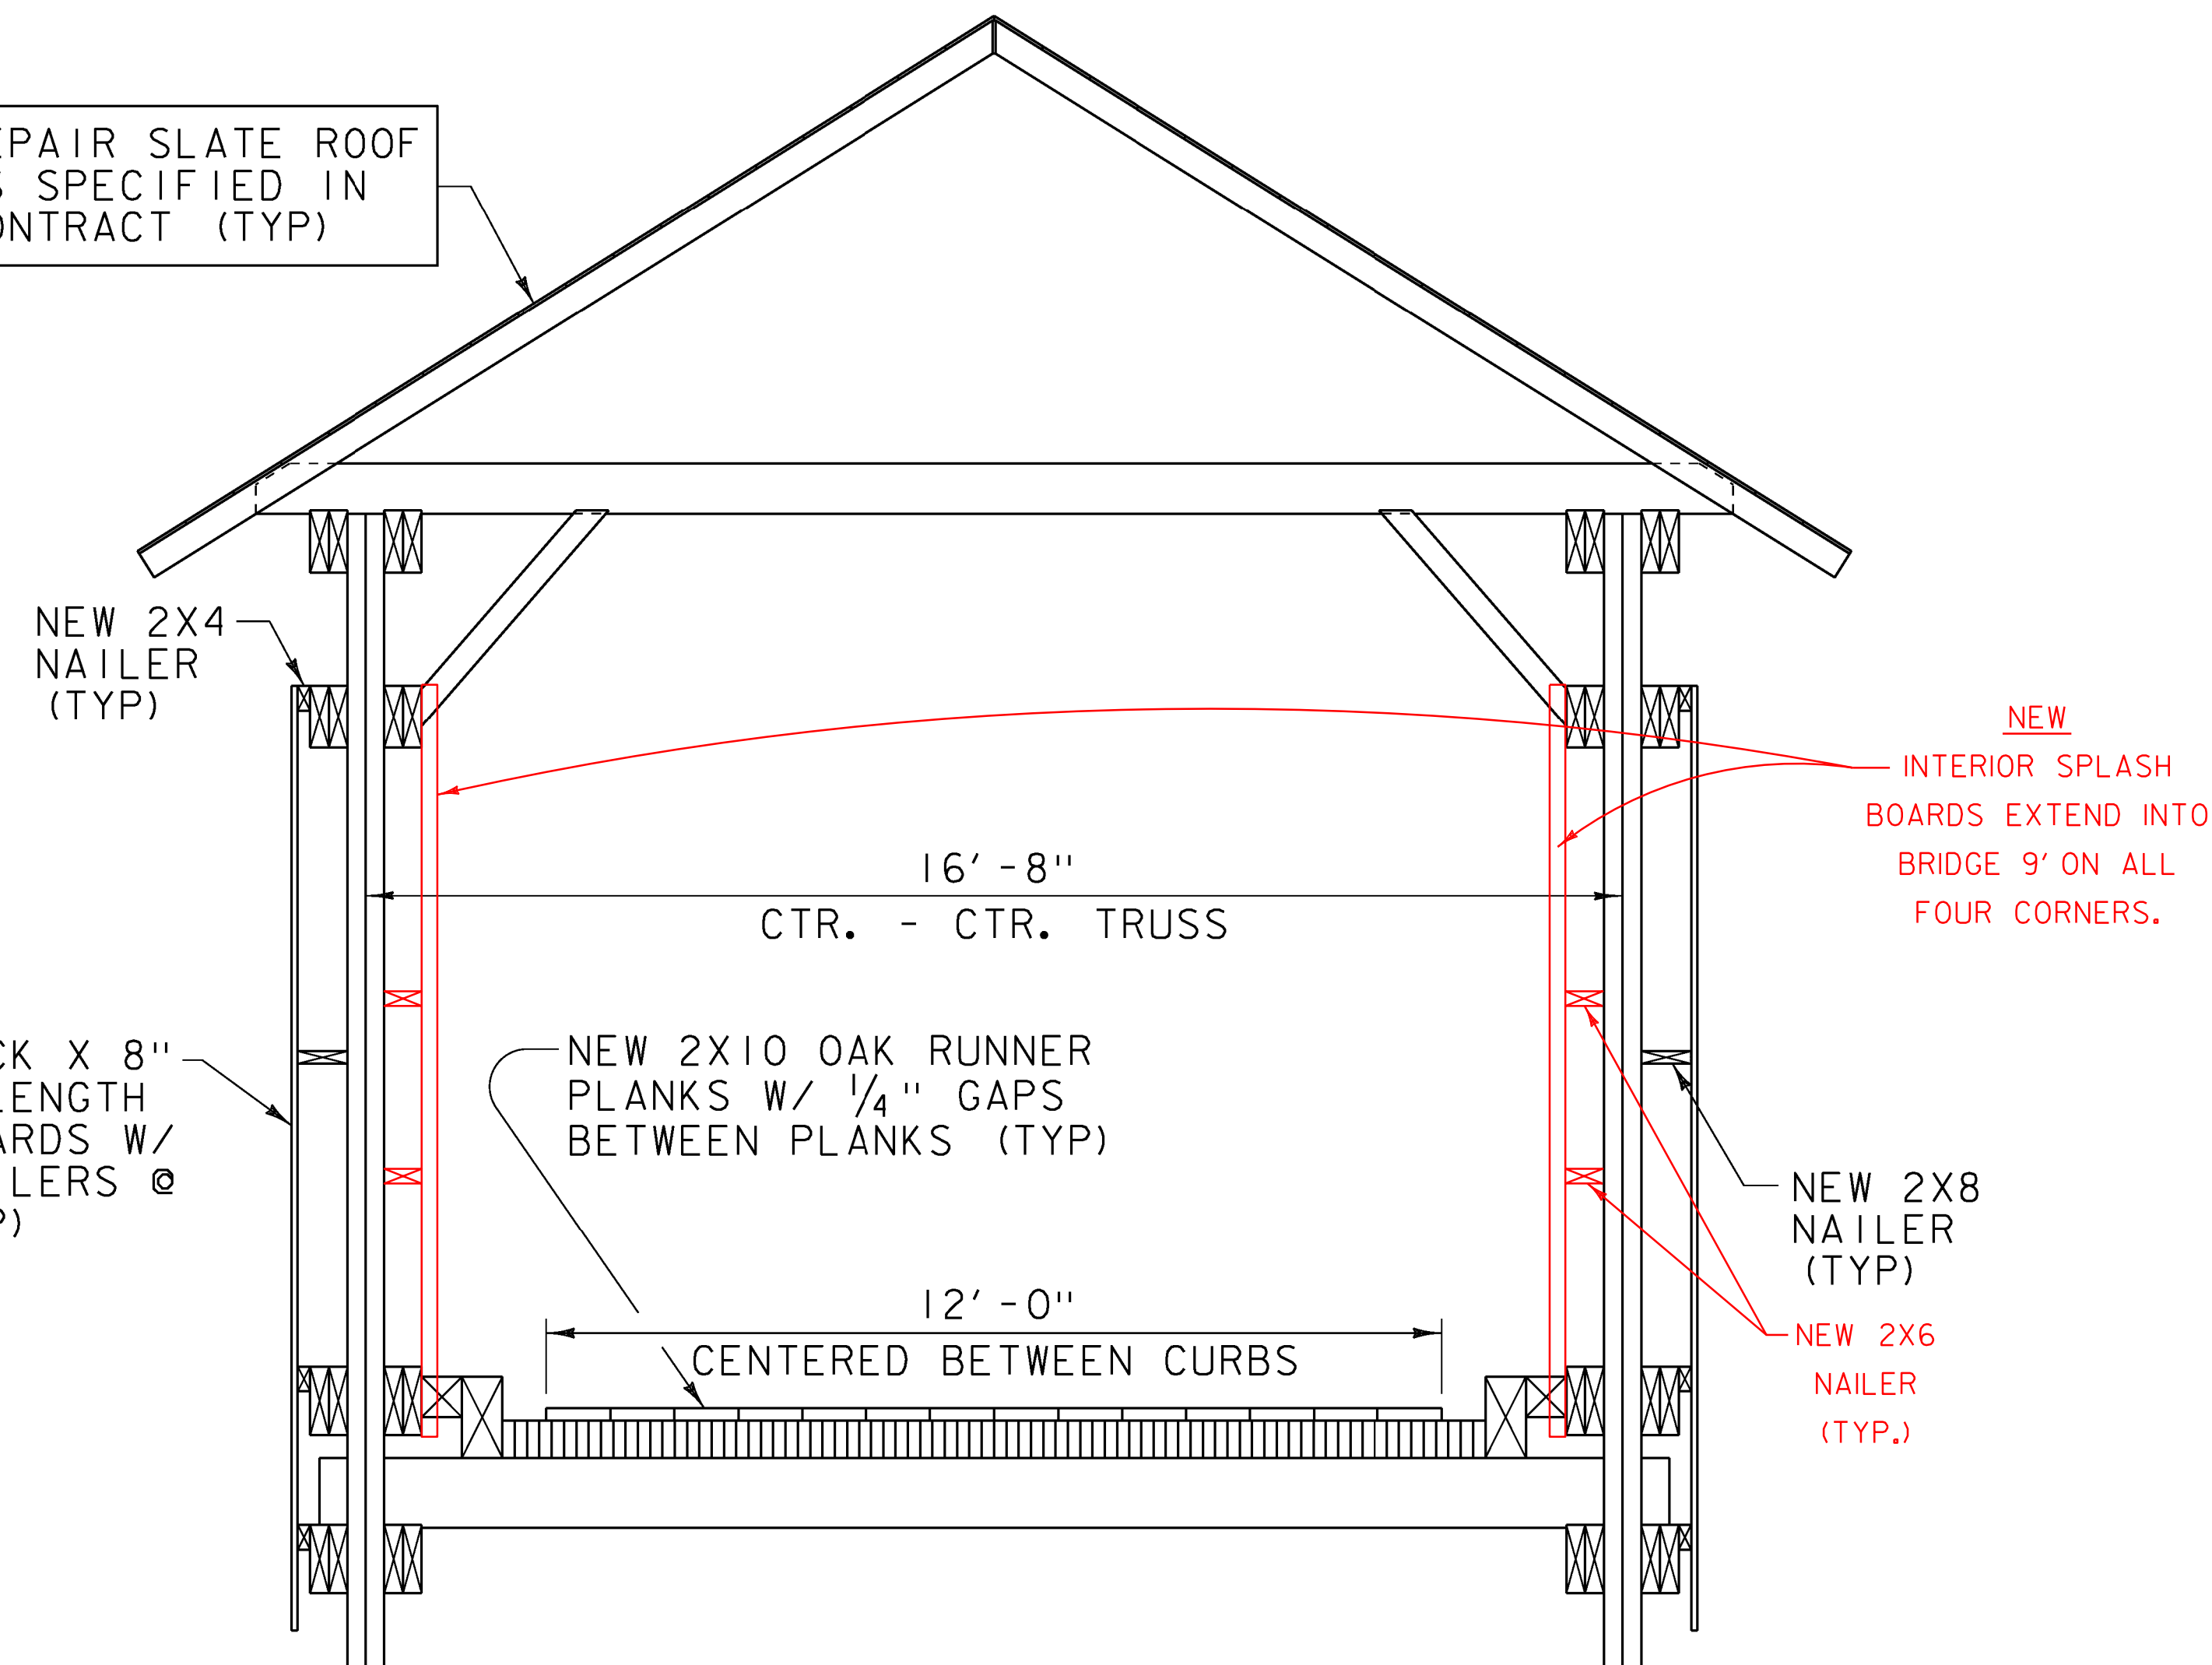

NEW CROSS SECTION
NOT TO SCALE

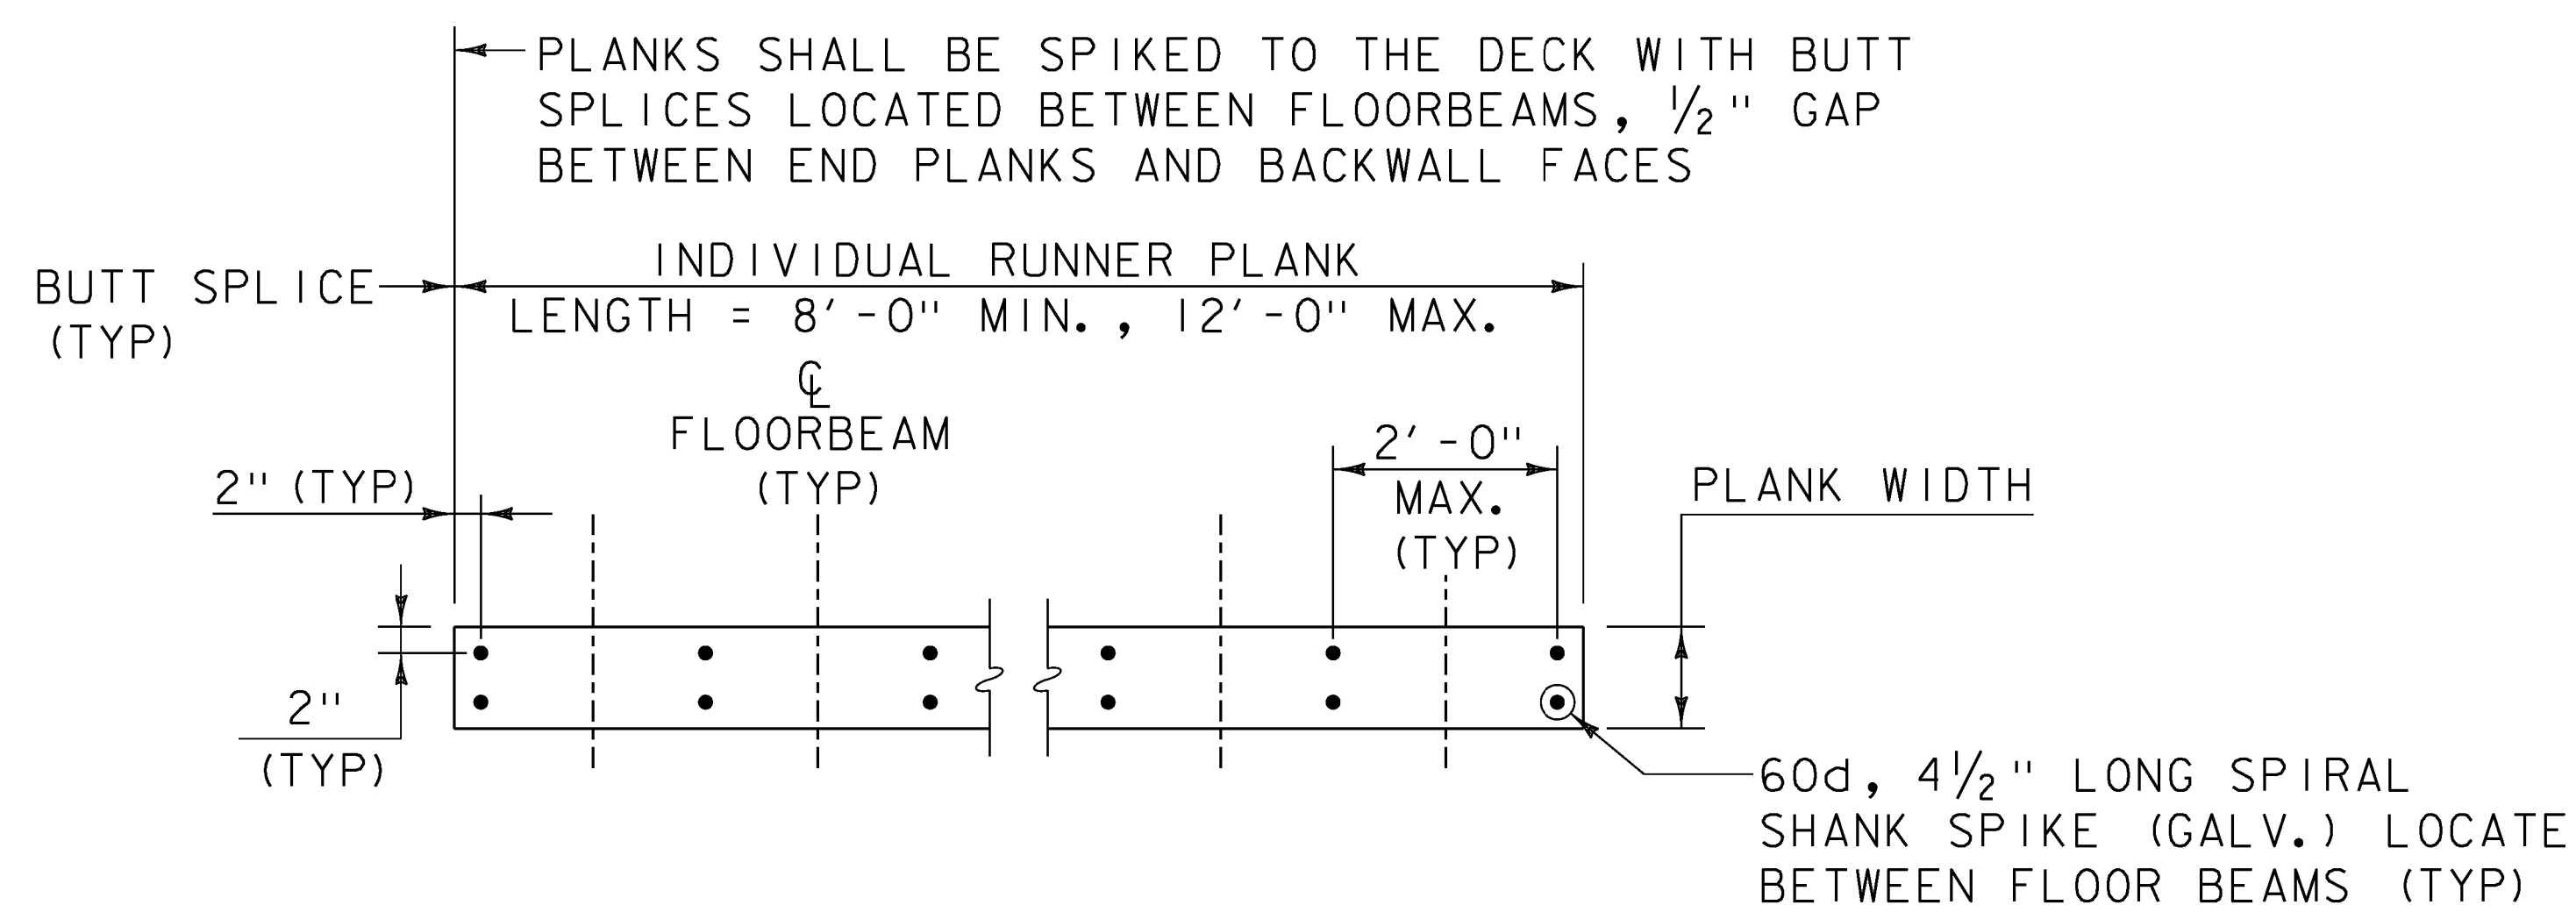

RUNNER PLANK ATTACHMENT DETAIL
NOT TO SCALE

PROJECT NAME:	Shrewsbury	PLOT DATE:	06-NOV-2014
PROJECT NUMBER:	BHO 1443(49)	DRAWN BY:	Weeber
FILE NAME:	I2J350Typicals.dgn	CHECKED BY:	Weaver
PROJECT LEADER:	Sargent	SHEET	2 OF 23
DESIGNED BY:	Weaver		
Typical Sections (I)			