


EXISTING & NEW
END VIEW
NOT TO SCALE

SPECIAL PROVISION (STEEL BACKED TIMBER GUARDRAIL, FASCIA MOUNTED)

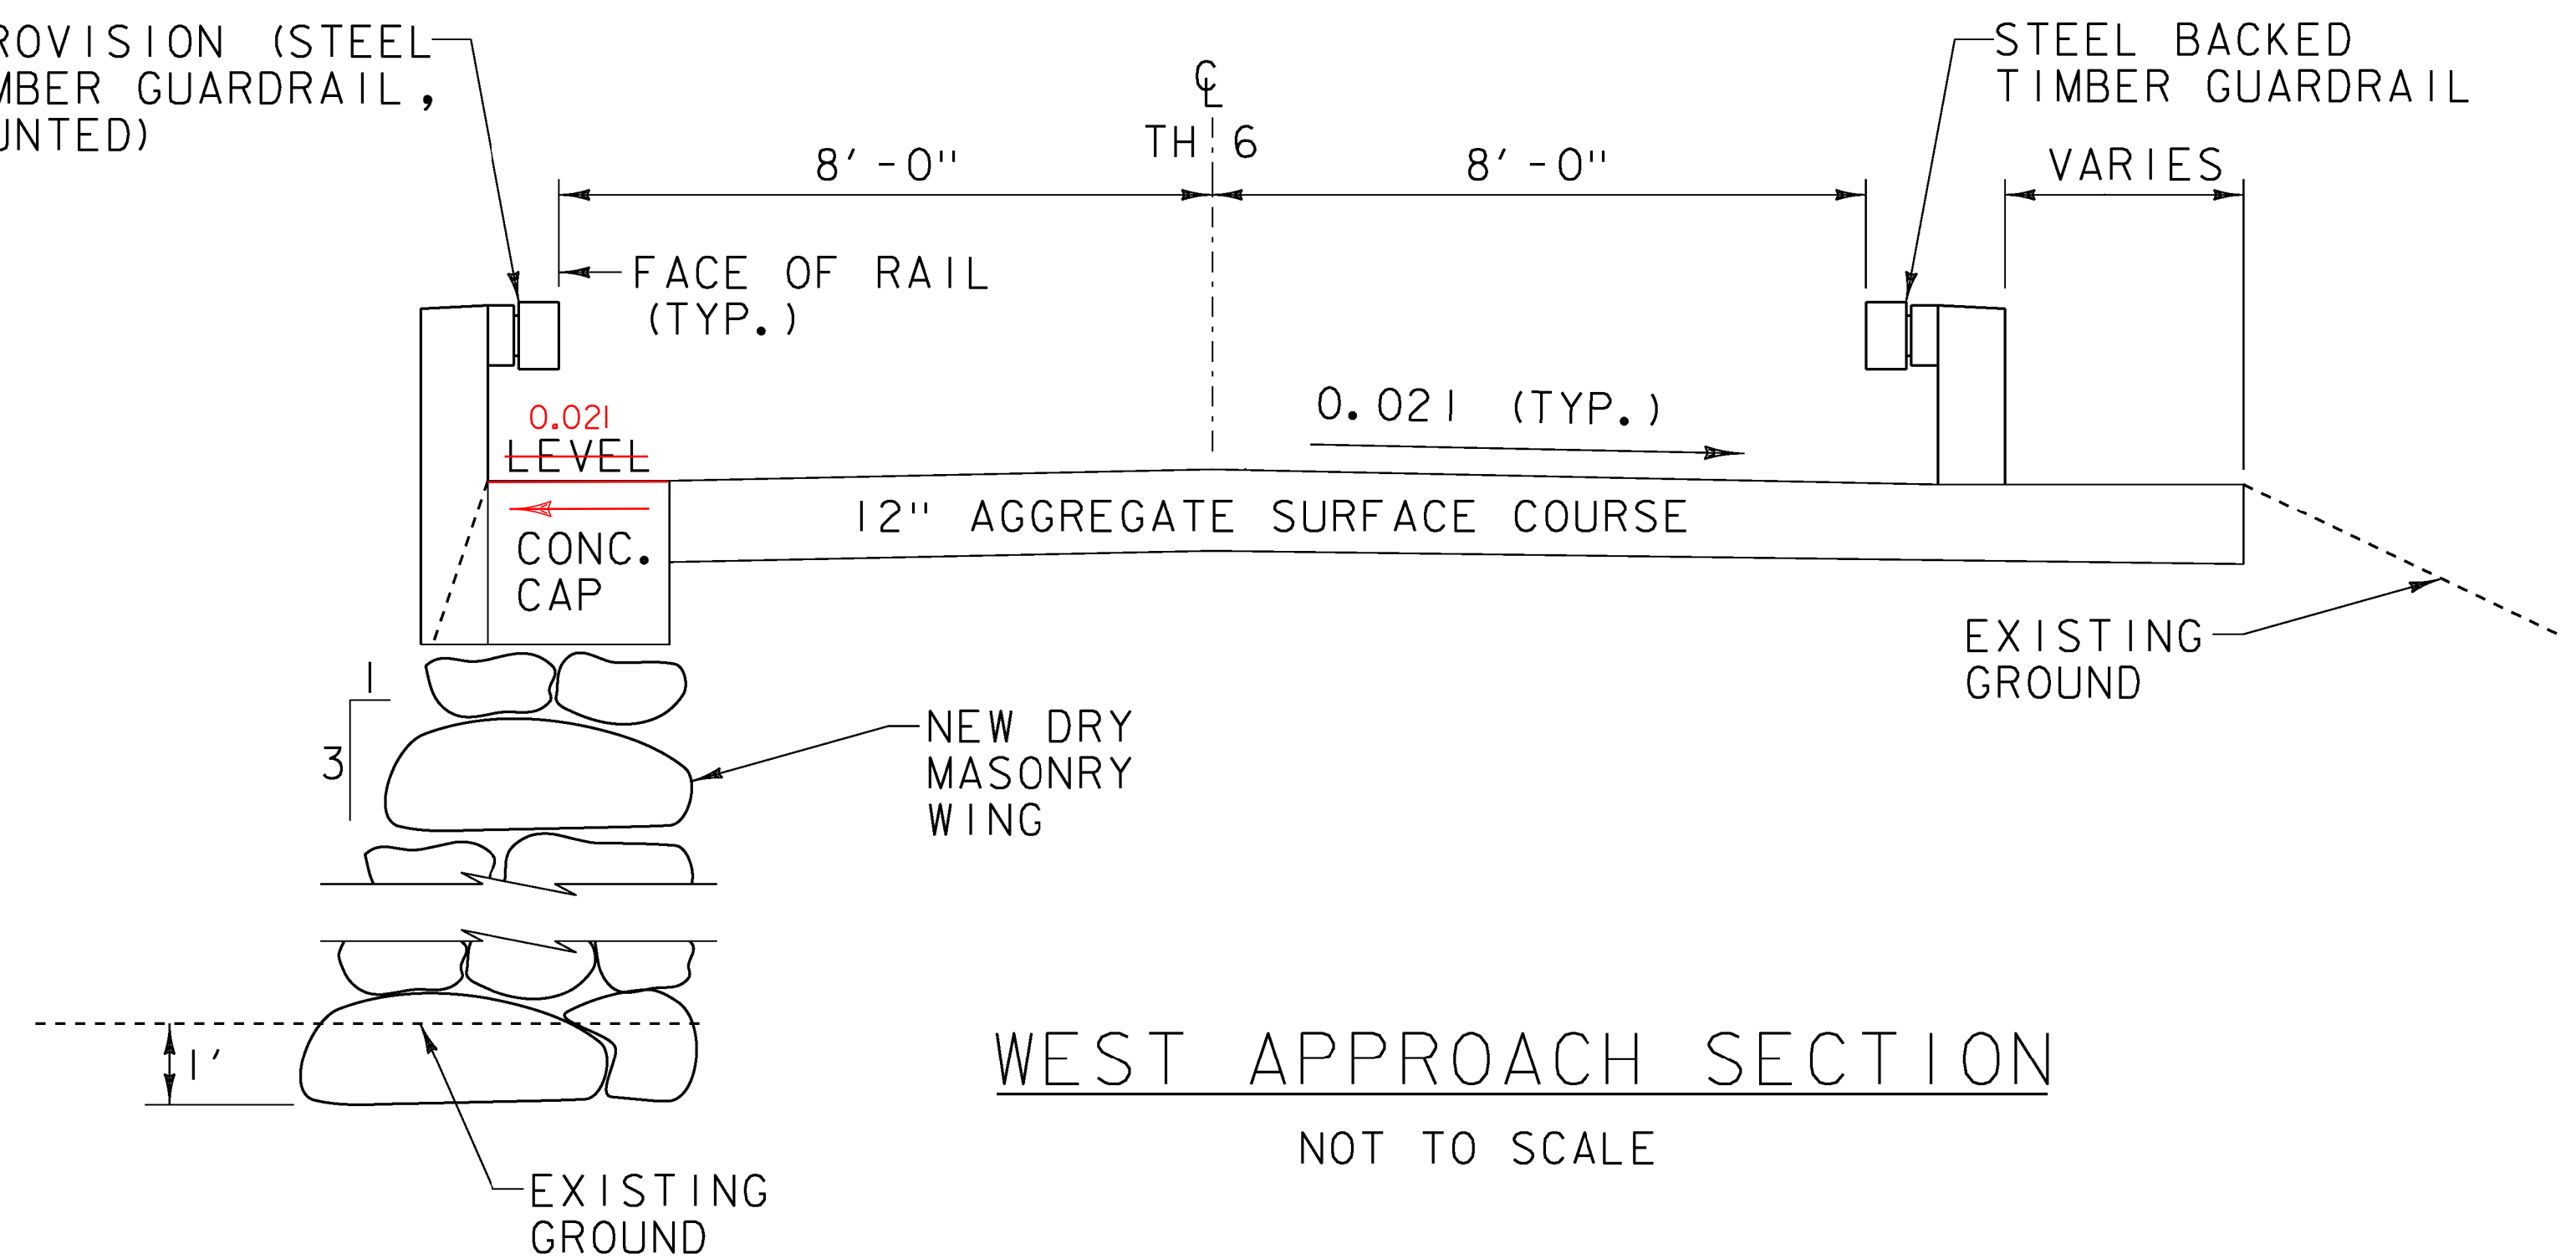

WEST APPROACH SECTION
NOT TO SCALE

PROJECT NAME: Shrewsbury
PROJECT NUMBER: BHO 1443(49)

FILE NAME: I2J350Typicals.dgn
PROJECT LEADER: Sargent
DESIGNED BY: Weaver
Typicals Sections (2)

PLOT DATE: 03-NOV-2014
DRAWN BY: Weeber
CHECKED BY: Weaver
SHEET 3 OF 23