


NORTH EAST CORNER
 NEW BOLSTER BEAM
 AND BEARING BLOCKS

9-20-15
 TL2

LAPPED LATTICE
 SISTER (DETAIL 2)

LATTICE SISTER (DETAIL 2)

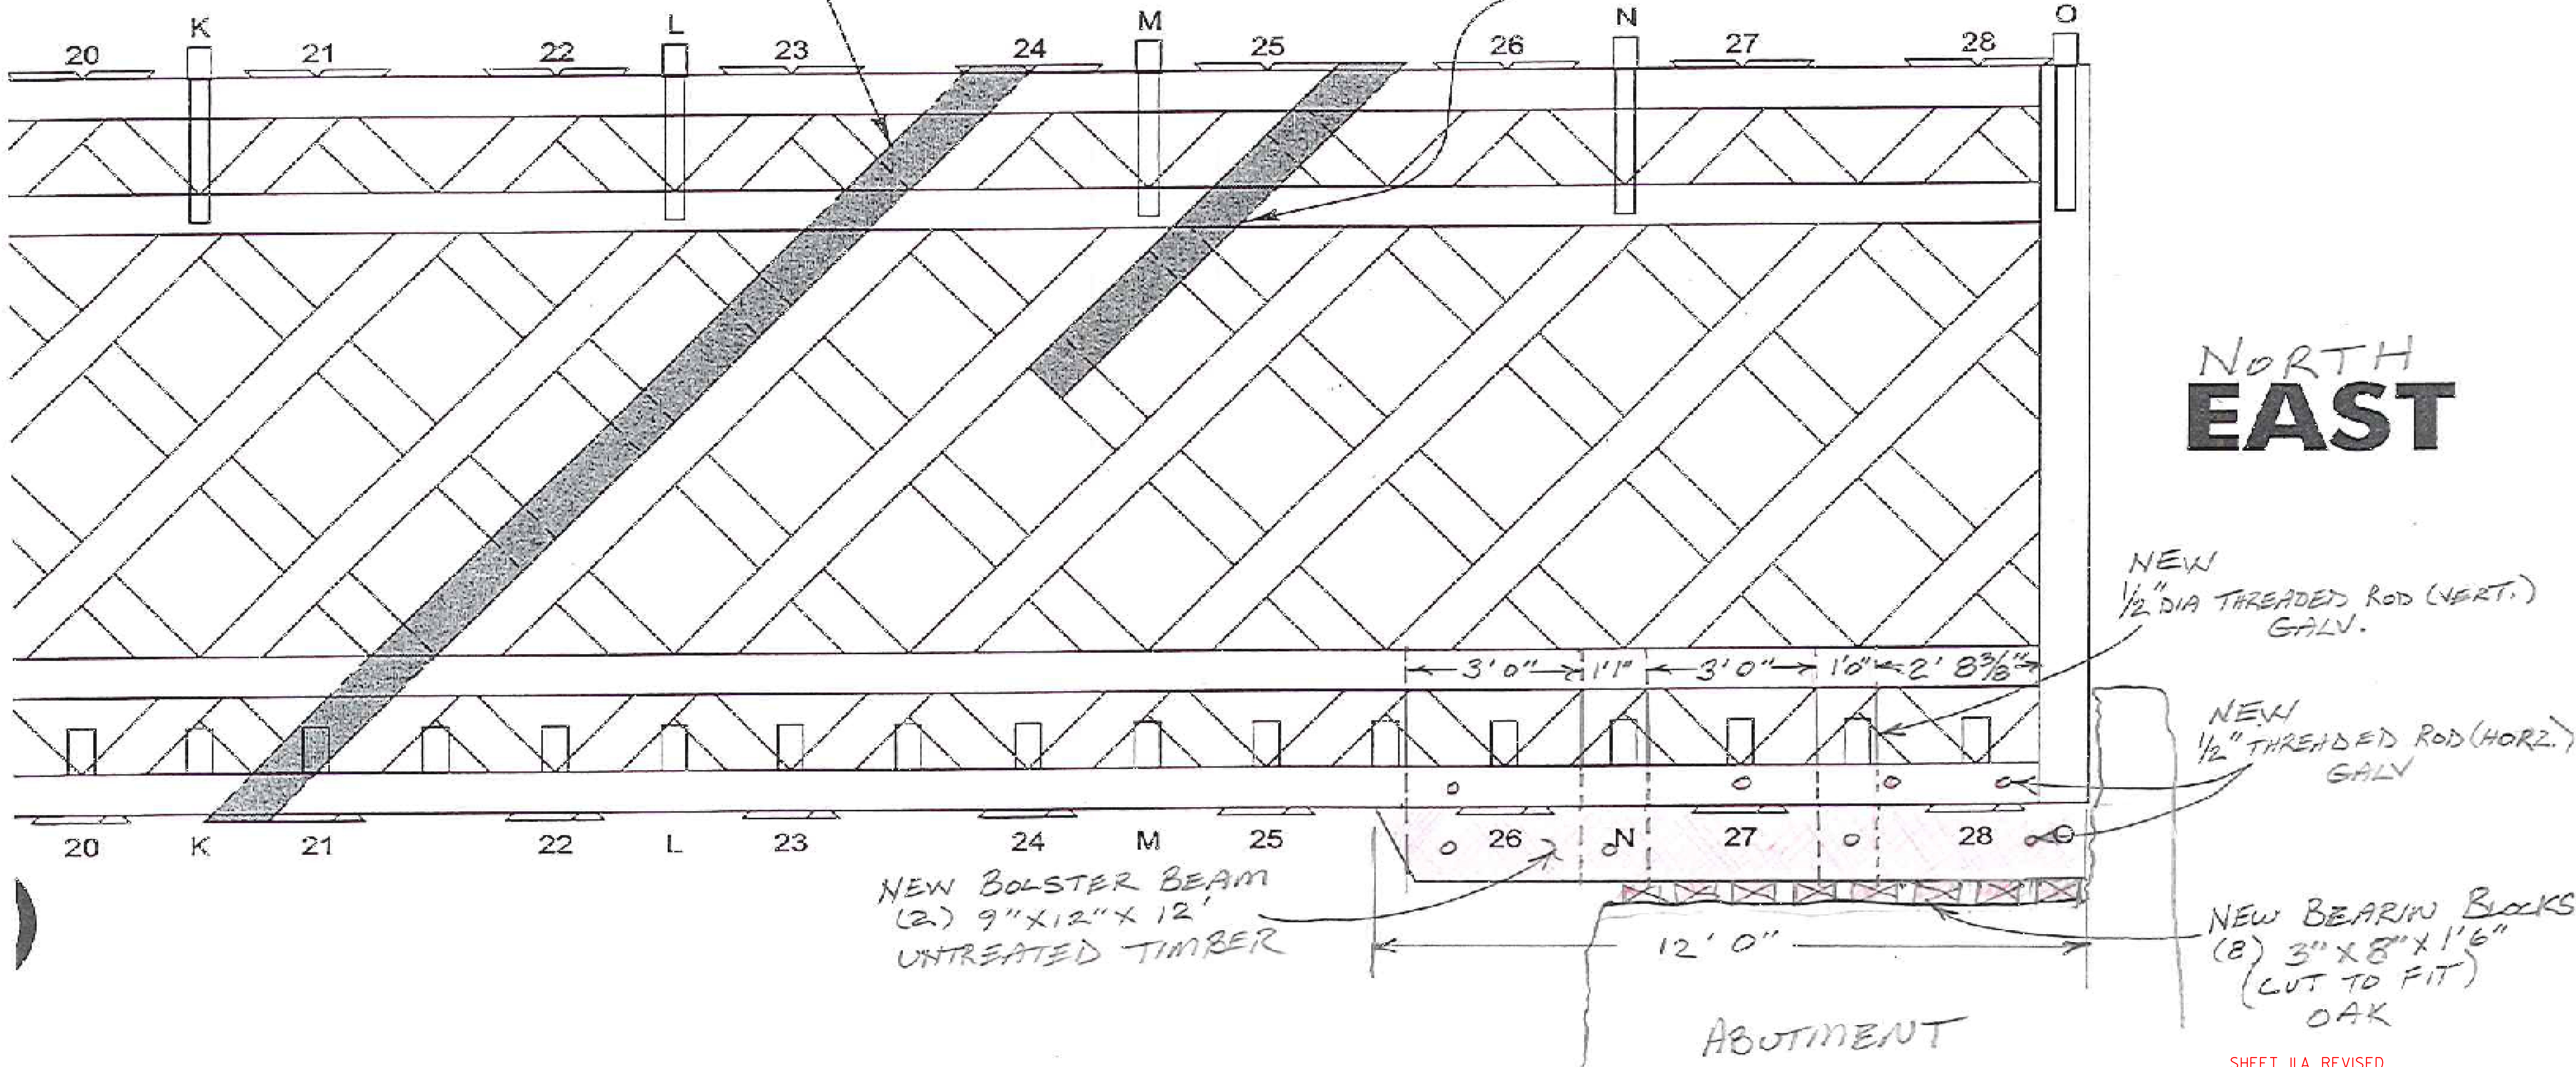

**NORTH
 EAST**

NEW
 1/2" DIA THREADED ROD (VERT.)
 GALV.

NEW
 1/2" THREADED ROD (HORZ.)
 GALV.

NEW BEARING BLOCKS
 (8) 3" X 8" X 1'6"
 (CUT TO FIT)
 OAK

NEW BOLSTER BEAM
 (2) 9" X 12" X 12'
 UNTREATED TIMBER

12' 0"

ABUTMENT

NEW 3X10 SPLICED
 LATTICE SISTER