

NORTHWEST CORNER
 NEW BOLSTER BEAM
 AND BEARING BLOCKS
 9-20-15
 TL2

4" X 4"
 SWAY BRACE
 (TYP)


LATTICE EPOXY
 REPAIR AREAS

NORTH
WEST

NEW
 1/2" DIA. THREADED ROD
 (HORZ.)
 GALV.

ABUTMENT

CHORD

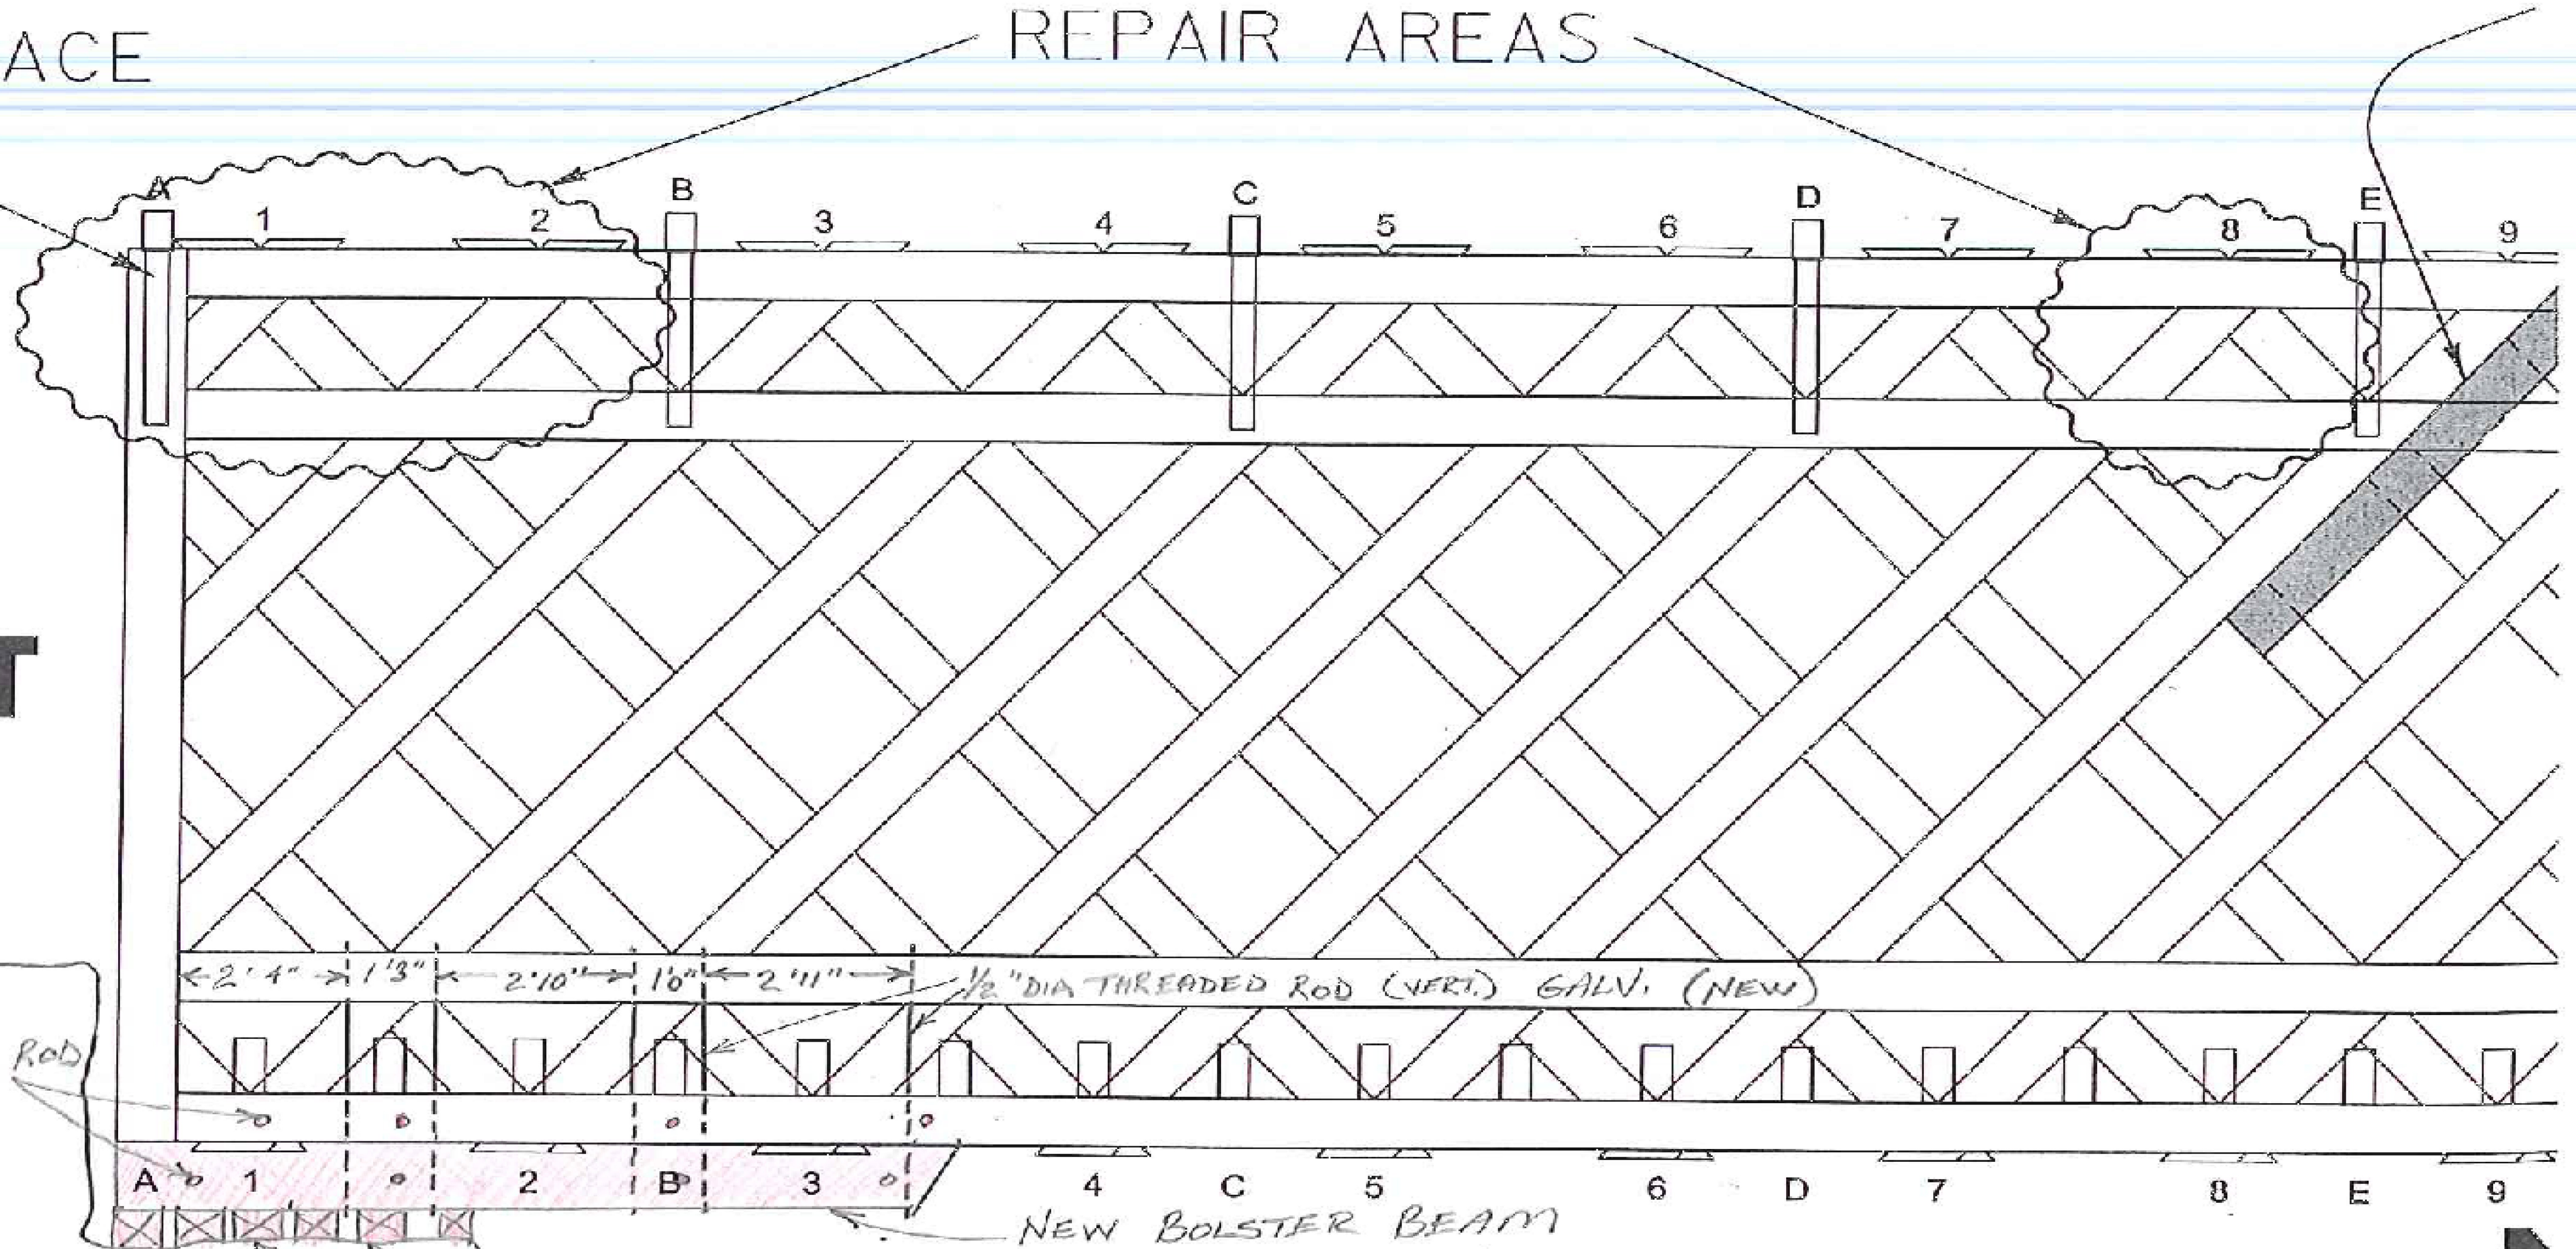

(6) NEW BEARING BLOCKS
 3" X 8" X 1'6" OAK
 (CUT TO FIT)

(2) 9" X 12" X 12'
 UNTREATED TIMBER

TIE BEAM
 NODE (TYP)

SHEET 11B REVISED

3X10 INSIDE