

SOUTH WEST CORNER  
 NEW BOLSTER BEAM  
 AND BEARING BLOCKS

9-20-15


TL2

INSIDE  
 LATTICE  
 (TYP)

OUTSIDE  
 LATTICE  
 (TYP)


LATTICE S  
 (SIMILAR T  
 SHEET II)

**SOUTH  
 WEST**

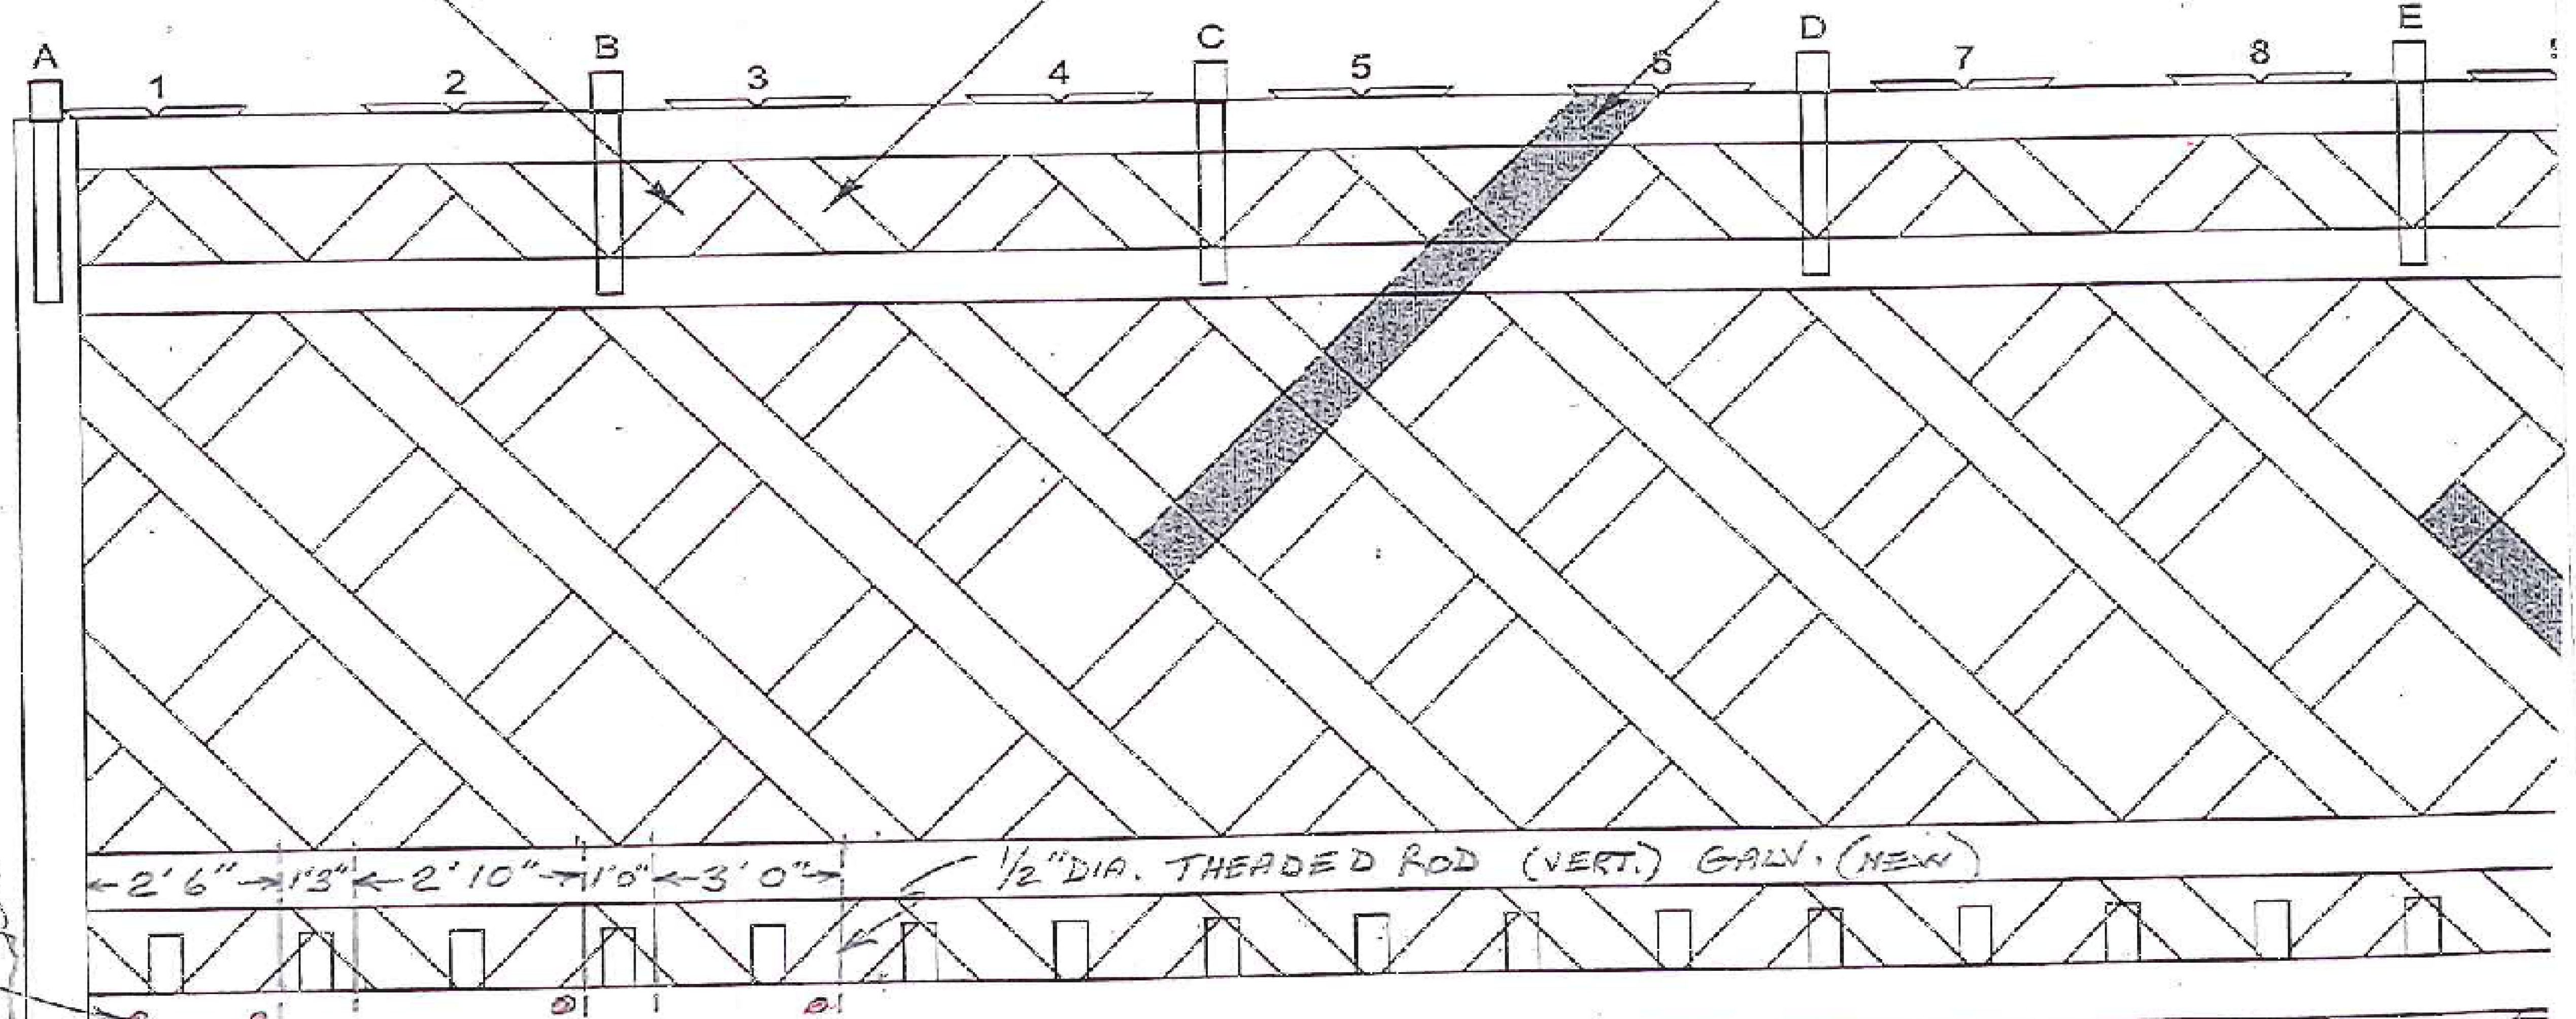

NEW  
 1/2" DIA. THREADED ROD  
 (HORZ.)  
 GALV.

1/2" DIA. THREADED ROD (VERT.) GALV. (NEW)

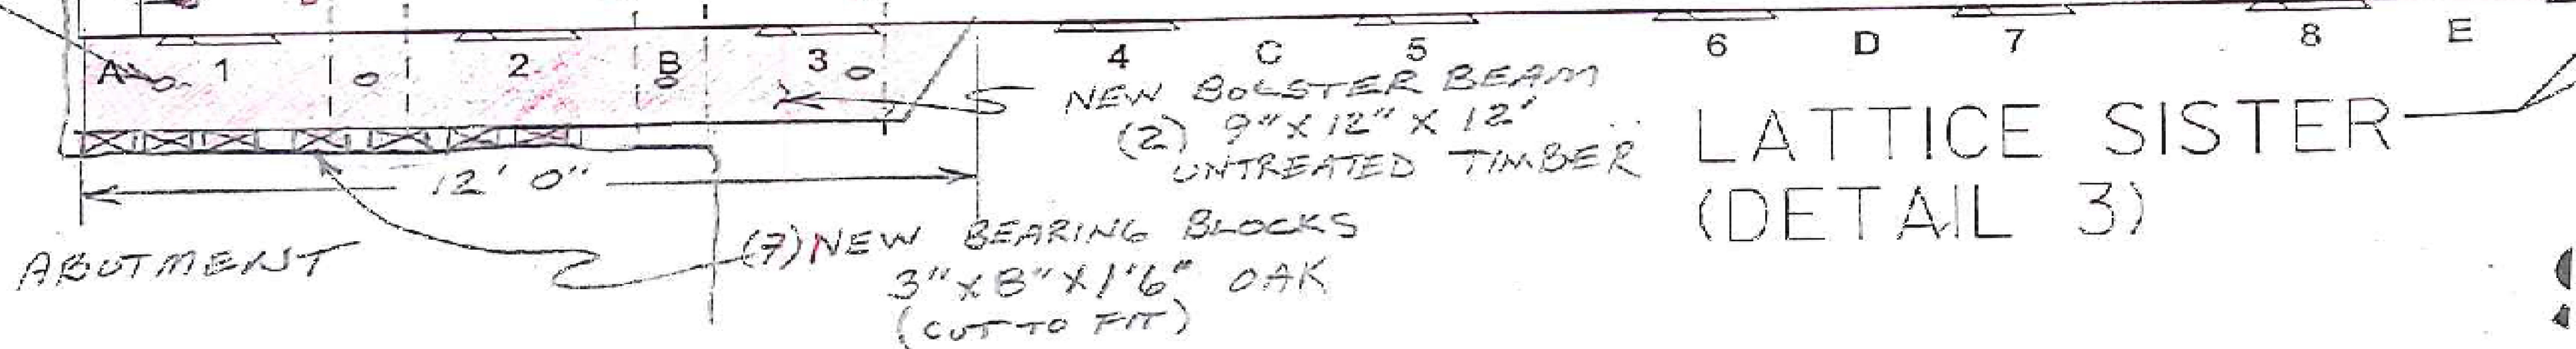

LATTICE SISTER  
 (DETAIL 3)