


SOUTHEAST CORNER
 NEW BOLSTER BEAM
 AND BEARING BLOCKS

9-20-15
 TL2

LATTICE SISTER
 SIMILAR TO DET. 1,
 SHEET II)

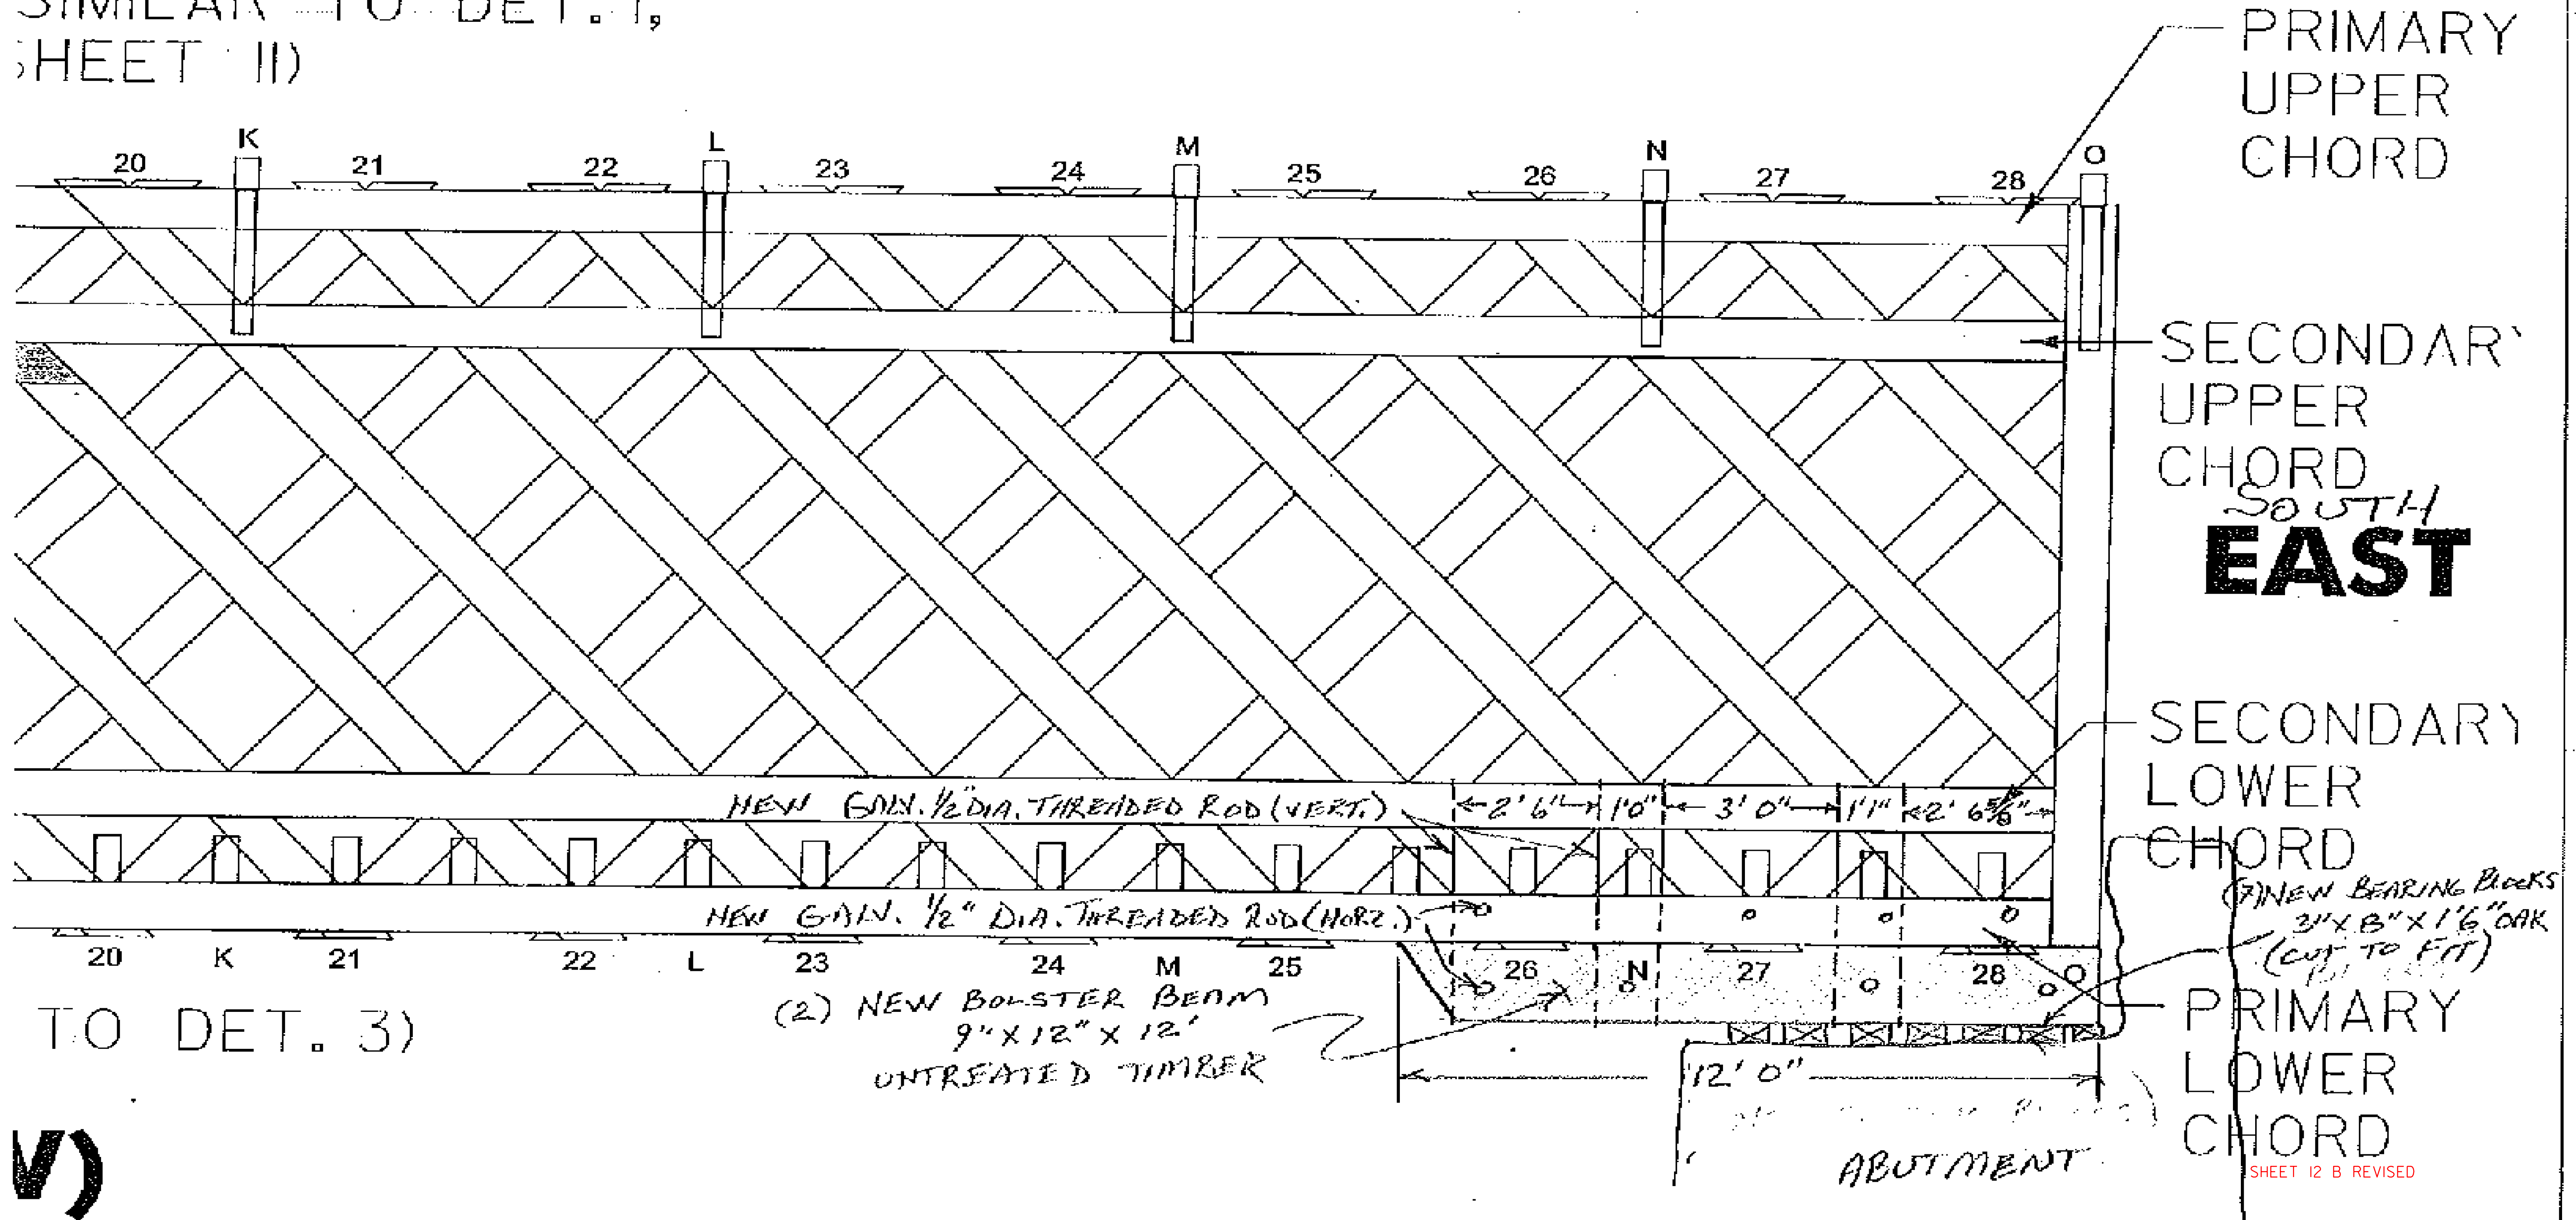

TO DET. 3)

V)