


WEST

EAST

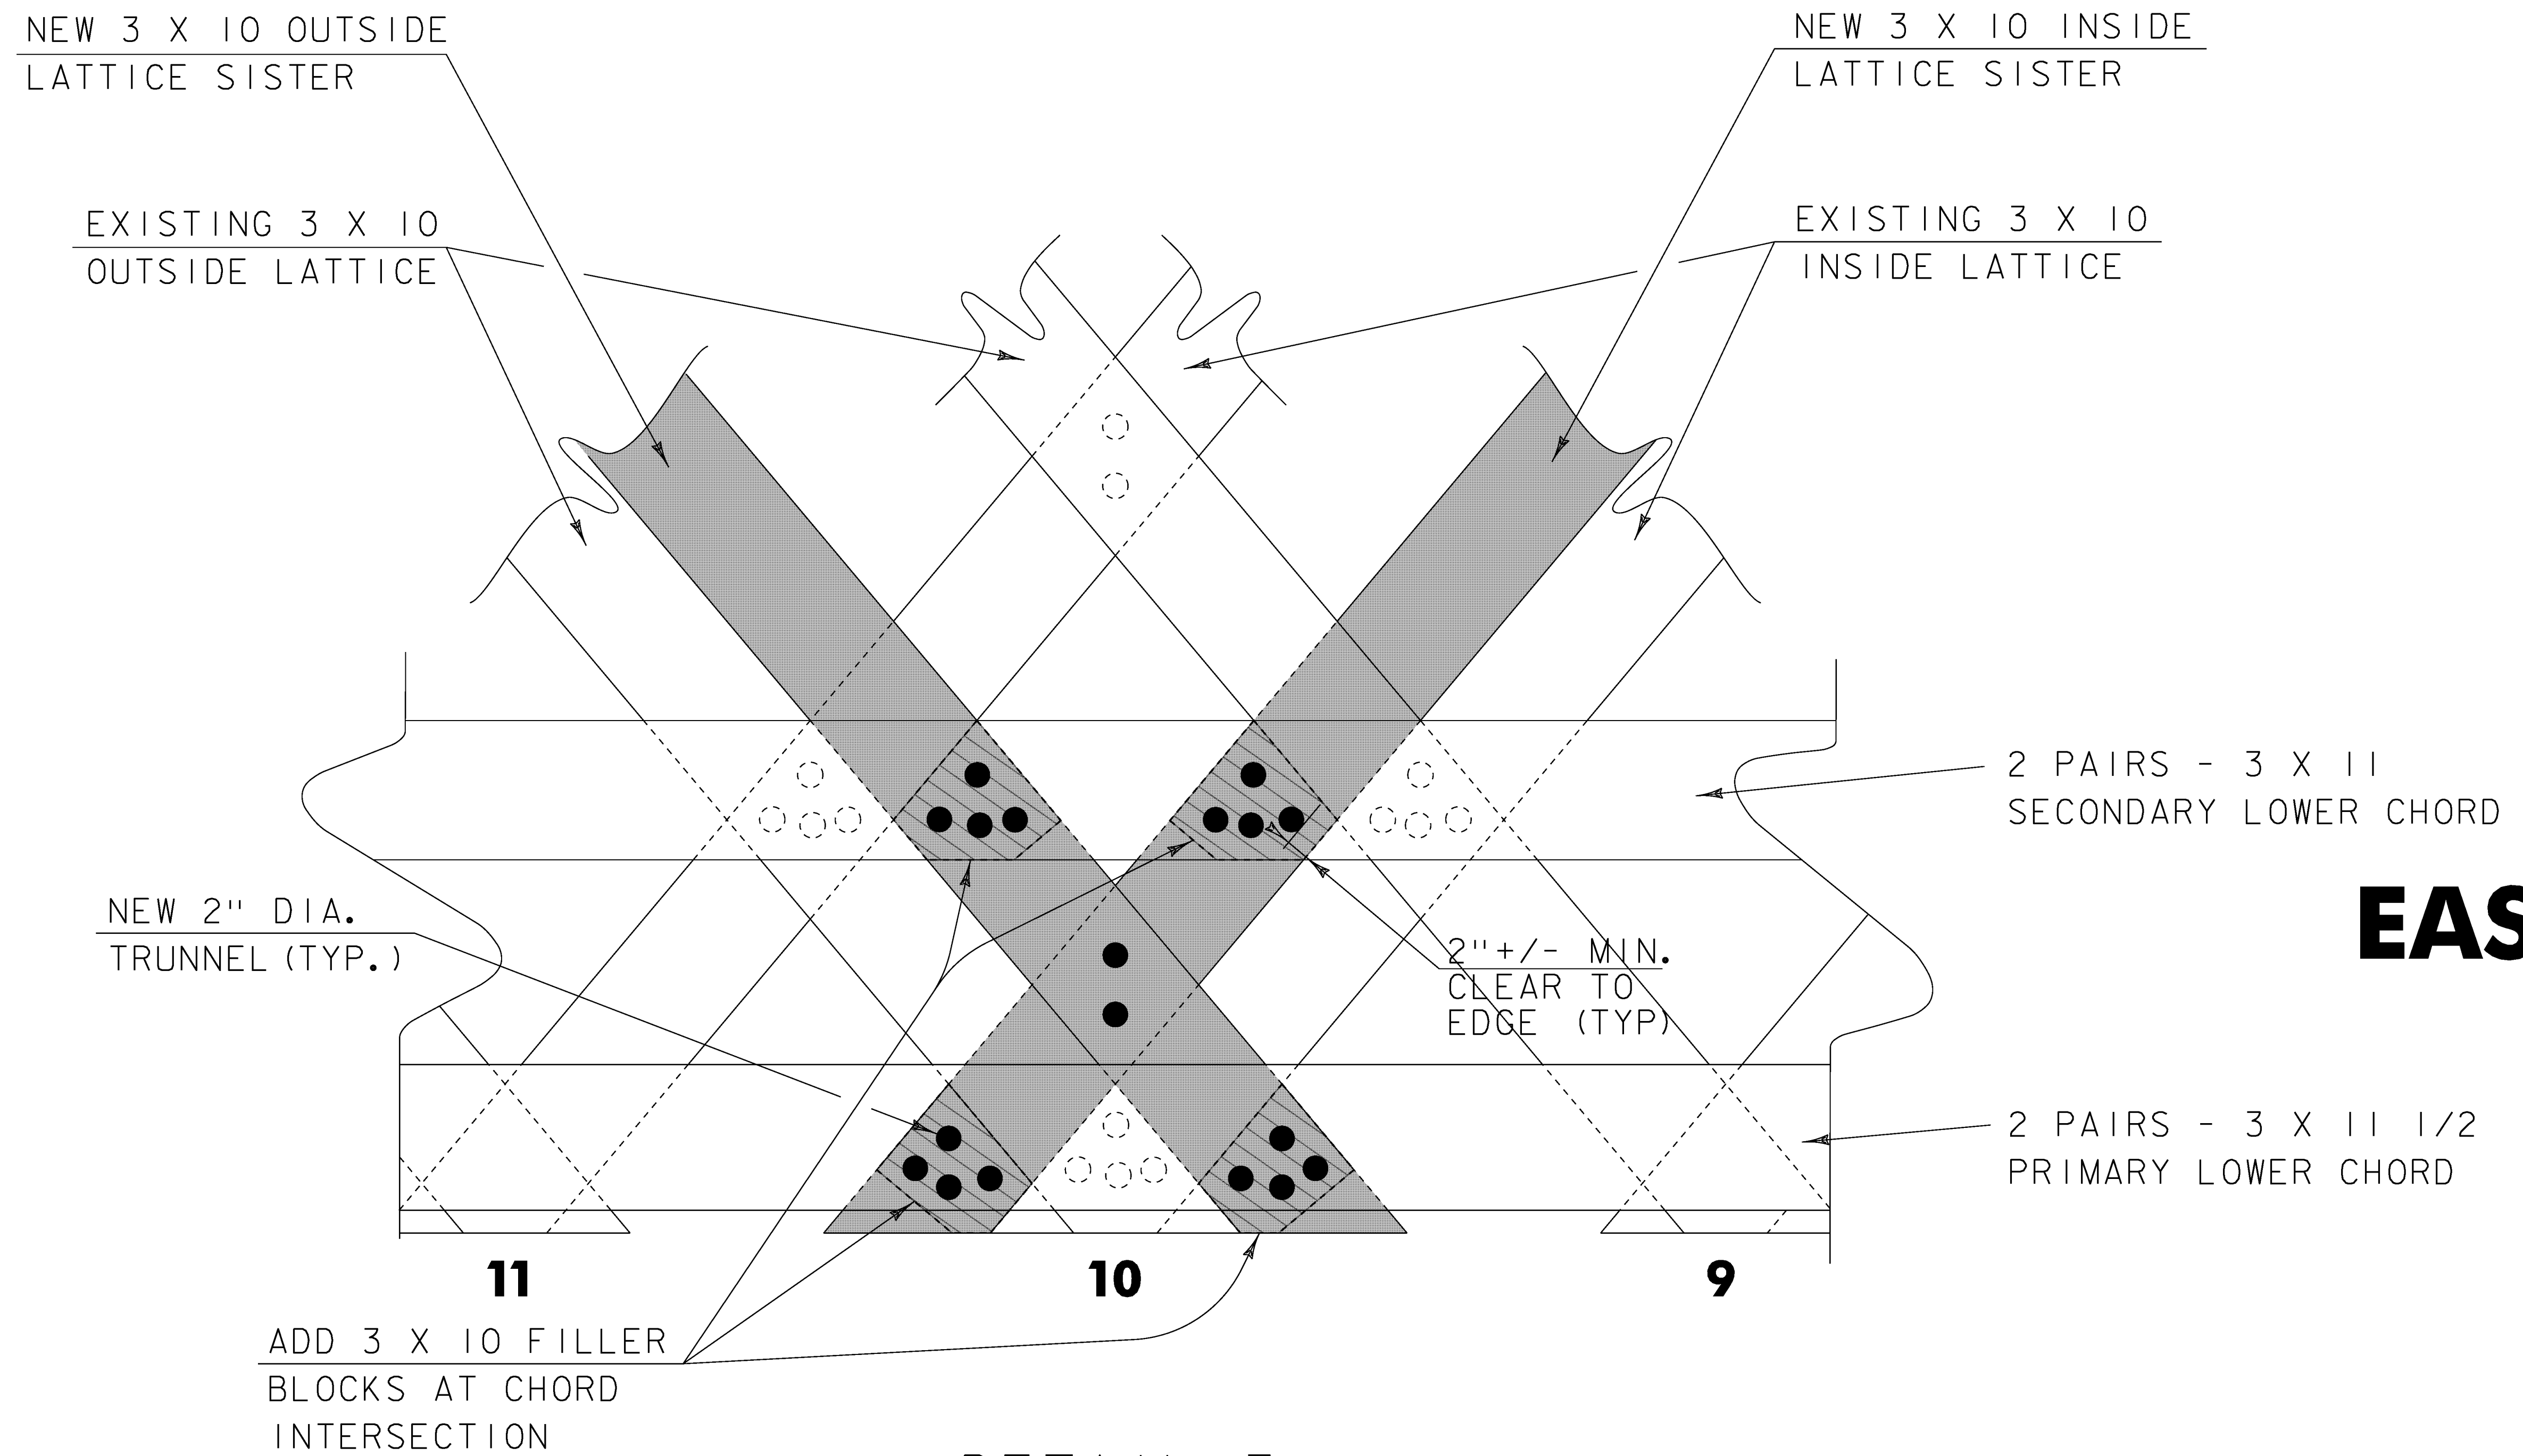

DETAIL 3
 OUTSIDE VIEW @ NODE 10*
 SOUTH TRUSS
 SCALE: 3/4" = 1' - 0"

* CONNECTION DETAILS AT OTHER NODE LOCATIONS ARE SIMILAR

LEGEND	
NEW LATTICE SISTER	
NEW FILLER BLOCK	
NEW TRUNNEL	
EXISTING TRUNNEL	

PROJECT NAME: SHREWSBURY	PLOT DATE: 11-DEC-2014
PROJECT NUMBER: BHO 1443(29)	DRAWN BY: STRI
FILE NAME: I2J350BridgeDetails	CHECKED BY: John Weaver
PROJECT LEADER: Mark Sargent	SHEET 13 OF 23
DESIGNED BY: John Weaver	LATTICE SISTER DETAILS