



INDEX OF SHEETS
SEE PAGE 2

STATE OF VERMONT AGENCY OF TRANSPORTATION

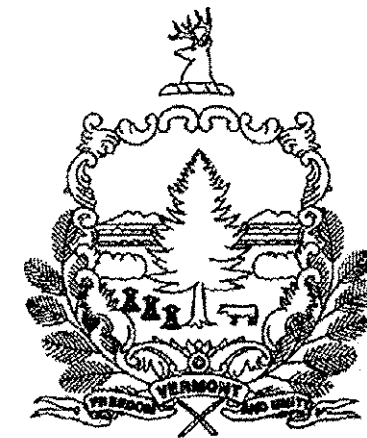

PROPOSED IMPROVEMENT

STATEWIDE NORTHEAST REGION STP HRRR(12) / HES HSIP(3)
TOWNS OF BARRE, DERBY, LYNDON AND WILLIAMSTOWN
COUNTIES OF WASHINGTON, ORLEANS, CALEDONIA AND ORANGE
VARIOUS TOWN HIGHWAYS

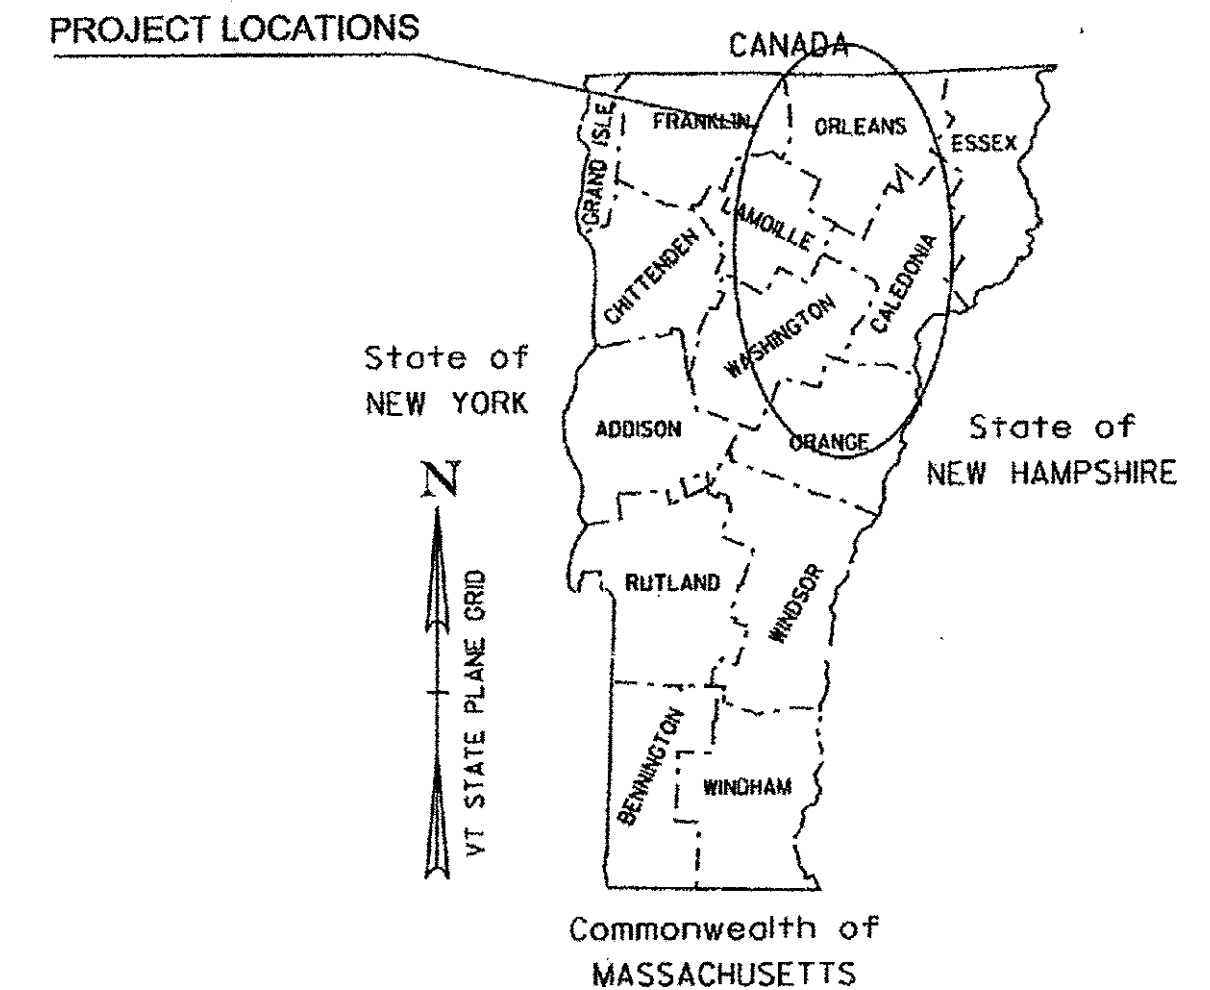

RECORD PLANS	
CONTRACTOR:	F. R. LAFAYETTE, INC. - ESSEX JUNCTION, VT
RESIDENT ENGINEER:	BRIGITTE CODLING
CONSTRUCTION BEGAN:	MAY 01, 2013
CONSTRUCTION COMPLETE:	JULY 17, 2013
RECORD PLANS BY:	BRIGITTE CODLING & CRAIG PIERCE
I HEREBY CERTIFY THAT ALL THE CONSTRUCTION REQUIRED BY THIS SET OF DRAWINGS HAS BEEN ACCOMPLISHED AS INDICATED HEREIN:	
BY <u>Brigitte Codling</u>	RESIDENT ENGINEER
DATE <u>January 21, 2014</u>	
NOTE: Any further information concerning final quantities, amounts or other details relative to this project may be found at Central Files in the electronic archives.	

PROJECT DESCRIPTION: WORK TO BE PERFORMED UNDER THIS PROJECT INCLUDES THE REMOVAL OF EXISTING SIGNS, SIGN POSTS, AND GUARDRAIL; THE INSTALLATION OF NEW SIGNS, SIGN POSTS, AND GUARDRAIL; PAVEMENT MARKINGS (CENTERLINE, EDGELINE, SYMBOLS AND LETTERS); AND OTHER RELATED HIGHWAY ITEMS FOR THE DESCRIBED WORK.

PROJECT LOCATIONS:	TH-38, TH-7, TH-1, TH-7,	MM MM MM MM	0.000 - 2.066 0.000 - 1.238 0.000 - 4.096 0.000 - 3.357	BARRE TOWN (EAST COBBLE HILL ROAD) DERBY (SHATTUCK HILL ROAD) LYNDON (SOUTH WHEELLOCK ROAD) WILLIAMSTOWN (GRANITEVILLE ROAD)	PROJECT LENGTHS:	2.066 MILES (10908.48 FT) 1.238 MILES (6536.84 FT) 4.096 MILES (21626.88 FT) 3.357 MILES (17724.96 FT)
TOTAL LENGTH: 10.757 MILES (56796.96 FT)						

STATEWIDE NORTHEAST REGION HES HSIP(3)

TOWN OF BARNET
COUNTY CALEDONIA
VARIOUS TOWN HIGHWAYS

PROJECT DESCRIPTION: WORK TO BE PERFORMED UNDER THIS PROJECT INCLUDES THE REMOVAL OF EXISTING SIGNS, AND SIGN POSTS; THE INSTALLATION OF NEW SIGNS, AND SIGN POSTS, AND OTHER RELATED ITEMS FOR THE DESCRIBED WORK.

PROJECT LOCATIONS:	TH-1,	MM	3.304 - 3.725	BARNET (WEST BARNET ROAD)	PROJECT LENGTH:	0.421 MILES (2222.88 FT)
--------------------	-------	----	---------------	---------------------------	-----------------	--------------------------

QUALITY ASSURANCE PROGRAM: LEVEL 3

CONVENTIONAL SYMBOLS	
COUNTY LINE	
TOWN LINE	
LIMITS OF ACCESS	
POINT OF ACCESS	
FENCE LINE	
STONE WALL	
TRAVELED WAY	
GUARD RAIL	
RAILROAD	
SURVEY LINE	
CULVERT	
POWER POLE	
TELEPHONE POLE	
TREES	
CONTROL OF ACCESS	
PROPERTY LINE	
R.O.W. TAKING LINE	
SLOPE RIGHTS	
TOP OF CUT	
TOE OF SLOPE	

SURVEYED BY : N/A	
SURVEYED DATE : N/A	
DATUM	
VERTICAL	N/A
HORIZONTAL	N/A

THESE PLANS ARE SUBJECT TO SUCH ENGINEERING CHANGES AS MAY BE REQUIRED BY THE FEDERAL HIGHWAY ADMINISTRATION OR THE DIRECTOR OF PROGRAM DEVELOPMENT.

CONSTRUCTION IS TO BE CARRIED ON IN ACCORDANCE WITH THESE PLANS AND THE STANDARD SPECIFICATIONS FOR CONSTRUCTION DATED 2011, AS APPROVED BY THE FEDERAL HIGHWAY ADMINISTRATION ON JULY 20, 2011 FOR USE ON THIS PROJECT, INCLUDING ALL SUBSEQUENT REVISIONS AND SUCH REVISED SPECIFICATIONS AND SPECIAL PROVISIONS AS ARE INCORPORATED IN THESE PLANS.

DIRECTOR OF PROGRAM DEVELOPMENT	
APPROVED <u>John Schultze</u>	DATE <u>2-9-12</u>
PROJECT MANAGER : JOSH SCHULTZ	
PROJECT NAME : STATEWIDE - NORTHEAST REGION	
PROJECT NUMBER : STP HRRR(12) / HES HSIP(3)	
SHEET 1 OF 52 SHEETS	