

INDEX OF SHEETS  
SEE SHEET 2


# STATE OF VERMONT AGENCY OF TRANSPORTATION



## PROPOSED IMPROVEMENT

STATEWIDE NORTHWEST REGION STP HRRR(13)

TOWNS OF BRISTOL, CHARLOTTE, ENOSBURG, FERRISBURGH, FRANKLIN, HIGHGATE,  
HYDE PARK, NEW HAVEN, SHELDON, STARKSBORO, STOWE AND WALTHAM  
COUNTIES OF ADDISON, CHITTENDEN, FRANKLIN, LAMOILLE  
VARIOUS TOWN HIGHWAYS

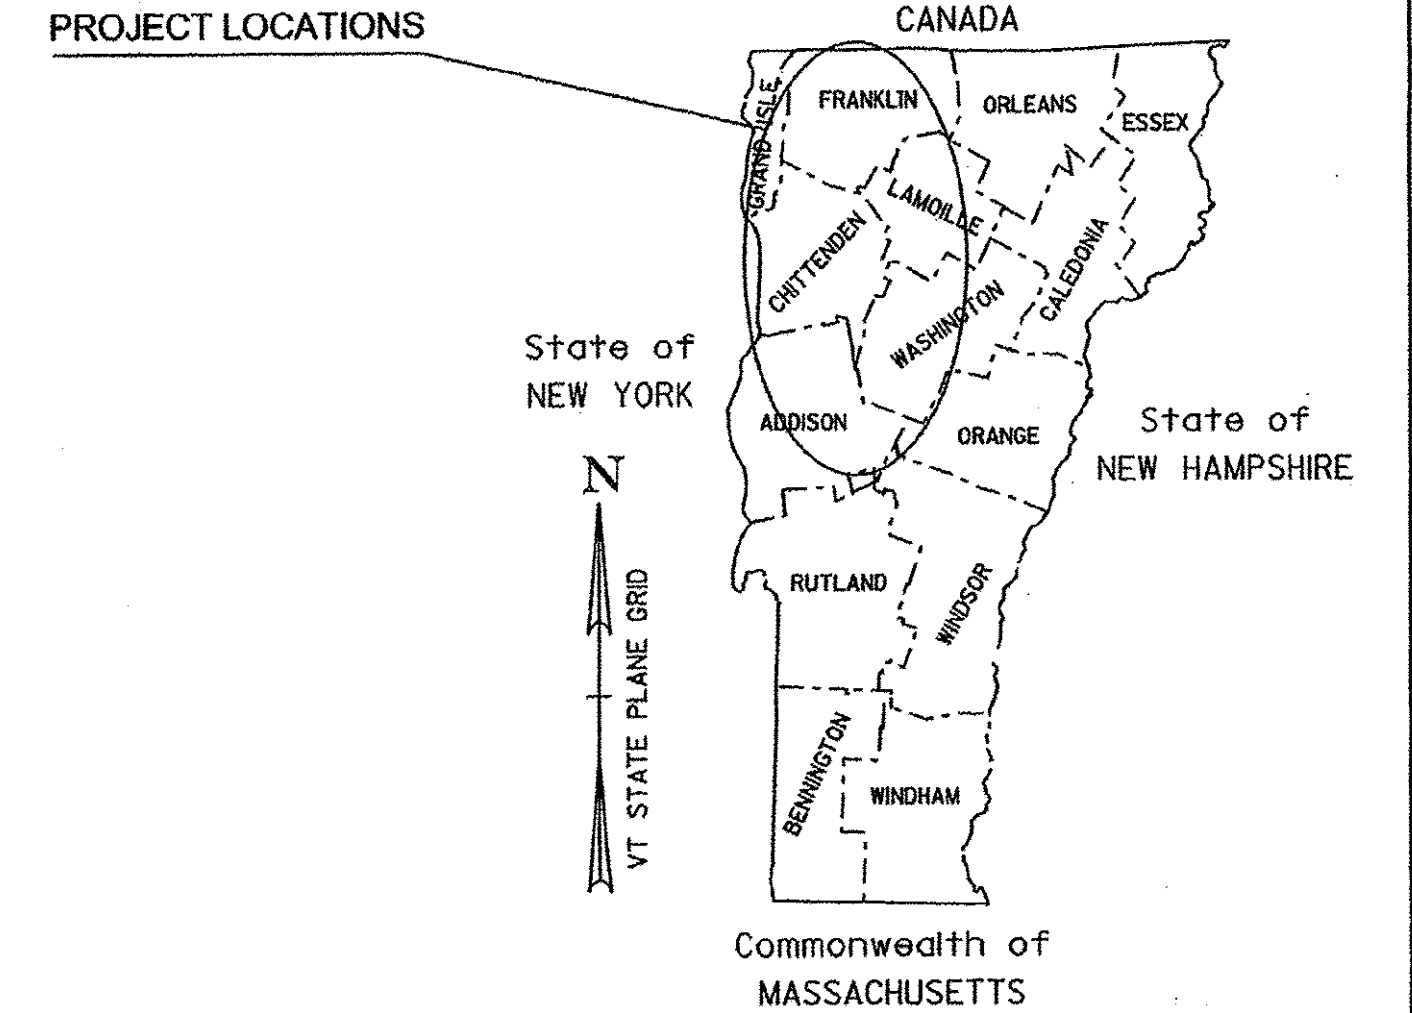

RECORD PLANS	
CONTRACTOR:	L&D SAFETY MARKINGS CORP. - BERLIN, VT
RESIDENT ENGINEER:	JEFF COTA
CONSTRUCTION BEGAN:	MAY 7, 2013
CONSTRUCTION COMPLETE:	JUNE 20, 2013
RECORD PLANS BY:	JEFF COTA & JENNA HYDE
I HEREBY CERTIFY THAT ALL THE CONSTRUCTION REQUIRED BY THIS SET OF DRAWINGS HAS BEEN ACCOMPLISHED AS INDICATED HEREIN.	
BY _____	RESIDENT ENGINEER
DATE <u>1/7/16</u>	
NOTE: Any further information concerning final quantities, amounts or other details relative to this project may be found at Central Files in the electronic archives.	

PROJECT DESCRIPTION: WORK TO BE PERFORMED UNDER THIS PROJECT INCLUDES THE REMOVAL OF EXISTING SIGNS, SIGN POSTS, AND GUARDRAIL; THE INSTALLATION OF NEW SIGNS, SIGN POSTS, AND GUARDRAIL; PAVEMENT MARKINGS (CENTERLINE, EDGELINE, SYMBOLS AND LETTERS); AND OTHER HIGHWAY RELATED ITEMS FOR THE DESCRIBED WORK.

PROJECT LOCATIONS:	TH	MM	0.000 -	MM	6.380	CHARLOTTE (MOUNT PHILO ROAD)
	TH-1,	MM	0.000 -	MM	1.568	CHARLOTTE (SPEAR STREET)
	TH-10,	MM	0.000 -	MM	3.595	ENOSBURG (PERLEY ROAD)
	TH-58,	MM	0.000 -	MM	1.254	HYDE PARK (CRICKET HILL ROAD)
	TH-9 / TH-53 / TH-9,	MM	0.000 -	MM	3.986	SHELDON / HIGHGATE / FRANKLIN (RICE HILL ROAD)
	TH-5,	MM	0.000 -	MM	5.300	STARKSBORO (BIG HOLLOW ROAD)
	TH-5,	MM	0.000 -	MM	4.557	STOWE (STOWE HOLLOW ROAD)
	TH-3 / TH-54 / TH-9 / TH-20,	MM	0.000 -	MM	8.187	WALTHAM / FERRISBURGH / NEW HAVEN / BRISTOL (PLANK ROAD)

PROJECT LENGTHS:	6.380 MILES	(33686.40 FT)
	1.568 MILES	(8279.04 FT)
	3.595 MILES	(18981.60 FT)
	1.254 MILES	(6621.12 FT)
	3.986 MILES	(21046.08 FT)
	5.300 MILES	(27984.00 FT)
	4.557 MILES	(24060.96 FT)
	8.187 MILES	(43227.36 FT)
TOTAL LENGTH:	34.827 MILES	(183886.56 FT)

### STATEWIDE NORTHWEST REGION HES HSIP(4) TOWNS OF BURLINGTON, COLCHESTER, HINESBURG, AND MILTON COUNTY OF CHITTENDEN VARIOUS TOWN HIGHWAYS

PROJECT DESCRIPTION: WORK TO BE PERFORMED UNDER THIS PROJECT INCLUDES THE REMOVAL OF EXISTING SIGNS, SIGN POSTS, AND GUARDRAIL; THE INSTALLATION OF NEW SIGNS, SIGN POSTS, AND GUARDRAIL; PAVEMENT MARKINGS (CENTERLINE, EDGELINE, SYMBOLS AND LETTERS); AND OTHER HIGHWAY RELATED ITEMS FOR THE DESCRIBED WORK.

PROJECT LOCATIONS:	TH	MM	0.000 -	MM	0.758	BURLINGTON (ROUTE 127)
	TH-10,	MM	1.550 -	MM	2.222	COLCHESTER (PRIM ROAD STREET)
	TH-1,	MM	0.000 -	MM	0.146	COLCHESTER (W. LAKESHORE ROAD)
	TH-2,	MM	1.510 -	MM	1.867	HINESBURG (RICHMOND ROAD)
	TH-3,	MM	0.000 -	MM	1.324	MILTON (LAKE ROAD)
	TH-2,	MM	2.688 -	MM	3.000	MILTON (WESTFORD ROAD)
	TH-1,	MM	0.000 -	MM	1.525	MILTON (MIDDLE ROAD)

PROJECT LENGTHS:	0.758 MILES	(4002.24 FT)
	0.672 MILES	(3548.16 FT)
	0.146 MILES	(770.88 FT)
	0.357 MILES	(1884.96 FT)
	1.324 MILES	(6990.72 FT)
	0.312 MILES	(1647.36 FT)
	1.525 MILES	(8052.00 FT)
TOTAL LENGTH:	5.094 MILES	(26896.32 FT)

QUALITY ASSURANCE PROGRAM: LEVEL 3

#### CONVENTIONAL SYMBOLS

COUNTY LINE	
TOWN LINE	
LIMITS OF ACCESS	
POINT OF ACCESS	
FENCE LINE	
STONE WALL	
TRAVELED WAY	
GUARD RAIL	
RAILROAD	
SURVEY LINE	
CULVERT	
POWER POLE	
TELEPHONE POLE	
TREES	
CONTROL OF ACCESS	
PROPERTY LINE	
R.O.W. TAKING LINE	
SLOPE RIGHTS	
TOP OF CUT	
TOE OF SLOPE	

SURVEYED BY : N/A  
SURVEYED DATE : N/A

#### DATUM

VERTICAL N/A  
HORIZONTAL N/A

THESE PLANS ARE SUBJECT TO SUCH ENGINEERING CHANGES AS MAY BE REQUIRED BY THE FEDERAL HIGHWAY ADMINISTRATION OR THE DIRECTOR OF PROGRAM DEVELOPMENT.

CONSTRUCTION IS TO BE CARRIED ON IN ACCORDANCE WITH THESE PLANS AND THE STANDARD SPECIFICATIONS FOR CONSTRUCTION DATED 2011, AS APPROVED BY THE FEDERAL HIGHWAY ADMINISTRATION ON JULY 20, 2011 FOR USE ON THIS PROJECT, INCLUDING ALL SUBSEQUENT REVISIONS AND SUCH REVISED SPECIFICATIONS AND SPECIAL PROVISIONS AS ARE INCORPORATED IN THESE PLANS.

DIRECTOR OF PROGRAM DEVELOPMENT

APPROVED DATE 7-16-12

PROJECT MANAGER : JOSH SCHULTZ

PROJECT NAME : STATEWIDE - NORTHWEST REGION  
PROJECT NUMBER : STP HRRR(13) / HES HSIP(4)

SHEET 1 OF 107 SHEETS