


INDEX OF SHEETS  
SEE SHEET 2

# STATE OF VERMONT AGENCY OF TRANSPORTATION



## PROPOSED IMPROVEMENT

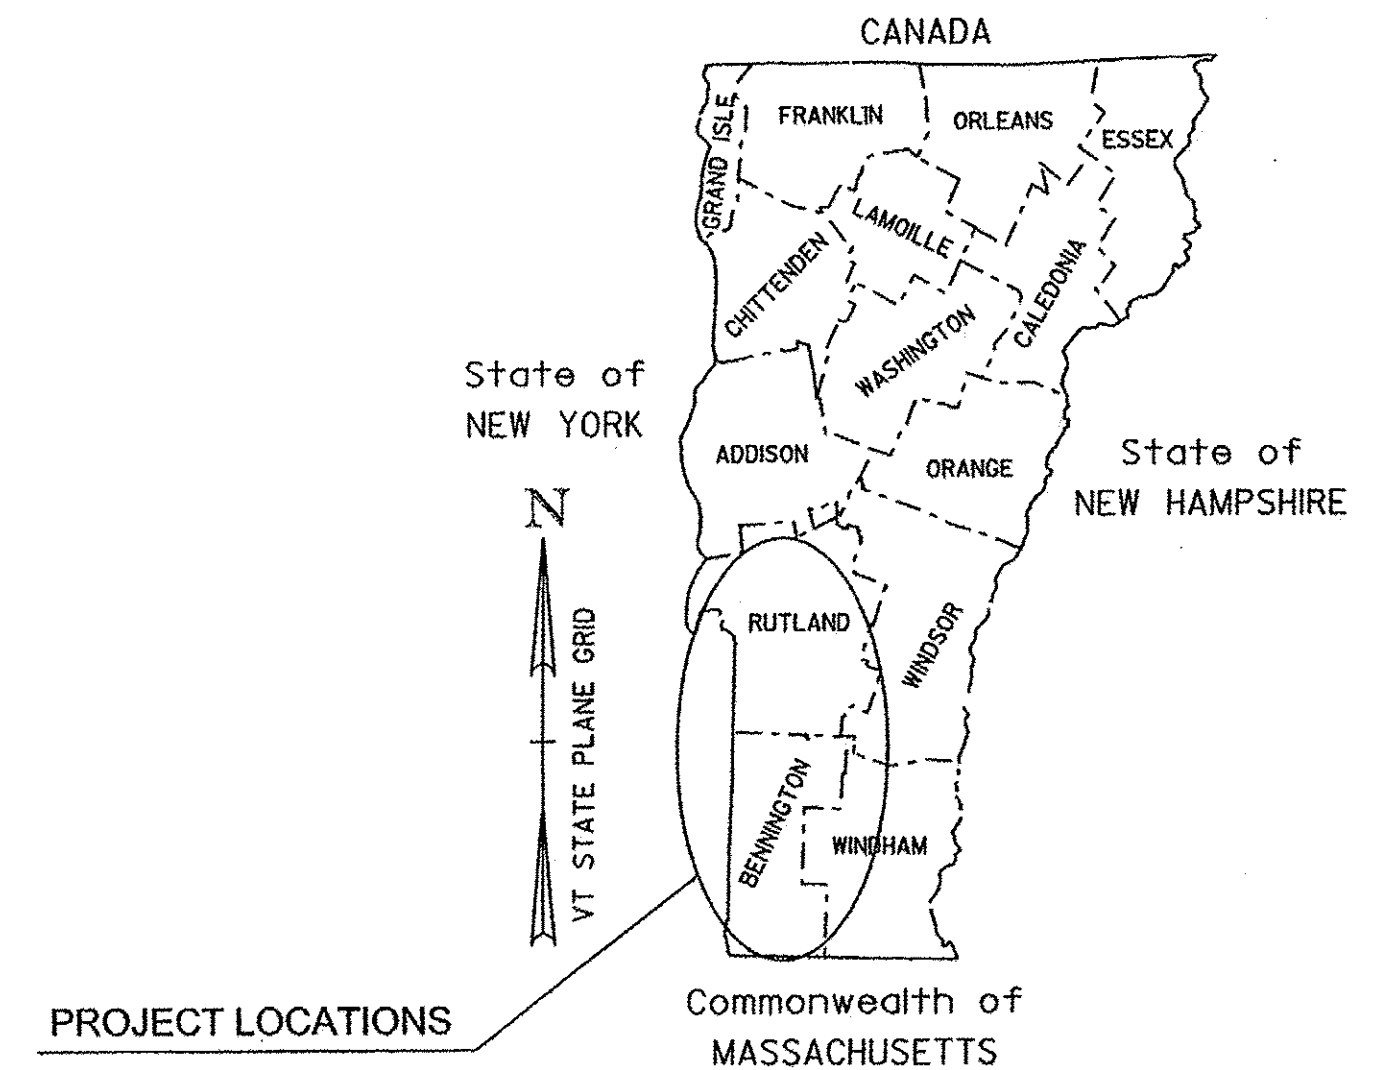

### STATEWIDE SOUTHWEST REGION STP HRRR(15) TOWNS OF BENNINGTON, BENSON, CASTLETON, MANCHESTER COUNTIES OF BENNINGTON AND RUTLAND

PROJECT DESCRIPTION: WORK TO BE PERFORMED UNDER THIS PROJECT INCLUDES THE REMOVAL OF EXISTING SIGNS AND POSTS, AND GUARDRAIL, AND THE INSTALLATION OF NEW SIGNS AND POSTS, GUARDRAIL, PAVEMENT MARKINGS, AND OTHER HIGHWAY RELATED ITEMS FOR THE DESCRIBED WORK.

PROJECT LOCATIONS:	TH-5, BENNINGTON	MM 0.000 - 1.860 (EAST ROAD)	PROJECT LENGTHS: 1.860 MILES (9820.80 FT)
	TH-14, BENNINGTON	MM 0.000 - 0.066 (HOUGHTON ROAD)	0.066 MILES (348.5 FT)
	TH-2 (SHTH 144), BENSON	MM 0.000 - 4.221 (VT ROUTE 144)	4.221 MILES (22286.9 FT)
	TH-3, CASTLETON	MM 0.000 - 3.272 (EAST HUBBARDTON ROAD)	3.272 MILES (17276.2 FT)
	TH-2, MANCHESTER	MM 0.000 - 3.380 (WEST ROAD)	3.380 MILES (17846.4 FT)
			12.799 MILES (67578.7 FT)

### STATEWIDE SOUTHWEST REGION HES HSIP(6) TOWNS OF BENNINGTON, DANBY, NEW HAVEN, AND THE CITY OF RUTLAND COUNTIES OF ADDISON, BENNINGTON AND RUTLAND

PROJECT DESCRIPTION: WORK TO BE PERFORMED UNDER THIS PROJECT INCLUDES THE REMOVAL OF EXISTING SIGNS AND POSTS, AND GUARDRAIL, AND THE INSTALLATION OF NEW SIGNS AND POSTS, GUARDRAIL, PAVEMENT MARKINGS, AND OTHER HIGHWAY RELATED ITEMS FOR THE DESCRIBED WORK.

PROJECT LOCATIONS:	TH-11, BENNINGTON	MM 0.000 - 0.382 (MATTESON ROAD)	PROJECT LENGTHS: 0.382 MILES (2016.96 FT.)	
	TH-1, BENNINGTON	MM 2.730 - 2.893 (SOUTH STREET)	0.163 MILES (860.64 FT.)	
	TH-424, BENNINGTON	MM 0.000 - 0.047 (FRANKLIN LANE)	0.047 MILES (248.16 FT.)	
	TH-5, BENNINGTON	MM 0.000 - 0.402 (PARK STREET)	0.402 MILES (2122.56 FT.)	
	TH-1, DANBY	MM 4.950 - 5.314 (BROOK ROAD)	0.364 MILES (1921.92 FT.)	
	TH-30, DANBY	MM 0.000 - 0.057 (KEELER ROAD)	0.057 MILES (300.96 FT.)	
	TH-2, NEW HAVEN	MM 0.000 - 0.513 (RIVER ROAD)	0.513 MILES (2708.64 FT.)	
	TH-235, RUTLAND	MM 0.000 - 1.320 (LINCOLN AVENUE)	1.320 MILES (6969.60 FT.)	
				3.248 MILES (17149.44 FT.)

QUALITY ASSURANCE PROGRAM: LEVEL 3

#### CONVENTIONAL SYMBOLS

COUNTY LINE	
TOWN LINE	
LIMITS OF ACCESS	
POINT OF ACCESS	
FENCE LINE	
STONE WALL	
TRAVELED WAY	
GUARD RAIL	
RAILROAD	
SURVEY LINE	
CULVERT	
POWER POLE	
TELEPHONE POLE	
TREES	
CONTROL OF ACCESS	
PROPERTY LINE	
R.O.W. TAKING LINE	
SLOPE RIGHTS	
TOP OF CUT	
TOE OF SLOPE	

SURVEYED BY : N/A  
SURVEYED DATE : N/A

DATUM  
VERTICAL N/A  
HORIZONTAL N/A

RECORD PLANS	
CONTRACTOR:	F. R. LAFAYETTE, INC. - ESSEX JUNCTION, VT
RESIDENT ENGINEER:	JUDY GILMORE
CONSTRUCTION BEGAN:	APRIL 15, 2013
CONSTRUCTION COMPLETE:	AUGUST 21, 2013
RECORD PLANS BY:	JUDY GILMORE & NICK GARBACK
I HEREBY CERTIFY THAT ALL THE CONSTRUCTION REQUIRED BY THIS SET OF DRAWINGS HAS BEEN ACCOMPLISHED AS INDICATED HEREIN.	
BY	RESIDENT ENGINEER
DATE	27 April 2014
NOTE: Any further information concerning final quantities, amounts or other details relative to this project may be found at Central Files in the electronic archives.	

THESE PLANS ARE SUBJECT TO SUCH ENGINEERING CHANGES AS MAY BE REQUIRED BY THE FEDERAL HIGHWAY ADMINISTRATION OR THE DIRECTOR OF PROGRAM DEVELOPMENT.  
CONSTRUCTION IS TO BE CARRIED ON IN ACCORDANCE WITH THESE PLANS AND THE STANDARD SPECIFICATIONS FOR CONSTRUCTION DATED 2011, AS APPROVED BY THE FEDERAL HIGHWAY ADMINISTRATION ON JULY 20, 2011 FOR USE ON THIS PROJECT, INCLUDING ALL SUBSEQUENT REVISIONS AND SUCH REVISED SPECIFICATIONS AND SPECIAL PROVISIONS AS ARE INCORPORATED IN THESE PLANS.

DIRECTOR OF PROGRAM DEVELOPMENT	APPROVED	DATE 8-7-12
PROJECT MANAGER : JOSH SCHULTZ		
PROJECT NAME : STATEWIDE SOUTHWEST REGION		
PROJECT NUMBER : STP HRRR(15) / HES HSIP(6)		
SHEET 1 OF 90 SHEETS		