








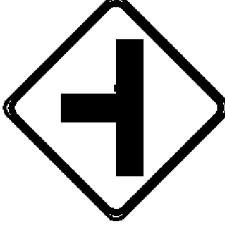

DIRECTION	MILEMARKER, STATION, OR SIGN NUMBER	LOCATION	MANUAL ON UNIFORM TRAFFIC DEVICES OR STATE CODE	SIGN DIMENSIONS		SHEETING REMARKS	SIGN LEGEND	NEW SIGNS		EXISTING SIGNS					EXISTING POST	NO. OF NEW POSTS	SQUARE STEEL (in)			TUBULAR STEEL (in)				SIGN FRAME REQUIRED	REMARKS SHSM = STANDARD HIGHWAY SIGN & MARKING BOOK	SIGN DETAIL			
				WIDTH	HEIGHT			"A"	"B"	RETAIN	SALVAGE FROM	SALVAGE TO	REMOVE	RETAIN			REMOVE	FT	FT	FT	LB	LB	LB			LB	DETAIL IN SHSM	DETAIL ON SHEET NUMBER	STANDARD SHEET NUMBER

SB	MM 0.764, LT.	F	W2-2L	30	30			6.25																INSTALL NEW W2-2 L SIGN AND POST. LOCATION IS 25' SOUTH OF POLE # 65T/4/25/<4-3/37.	X			
		F	W16-8P	24	8			1.33																INSTALL NEW W16-8P SIGN BELOW THE W2-2 LT SIGN. LOCATION IS 25' SOUTH OF POLE # 65T/4/25/<4-3/37.		13		
NB	MM 0.764, RT.	A	R2-1	24	30			5.00					X	X	1.00									REPLACE THE EXISTING R2-1 AND POST LOCATED 25' SOUTH AND ACROSS FROM POLE # 65T/4/25/<4-3/37.	X			
NB	MM 0.864, RT.	D	R1-1	30	30			6.25					X	X	1.00									REPLACE THE EXISTING R1-1 AND POST LOCATED ON THE NORTH WEST SIDE OF BRIGHTWOOD RD.	X			
NB	MM 1.209, RT.	A	R2-1	24	30			5.00							1.00									INSTALL NEW R2-1 AND POST LOCATED ACROSS FROM POLE # 52 / 39.	X			
SB	MM 1.209, LT.	F	R2-1	24	30			5.00					X	X	1.00									REPLACE THE EXISTING R2-1 AND POST LOCATED ADJACENT TO # 52 / 39.	X			
NB	MM 1.277, RT.	A	R2-1	24	30								X	X										REMOVE EXISTING R2-1 AND POST LOCATED ACROSS FROM POLE # 161 / 55.				
SB	MM 1.280, LT.	F	W3-5	36	36			9.00							2.00									INSTALL A NEW SRS SL-30 SIGN AND POST, LOCATION IS 30' NORTH OF POLE # 161 / 55.	X			
SB	MM 1.300, LT.	F E	D3-1	54	12			4.50					X	X	2.00									REPLACE THE EXISTING D3-1 OVER THE R1-1 SIGN. INSTALL NEW D3-1 ON 2-POST ADJACENT TO R1-1 LOCATED ON THE SOUTHEAST SIDE OF POWDERHAM RD.			13	

FINAL POST LENGTHS ARE TO BE DETERMINED IN THE FIELD. POST SIZES ARE COMPUTED BASED ON INFORMATION FURNISHED ON THE STANDARD SHEETS AND THE VTRANS "SIGN POST DESIGN GUIDE".

* TOWN RELOCATED SIGNS TO WHERE THEY WANTED THEM

SF
42.33
51.33

SF

EA
5

EA
5

EA
9

FT
135
123.75

EA

LB

PROJECT NAME: STATEWIDE SOUTHWEST REGION
PROJECT NUMBER: STP HRRR(15)

FILE NAME: I2k024frm.dgn
PROJECT LEADER: JLS
DESIGNED BY: NLA
MANCHESTER TRAFFIC SIGN SUMMARY SHT 3

PLOT DATE: 06-AUG-2012
DRAWN BY: TDS
CHECKED BY: NLA
SHEET 40 OF 90