



INDEX OF SHEETS
SEE SHEET 2

STATE OF VERMONT
AGENCY OF TRANSPORTATION

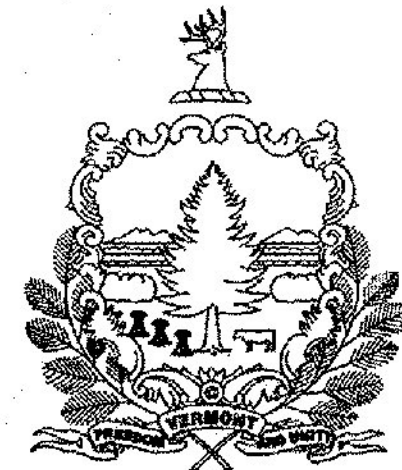

PROPOSED IMPROVEMENT
BRIDGE PROJECT
TOWNS OF CASTLETON & RUTLAND
COUNTY OF RUTLAND
PROJECT BF MEMB(37)

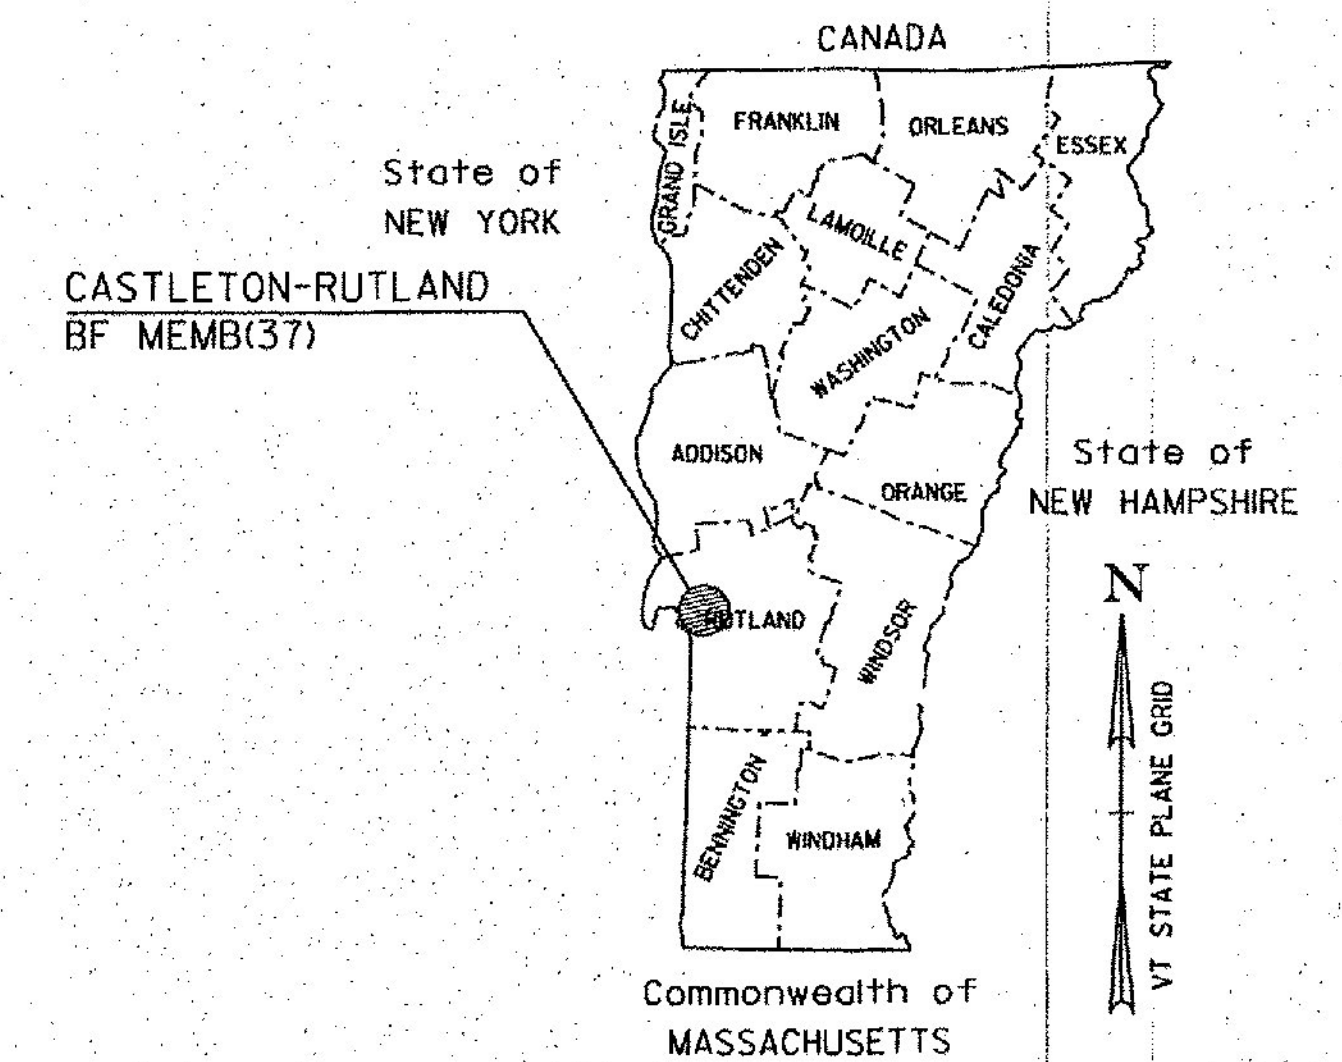

RECORD PLANS	
CONTRACTOR:	COLD RIVER BRIDGES, LLC - KEENE, NH
RESIDENT ENGINEER:	TIM POCKETT
CONSTRUCTION BEGAN:	JUNE 17, 2014
CONSTRUCTION COMPLETE:	OCTOBER 7, 2014
RECORD PLANS BY:	TIM POCKETT & CRAIG PIERCE
I HEREBY CERTIFY THAT ALL THE CONSTRUCTION REQUIRED BY THIS SET OF DRAWINGS HAS BEEN ACCOMPLISHED AS INDICATED HEREIN.	
BY:	<i>[Signature]</i> RESIDENT ENGINEER
DATE:	02-24-16
NOTE: Any further information concerning final quantities, amounts or other details relative to this project may be found at Central Files in the electronic archives.	

ROUTE NO.: T.H. NO. 5 (NORTH ROAD)
CASTLETON STATE HIGHWAY (EAST HUBBARDTON ROAD)
T.H. NO. 22 (QUARTERLINE ROAD)

BRIDGE NO.: D11, 2, D18

PROJECT LOCATIONS: CASTLETON - BR D11 OVER US 4 (MM 35.00) (T.H. NO. 5 - NORTH ROAD)
CASTLETON - BR 2 OVER US 4 (MM 2.02) (CASTLETON STATE HIGHWAY - EAST HUBBARDTON ROAD)
RUTLAND TOWN - BR D18 OVER US 4 (TH NO. 22 - QUARTERLINE ROAD)
APPROXIMATELY 2.1 MILES WEST OF US 4 JUNCTION WITH US 7

PROJECT DESCRIPTION: THIS PROJECT INVOLVES REMOVING AND REPLACING THE SHEET MEMBRANE WATERPROOFING AND BITUMINOUS CONCRETE PAVEMENT ON THE BRIDGE AND ITS APPROACHES ALONG WITH MINOR RELATED WORK.

LENGTH OF STRUCTURES: BR D11 408.14'
BR 2 261.11'
BR D18 371.21'



TOTAL LENGTH OF STRUCTURES: 1040.46'

QUALITY ASSURANCE PROGRAM: LEVEL I

CLD CONSULTING ENGINEERS
540 Commercial Street, Manchester, NH 03101
(603) 666-8223 • Fax: (603) 666-8802
clde@cldeengineers.com • www.cldengineers.com
Maine • New Hampshire • Vermont

CONVENTIONAL SYMBOLS

COUNTY LINE	
TOWN LINE	
LIMITS OF ACCESS	
POINT OF ACCESS	
FENCE LINE	
STONE WALL	
TRAVELED WAY	
GUARD RAIL	
RAILROAD	
SURVEY LINE	
CULVERT	
POWER POLE	
TELEPHONE POLE	
TREES	
CONTROL OF ACCESS	
PROPERTY LINE	
R.O.W. TAKING LINE	
SLOPE RIGHTS	
TOP OF CUT	
TOE OF SLOPE	

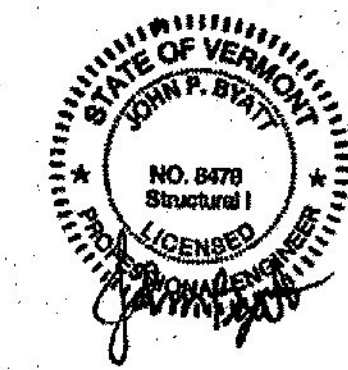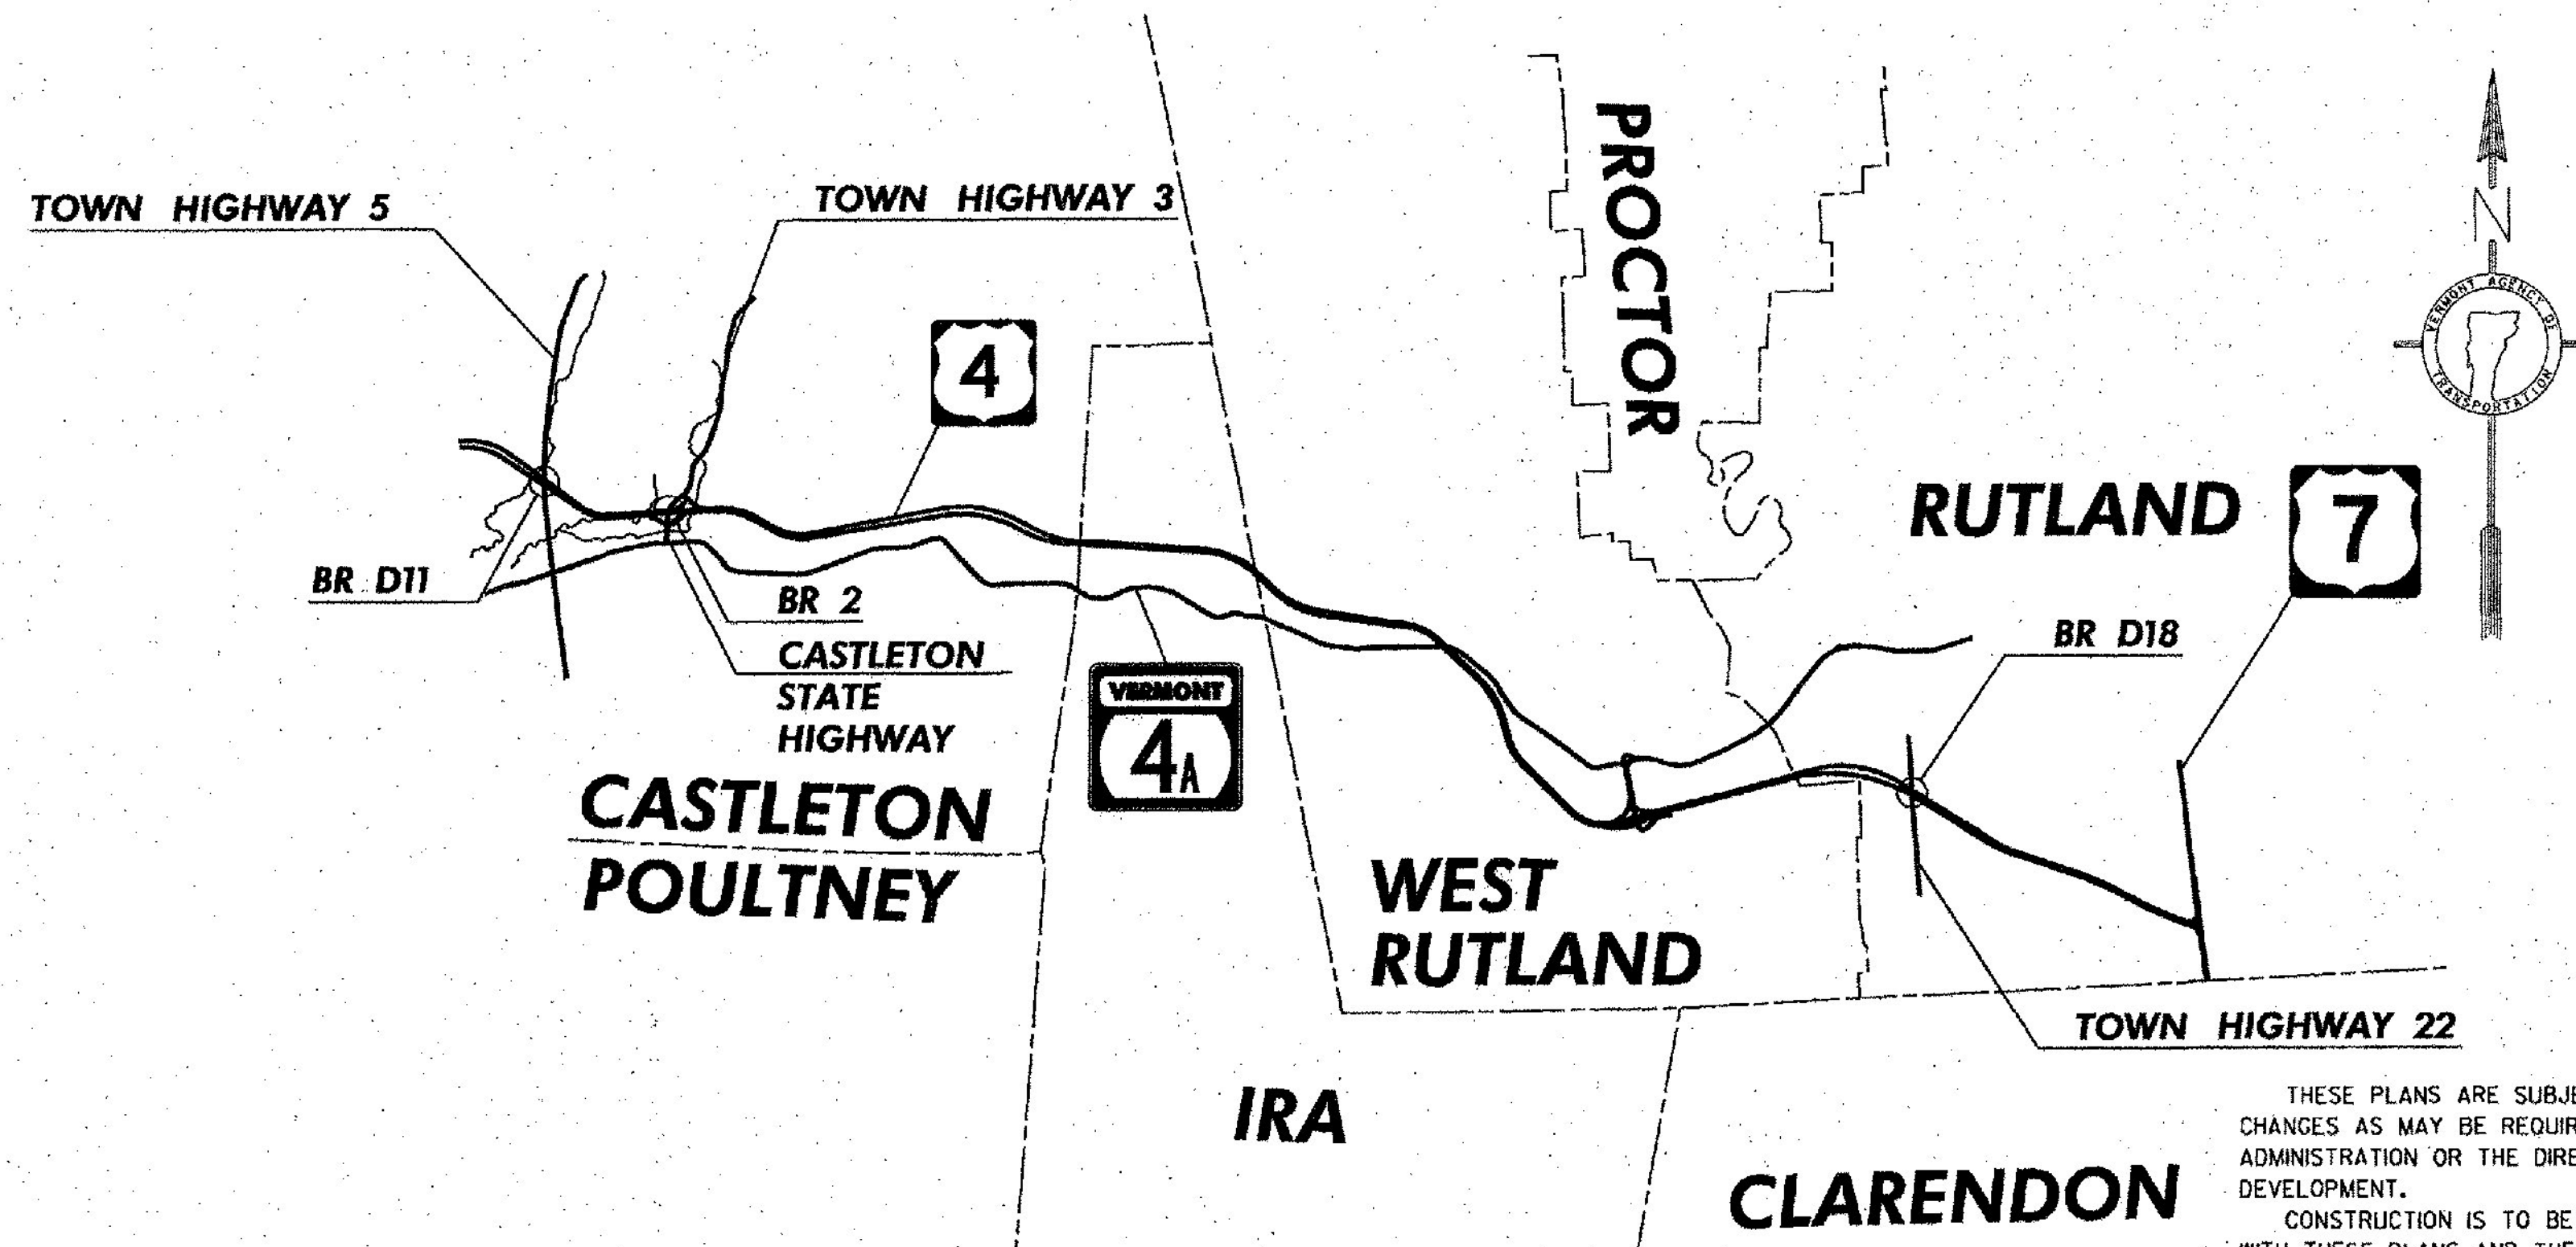

THESE PLANS ARE SUBJECT TO SUCH ENGINEERING CHANGES AS MAY BE REQUIRED BY THE FEDERAL HIGHWAY ADMINISTRATION OR THE DIRECTOR OF PROGRAM DEVELOPMENT.
CONSTRUCTION IS TO BE CARRIED ON IN ACCORDANCE WITH THESE PLANS AND THE STANDARD SPECIFICATIONS FOR CONSTRUCTION DATED 2011, AS APPROVED BY THE FEDERAL HIGHWAY ADMINISTRATION ON JULY 20, 2011 FOR USE ON THIS PROJECT, INCLUDING ALL SUBSEQUENT REVISIONS AND SUCH REVISED SPECIFICATIONS AND SPECIAL PROVISIONS AS ARE INCORPORATED IN THESE PLANS.

DIRECTOR OF PROGRAM DEVELOPMENT	APPROVED <i>[Signature]</i> DATE 2-27-14
PROJECT MANAGER : DOUGLAS BONNEAU, P.E.	
PROJECT NAME : CASTLETON-RUTLAND	
PROJECT NUMBER: BF MEMB(37)	
SHEET 1 OF 28 SHEETS	