


PLAN  
Scale: 1" = 30'

**GENERAL NOTES**

- SPECIFICATIONS:**  
All materials and construction shall conform to the State of Vermont, Department of Highways, Standard Specifications for Highway and Bridge Construction, dated April, 1964 and the AASHTO Standard Specifications dated 1963, as modified by current Interim Specifications.
- LIVE LOAD:**  
Structure designed for HS-20-44 loading modified for National System of Interstate Highways applied in accordance with the provisions of the AASHTO Standard Specifications Article 1.2.8.
- CONCRETE:**  
All exposed edges of concrete shall be chamfered 1"x1" unless otherwise noted. All construction joints to be made as shown on SCB-D6-67 details B and C unless otherwise noted.
- REINFORCEMENT:**  
All reinforcement to have a clear cover of 2", unless otherwise noted.
- DIMENSIONS:**  
All dimensions given are measured horizontally or vertically unless otherwise noted. Dimensions given are for 68°F, unless otherwise noted. Elevation datum sea level based on nearest U.S. Government vertical control.
- STRUCTURAL STEEL:**  
Item 404-A shall include all structural steel, copper, wrought iron, and any other materials indicated or required in the completed structure which are not otherwise classified.  
Structural steel shall be structural carbon steel conforming to the requirements of the specifications for steel bridges and buildings A.S.T.M. Designations as noted on the project plans.  
The contractor shall submit complete details of the structural steel to the State of Vermont, Department of Highways, and receive their written approval prior to start of fabrication. The steel details shall include provisions for cambering of beams for dead load deflection as well as erection diagrams and fawework details.  
The final coat of field paint shall be green.
- WATER REPELLENT:**  
The top surfaces of safety walks, fascia, bottom of deck slab back to the exterior frame and the exposed areas of the Piers and abutments not otherwise treated shall be covered with Water Repellent (Item 440).
- FIELD BOLTING:**  
Field bolted connections shall be made with 7/8" φ A325 High Strength bolts. A490 bolts are not allowed.
- ABUTMENTS AND PIERS:**  
The top surfaces of all abutments shall be sloped 1/4" per ft. from the front edge of abutment and curtainwalls except for bearing pads, which shall be level. Elevation of bridge seats given are for centerline of bearings.  
The entire exposed top surface of abutments shall be coated with Asphaltic-Asbestos coating 1/2" thick as per Item 407 of the specifications. The application of this item shall be after all painting and incidental items are completed.
- STEEL PILES:**  
Steel bearing piles shall be driven to ledge rock unless otherwise approved by the engineer. When piles are driven in fill the material shall be such as to have no stones large enough to interfere with the driving of the piles. All pile points shall be reinforced with steel plates as specified in Article 503.03, Subarticle C, Part 1 of the Special Provisions for Item 503-C, Steel Piling.
- GENERAL:**  
All expansion material shall be preformed cork containing no bitumen or asphalt. Payments for waterstop sealing strips and all labor necessary to install same shall be included in the unit price bid for Concrete Class B, Item 401-B.
- BITUMINOUS CONCRETE PAVEMENT**  
Bituminous Concrete Pavement, Item 361 (Modified) Type II mix shall be applied in two courses.

**CURVE DATA TH-17**  
Δ = 7° 15' 40" Rt.  
D = 1° 00'  
R = 5729.58'  
T = 363.54'  
L = 726.11'  
E = 11.52'  
Bank 1/4" per ft.

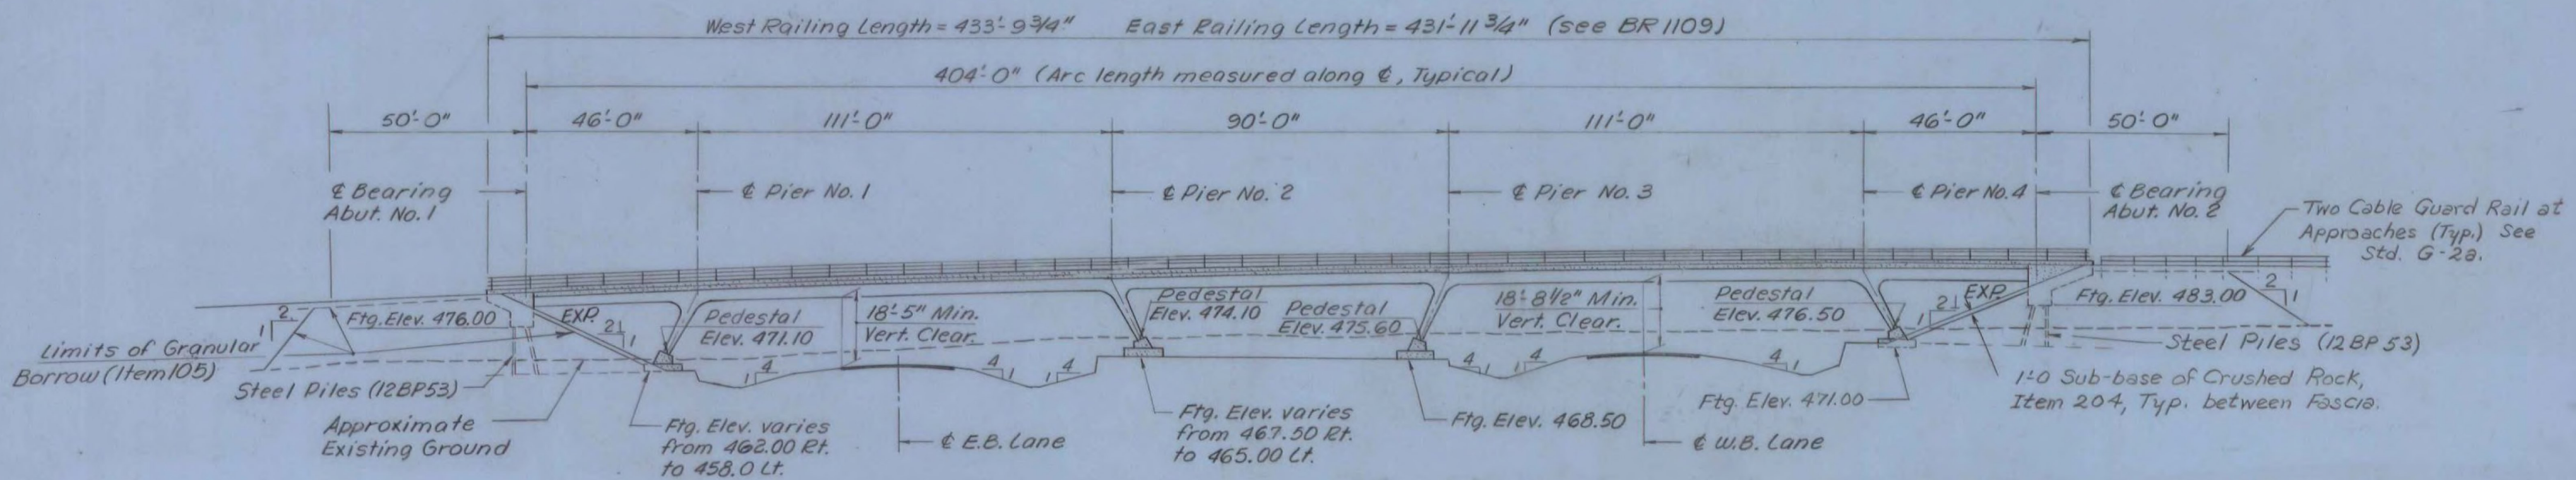

ELEVATION  
Scale: 1" = 30'

- INDEX OF DRAWINGS**
- BR 1101 PLAN AND ELEVATION
  - BR 1102 BRIDGE QUANTITY SHEET
  - BR 1103 PRELIMINARY INFORMATION SHEET
  - BR 1104 BORING LOG
  - BR 1105 SUPERSTRUCTURE DETAILS
  - BR 1106 SUPERSTRUCTURE DETAILS
  - BR 1107 SUPERSTRUCTURE DETAILS
  - BR 1108 SUPERSTRUCTURE DETAILS
  - BR 1109 SUPERSTRUCTURE DETAILS
  - BR 1110 JOINT DETAILS
  - BR 1111 ABUTMENT NO. 1 DETAILS
  - BR 1112 ABUTMENT NO. 2 DETAILS
  - BR 1113 ABUTMENT FOOTING DETAILS & TYPICAL SECTIONS.
  - BR 1114 PIER NO. 1 & PIER NO. 2
  - BR 1115 PIER NO. 3 & PIER NO. 4
  - BR 1116 REINFORCING STEEL DETAILS
  - BR 1117 REINFORCING STEEL DETAILS.


CONTRACTOR <b>E.T. O'NEIL &amp; SON</b>	CONTRACT DATED <b>AUG. 19, 1970</b>
RESIDENT ENGINEER <b>N.W. BITTNER</b>	STARTED <b>AUG. 20, 1970</b>
INSPECTORS <b>R.L. WEICHERT</b>	COMPLETED <b>AUG. 31, 1971</b>
RECORD PLANS <b>R.L. WEICHERT</b>	ACCEPTED <b>SEPT. 15, 1971</b>

**MATERIALS**

**CONCRETE (AA & B): CARRARA**  
**REINFORCING STEEL: BETHLEHEM STEEL**  
**STRUCTURAL STEEL: VT. STRUCT. STEEL**  
**BRIDGE RAILING: S.T. GRISWOLD**

**STANDARD DRAWINGS**

- SCB-D1-67 BENCH MARK DETAILS & GENERAL NOTES APRIL 28, 1970 R
- SCB-D6-67 CURB DETAILS, PILE SPLICE DETAILS, & CONSTRUCTION JOINT DETAILS APRIL 28, 1970 R
- SB-22-65 STEEL RAILING DETAILS Nov. 8, 1964 R
- SB-E1-64 (SHEETS 1 & 2) ALUMINUM RAILING DETAILS APRIL 28, 1970 R
- SCB-D2-67 BEAM HAUNCH Jan. 24, 1968
- SCB-D7-67 DIAPHRAGM DETAILS Jan. 24, 1968

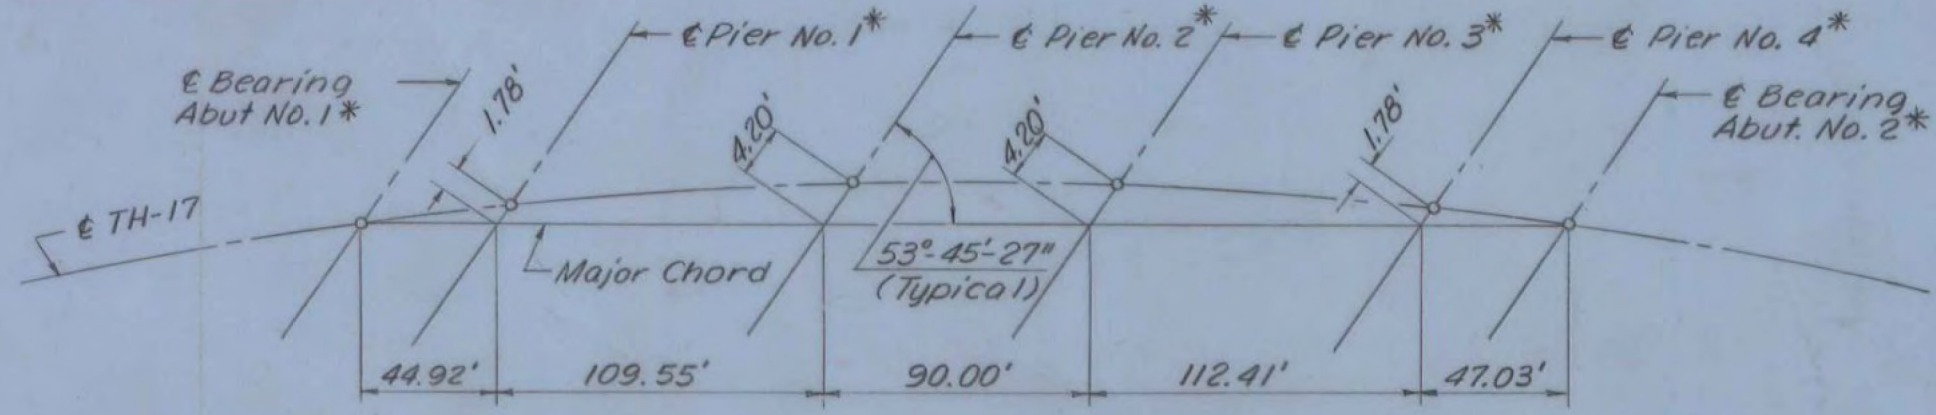

SUPERSTRUCTURE LAYOUT FROM MAJOR CHORD  
No Scale

\* WORKING POINTS ARE LOCATED AT TOP OF STEEL FRAME AS SHOWN ON BR. 1106. FOR SUBSTRUCTURE LAYOUT SEE BR. 1113

**DESIGN STRESSES**

- CONCRETE:  $f'_c = 3,000$  ps.i.
- $P_c = 1,200$  ps.i.
- STRUCTURAL STEEL:  $f_s = 20,000$  ps.i. (A36, other steels as per AASHTO Specifications)
- REINFORCING STEEL:  $f_s = 20,000$  ps.i. (tension)
- $f_s = 16,000$  ps.i. (compression) (intermediate grade)

CASTLETON-RUTLAND  
BF MEMB (37)  
SHEET 11 OF 28  
BRIDGE NO. D11  
FOR REFERENCE ONLY

VERMONT  
STATE HIGHWAY DEPARTMENT  
TOWN OF CASTLETON  
U.S. ROUTE 4

TH-17 RELOC. OVER U.S. RTE 4 RELOC.  
PLAN AND ELEVATION

MCFARLAND-JOHNSON  
CONSULTING ENGINEERS  
BINGHAMTON, NEW YORK

DESIGNED BRK CHECKED REC DATE 7-12-68  
DRAWN RMG IN CHARGE HGC SCALE AS SHOWN  
PROJECT NO. F020-1(7) SH 43 OF 206

CONTRACT NO. BR. 1101