


NOTE:
The concrete floor slab surface shall be finished with a self-propelled concrete finishing machine.

For Haunch Details, see Std. SCB-D2-67

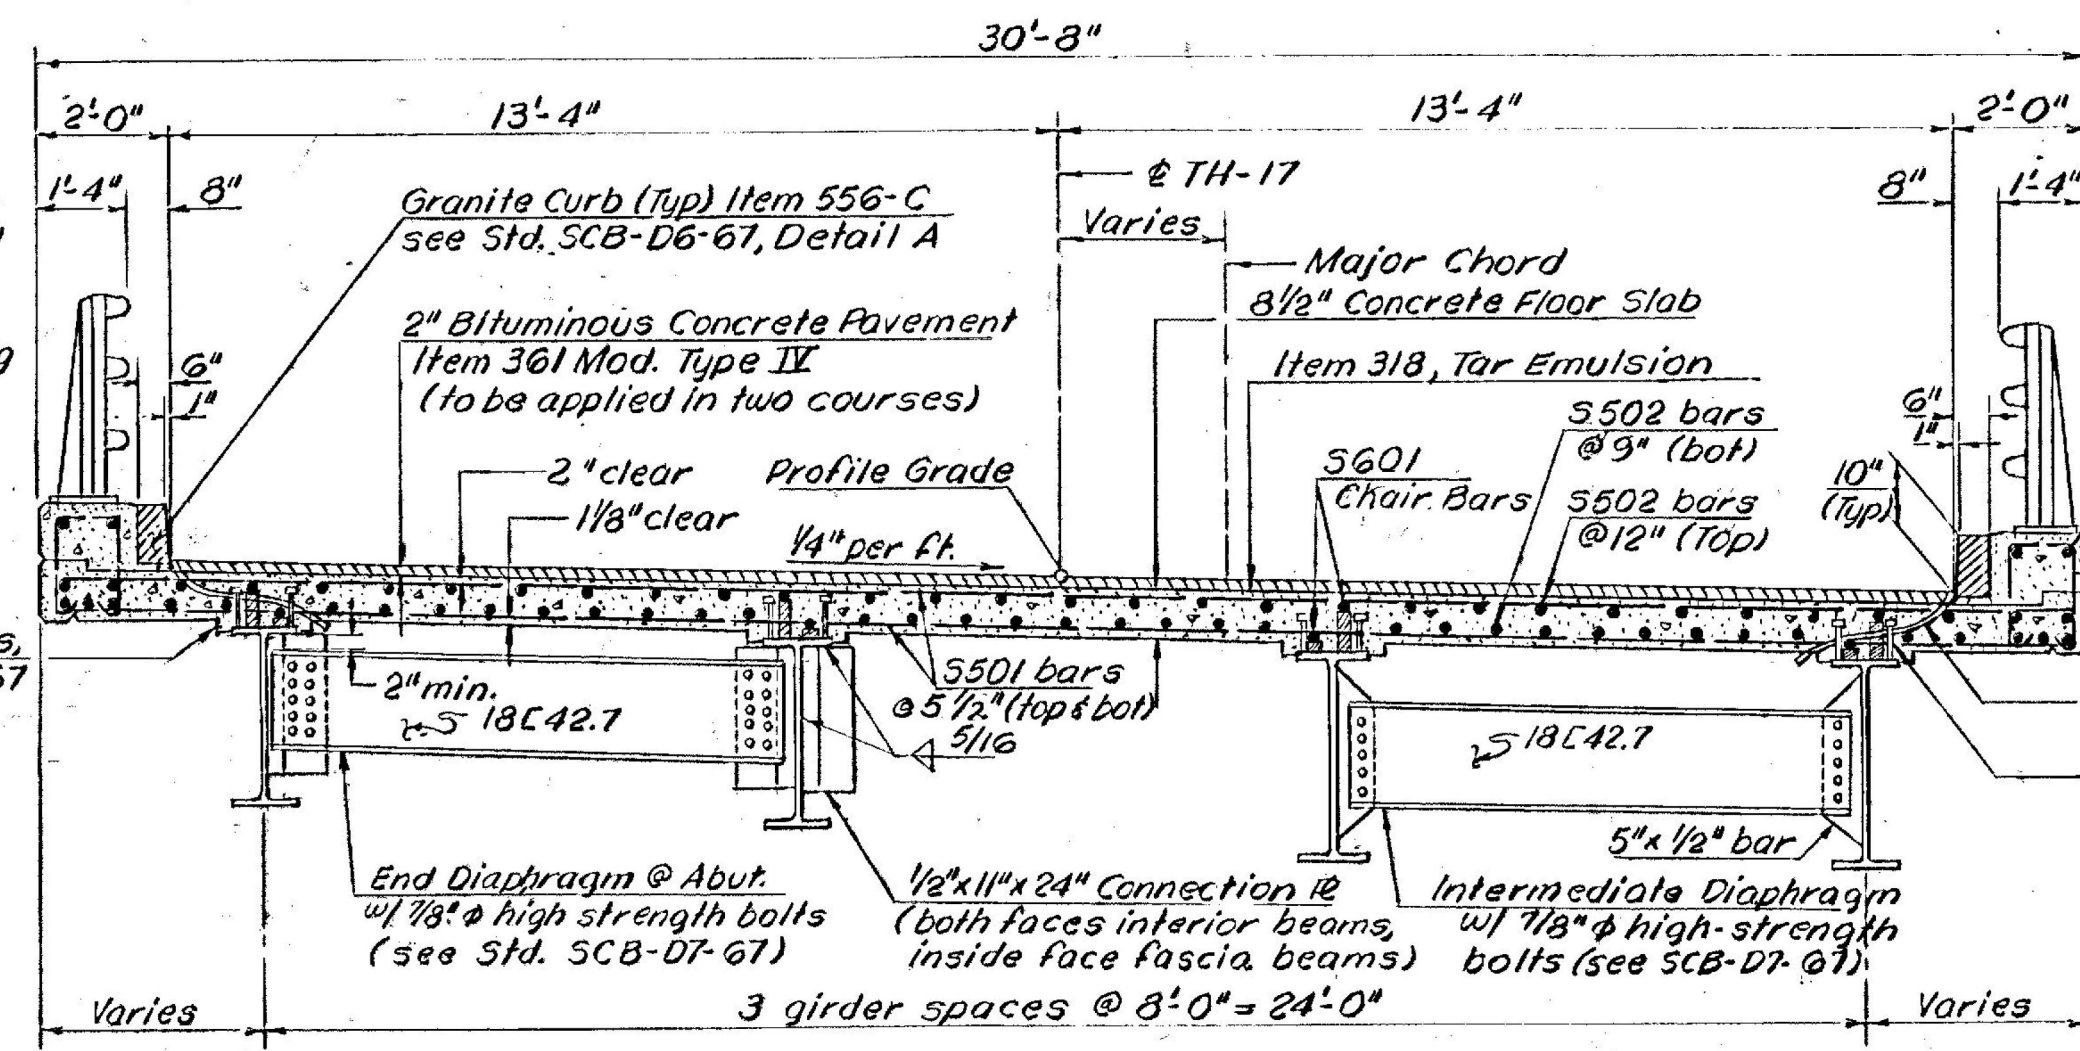


TYPICAL SECTION
Scale: 3/8" = 1'-0"

NOTE: For details of Pier Diaphragm, see BR 1108.


Note: Transverse reinforcing bars (S 501) are to be spaced @ 5 1/2" c.c.

7-5502 bars as shown
5504 bars @ 12"
1" plastic tubing @ 10' intervals (Typ) Stud Shear Connector Size 7" x 3/4"


1" Plastic Tube Omit tubes over Pavement of U.S. Route "4" and over inclined frame legs.

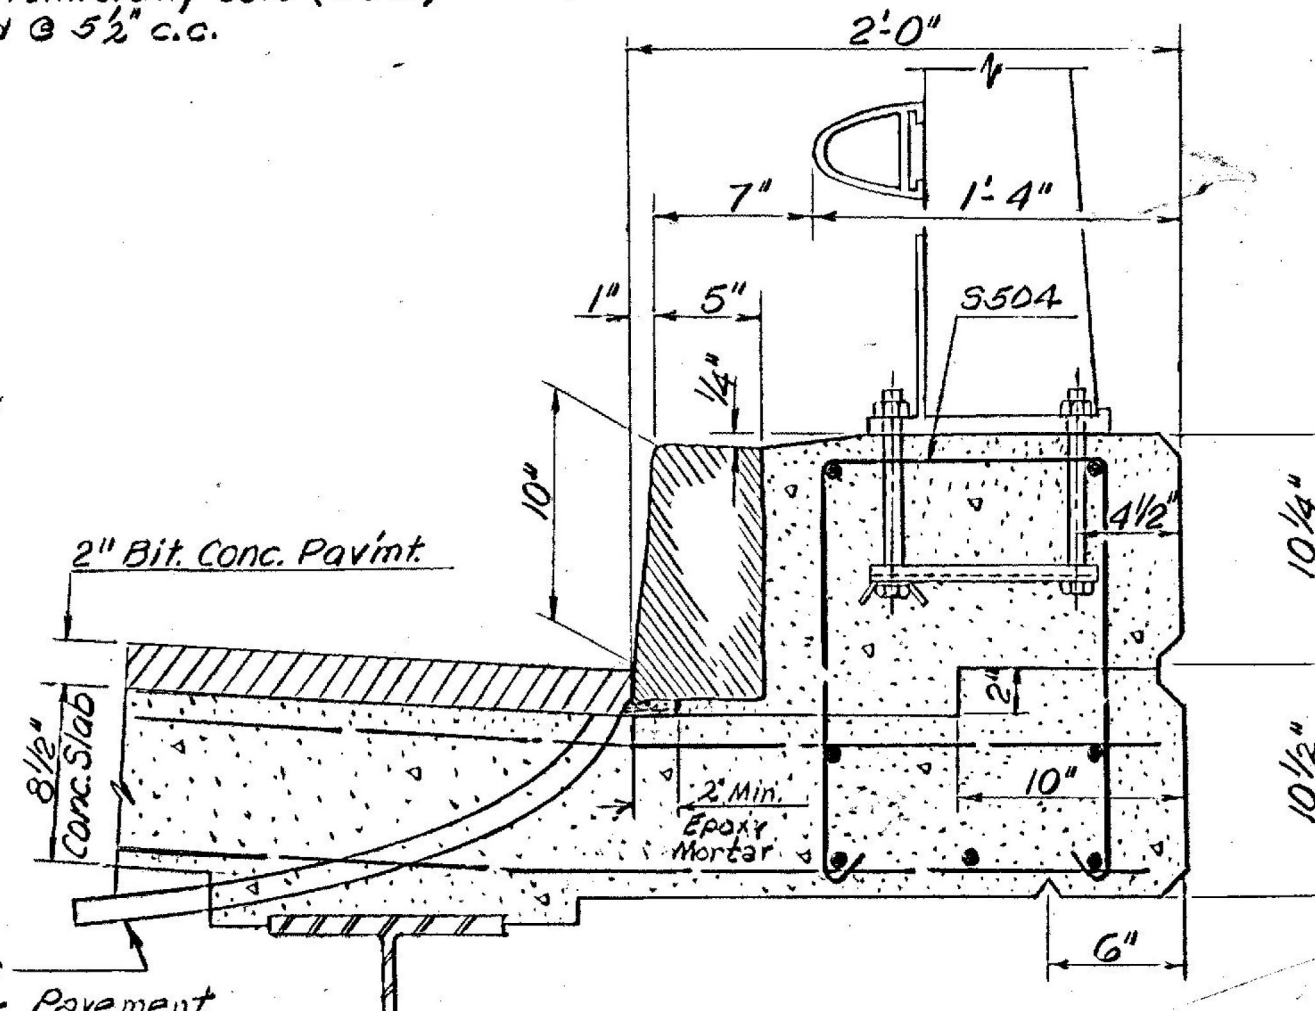


TYPICAL CURB SECTION
Scale: 1/2" = 1'-0"

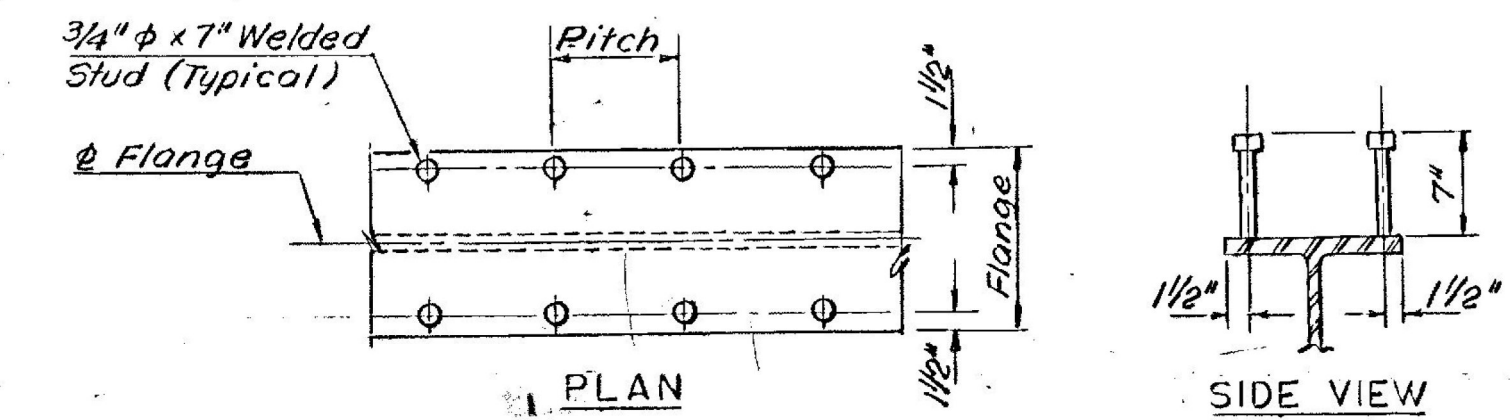

SHEAR CONNECTOR
No Scale

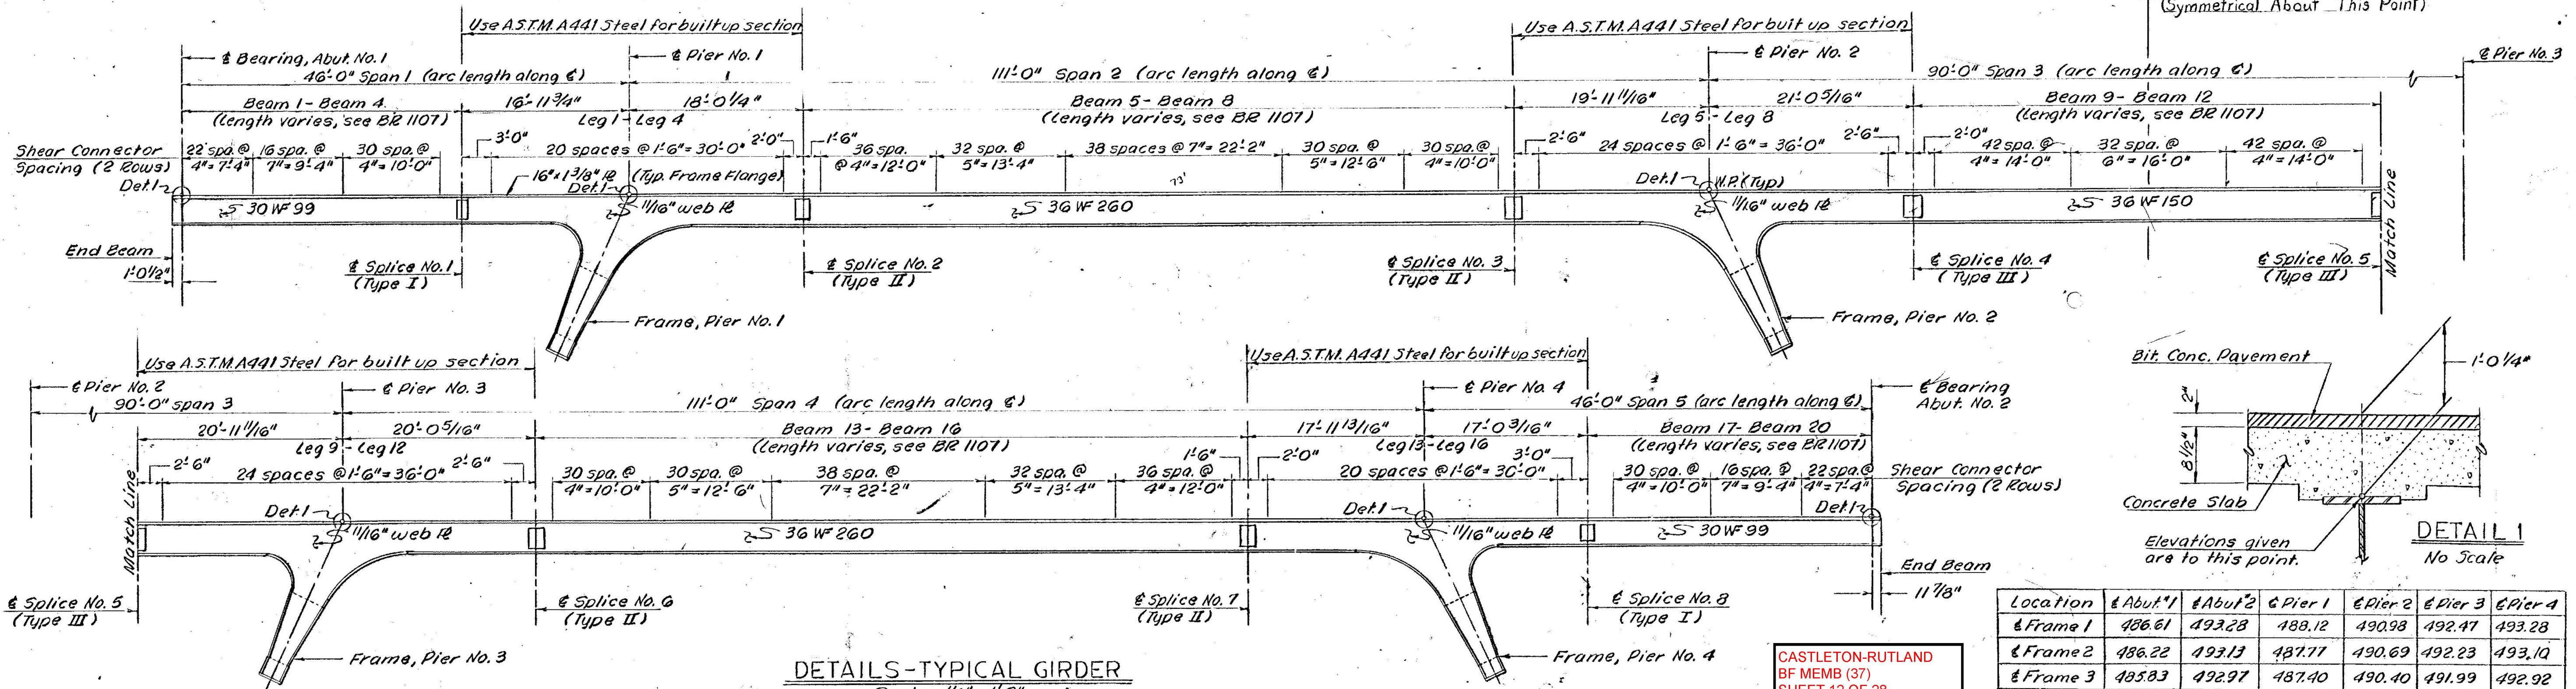

DETAILS-TYPICAL GIRDER
Scale: 1/8" = 1'-0"

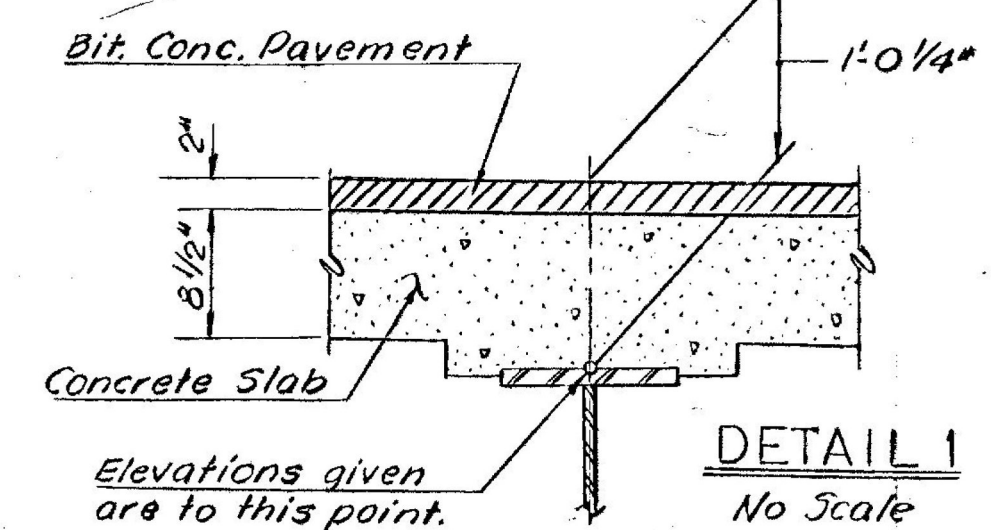

DETAIL 1
No Scale


Location	Abut. 1	Abut. 2	Pier 1	Pier 2	Pier 3	Pier 4
Frame 1	486.61	493.28	488.12	490.98	492.47	493.28
Frame 2	486.22	493.13	487.77	490.69	492.23	493.10
Frame 3	485.83	492.97	487.40	490.40	491.99	492.92
Frame 4	485.43	492.81	487.03	490.10	491.74	492.73

ELEVATIONS - TOP OF FRAME

CASTLETON-RUTLAND
BF MEMB (37)
SHEET 12 OF 28
BRIDGE NO. D11
FOR REFERENCE ONLY

NOTES


- For General Notes, see BR 1101.
- For Joint Details, see BR 1109 & 1110.
- For Beam Haunch Details, see SCB-D2-67.
- For Splice Details, see BR 1106.
- For Frame Details, see BR 1106.
- All studs are to be 3/4" x 7" welded studs. If 1/2" studs are used, increase the spacing shown for 3/4" studs by 50%.
- Pier 1 is defined as the intersection of leg and top of steel frame.
- Frame leg web, flange, and stiffener ribs shall be ASTM-A441. If beams, diaphragms, and all steel not otherwise designated shall be ASTM-A36.
- Deck concrete shall be placed during one working day according to the placing sequence shown on BR 1109.

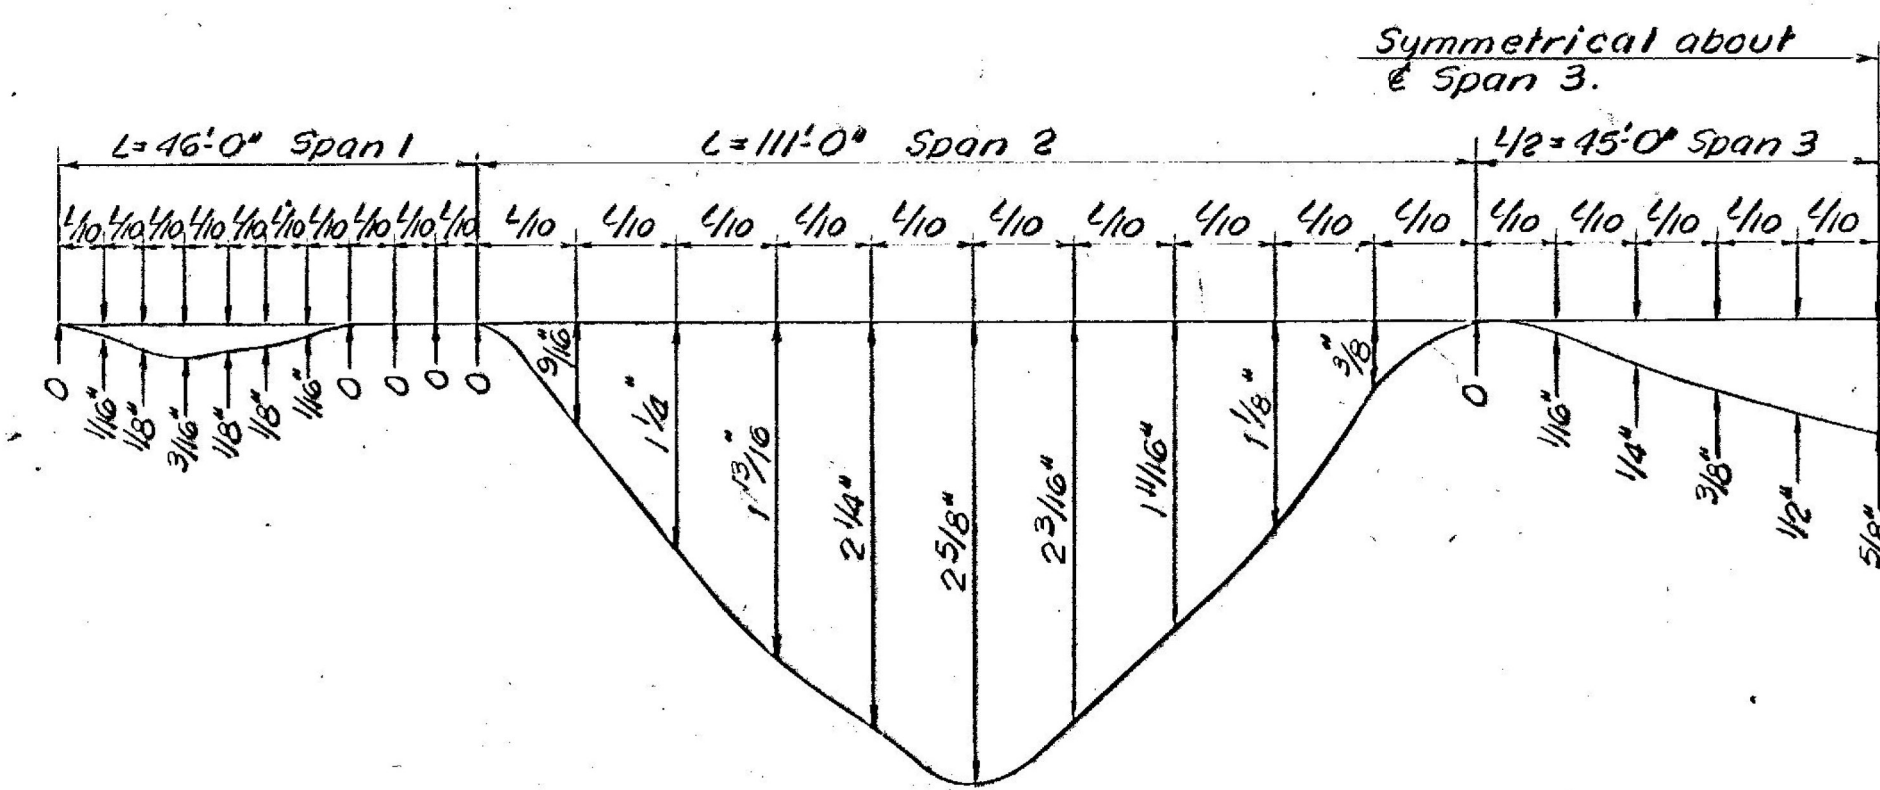

D.L. DEFLECTION DIAGRAM*
No Scale

* Includes weight of frame, slab, and superimposed dead load.

Maximum Live Load Deflections:
Spans 2 And 4 = 1/8"
Spans 1 And 5 = 1/4"
Span 3 = 3/8"

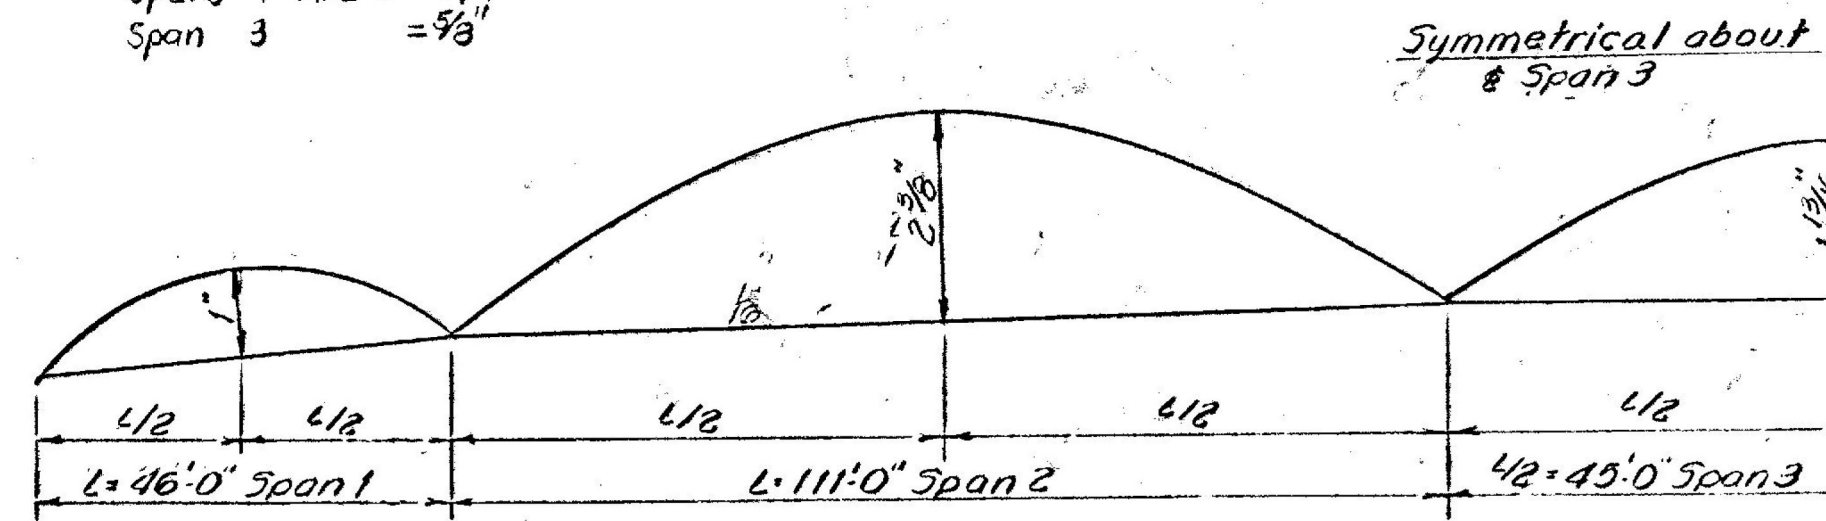

CAMBER DIAGRAM
No Scale

NOTE: Final camber after dead load deflection.

Revised Curb Stirrup Bars From #4 @ 18" to #5 @ 12", Added Note #9. W. Tripp 10-27-67

VERMONT
STATE HIGHWAY DEPARTMENT
TOWN OF CASTLETON
U.S. ROUTE 4
TH-17 RELOC. OVER U.S. RTE. 4 RELOC.
SUPERSTRUCTURE DETAILS

MCFARLAND-JOHNSON
CONSULTING ENGINEERS
BINGHAMTON, NEW YORK
DESIGNED WDS. CHECKED REC. DATE 7-12-68
DRAWN RMG. IN CHARGE HGC. SCALE AS SHOWN
PROJECT NO. F020-1(7) SH 47 OF 200

CONTRACT NO. BR 1105