


PLAN
SCALE 1"=20'

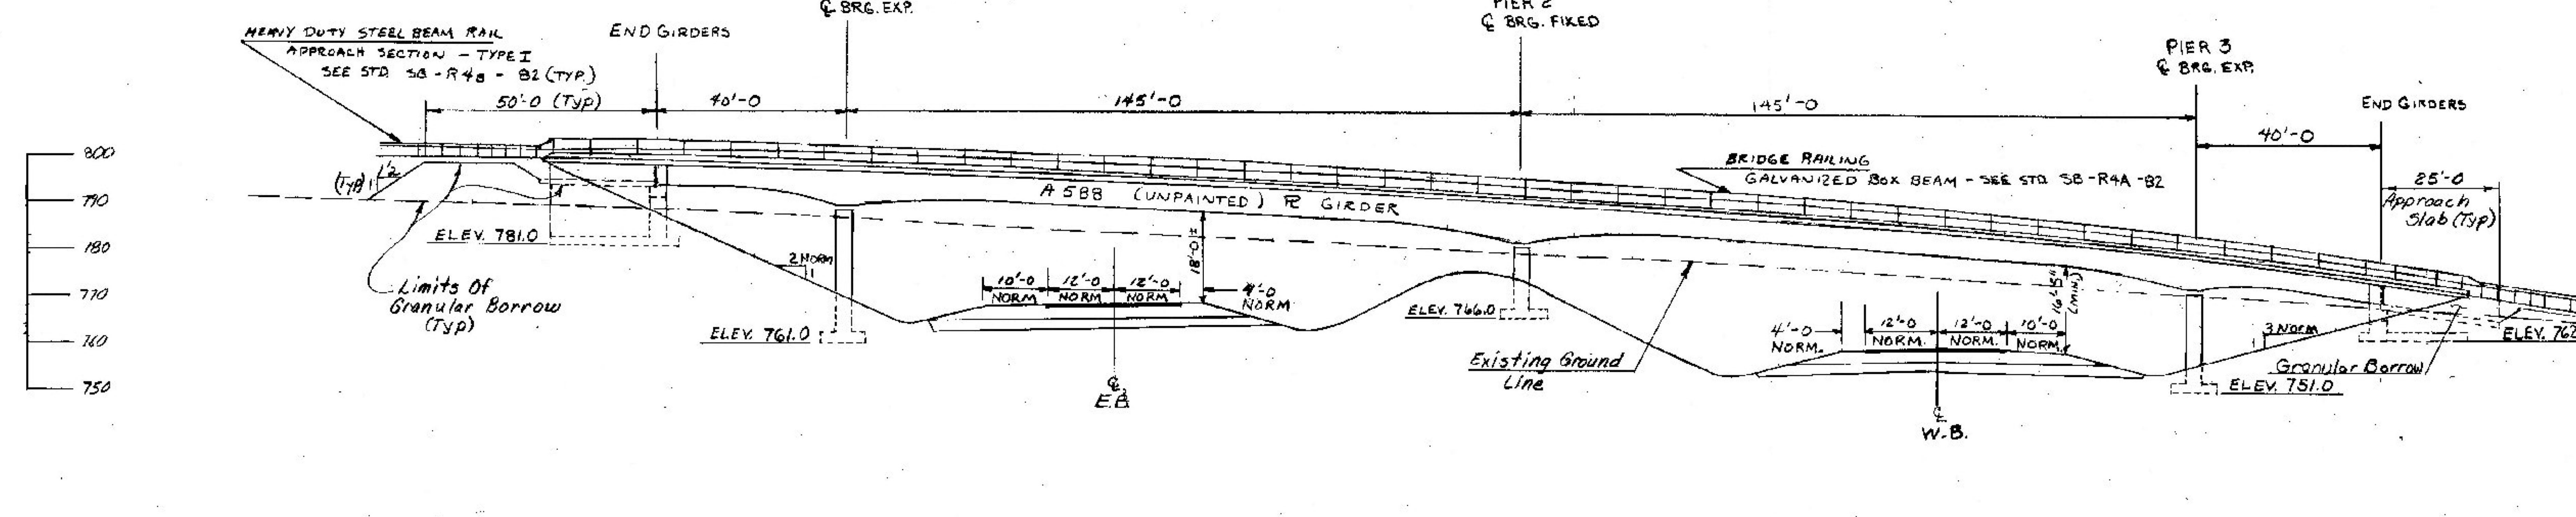

ELEVATION ALONG RIGHT FASCIA
SCALE: 1"=20'

CASTLETON-RUTLAND
BF MEMB (37)
SHEET 22 OF 28
BRIDGE NO. D18
FOR REFERENCE ONLY

STATE OF VERMONT	
AGENCY OF TRANSPORTATION	
TOWN OF RUTLAND	Bridge No. 4
HIGHWAY NO. TH.22	Log Sta.
T.H. 22 OVER U.S. 4 E.B. & W.B.	Surv. Sta. Q 887+80.1
PLAN AND ELEVATION	
Designed by R. ALDRICH	Drawn by M. EVANS 5/83
Checked by R. ALDRICH	Bridge Design Supervisor
date 6/83	R.L. Oatley date 7-83
PROJECT	PROJECT NO.
WEST RUTLAND - RUTLAND	FO20-1(10)
Bridge Sheet No. BR402	Sheet 187 of 457