



TYPICAL SECTION WINGWALLS 3&4
SCALE: 3/8" = 1'-0"

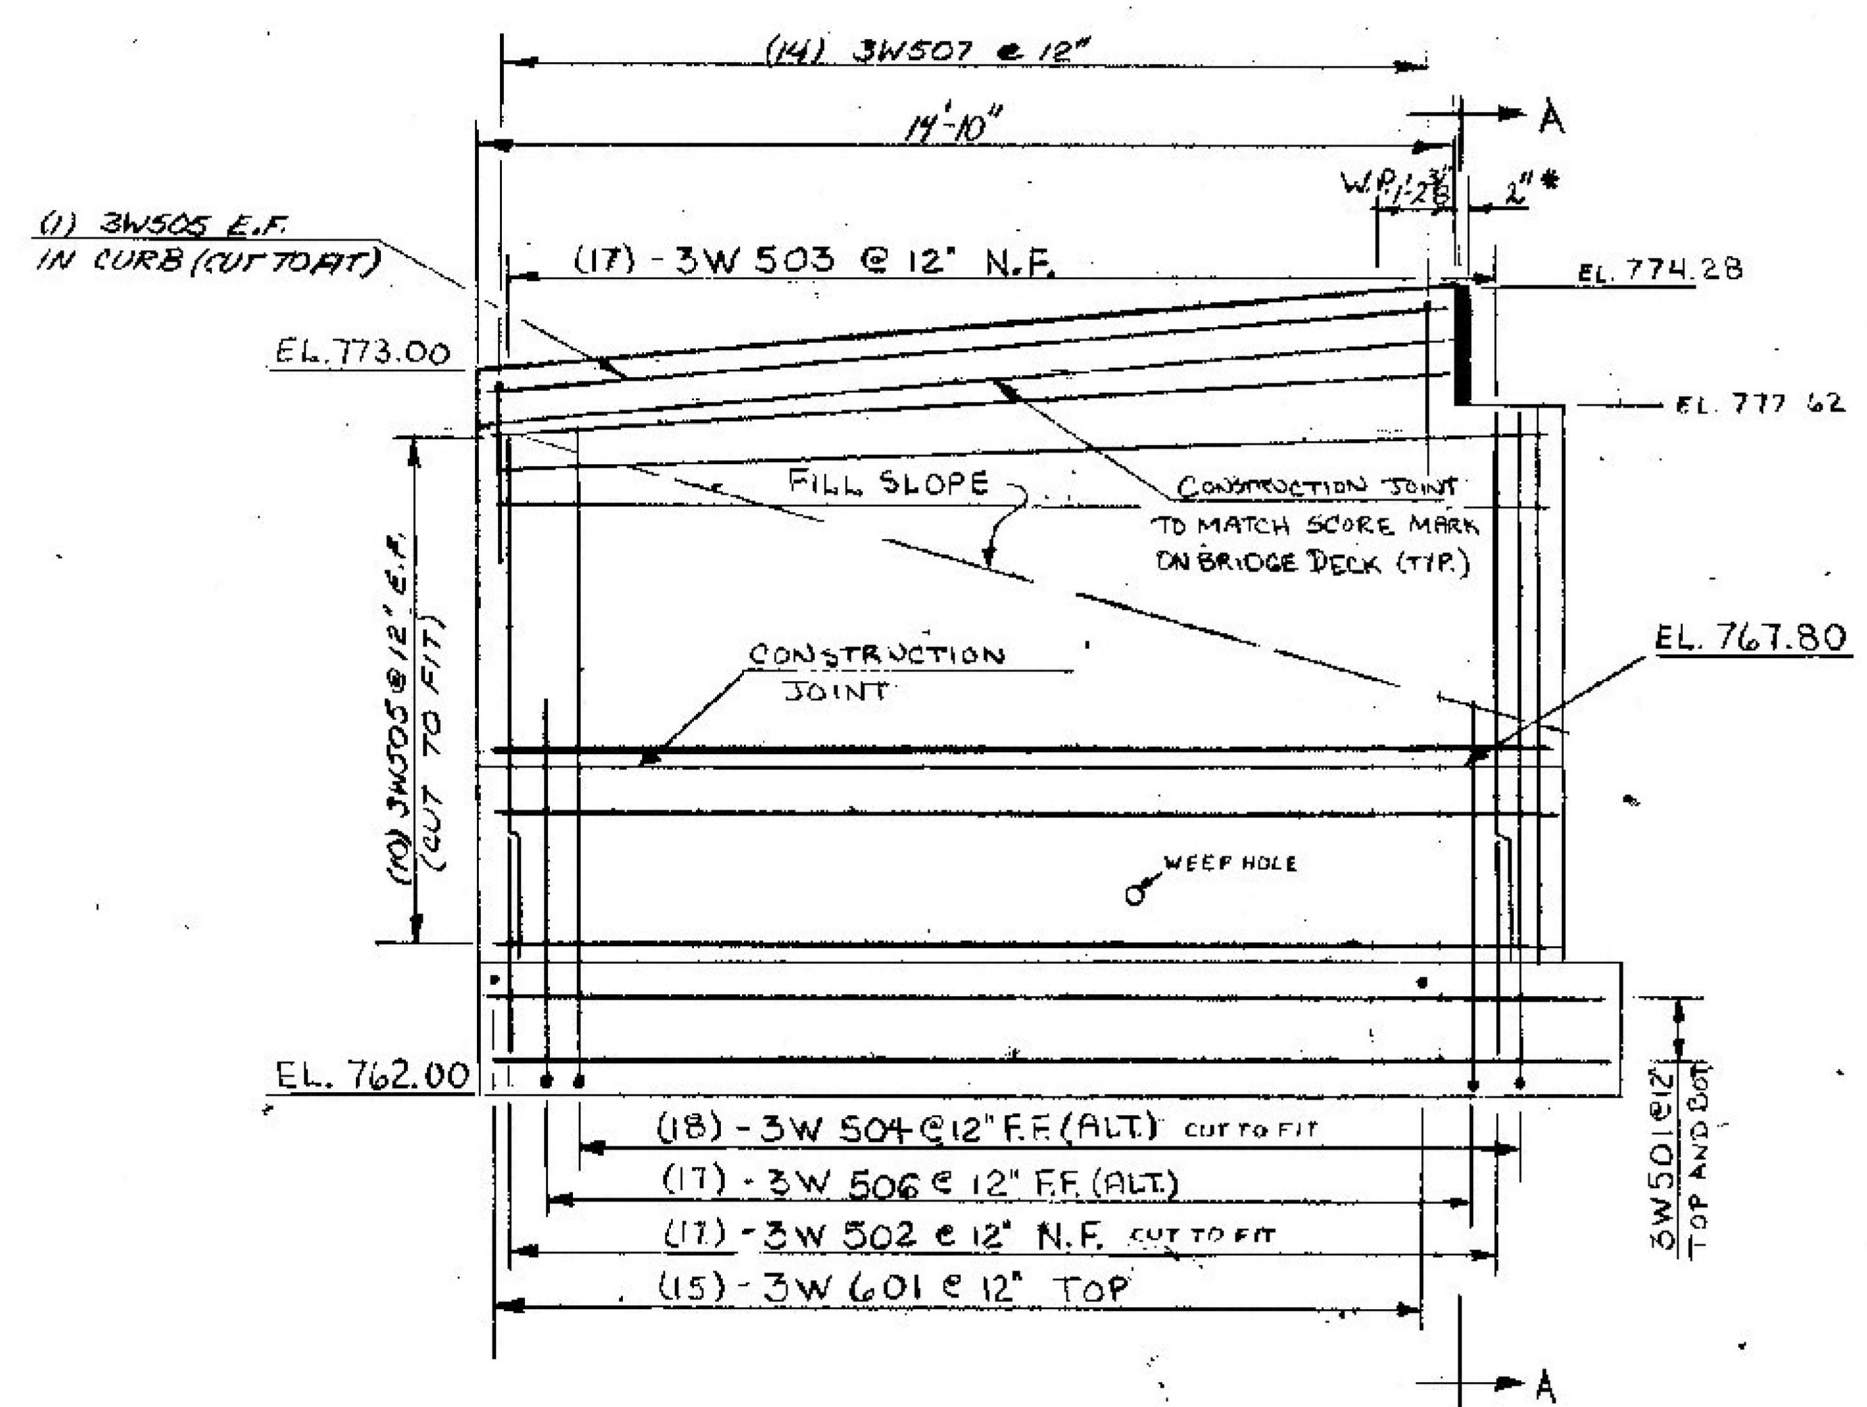

ELEVATION WINGWALL No. 3
SCALE: 3/8" = 1'-0"

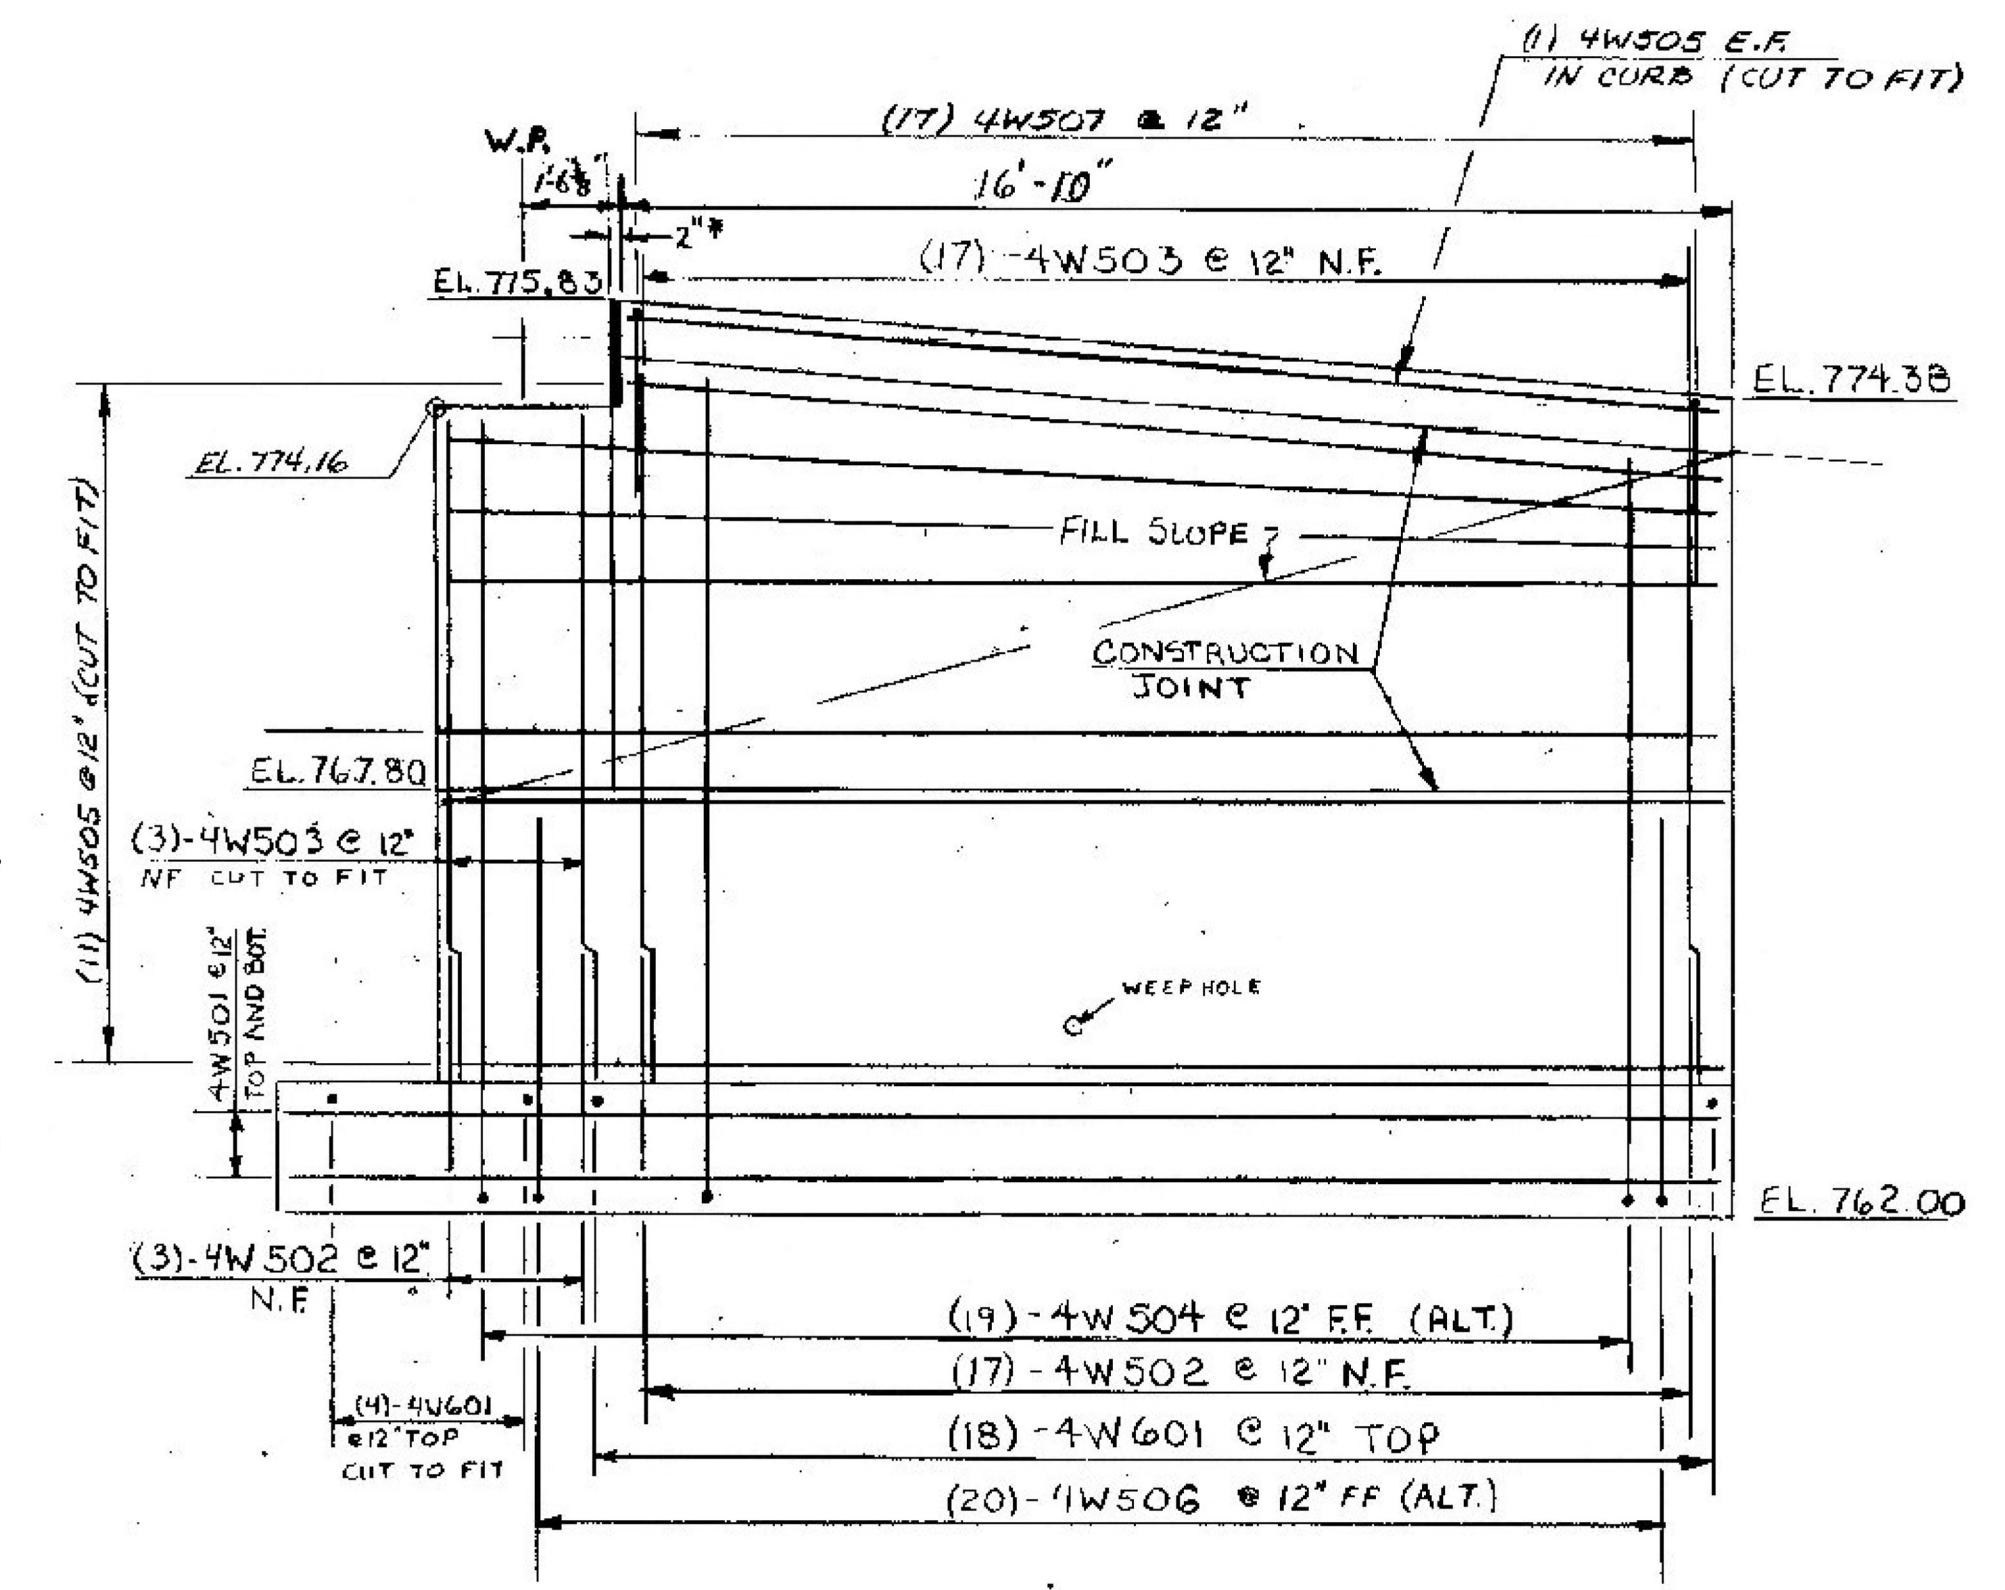


ELEVATION WINGWALL No. 4
SCALE: 3/8" = 1'-0"


TEMPERATURE ADJUSTMENT CHART

38°	48°	58°	68°	78°	88°
+7/8"	+3/4"	+1/2"	0	-1/8"	-5/16"


* INDICATES DIMENSION AT 68°F, SEE CHART FOR TEMPERATURE ADJUSTMENT

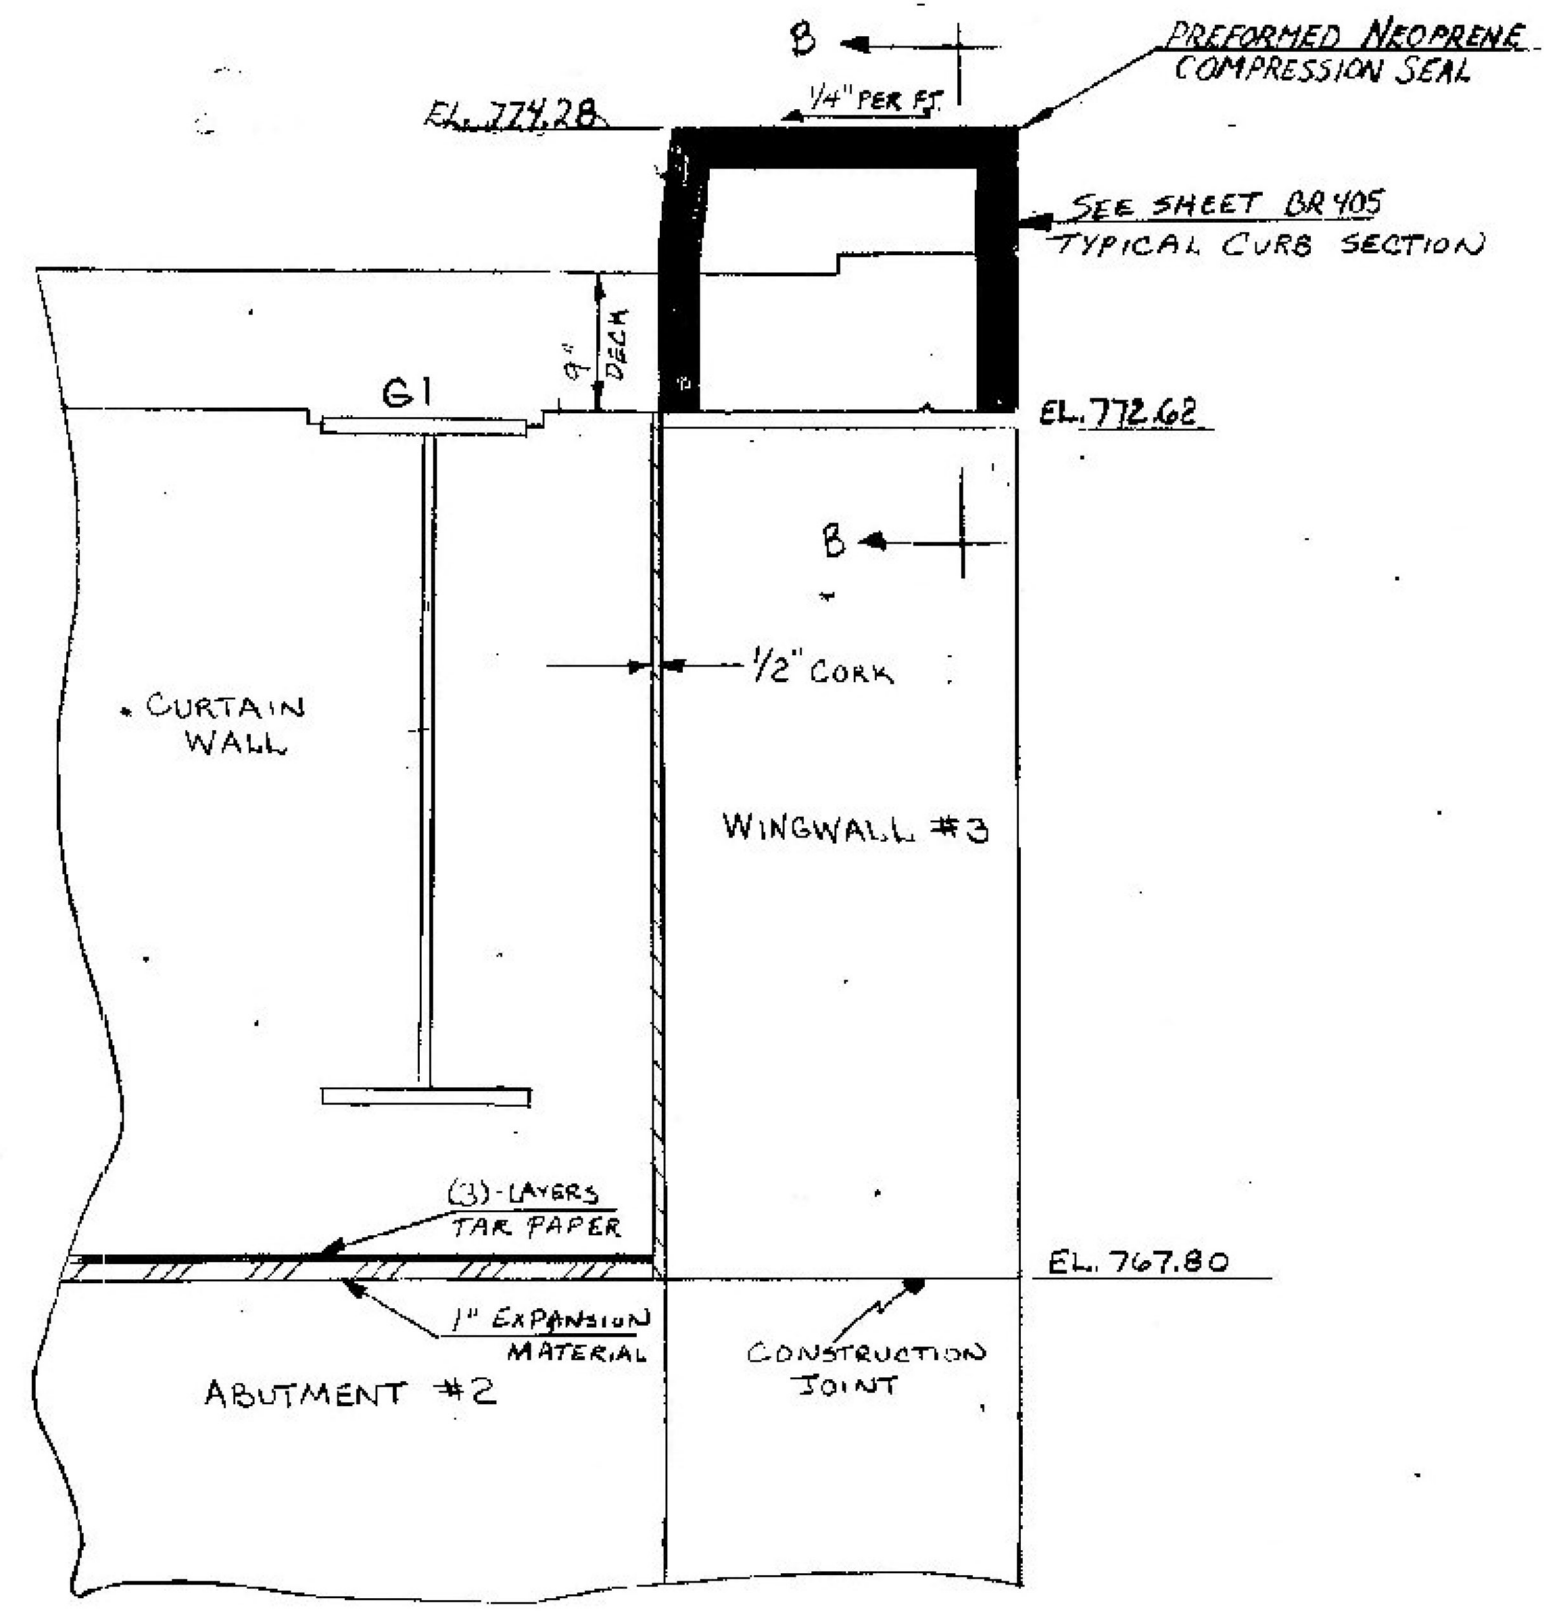

SECTION "A-A" (WINGWALL #3)
SCALE: 1" = 1'-0"
(OTHER WINGWALLS SIMILAR)

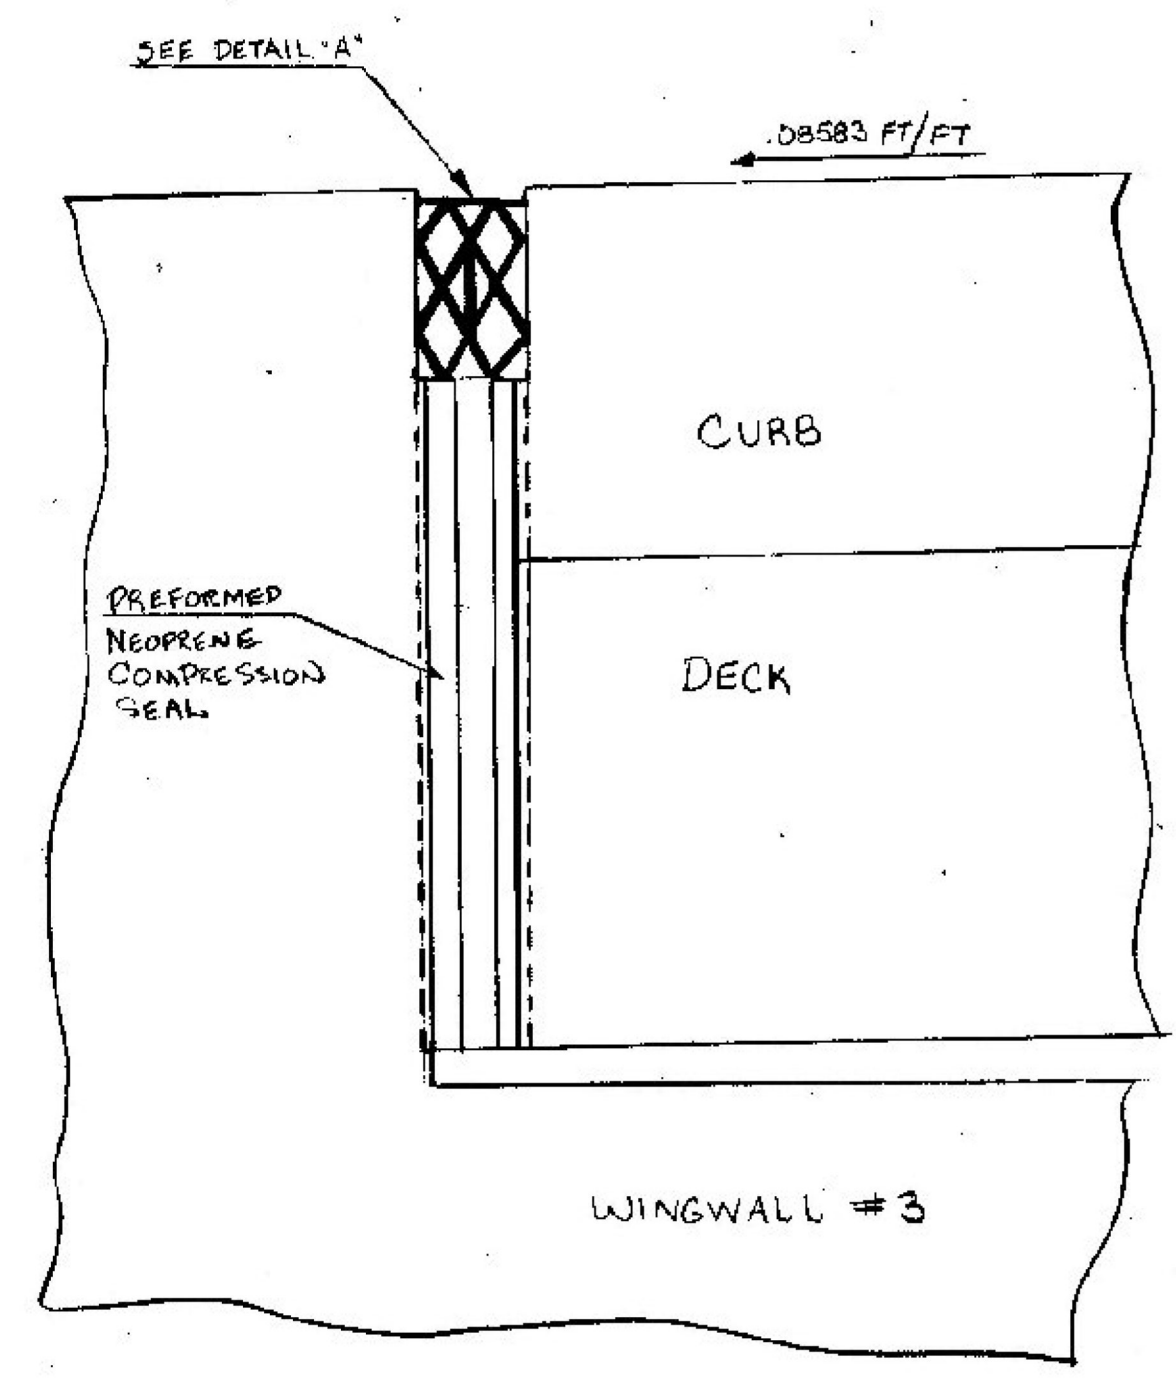

SECTION "B-B"
SCALE: 3" = 1'-0"

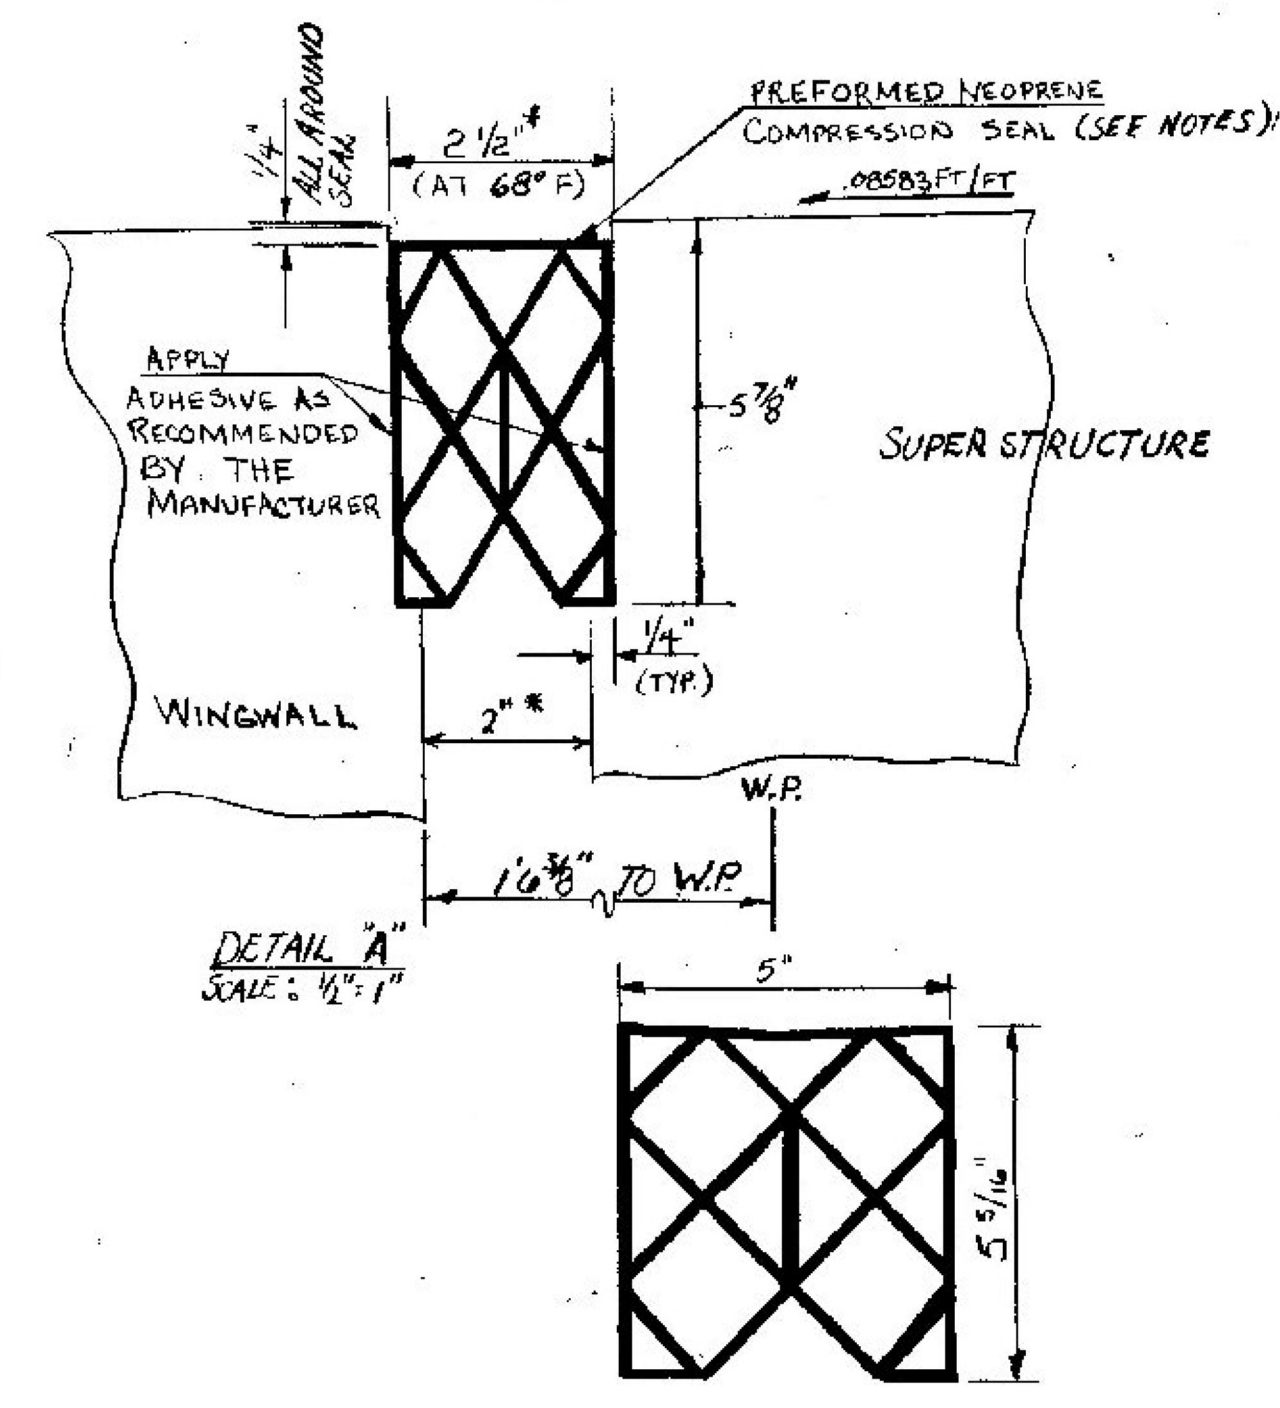

TYPICAL SECTION NEOPRENE SEAL (UNCOMPRESSED)
SCALE: 1/4" = 1'

PREFORMED NEOPRENE SEAL NOTES

- OTHER PREFORMED NEOPRENE COMPRESSION SEAL CONFIGURATIONS MAY BE SUBMITTED TO THE STRUCTURES ENGINEER FOR APPROVAL.
- THE PNC SEAL SHALL HAVE A TOTAL MOVEMENT CAPABILITY OF 2.50".
- THE PNC SEAL SHALL BE ONE CONTINUOUS STRIP, CUT AND VULCANIZED IN THE SHOP TO MATCH THE SHAPE SHOWN IN SECTION A-A, AND SHALL BE INSTALLED IN ACCORDANCE WITH VT. STD. SPEC. SECTION 614.22 AT THE LOCATIONS SHOWN IN THE DRAWINGS.
- PAYMENT FOR PNC SEAL SHALL BE AT THE UNIT BID PRICE FOR ITEM 614.22 JOINT SEALER, PREFORMED NEOPRENE 5" WIDTH.

CASTLETON-RUTLAND
BF MEMB (37)
SHEET 27 OF 28
BRIDGE NO. D18
FOR REFERENCE ONLY

STATE OF VERMONT	
AGENCY OF TRANSPORTATION	
TOWN OF RUTLAND	Bridge No. 4
HIGHWAY NO. T.H. 22	Log Sta.
T.H. 22 OVER U.S. 4, EB & WB	
WINGWALL 3 & 4 DETAILS	
Designed by M. EVANS	Drawn by M. EVANS 7-83
Checked by D. BURLEY date 7-83	Bridge Design Supervisor E. L. DOLLEY date 7-83
PROJECT W. RUTLAND-RUTLAND	PROJECT NO. FO20-1 (10)
Bridge Sheet No. BR 417	Sheet 204 of 457