

INDEX OF SHEETS

- 1 TITLE SHEET
- 2 QUANTITY SHEET
- 3-22 CLASS 2 TOWN HIGHWAY QUANTITY SHEETS
- 23 MISCELLANEOUS DETAILS
- 24 TRAFFIC CONTROL PLAN
- 25-29 TOWN HIGHWAY COUNTY MAP SHEETS

STANDARDS


- T-1 8-6-12
- T-24 8-6-12
- T-29 8-6-12

STATE OF VERMONT AGENCY OF TRANSPORTATION



PROPOSED IMPROVEMENT

STATEWIDE CLASS 2 TOWN HIGHWAY SYSTEM MARKING

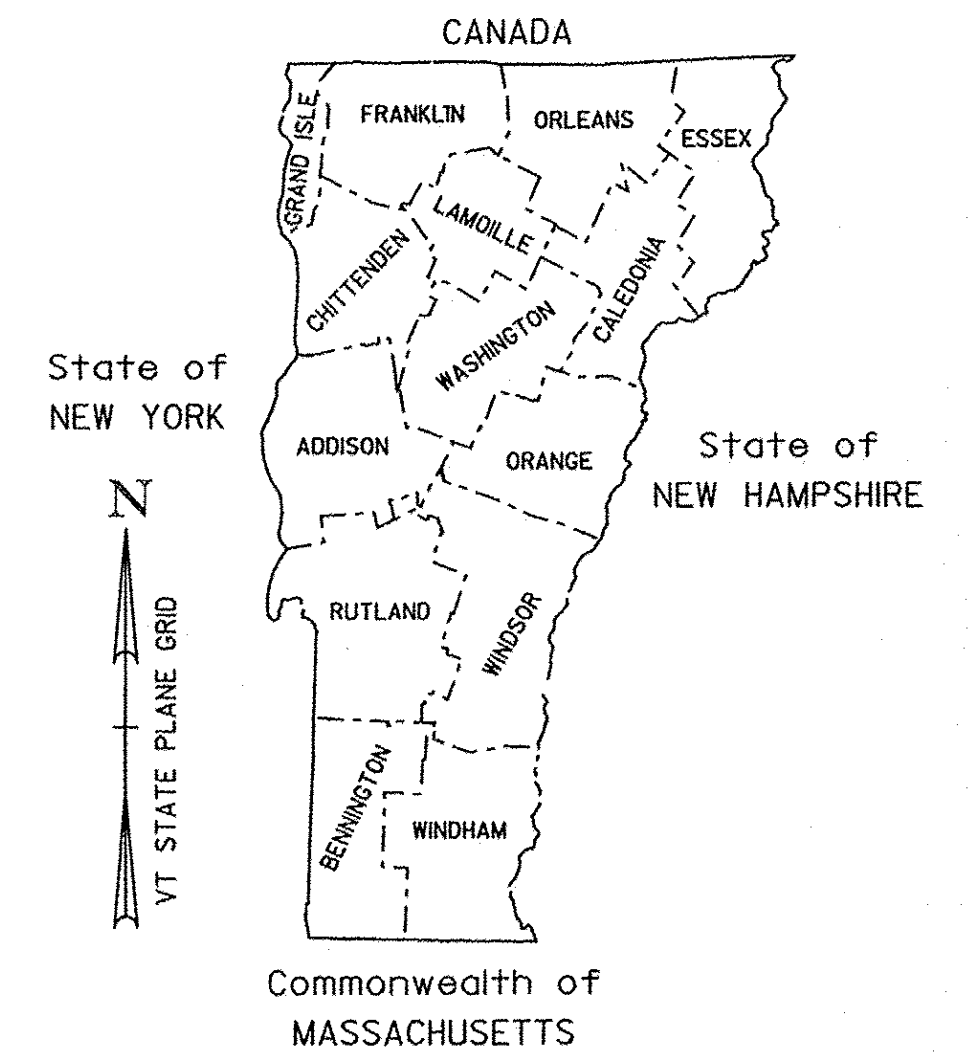


WORK TO BE PERFORMED UNDER THIS PROJECT CONSISTS OF PAINTING 4" DOUBLE YELLOW CENTERLINE MARKINGS ON CLASS 2 TOWN HIGHWAYS

LENGTH OF PROJECT 1,022.24 MILES

PROJECT DESCRIPTION

4" DOUBLE YELLOW CENTERLINE MARKINGS ON ALL PAVED CLASS 2 TOWN HIGHWAYS IN THE COUNTIES OF ADDISON, RUTLAND, BENNINGTON, WINDHAM AND WINDSOR.

RECORD PLANS	
CONTRACTOR:	HI-WAY SAFETY SYSTEMS, INC. - ROCKLAND, MA
RESIDENT ENGINEER:	MARK HAUGHWOUT
CONSTRUCTION BEGAN:	AUGUST 5, 2014
CONSTRUCTION COMPLETE:	NOVEMBER 5, 2014
RECORD PLANS BY:	MARK HAUGHWOUT & JENNA HYDE
I HEREBY CERTIFY THAT ALL THE CONSTRUCTION REQUIRED BY THIS SET OF DRAWINGS HAS BEEN ACCOMPLISHED AS INDICATED HEREIN.	
BY	<i>Mark W. Haughwout</i> RESIDENT ENGINEER
DATE	11/9/16
NOTE: Any further information concerning final quantities, amounts or other details relative to this project may be found at Central Files in the electronic archives.	

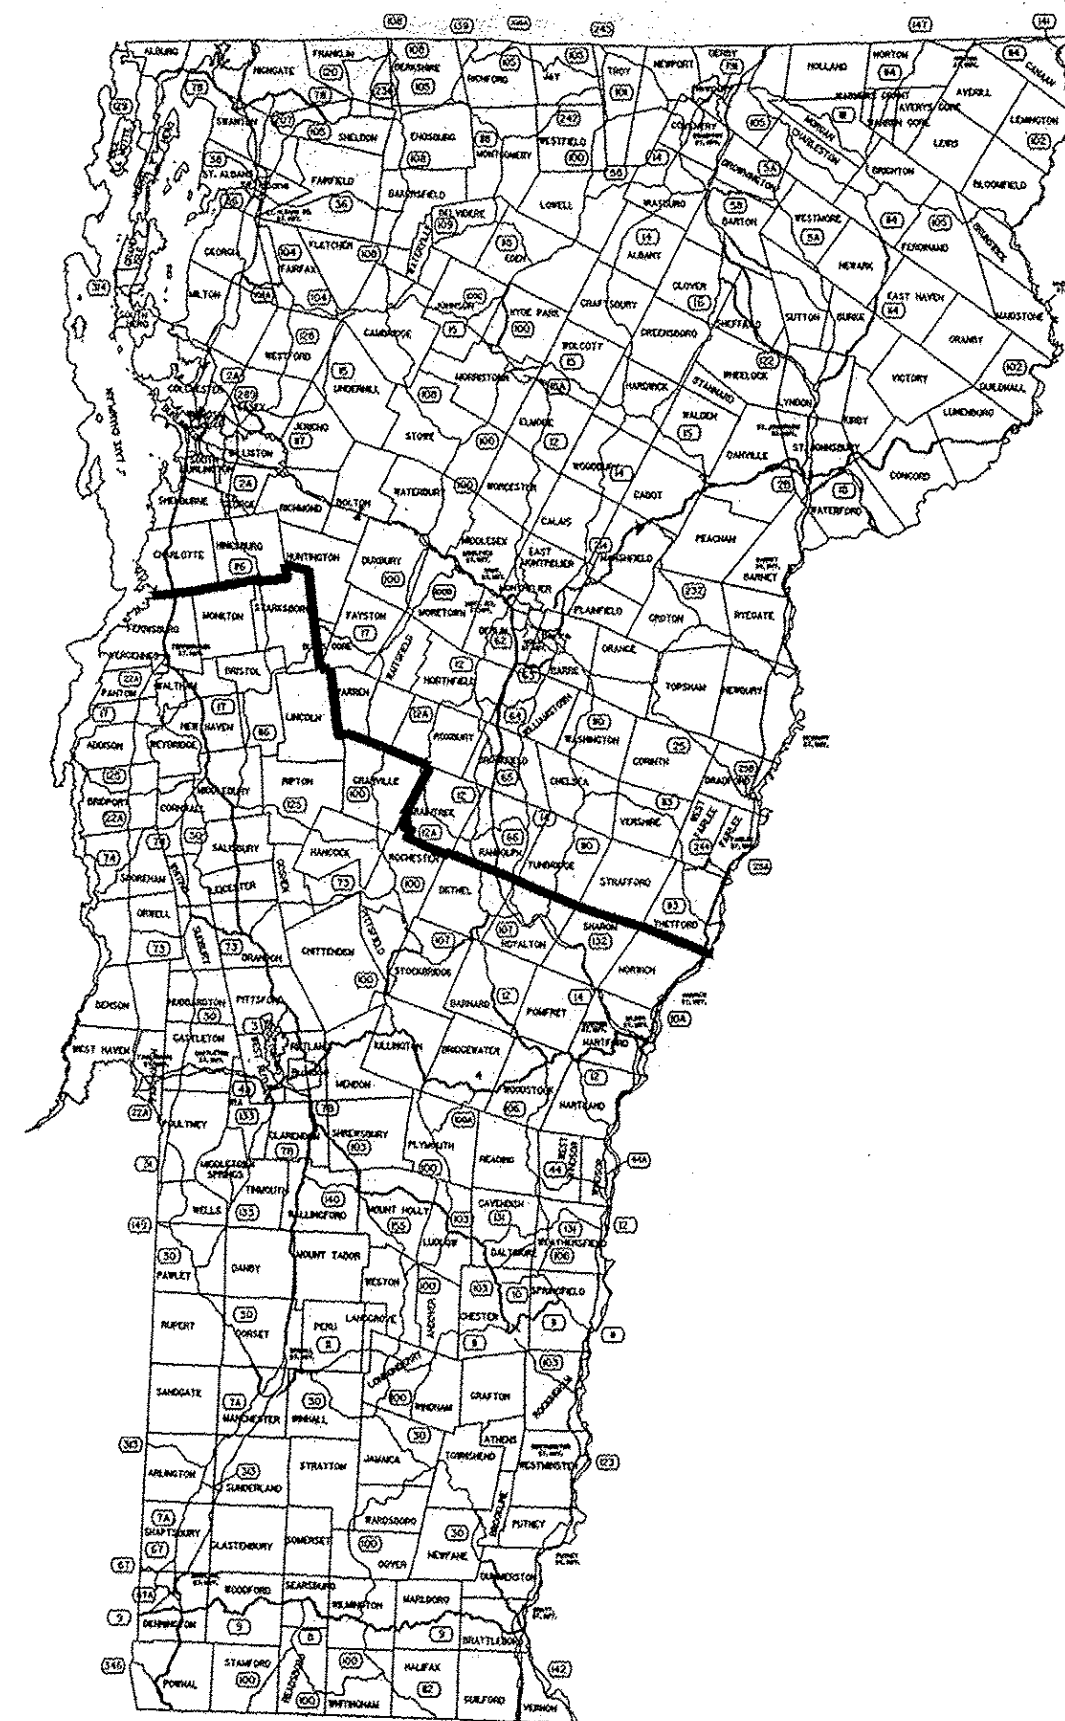

THESE PLANS ARE SUBJECT TO SUCH ENGINEERING CHANGES AS MAY BE REQUIRED BY THE FEDERAL HIGHWAY ADMINISTRATION OR THE DIRECTOR OF PROGRAM DEVELOPMENT.

CONSTRUCTION IS TO BE CARRIED ON IN ACCORDANCE WITH THESE PLANS AND THE STANDARD SPECIFICATIONS FOR CONSTRUCTION DATED 2011, AS APPROVED BY THE FEDERAL HIGHWAY ADMINISTRATION ON JULY 20, 2011 FOR USE ON THIS PROJECT, INCLUDING ALL SUBSEQUENT REVISIONS AND SUCH REVISED SPECIFICATIONS AND SPECIAL PROVISIONS AS ARE INCORPORATED IN THESE PLANS.

QUALITY ASSURANCE PROGRAM : LEVEL 3	
SURVEYED BY :	N/A
SURVEYED DATE :	N/A
DATUM	
VERTICAL	N/A
HORIZONTAL	N/A

DIRECTOR OF PROGRAM DEVELOPMENT	
APPROVED	<i>Kevin A. Marshall</i> DATE 3/12/14
PROJECT MANAGER : Patricia Coburn P.E.	
PROJECT NAME :	STATEWIDE SOUTH
PROJECT NUMBER :	HES MARK (403)
SHEET 1 OF 29 SHEETS	