


# STATE OF VERMONT AGENCY OF TRANSPORTATION

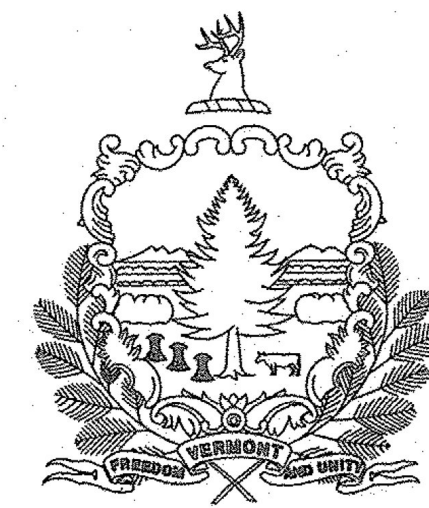

## PROPOSED IMPROVEMENT GRADE CROSSING PROJECT

TOWN OF NEW HAVEN  
COUNTY OF ADDISON



ROUTE NO: TH 26 (CAMPGROUND ROAD) RURAL LOCAL

DOT CROSSING NO: 851364Y

PROJECT LOCATION: RAIL-HIGHWAY CROSSING AARDOT 851364Y AT THE VERMONT RAILWAY, INC (VTR) NORTHERN MP 92.55 AND CAMPGROUND ROAD APPROXIMATELY 0.36 MILES WEST OF US 7 ETHAN ALLEN HIGHWAY.

PROJECT DESCRIPTION: RECONSTRUCTION OF AN EXISTING RAILROAD CROSSING, WELDED RAIL PANEL THROUGH CROSSING, SUPERELEVATION CHANGES TO RAILROAD, MODIFICATIONS TO ROADWAY PROFILE, PAVEMENT MARKINGS, SIGNS AND NEW ACTIVE WARNING DEVICES INCLUDING GATES AND FLASHERS.

PROJECT LENGTH: LENGTH OF ROADWAY: 275.00 FT  
LENGTH OF RAILROAD: 125.00 FT

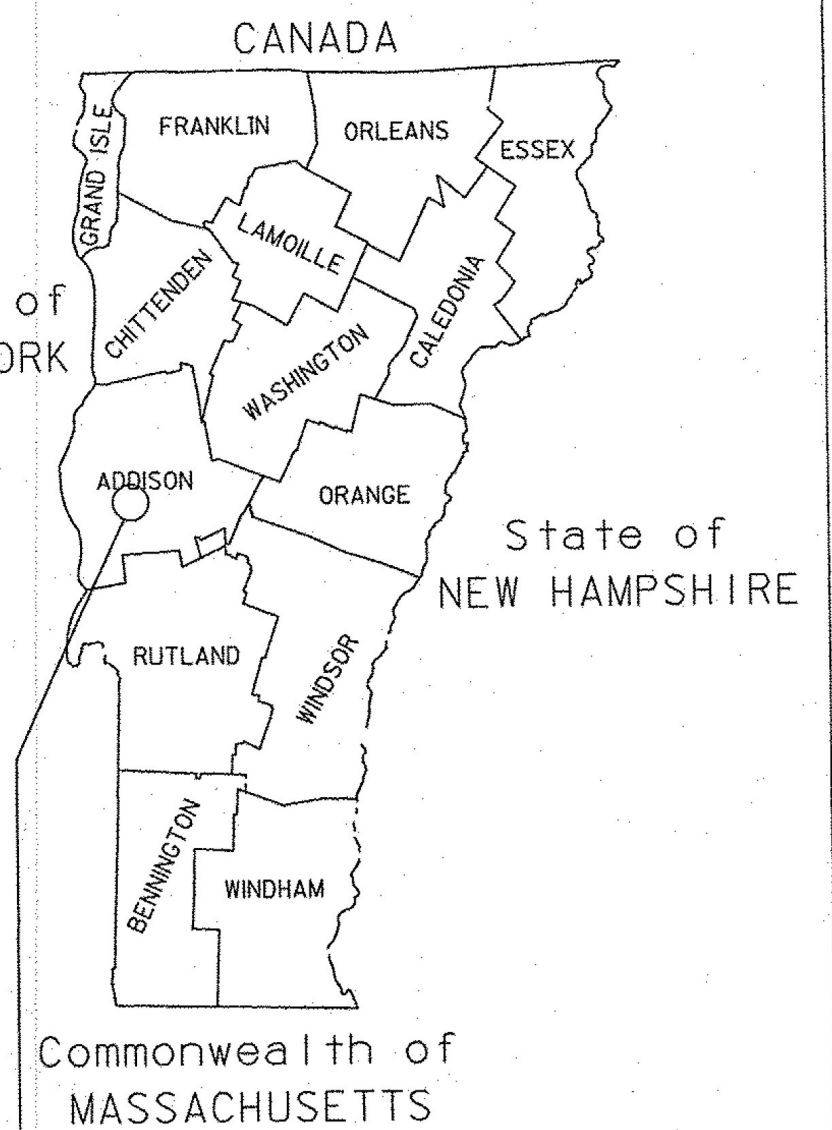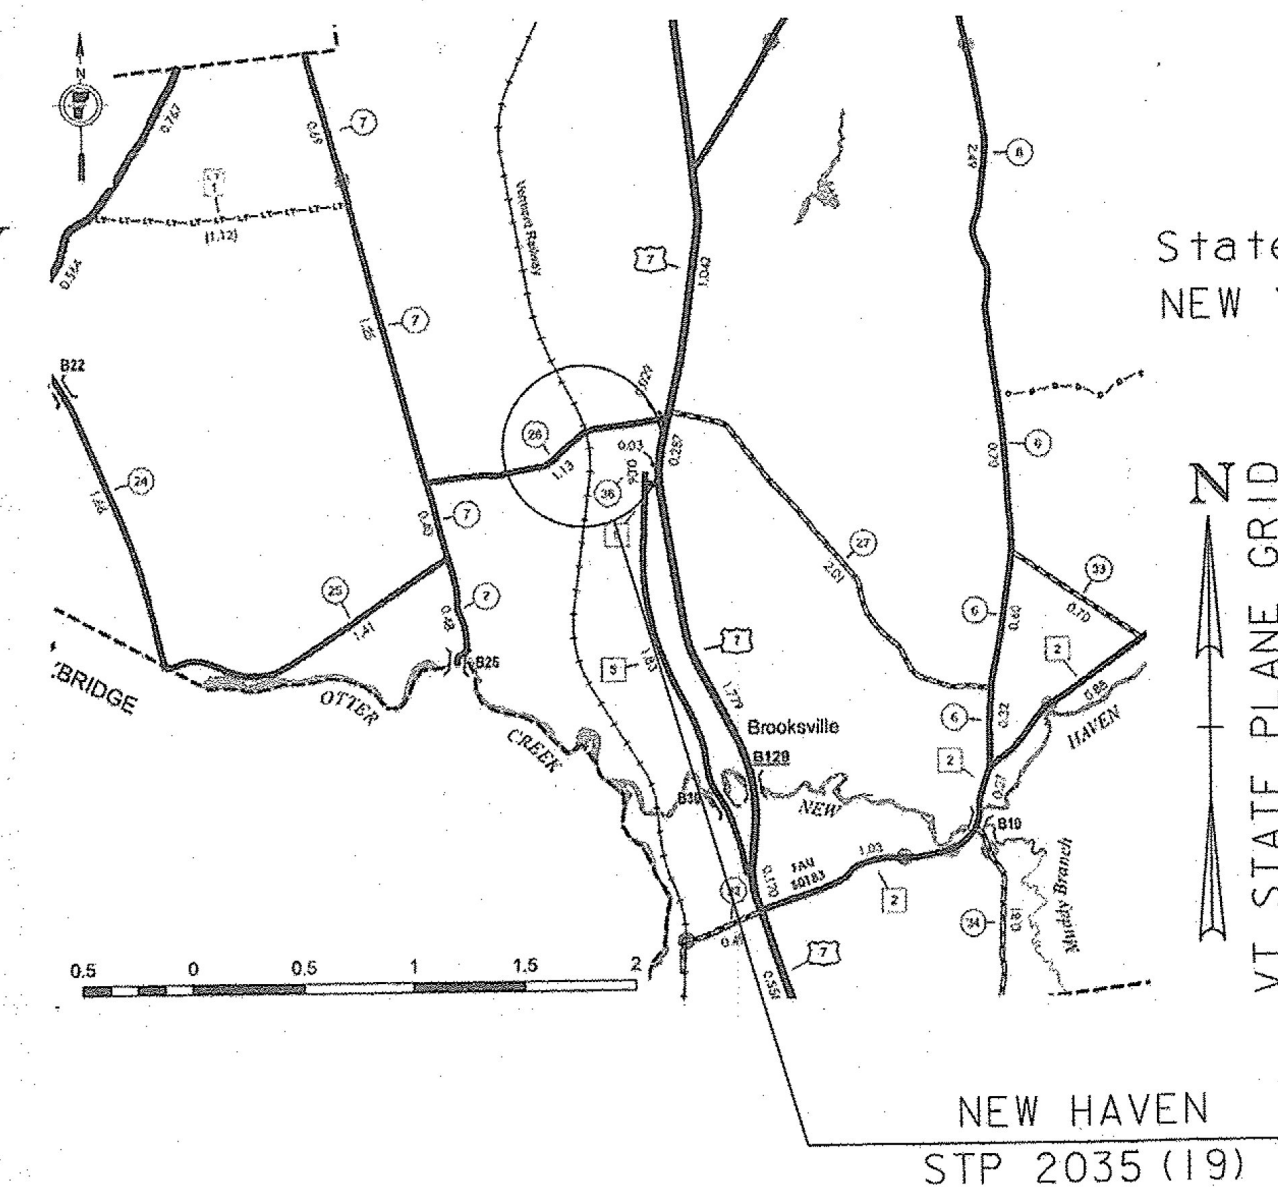



**Record Plans**  
Contractor: ENGINEERS CONSTRUCTION, INC.  
Resident Engineer: JOE KNIPES  
Construction Began: JUNE 9, 2017  
Construction Complete: NOVEMBER 30, 2017  
Record Plans By: JOE KNIPES & JESSE IVES

I hereby certify that all construction required by this set of drawings has been accomplished as indicated herein.

BY: Joe Knipes Resident Engineer  
on 2018-10-11 14:52:06 GMT


Date: October 11, 2018

NOTE: Any further information concerning final quantities, amounts or other details relative to this project may be found at Central Files in the electronic archives.

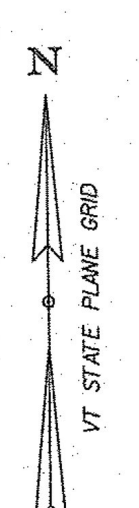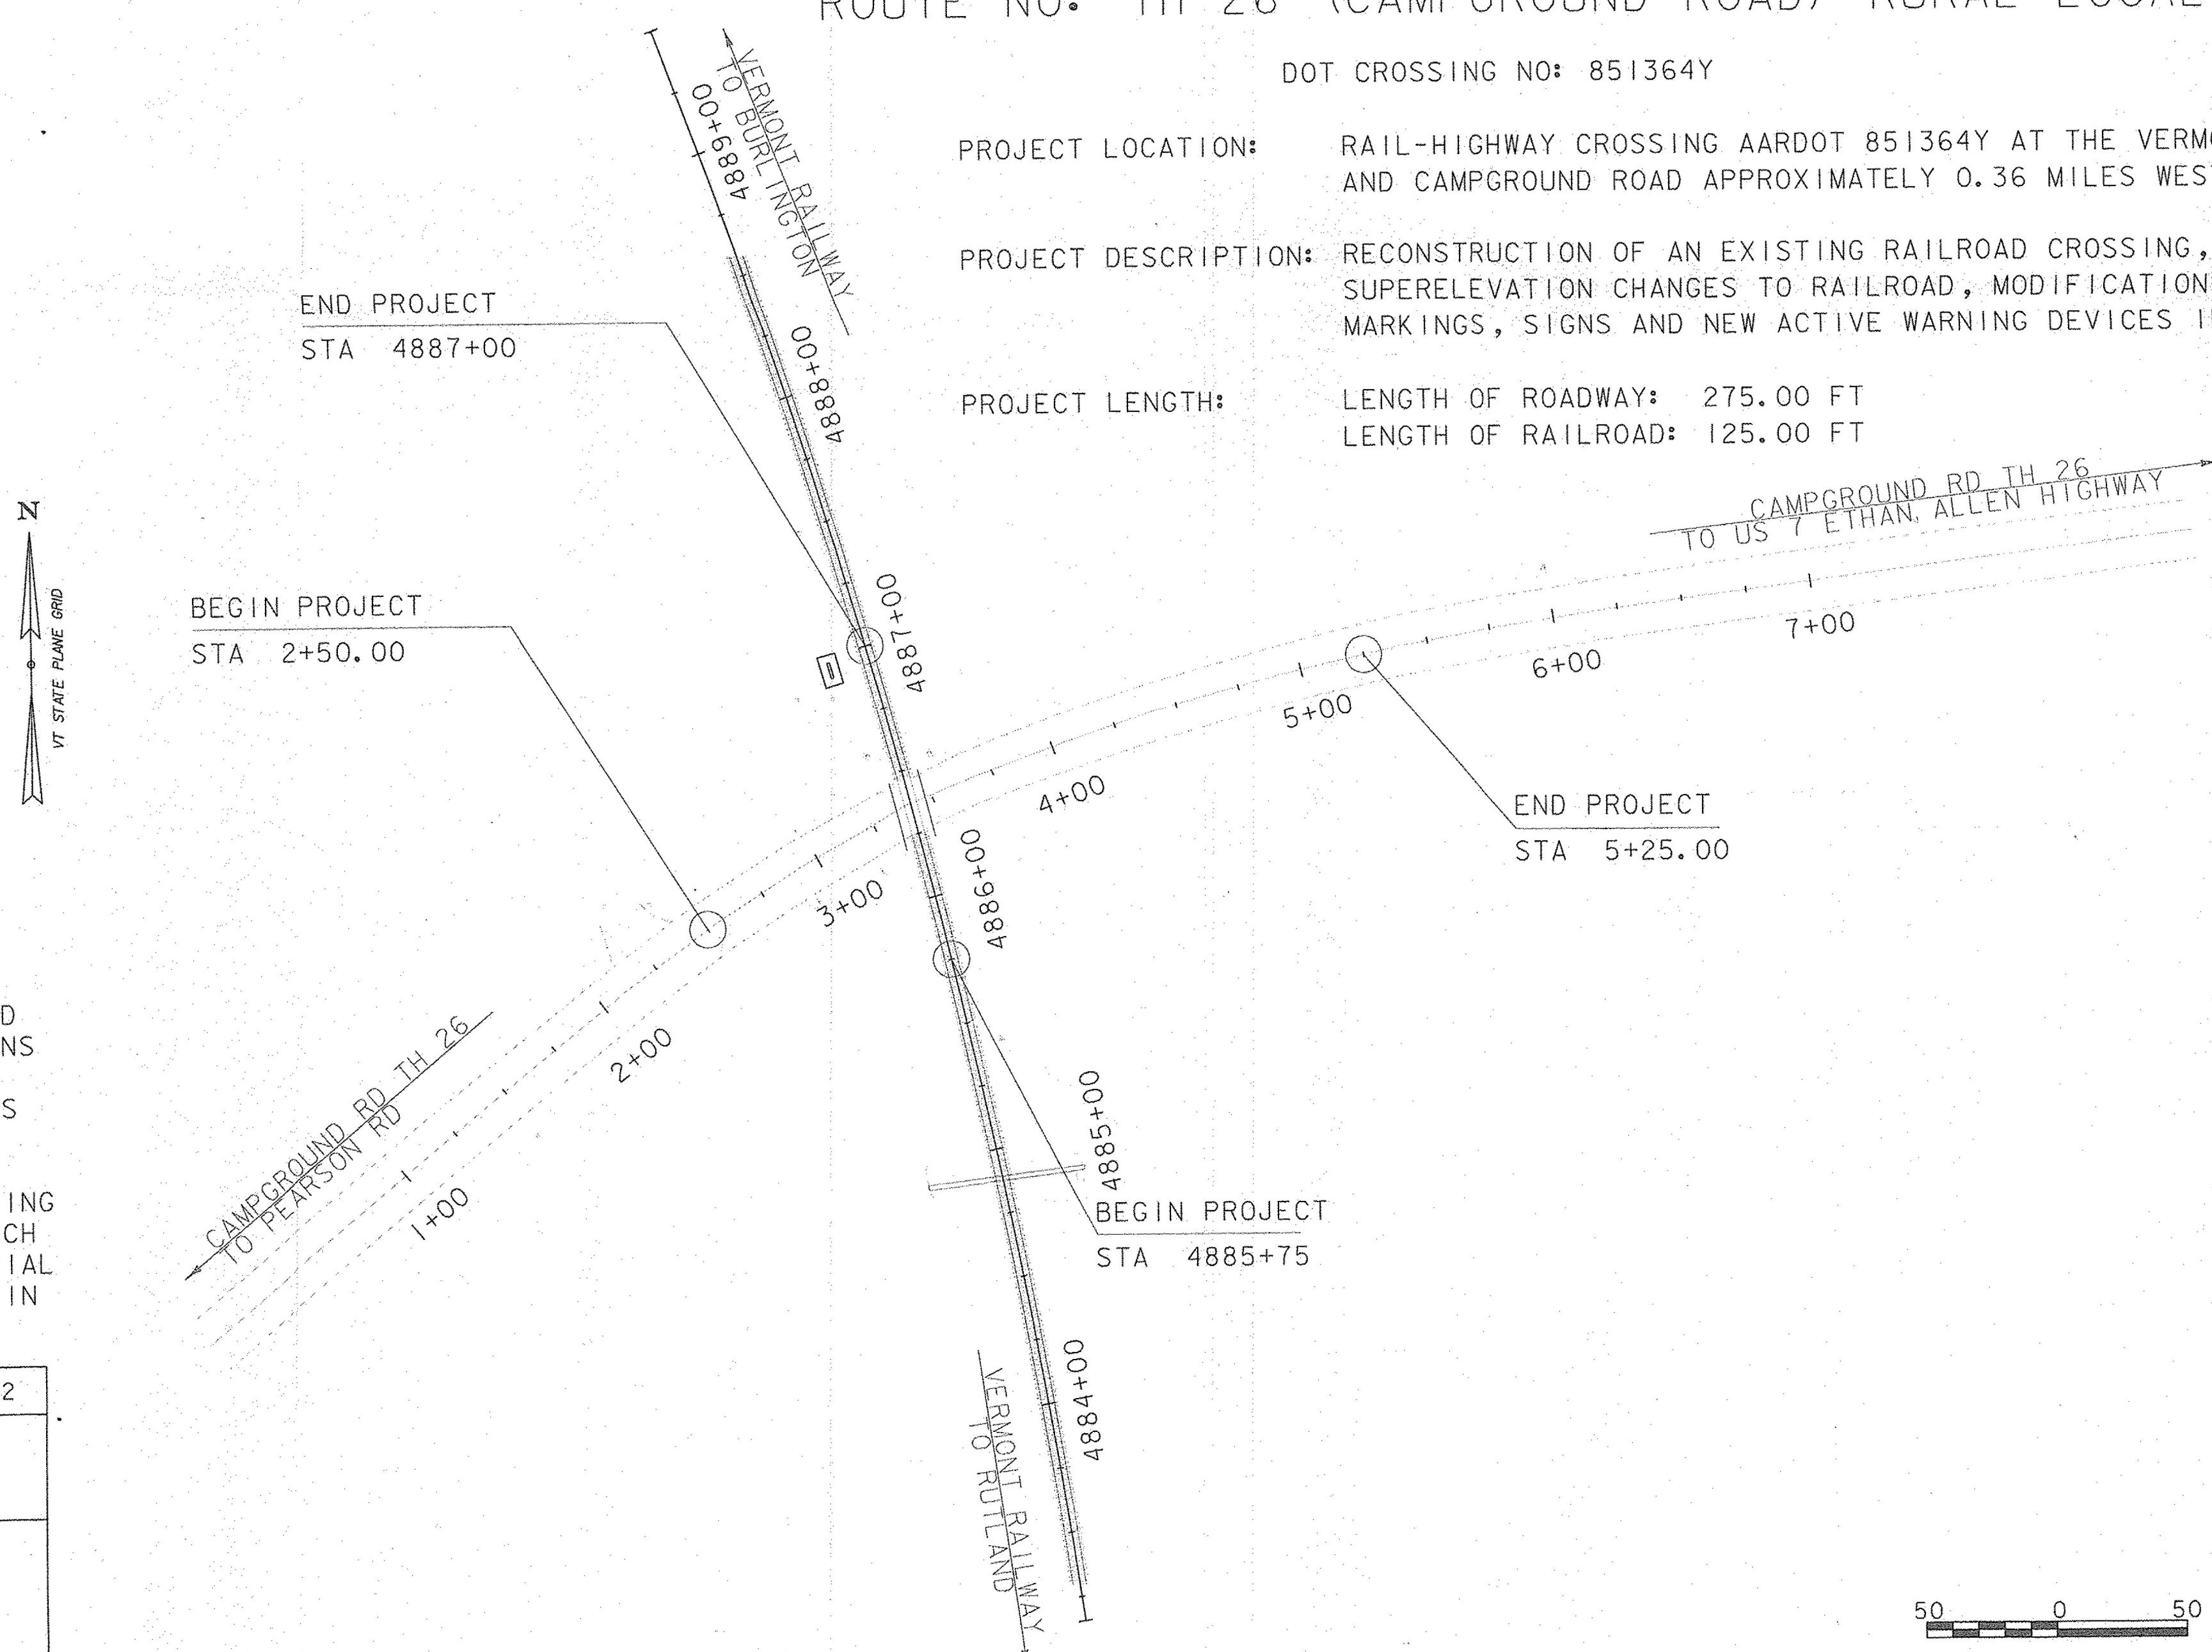


CONSTRUCTION IS TO BE CARRIED ON IN ACCORDANCE WITH THESE PLANS AND THE STANDARD SPECIFICATIONS FOR CONSTRUCTION DATED 2011, AS APPROVED BY THE FEDERAL HIGHWAY ADMINISTRATION ON JULY 20, 2011 FOR USE ON THIS PROJECT, INCLUDING ALL SUBSEQUENT REVISIONS AND SUCH REVISED SPECIFICATIONS AND SPECIAL PROVISIONS AS ARE INCORPORATED IN THESE PLANS.

QUALITY ASSURANCE PROGRAM : LEVEL 2	
SURVEYED BY :	V. S. E.
SURVEYED DATE :	2/8/2016
DATUM	
VERTICAL	NAVD 88
HORIZONTAL	NAD 83 (2011)

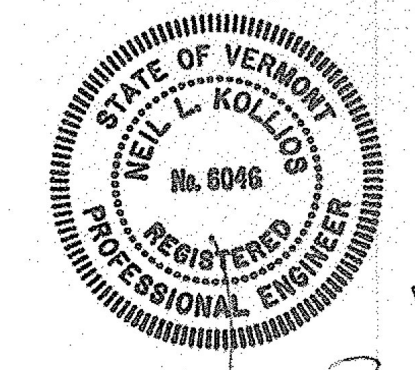

HDR ENGINEERING, INC. DATE 2/24/17  
TRACK

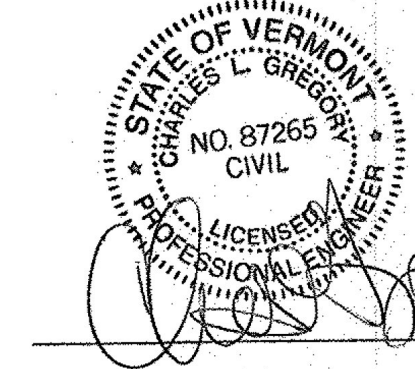

HDR ENGINEERING, INC. DATE 2/24/17  
CIVIL

RAIL PROGRAM DIRECTOR	APPROVED: <u>Andrew Gardner</u> DATE <u>2/24/17</u>
PROJECT MANAGER : COS GARDNER	
PROJECT NAME : NEW HAVEN	
PROJECT NUMBER : STP 2035 (19)	
SHEET 1 OF 42 SHEETS	

