

PIKE INDUSTRIES, INC.

STA 3+41.03 TH 26 =
STA 4886+34.34 RR

STA 2+50.00
BEGIN PROJECT

EXISTING TOWN R.O.W.

1+00

2+00

3+00


4+00

5+00

STA 5+25.00
END PROJECT

TRILEASE, INC.

STABILIZED CONSTRUCTION
ENTRANCE, (WEST ACCESS)

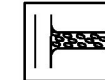

CHAMPLAIN PRECISION, INC.

STABILIZED CONSTRUCTION
ENTRANCE, (EAST ACCESS)



SCALE 1" = 20'-0"
20 0 20



PROJECT NAME: NEW HAVEN
PROJECT NUMBER: STP 2035 (19)

FILE NAME: z13g606bdr_ero.dgn
PROJECT LEADER: R. O'BLENIS
DESIGNED BY: W. TSE
EPSC PROPOSED LAYOUT

PLOT DATE: 2/15/2017
DRAWN BY: W. TSE
CHECKED BY: R. O'BLENIS
SHEET 18 OF 42