


GATE MECH "B" US&S MODEL 95 WITH MAINTENANCE SWITCH (OR APPROVED EQUAL)

TEST LINK BETWEEN 5B & 6B OPENS WITH GOLD NUT LOOSENED

CONTACT	CLOSED	FUNCTION
1	0° - 89°	MOTOR UP
2		VACANT SLOT
3	46° - 93°	MOTOR DN
4	5° - 93°	BELL
5	0° - 5°	GATE DN IND
6	83° - 90°	GATE UP IND

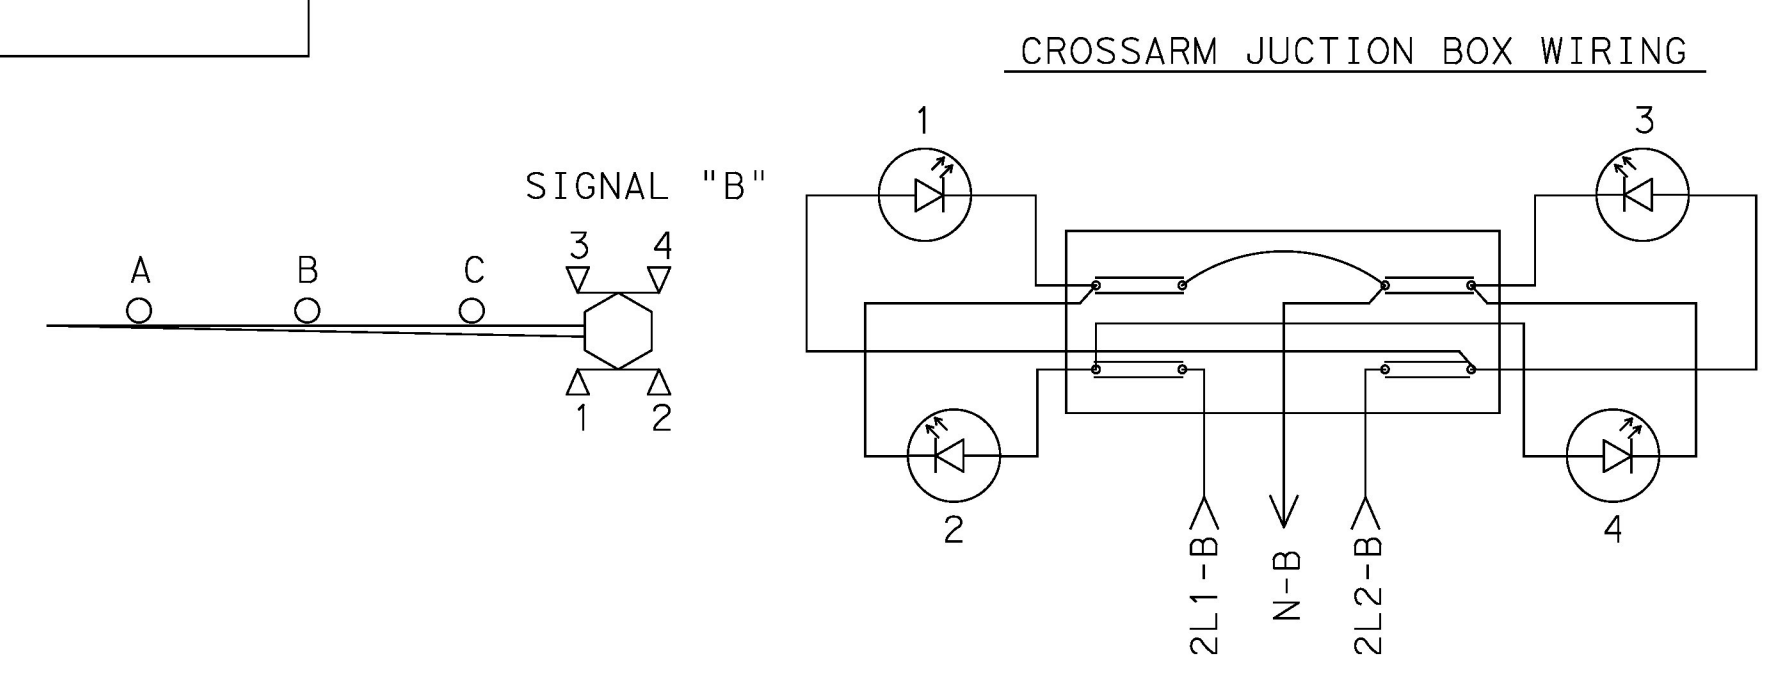

PROJECT NAME: NEW HAVEN  
 PROJECT NUMBER: STP. 2035 (19)  
 FILE NAME: SIGNAL B WIRING.dgn PLOT DATE: 02/15/17  
 PROJECT LEADER: DRAWN BY: J.L.S.  
 DESIGNED BY: D.W.S. CHECKED BY: K.N.  
 SIGNAL PLANS-SIGNAL "B" WIRING SHEET 37 OF 42