




SIDE "A" WALL

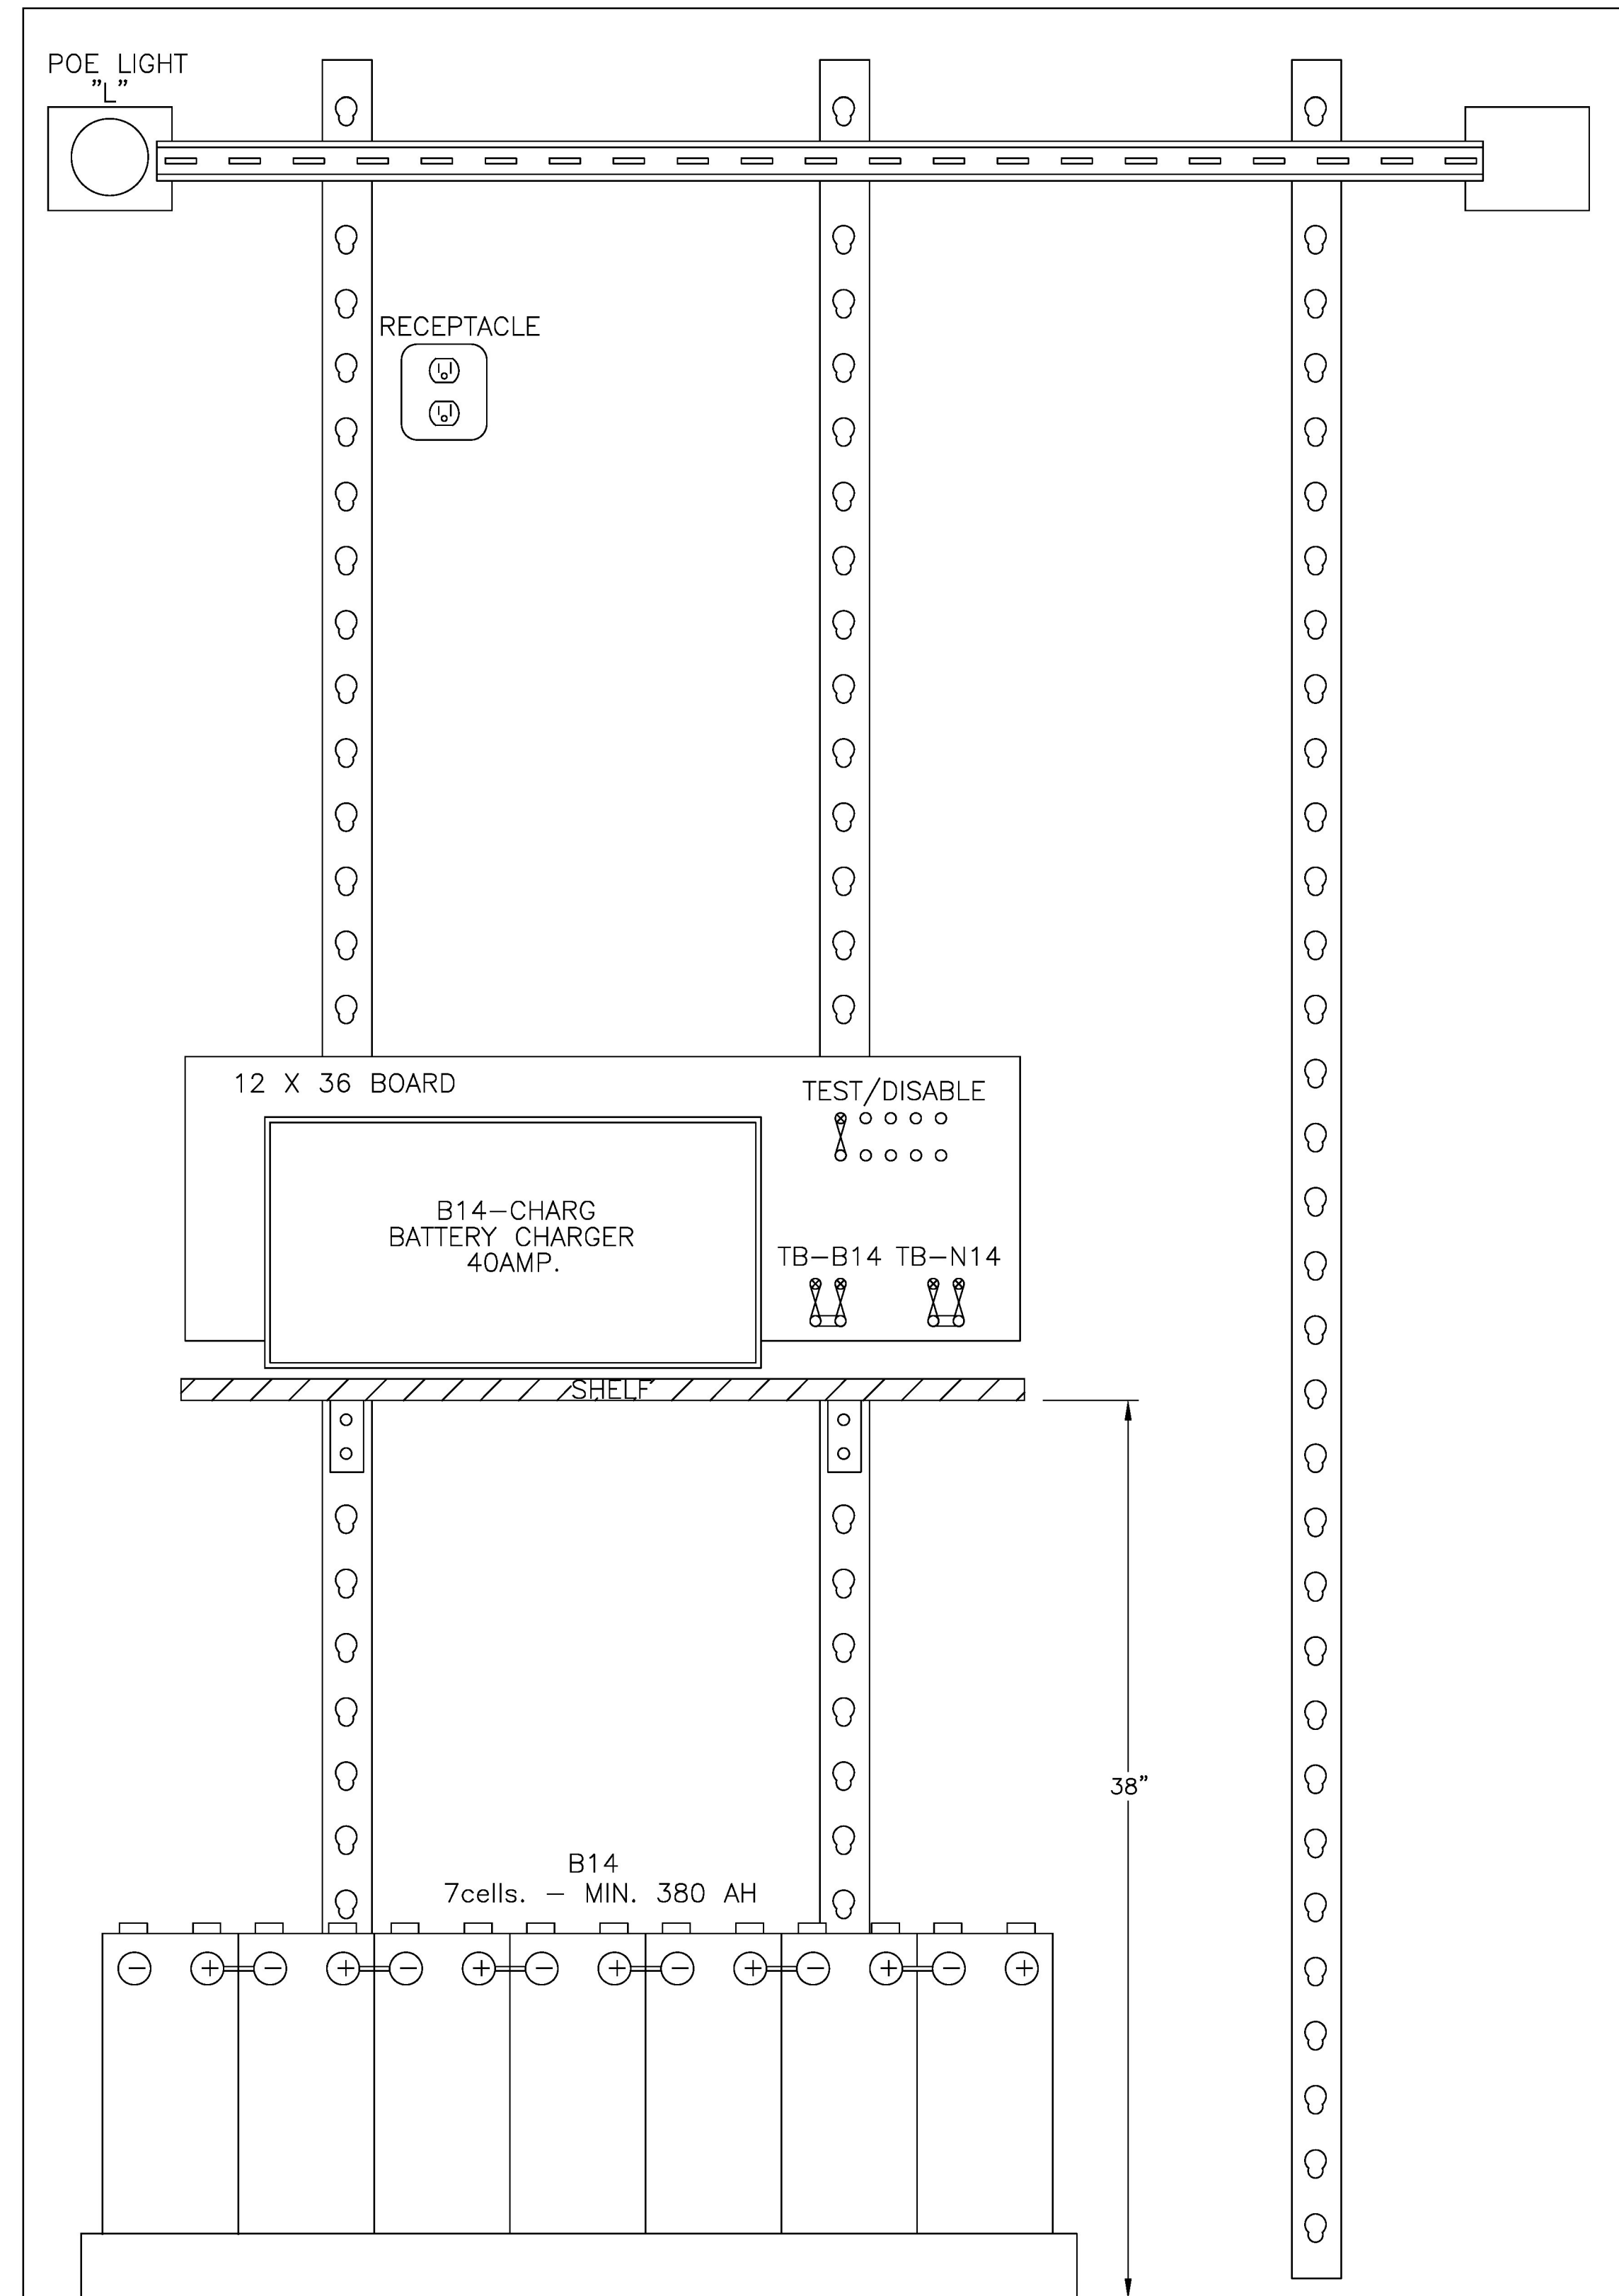

SIDE "C" WALL

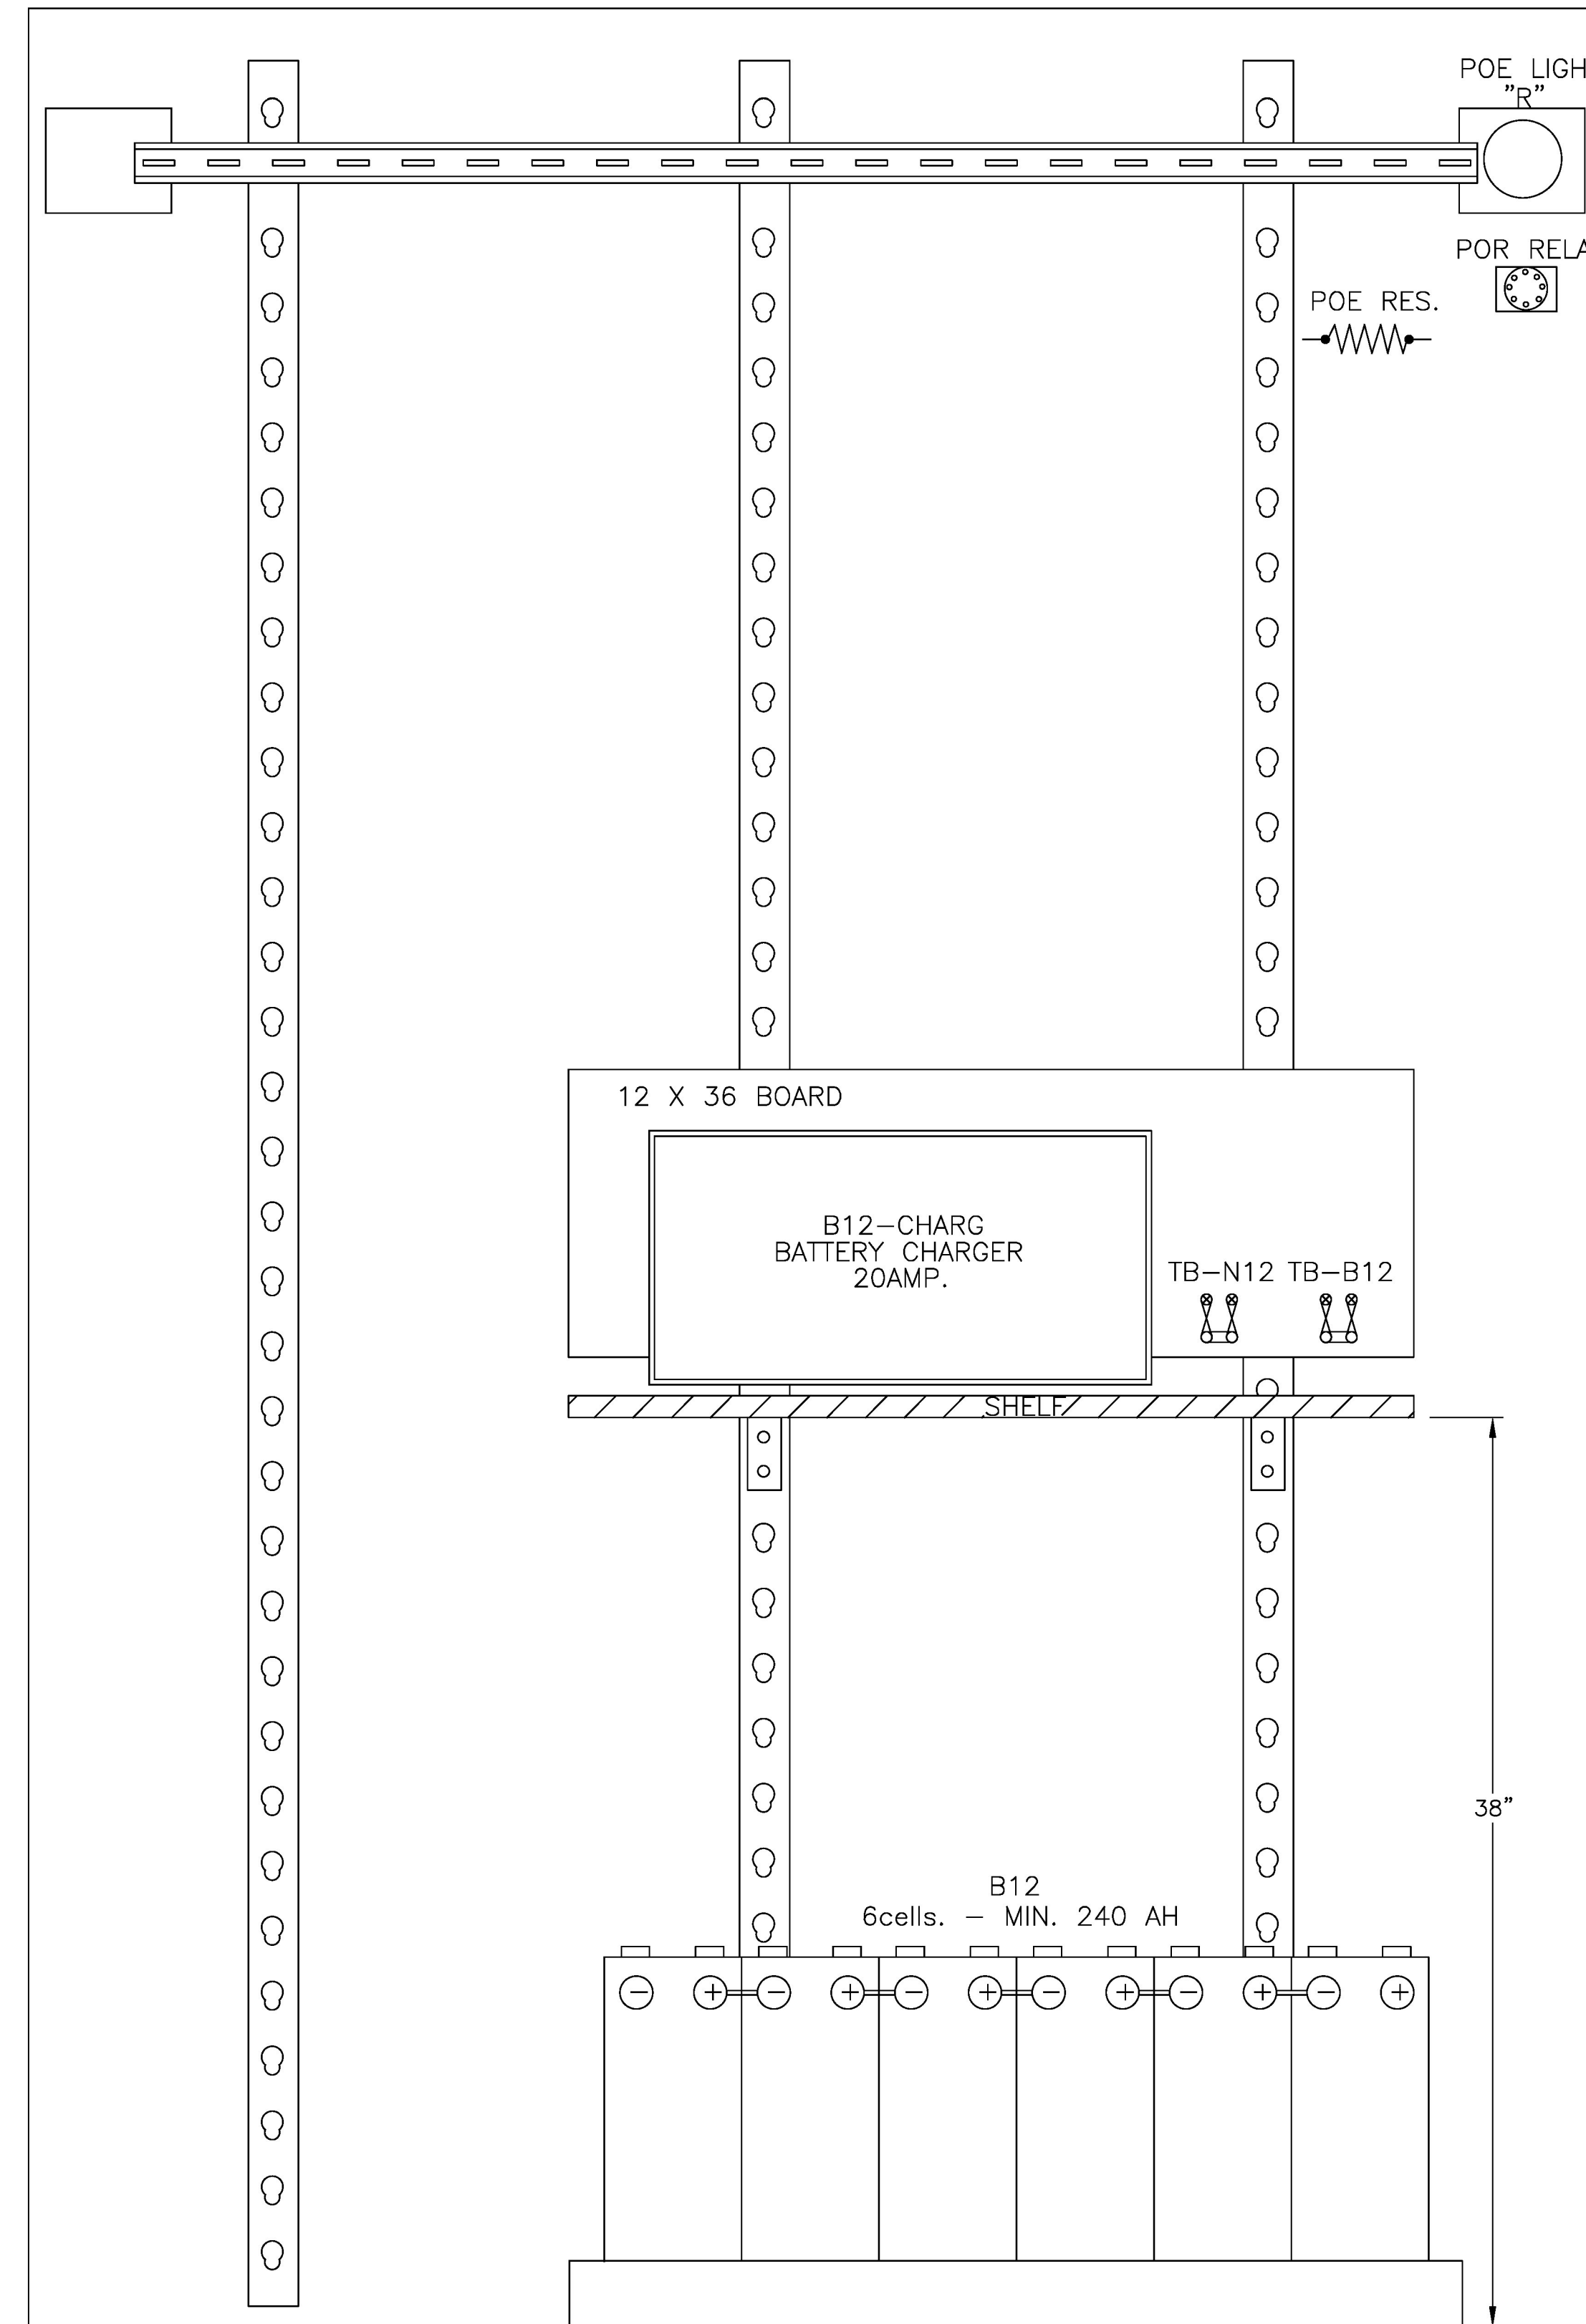

SIDE "D" WALL

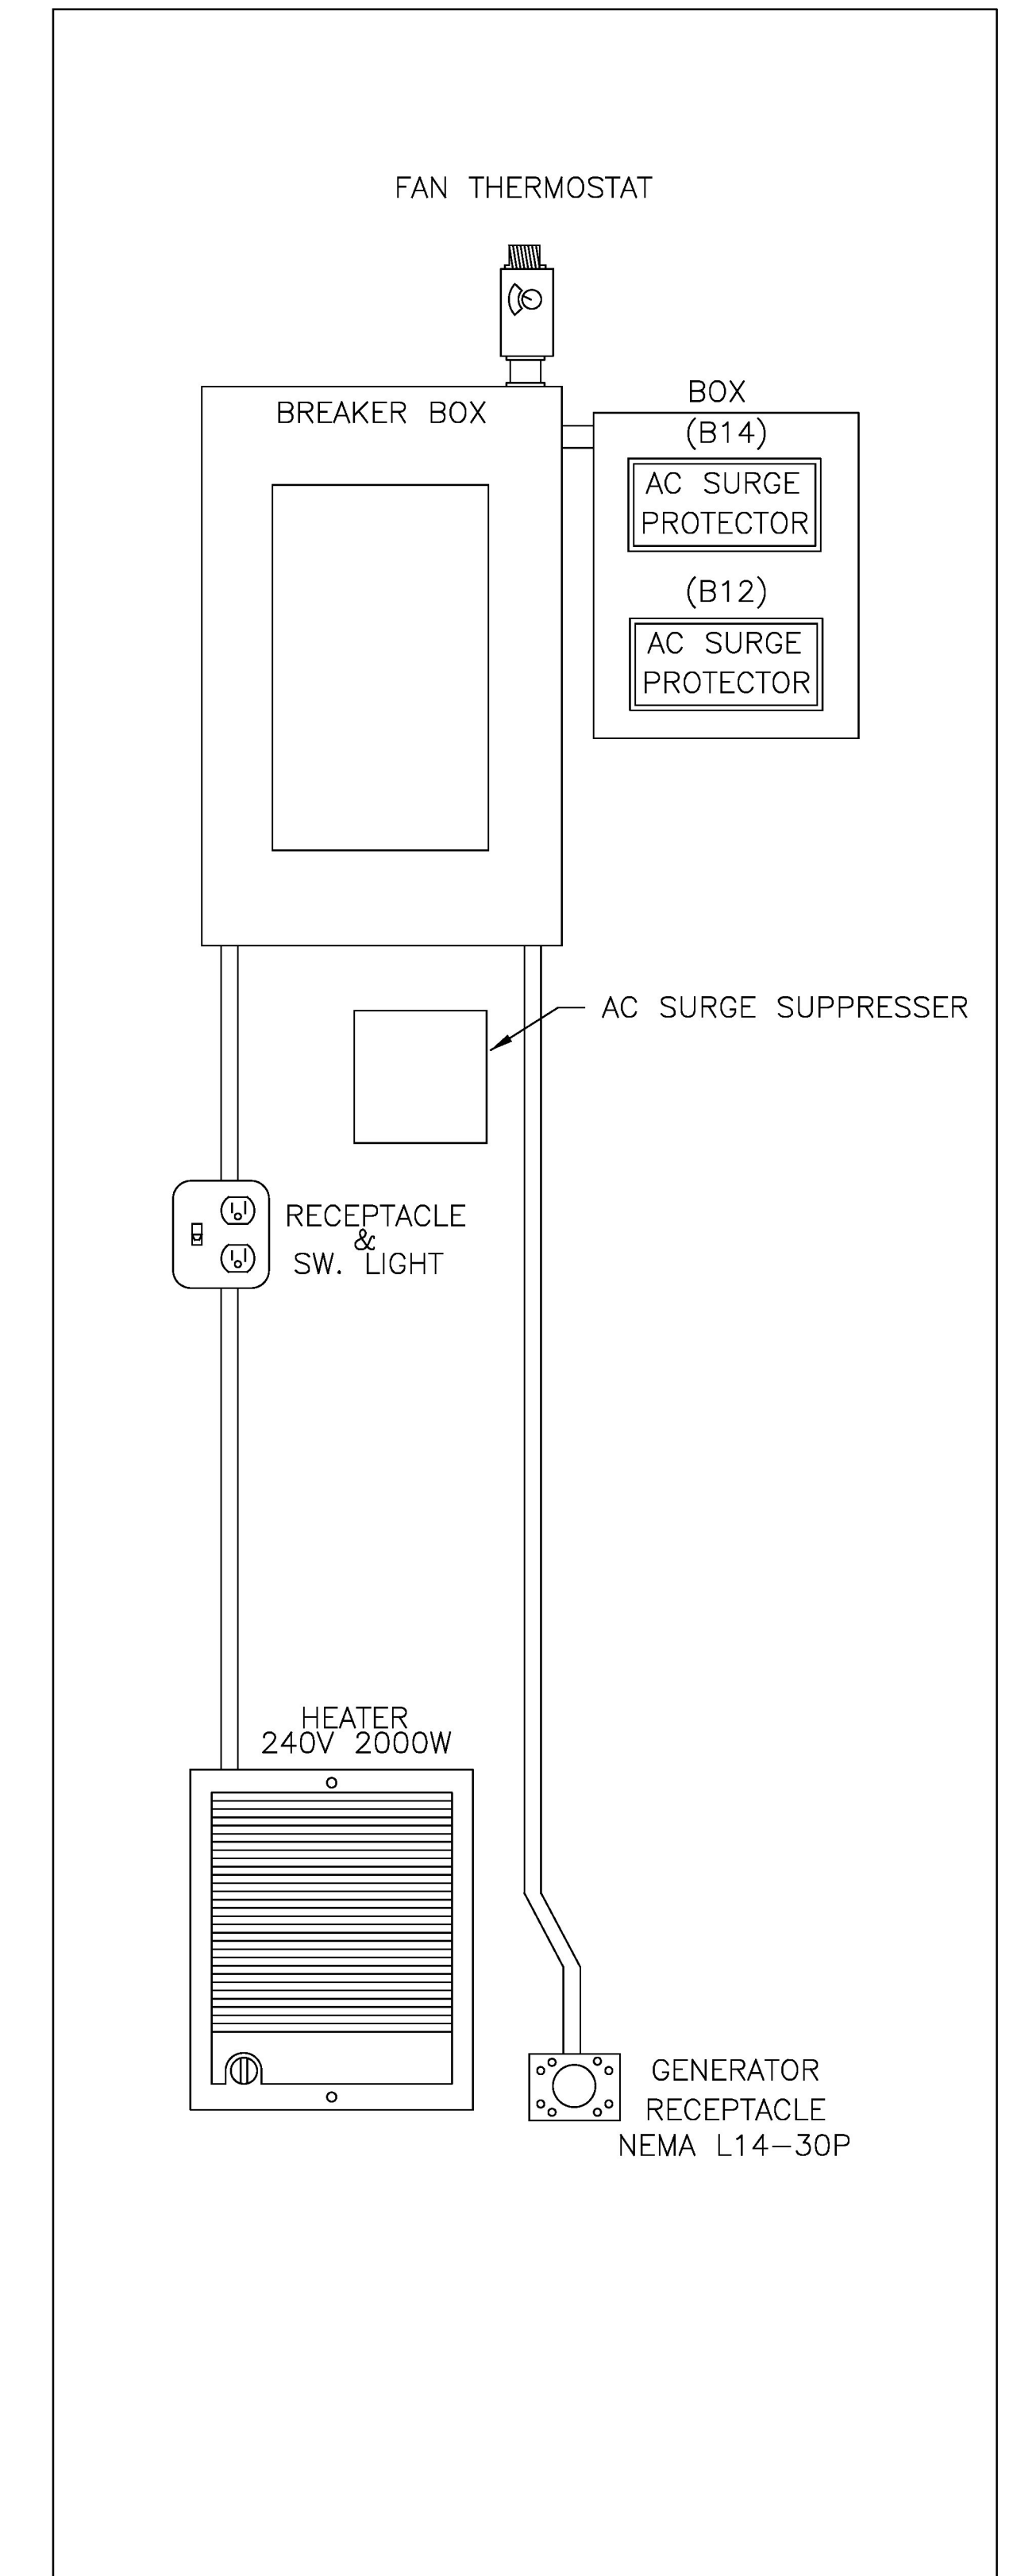

PROJECT NAME: NEW HAVEN
PROJECT NUMBER: STP. 2035 (19)

FILE NAME: WALL LAYOUTS.dgn
PROJECT LEADER:
DESIGNED BY: D.W.S.
SIGNAL PLANS-WALL LAYOUTS

PLOT DATE: 02/15/17
DRAWN BY: J.L.S.
CHECKED BY: K.N.
SHEET 41 OF 42