
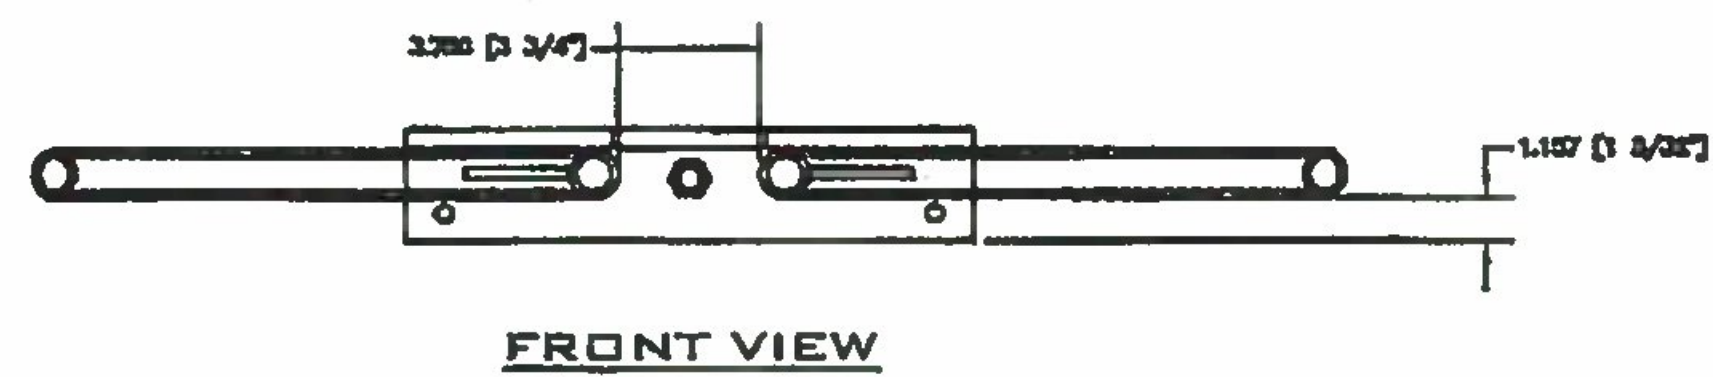


Sales Drawing

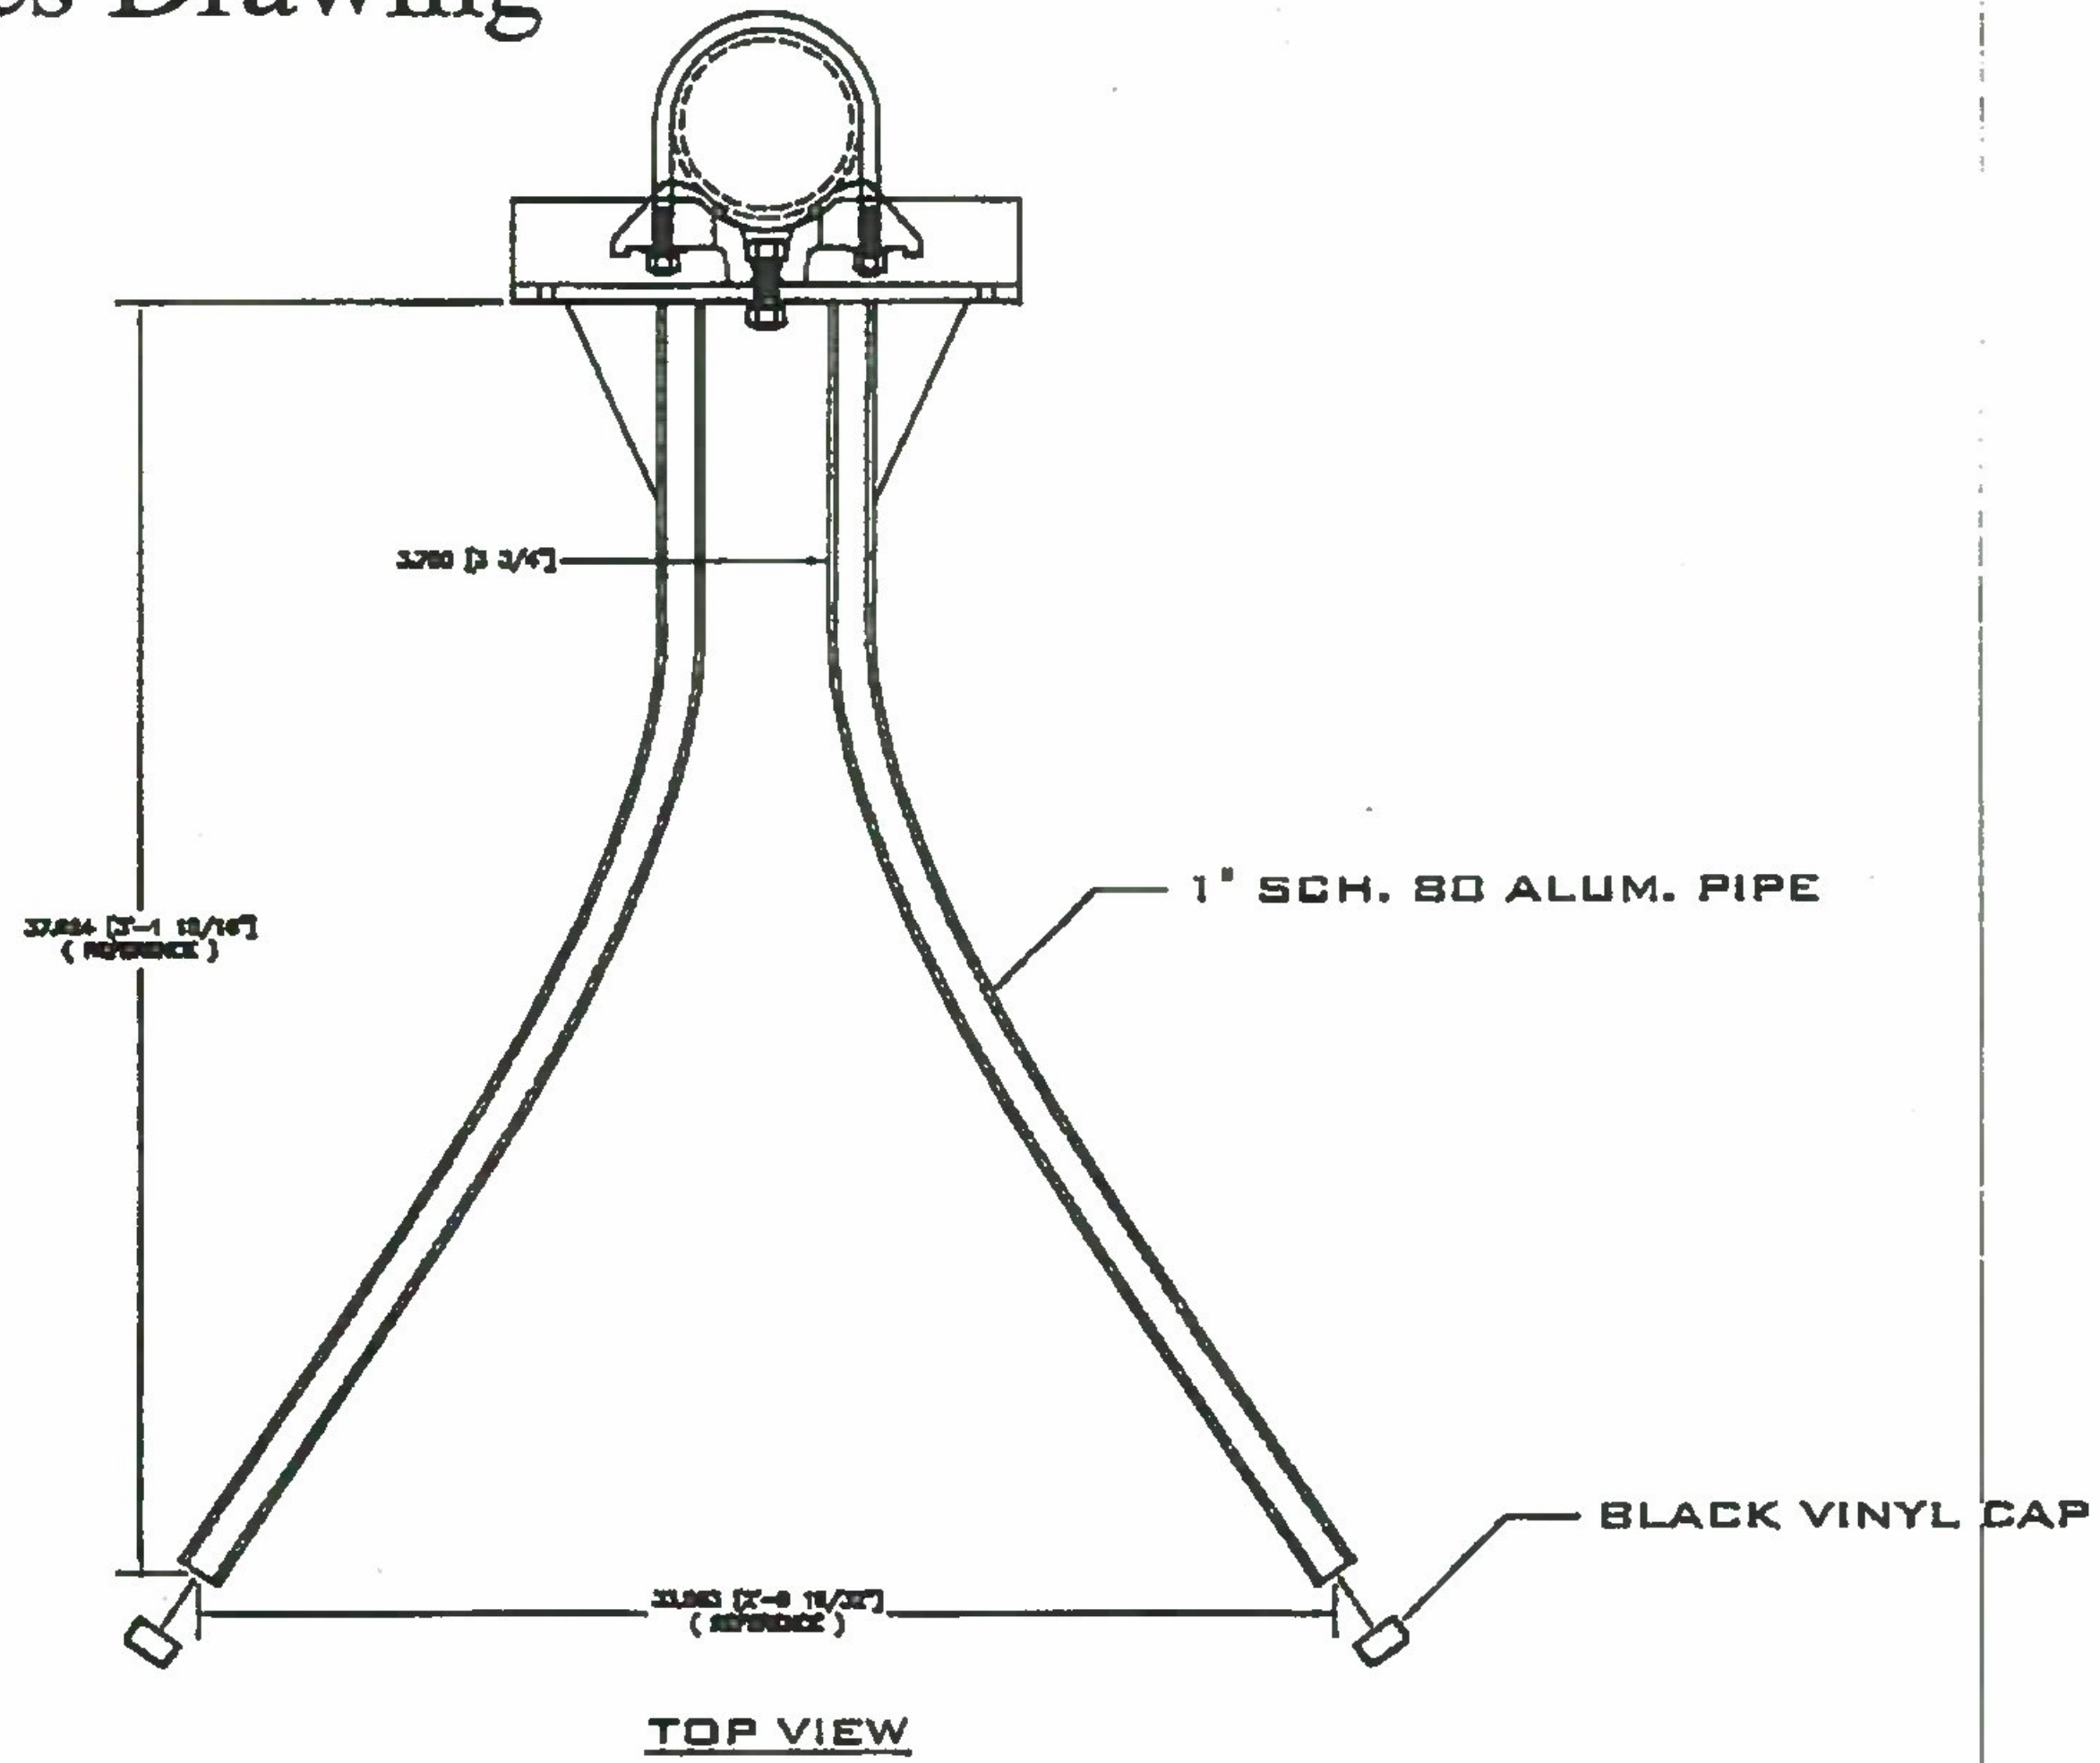

Please note for future submittals rotate pages to be correct orientation and include a submittal letter, submittal #, project & pay item reference, date, etc... Also, include page # so comments can be directly referenced.

PART # 9459001501	PROGRESS SIGNAL DIVISION		
THE DRAWING IS PROPRIETARY PROPERTY OF PROGRESS RAIL SERVICES	DATE: 09-10-03	EDL #	APP'D: M/H 09-10-03
UNLESS OTHERWISE SPECIFIED DIMENSIONS ARE IN INCHES	DRAWN BY: WD	SCALE: NONE	SHEET: E1 OF E4
TOLERANCES DECIMAL FRACTIONS .XX± ± .XXX±	HIGH WIND ASSEMBLY FOR 5" MAST		
DO NOT SCALE THIS DRAWING	DRAWING NUMBER: 9459001501		