


STATE OF VERMONT AGENCY OF TRANSPORTATION



PROPOSED IMPROVEMENT BRIDGE PROJECT

TOWN OF HUNTINGTON
COUNTY OF CHITTENDEN
TH-1, RURAL MAJOR COLLECTOR, FAS ROUTE 0211, BRIDGE NO 8

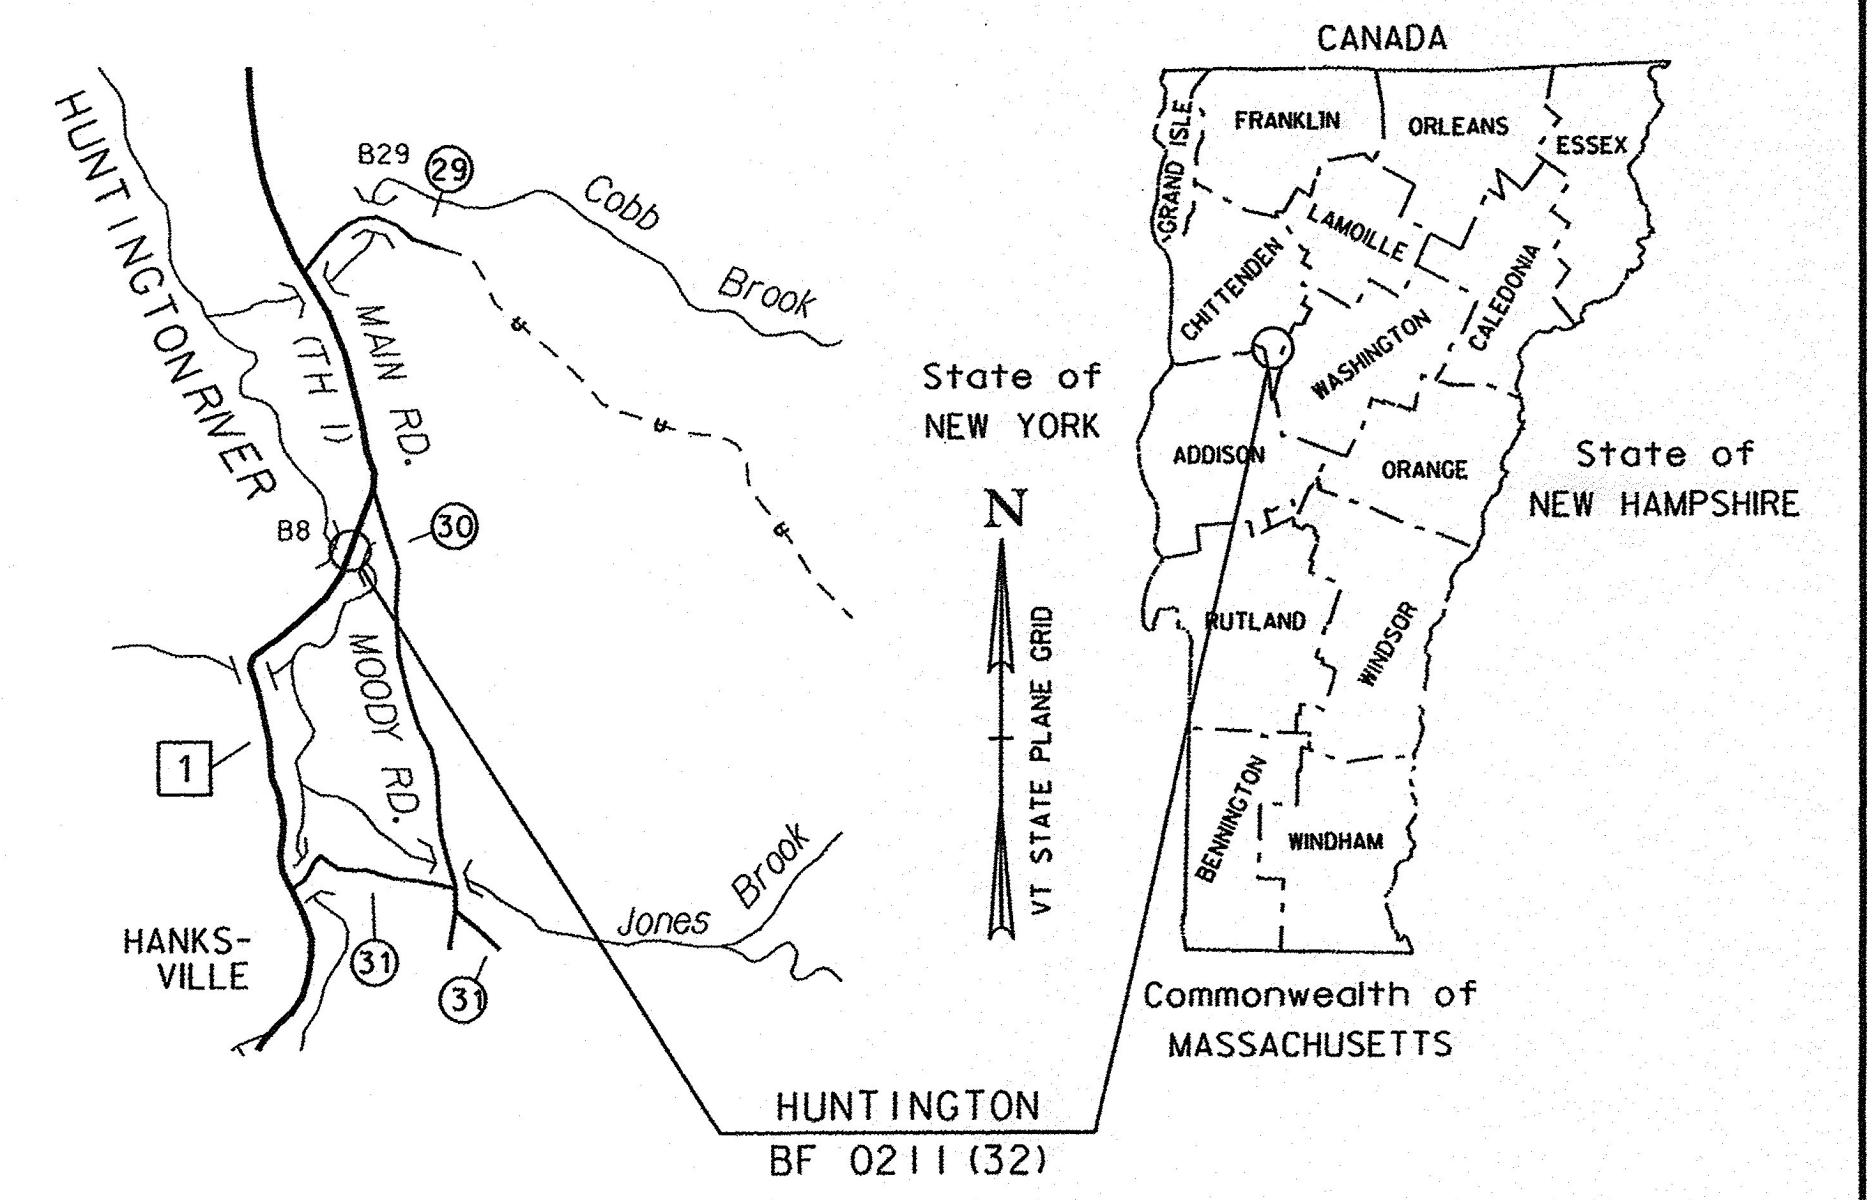


| RECORD PLANS | |
|--|--|
| CONTRACTOR: | S. D. IRELAND CONC. CONST. CORP - BURLINGTON, VT |
| RESIDENT ENGINEER: | GREG WILCOX |
| CONSTRUCTION BEGAN: | JUNE 19, 2017 |
| CONSTRUCTION COMPLETE: | SEPTEMBER 1, 2017 |
| RECORD PLANS BY: | GREG WILCOX & JESSE IVES |
| I HEREBY CERTIFY THAT ALL THE CONSTRUCTION REQUIRED BY THIS SET OF DRAWINGS HAS BEEN ACCOMPLISHED AS INDICATED HEREIN. | |
| BY | RESIDENT ENGINEER |
| DATE | 4/10/18 |
| NOTE: Any further information concerning final quantities, amounts or other details relative to this project may be found at Central Files in the electronic archives. | |

PROJECT LOCATION: LOCATED IN THE COUNTY OF CHITTENDEN, TOWN OF HUNTINGTON, ON TH 1 (FAS 0211), BRIDGE NO. 8 OVER HUNTINGTON RIVER, APPROXIMATELY 3.9 MILES NORTH OF TH 1'S JUNCTION WITH VT ROUTE 17.



PROJECT DESCRIPTION: WORK TO BE PERFORMED UNDER THIS PROJECT INCLUDES REMOVAL AND REPLACEMENT OF BRIDGE NO. 8 ON A NEW ALIGNMENT WITH ASSOCIATED ROADWAY AND CHANNEL WORK.

LENGTH OF STRUCTURE: 97.21 FEET
LENGTH OF ROADWAY: 302.79 FEET
LENGTH OF PROJECT: 400.00 FEET

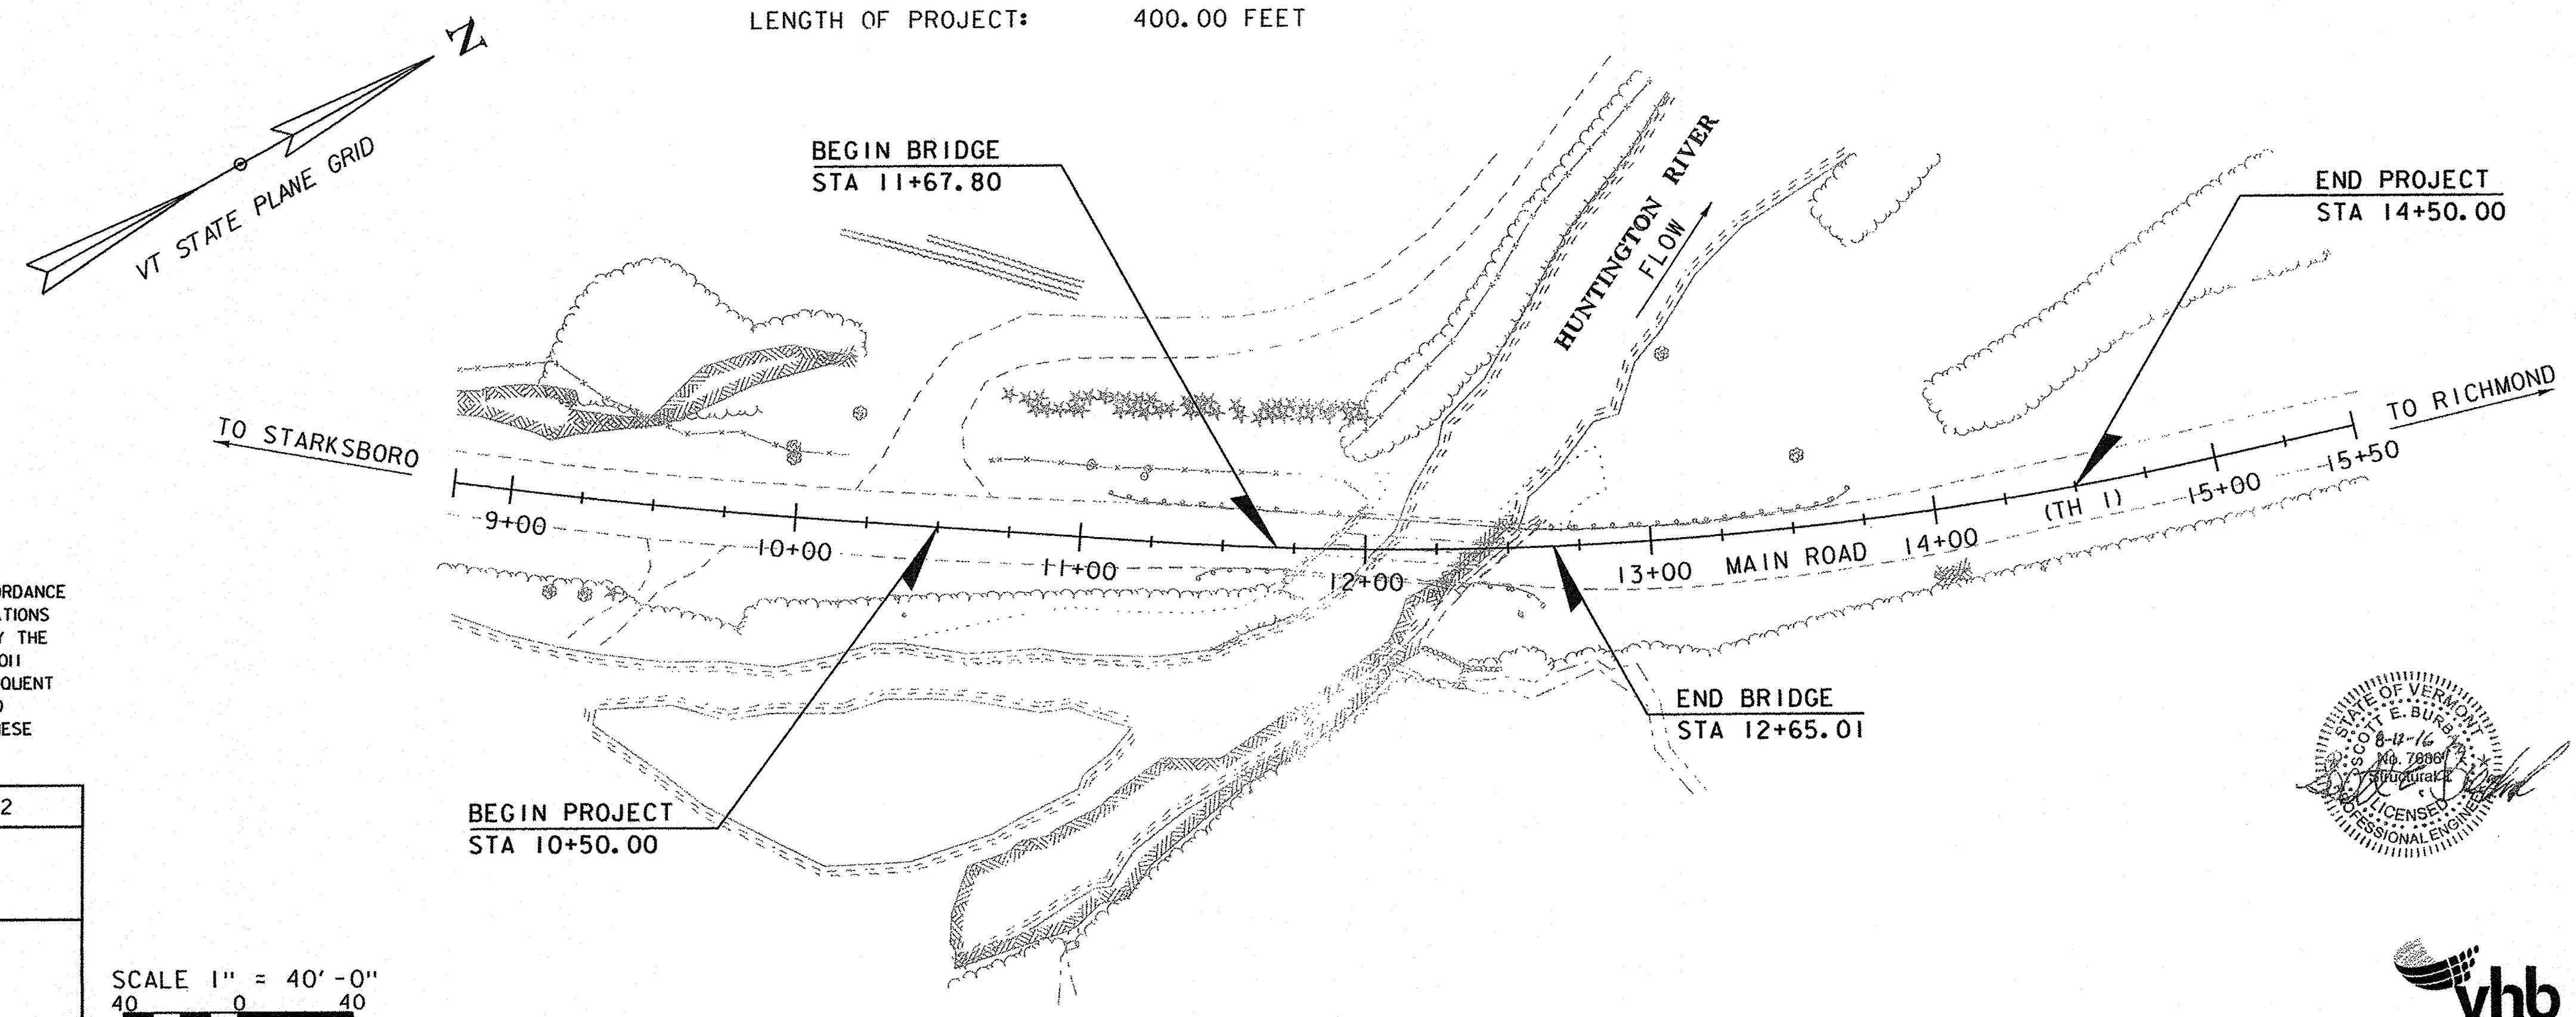

CONSTRUCTION IS TO BE CARRIED ON IN ACCORDANCE WITH THESE PLANS AND THE STANDARD SPECIFICATIONS FOR CONSTRUCTION DATED 2014, AS APPROVED BY THE FEDERAL HIGHWAY ADMINISTRATION ON JULY 20, 2011 FOR USE ON THIS PROJECT, INCLUDING ALL SUBSEQUENT REVISIONS AND SUCH REVISED SPECIFICATIONS AND SPECIAL PROVISIONS AS ARE INCORPORATED IN THESE PLANS.

| | |
|-------------------------------------|---------------|
| QUALITY ASSURANCE PROGRAM : LEVEL 2 | |
| SURVEYED BY : | L. ORVIS |
| SURVEYED DATE : | 06/17/2013 |
| DATUM | |
| VERTICAL | NAVD88 |
| HORIZONTAL | NAD 83 (2011) |

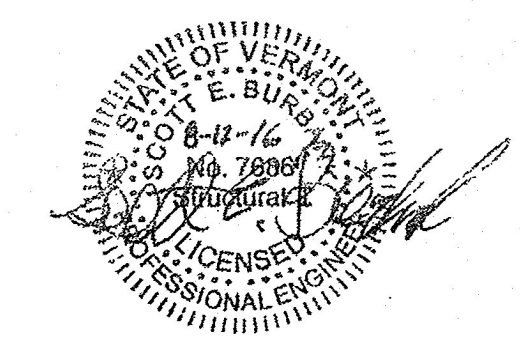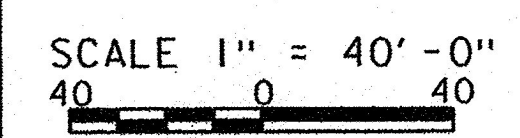

| | |
|--------------------------------------|----------------|
| DIRECTOR OF PROJECT DELIVERY | |
| APPROVED | DATE 8/22/2018 |
| PROJECT MANAGER : ROBERT YOUNG, P.E. | |
| PROJECT NAME : | HUNTINGTON |
| PROJECT NUMBER : | BF 0211 (32) |
| SHEET 1 OF 62 SHEETS | |

