


* - DIMENSIONS ARE RADIAL

TYPICAL BRIDGE SECTION


SCALE 3/8" = 1'-0"

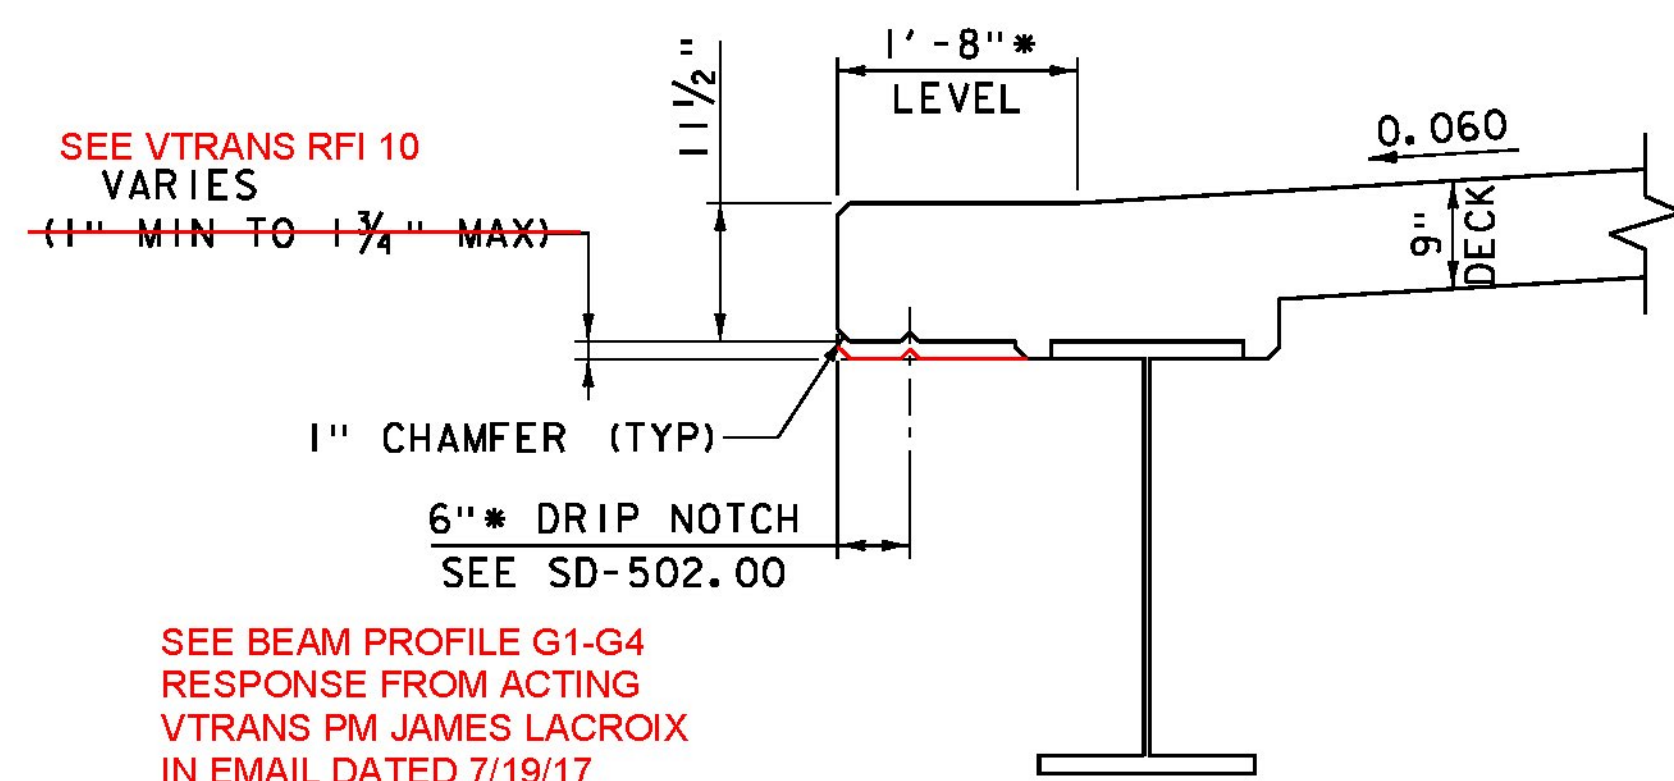

* - DIMENSIONS ARE RADIAL

GIRDER 1 FASCIA & DRIP NOTCH DETAIL

SCALE 3/4" = 1'-0"

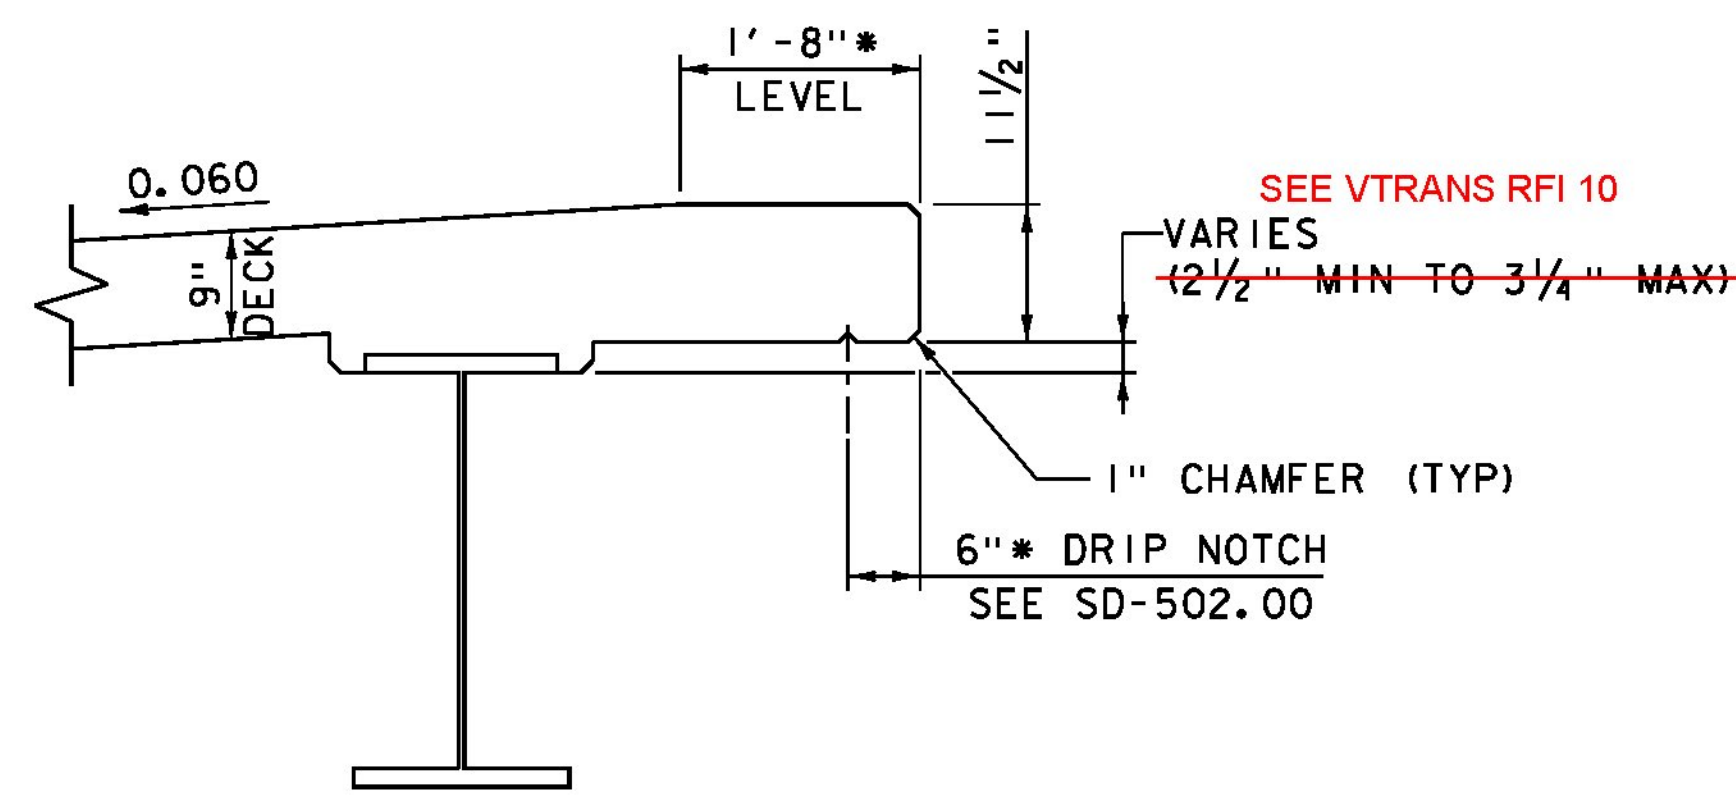

* - DIMENSIONS ARE RADIAL

GIRDER 4 FASCIA & DRIP NOTCH DETAIL

SCALE 3/4" = 1'-0"

PROJECT NAME: HUNTINGTON
PROJECT NUMBER: BF 0211(32)

FILE NAME: z13J080+typ.dgn
PROJECT LEADER: S.E. BURBANK
DESIGNED BY: E.F. LAWES
TYPICAL BRIDGE SECTION

PLOT DATE: 8/15/2016
DRAWN BY: J.D. KEENER
CHECKED BY: S.E. BURBANK
SHEET 3 OF 62

