


ABUTMENT NO 1 PLAN  
SCALE 1/2" = 1'-0"

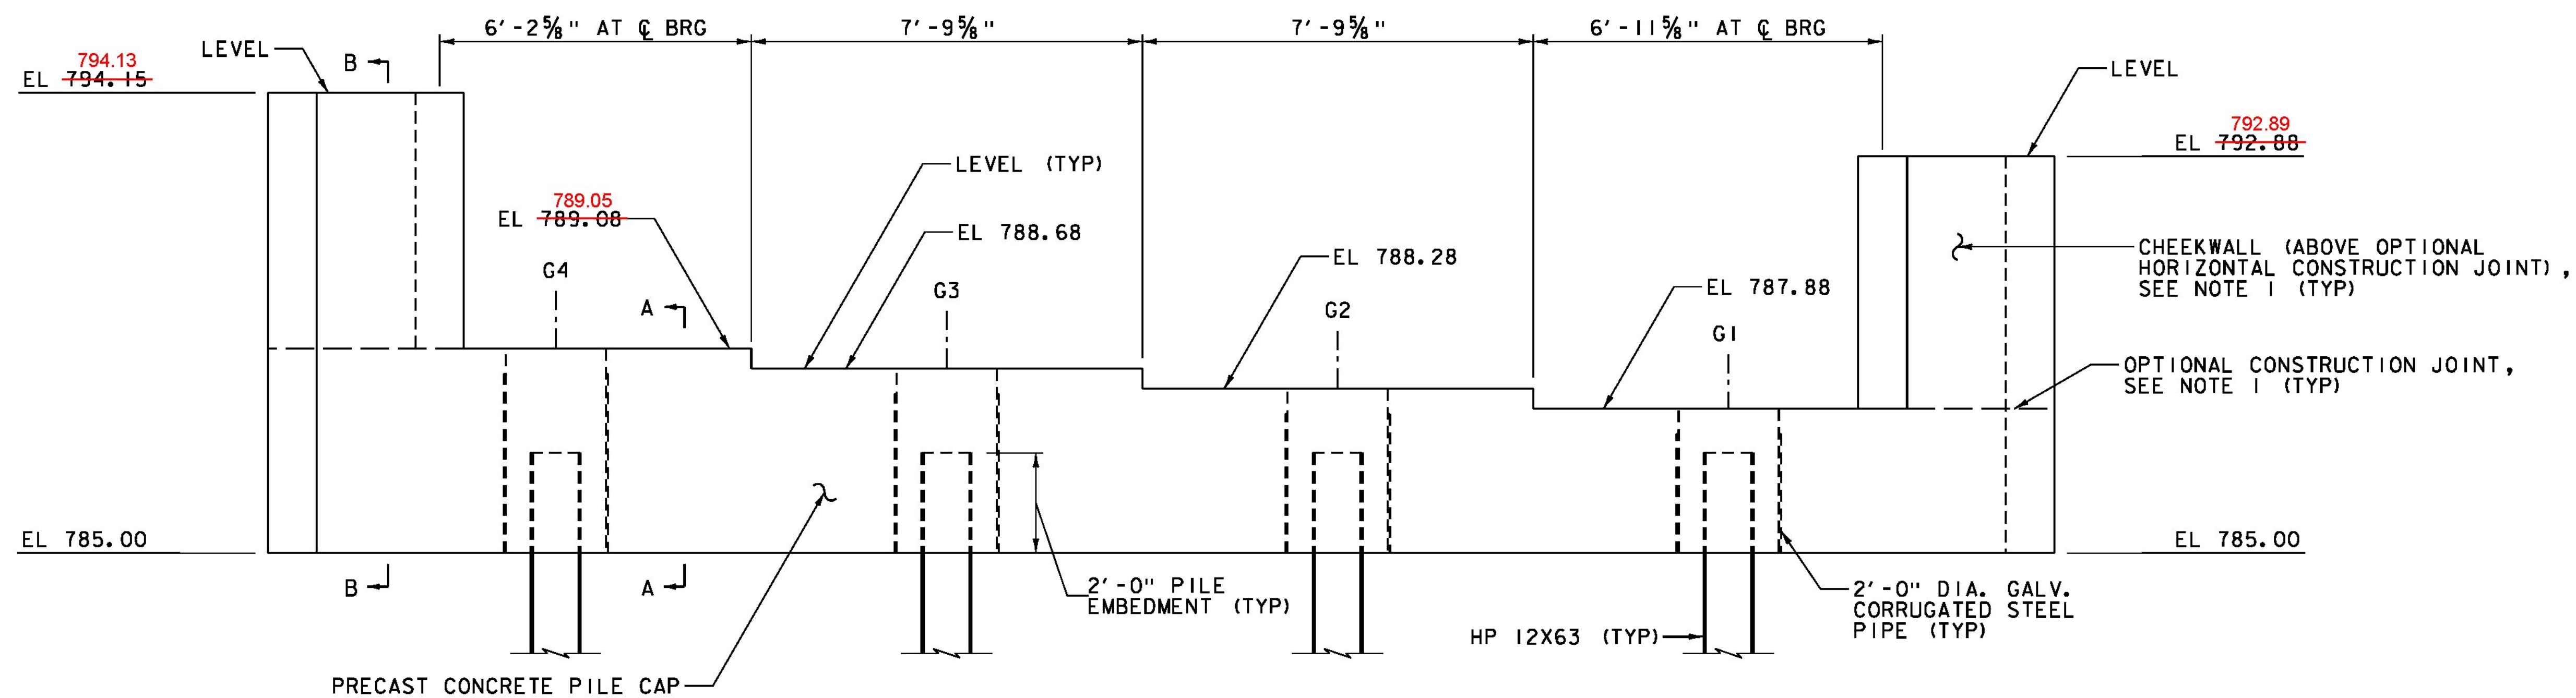

ABUTMENT NO 1 ELEVATION  
SCALE 1/2" = 1'-0"

- NOTES:**
1. THE CONTRACTOR HAS THE OPTION FOR PRECAST OR CAST-IN-PLACE CONCRETE CHEEKWALLS ABOVE THE HORIZONTAL CONSTRUCTION JOINT (IF USED). PAYMENT WILL BE INCLUDED UNDER THE APPROPRIATE PRECAST CONCRETE ITEM. SEE PROJECT NOTES FOR DETAILS.
  2. SEE ABUTMENT NO 1 SECTIONS SHEET FOR SECTIONS A-A AND B-B.

PROJECT NAME:	HUNTINGTON	FILE NAME:	z13j080subl.dgn	PLOT DATE:	8/15/2016
PROJECT NUMBER:	BF 0211(32)	PROJECT LEADER:	S.E. BURBANK	DRAWN BY:	J.D. KEENER
		DESIGNED BY:	R.H. BARNES	CHECKED BY:	R.H. BARNES
		ABUTMENT NO 1 PLAN & ELEVATION		SHEET	36 OF 62

