



10+00

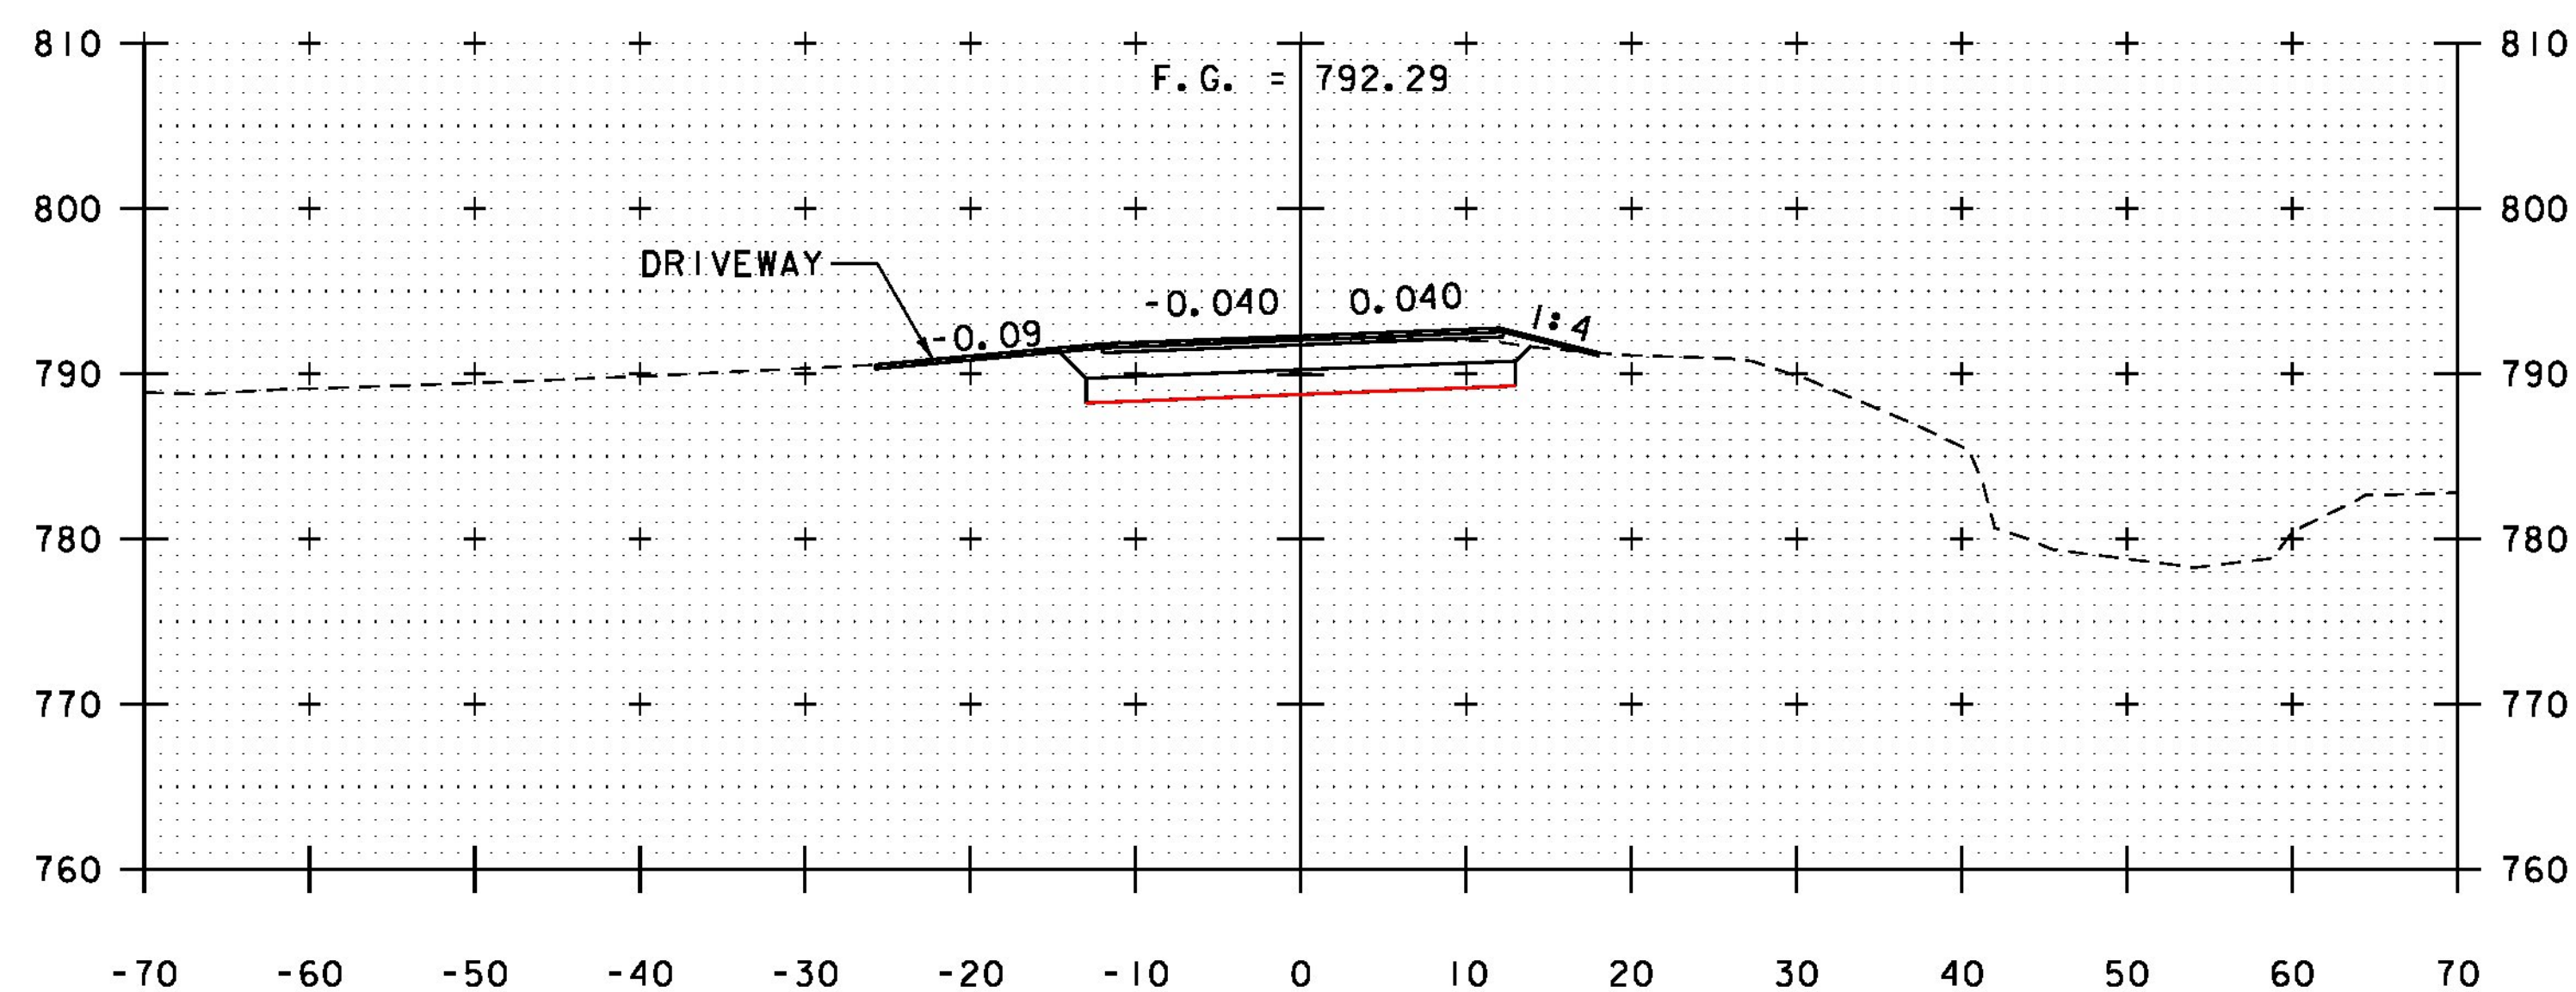

10+50

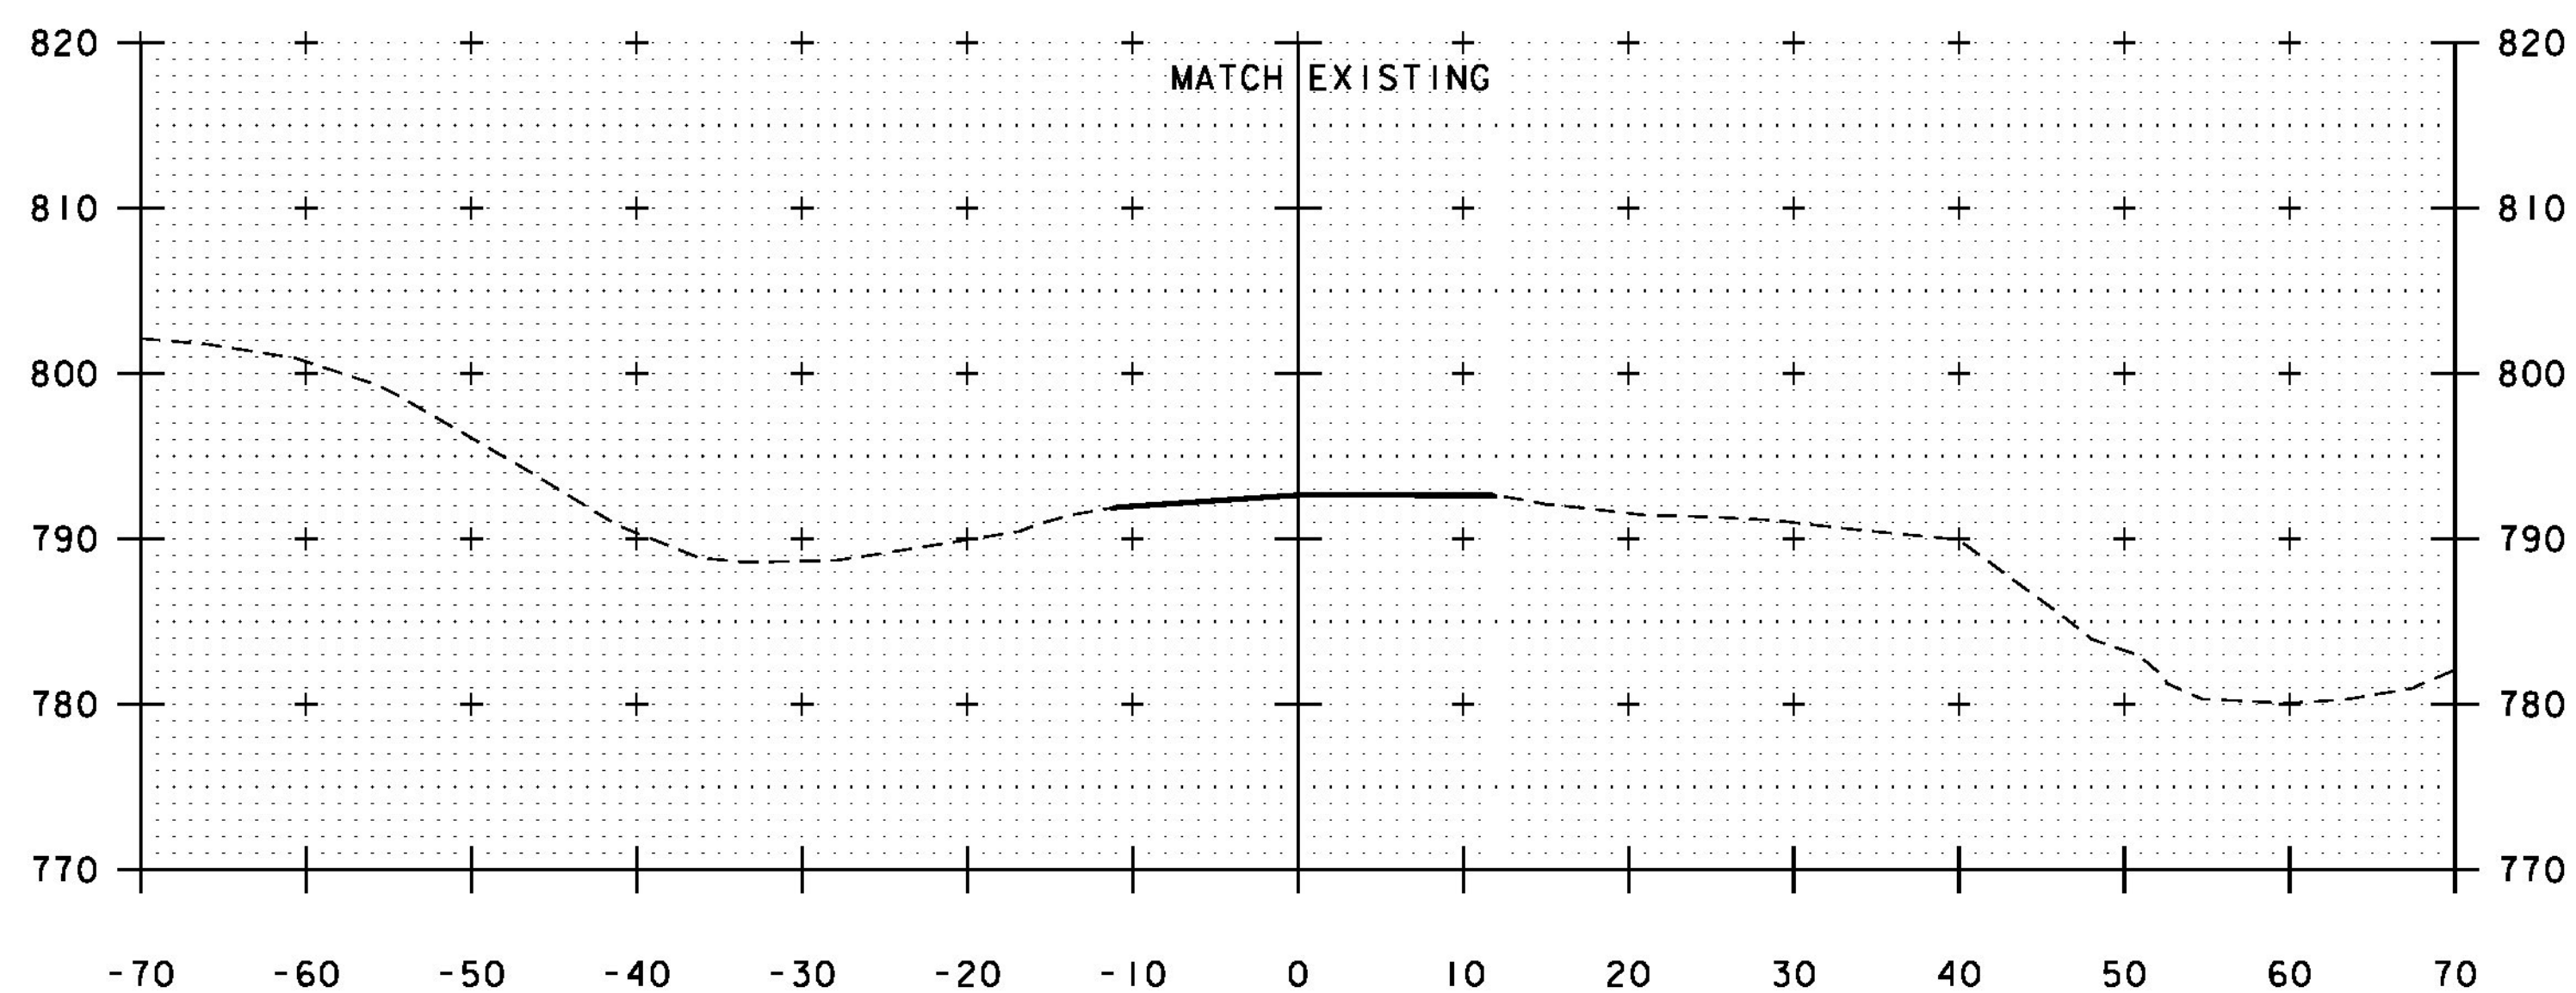

9+75

BEGIN APPROACH
STA. 9+75.00


FINAL X-SECTIONS FILE (DATA)
SAVED ON Z DRIVE

ROADWAY CROSS SECTIONS

SCALE 1" = 10'-0"

STA. 9+75 - 10+50

BOTTOM OF EXCAVATION
FIELD CHECKED BY QA STAFF
NO EXCEPTIONS TO DESIGN
GRADES. TYPICAL PER
CROSS SECTION SHEETS

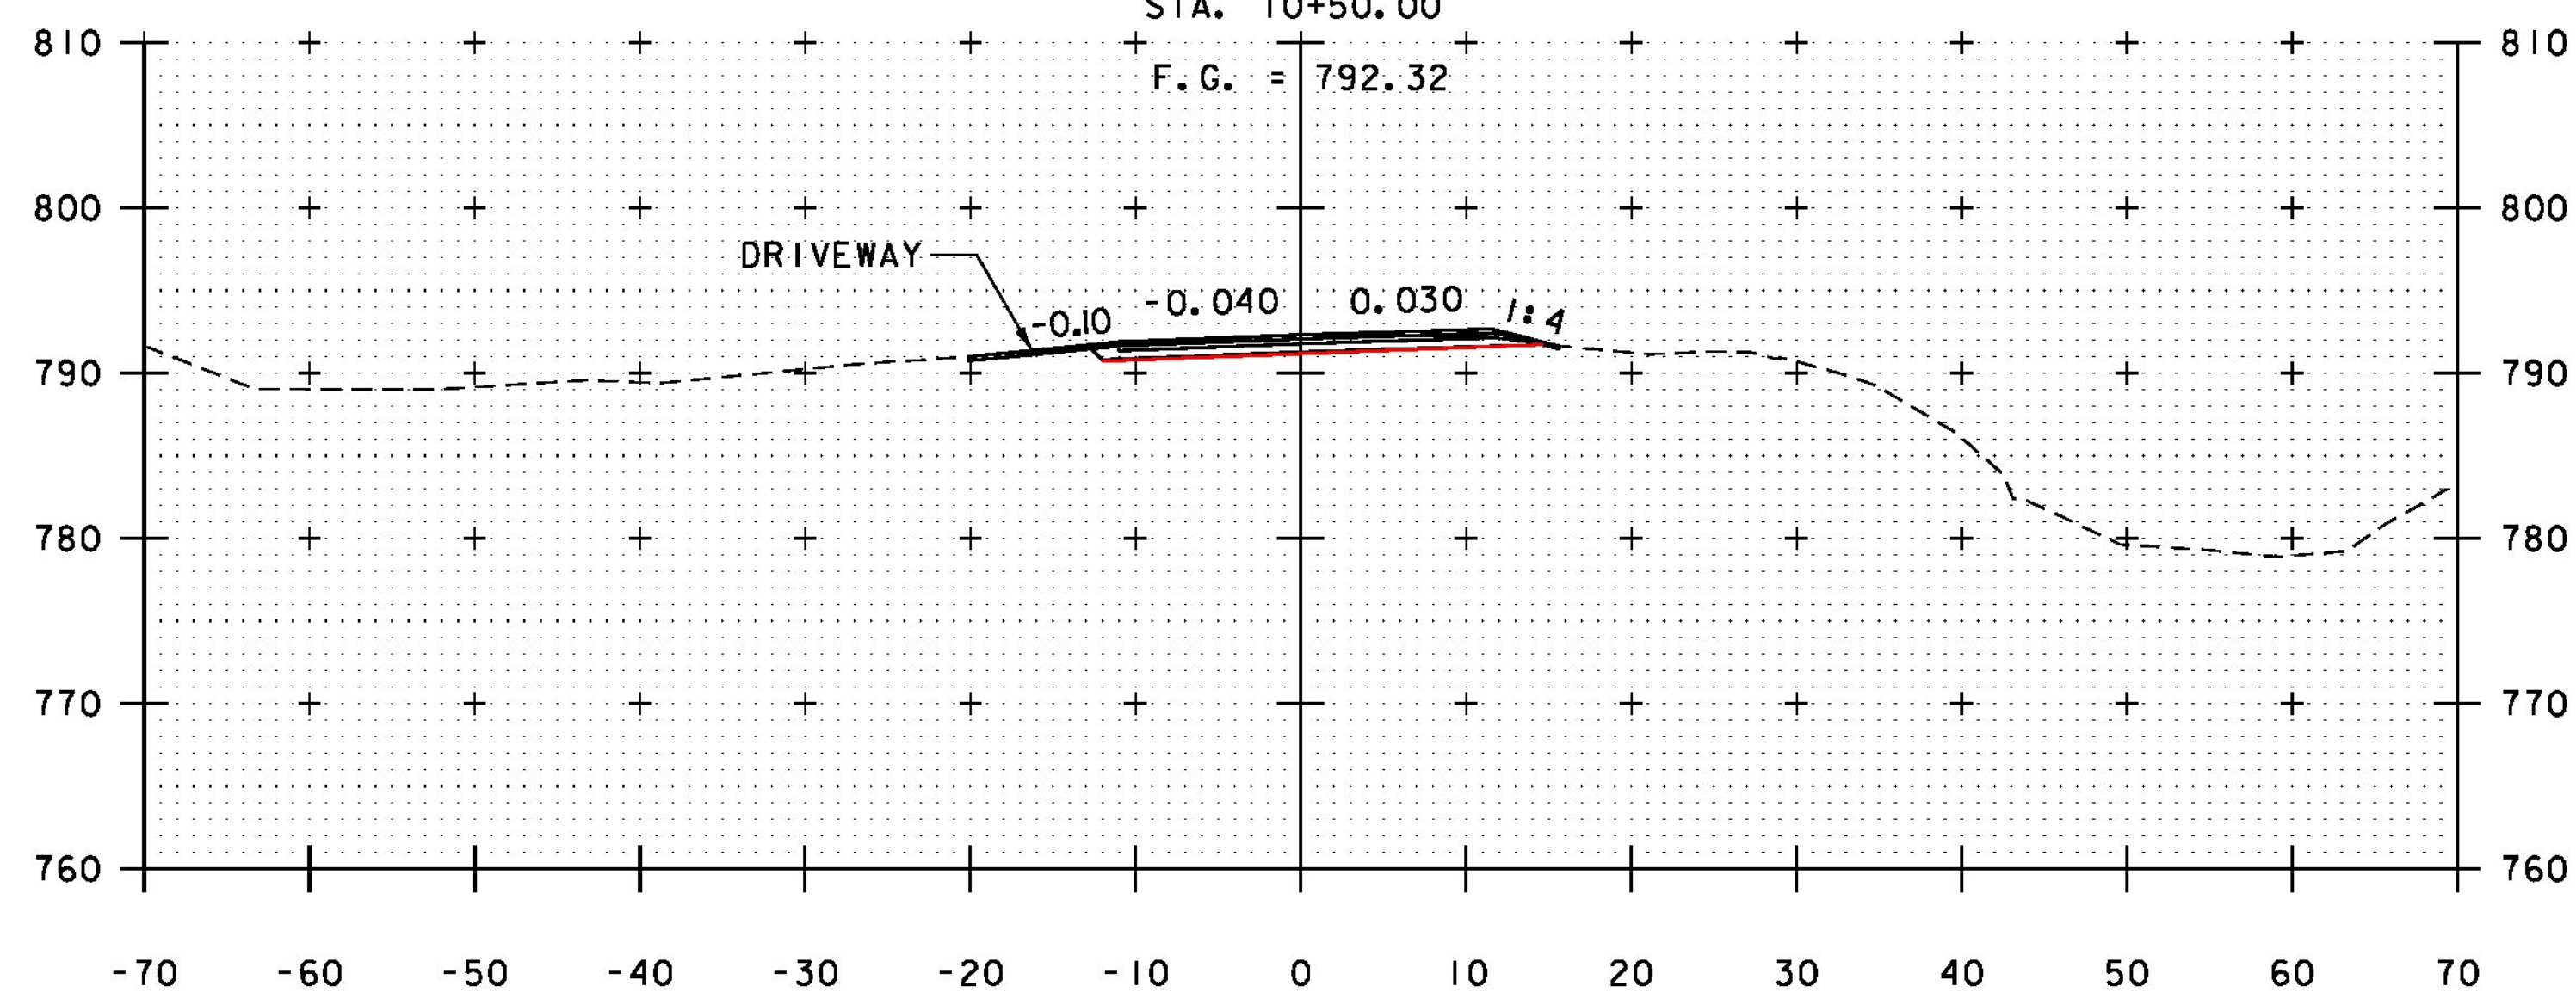

10+25



PROJECT NAME: HUNTINGTON
PROJECT NUMBER: BF 0211(32)

FILE NAME: z13j080xsl.dgn
PROJECT LEADER: S.E. BURBANK
DESIGNED BY: K.C. BARRY
ROADWAY CROSS SECTIONS (1 OF 6)

PLOT DATE: 8/15/2016
DRAWN BY: K.C. BARRY
CHECKED BY: E.F. LAWES
SHEET 47 OF 62