




11+00

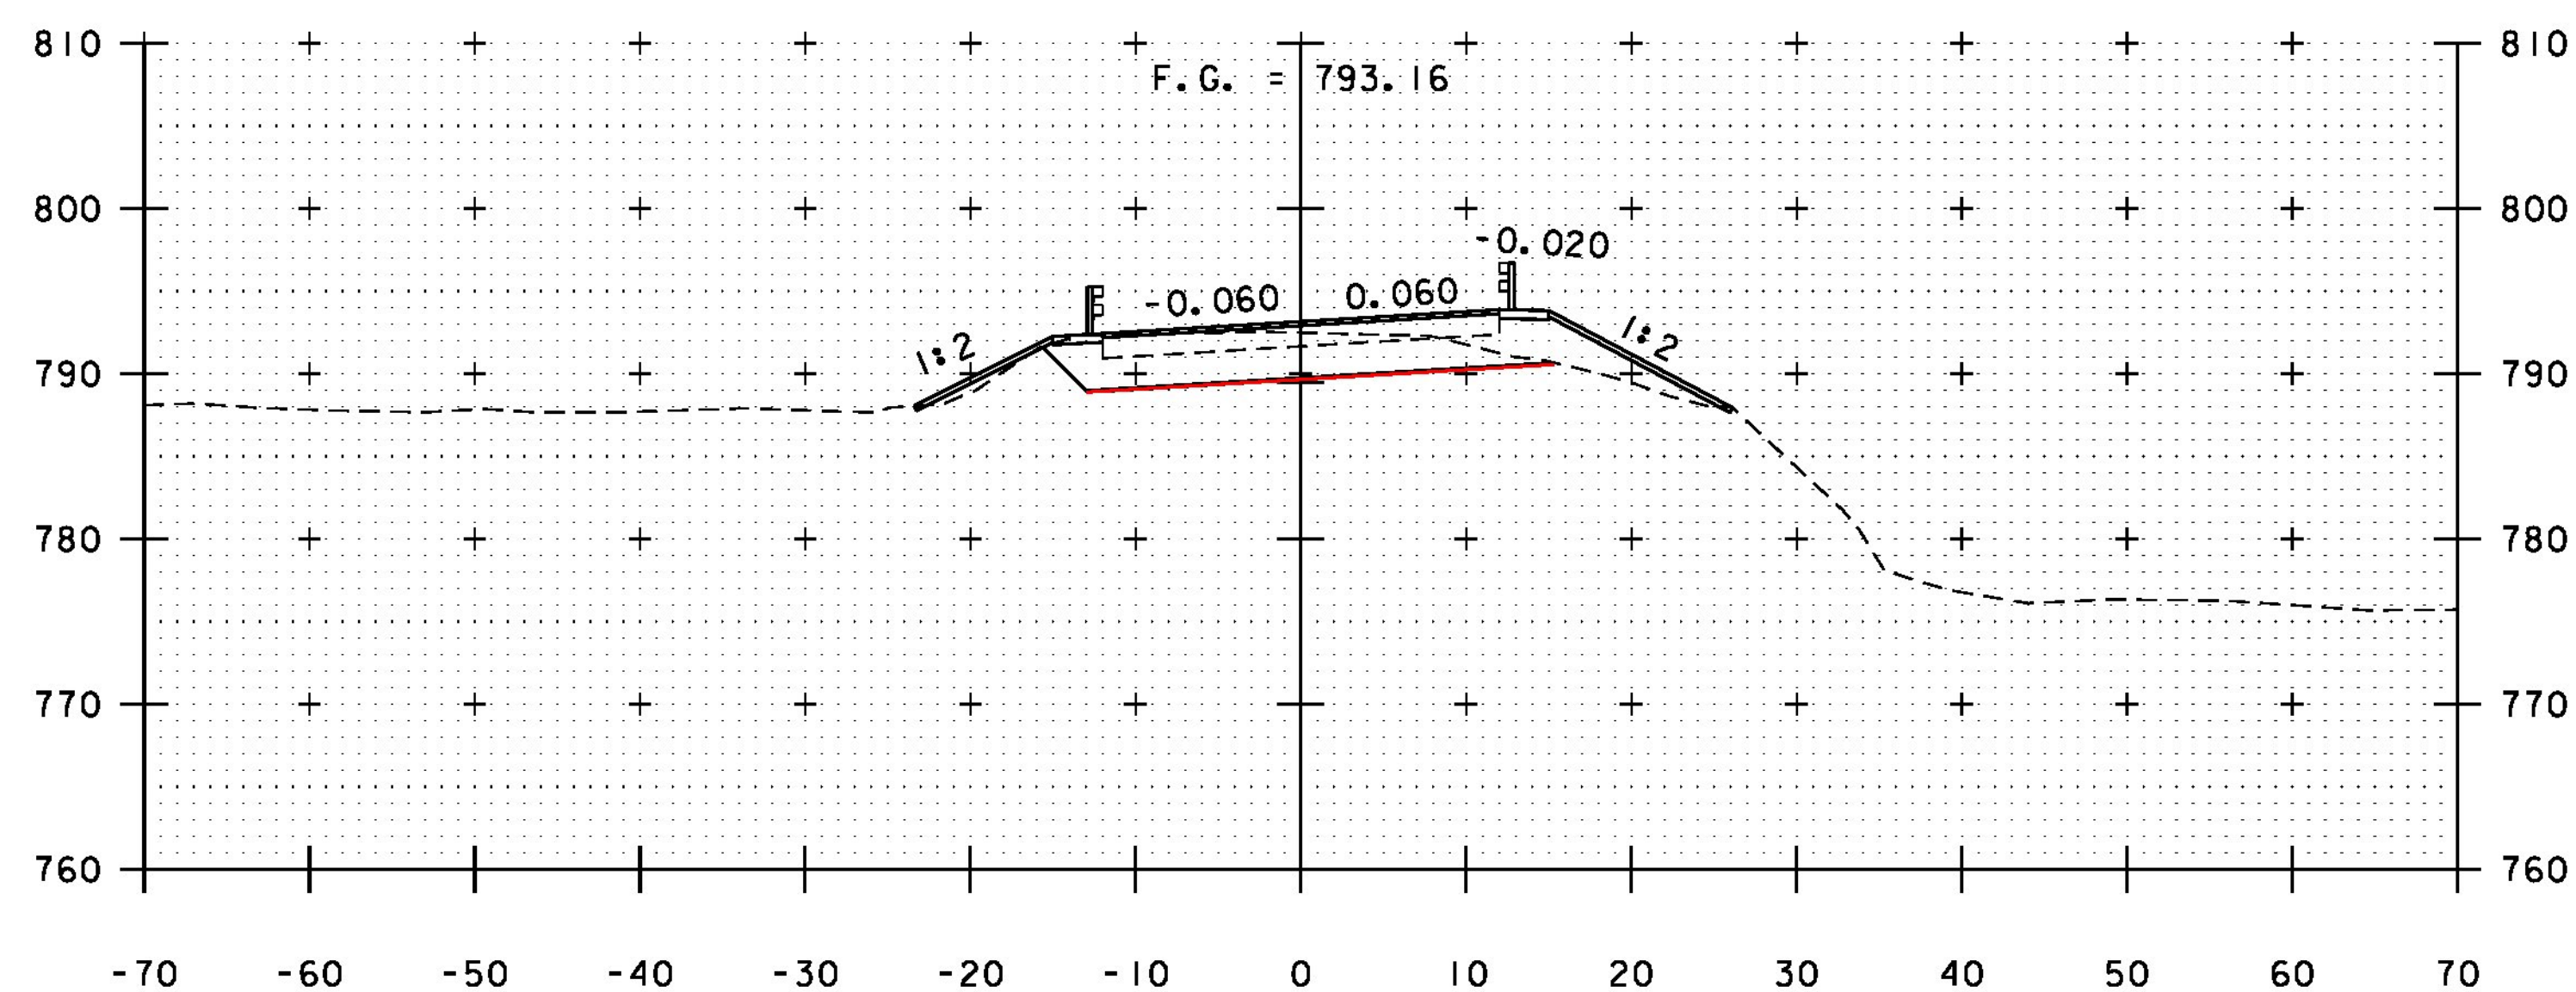

11+50

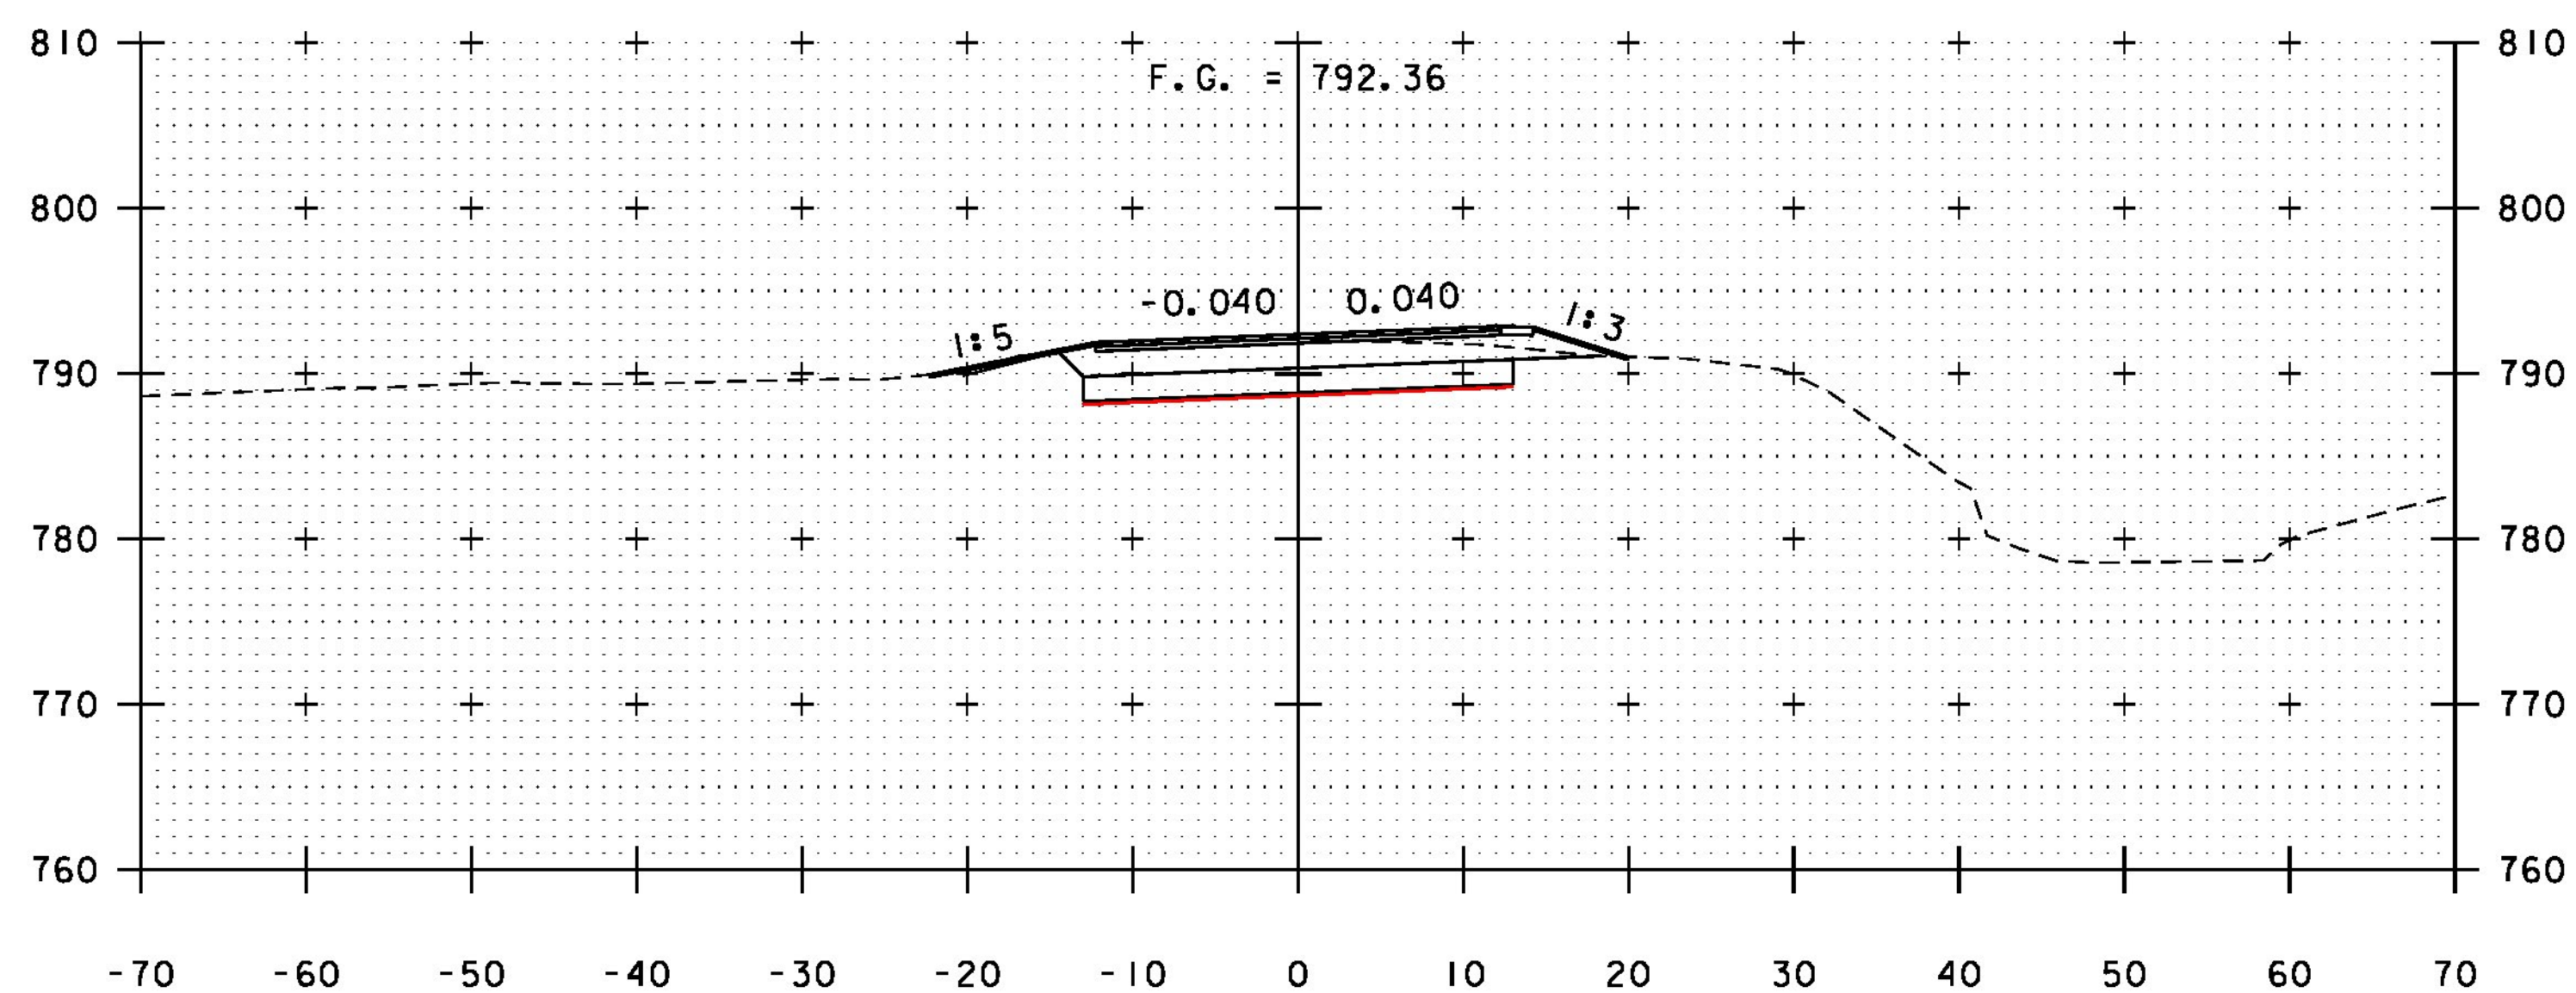

10+75

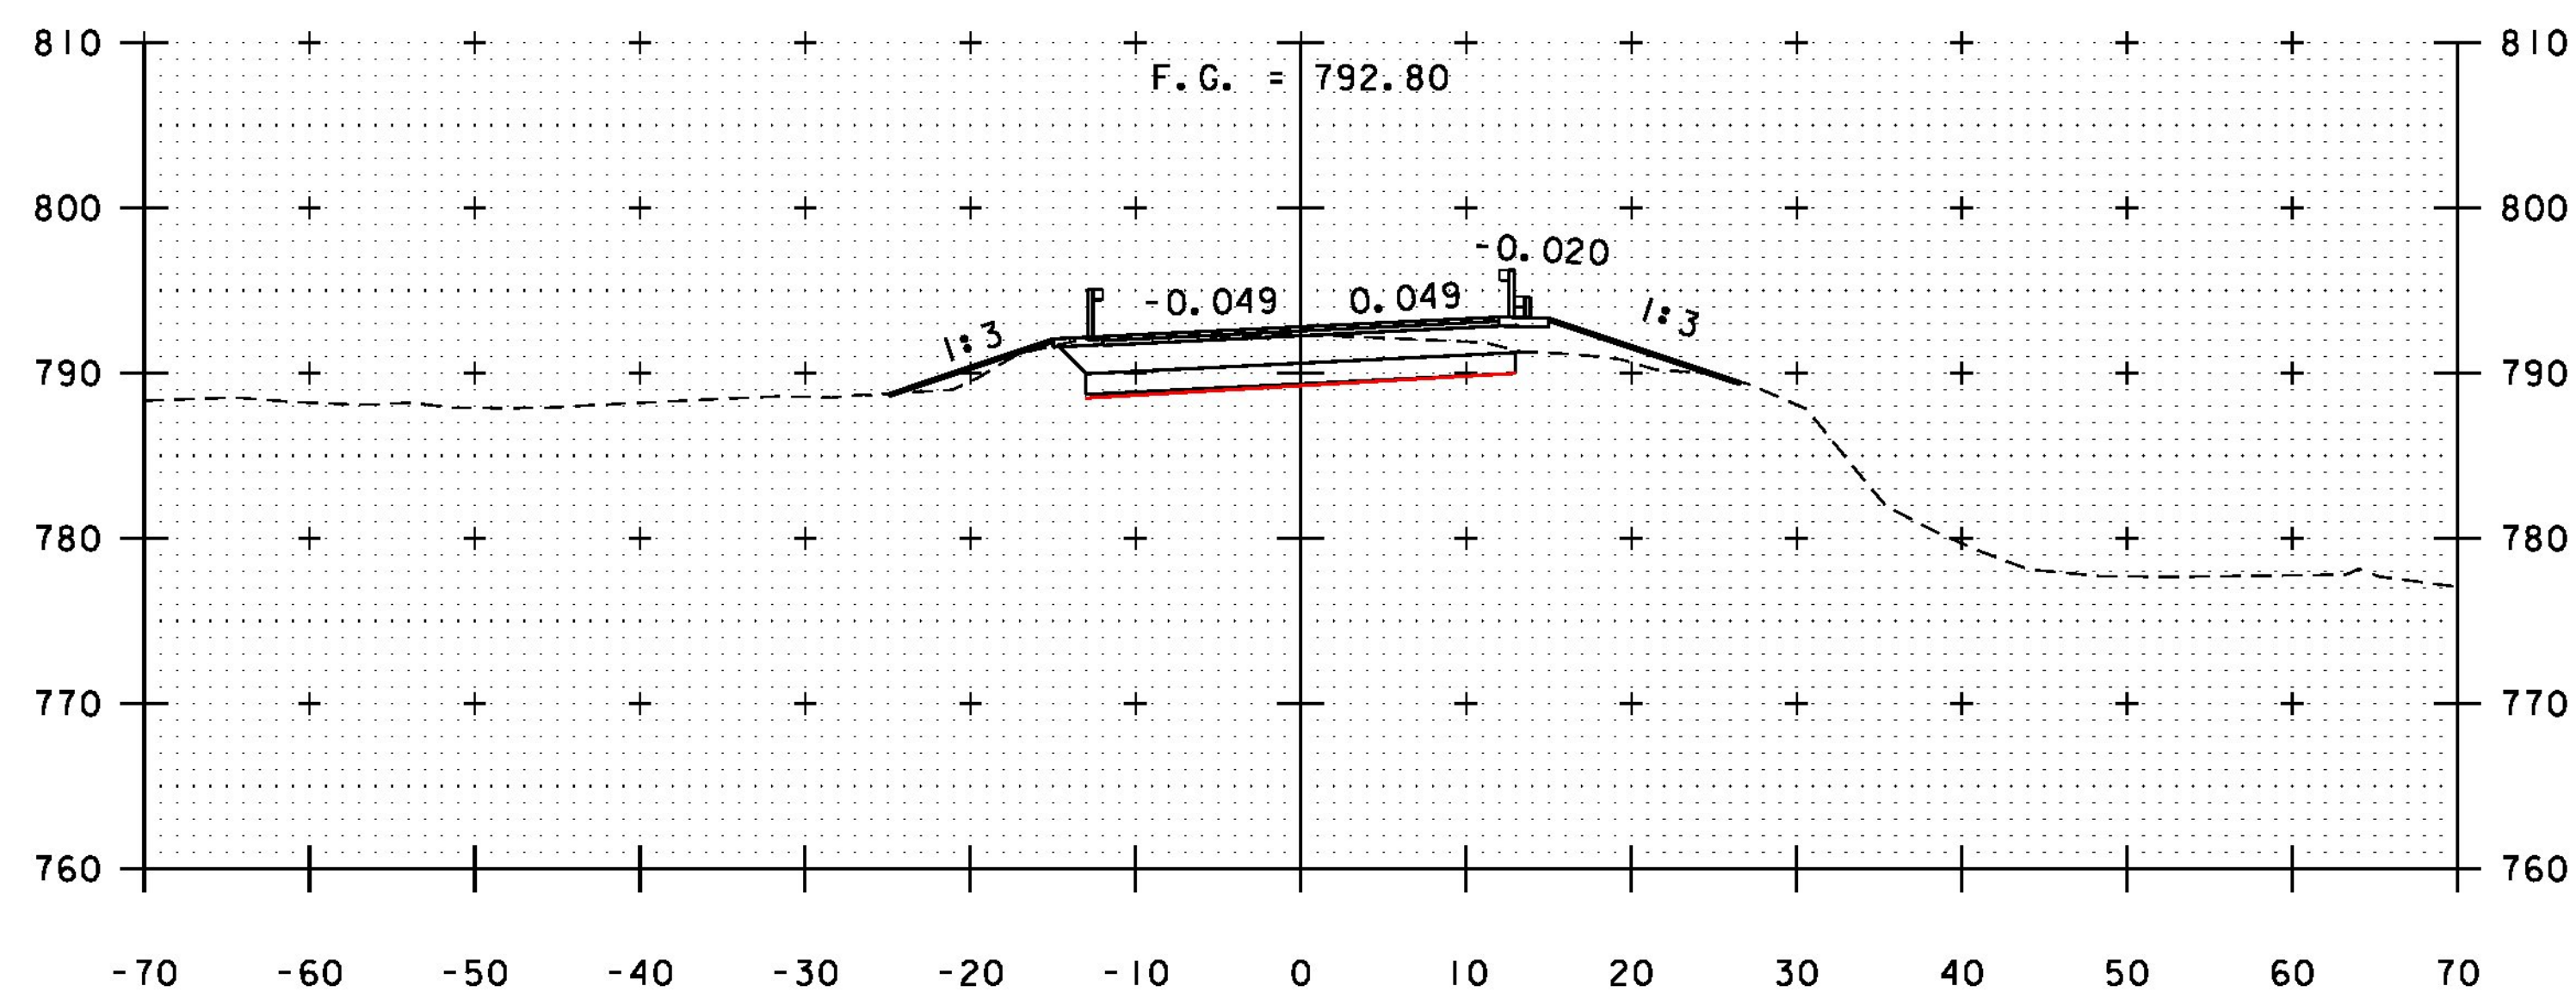

11+25

ROADWAY CROSS SECTIONS

SCALE 1" = 10'-0"

STA. 10+75 - 11+50



PROJECT NAME: HUNTINGTON
PROJECT NUMBER: BF 0211(32)

FILE NAME: z13J080xsl.dgn
PROJECT LEADER: S.E. BURBANK
DESIGNED BY: K.C. BARRY
ROADWAY CROSS SECTIONS (2 OF 6)

PLOT DATE: 8/15/2016
DRAWN BY: K.C. BARRY
CHECKED BY: E.F. LAWES
SHEET 48 OF 62