




50+80

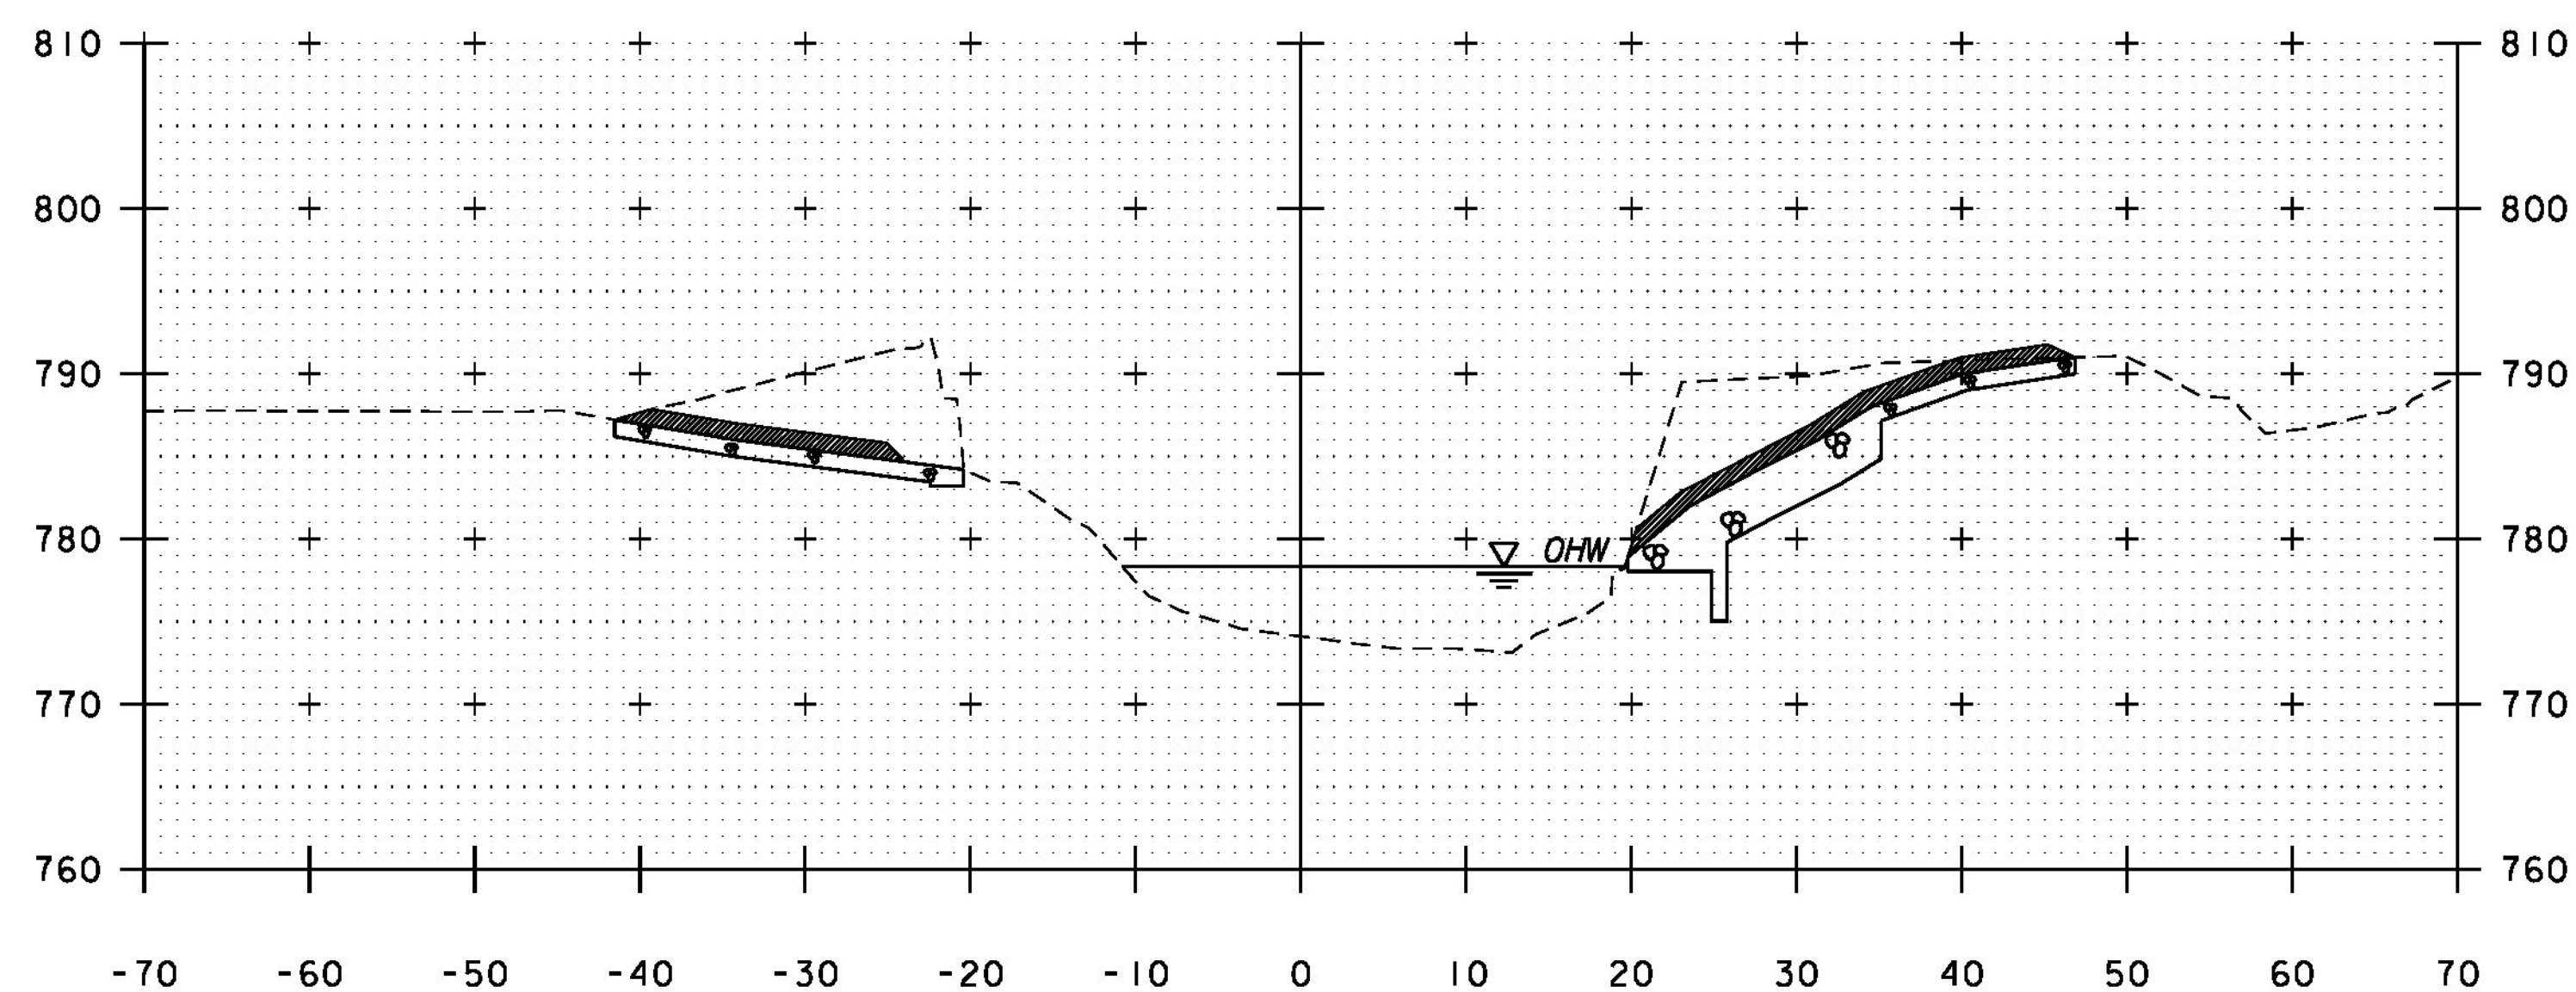

51+00

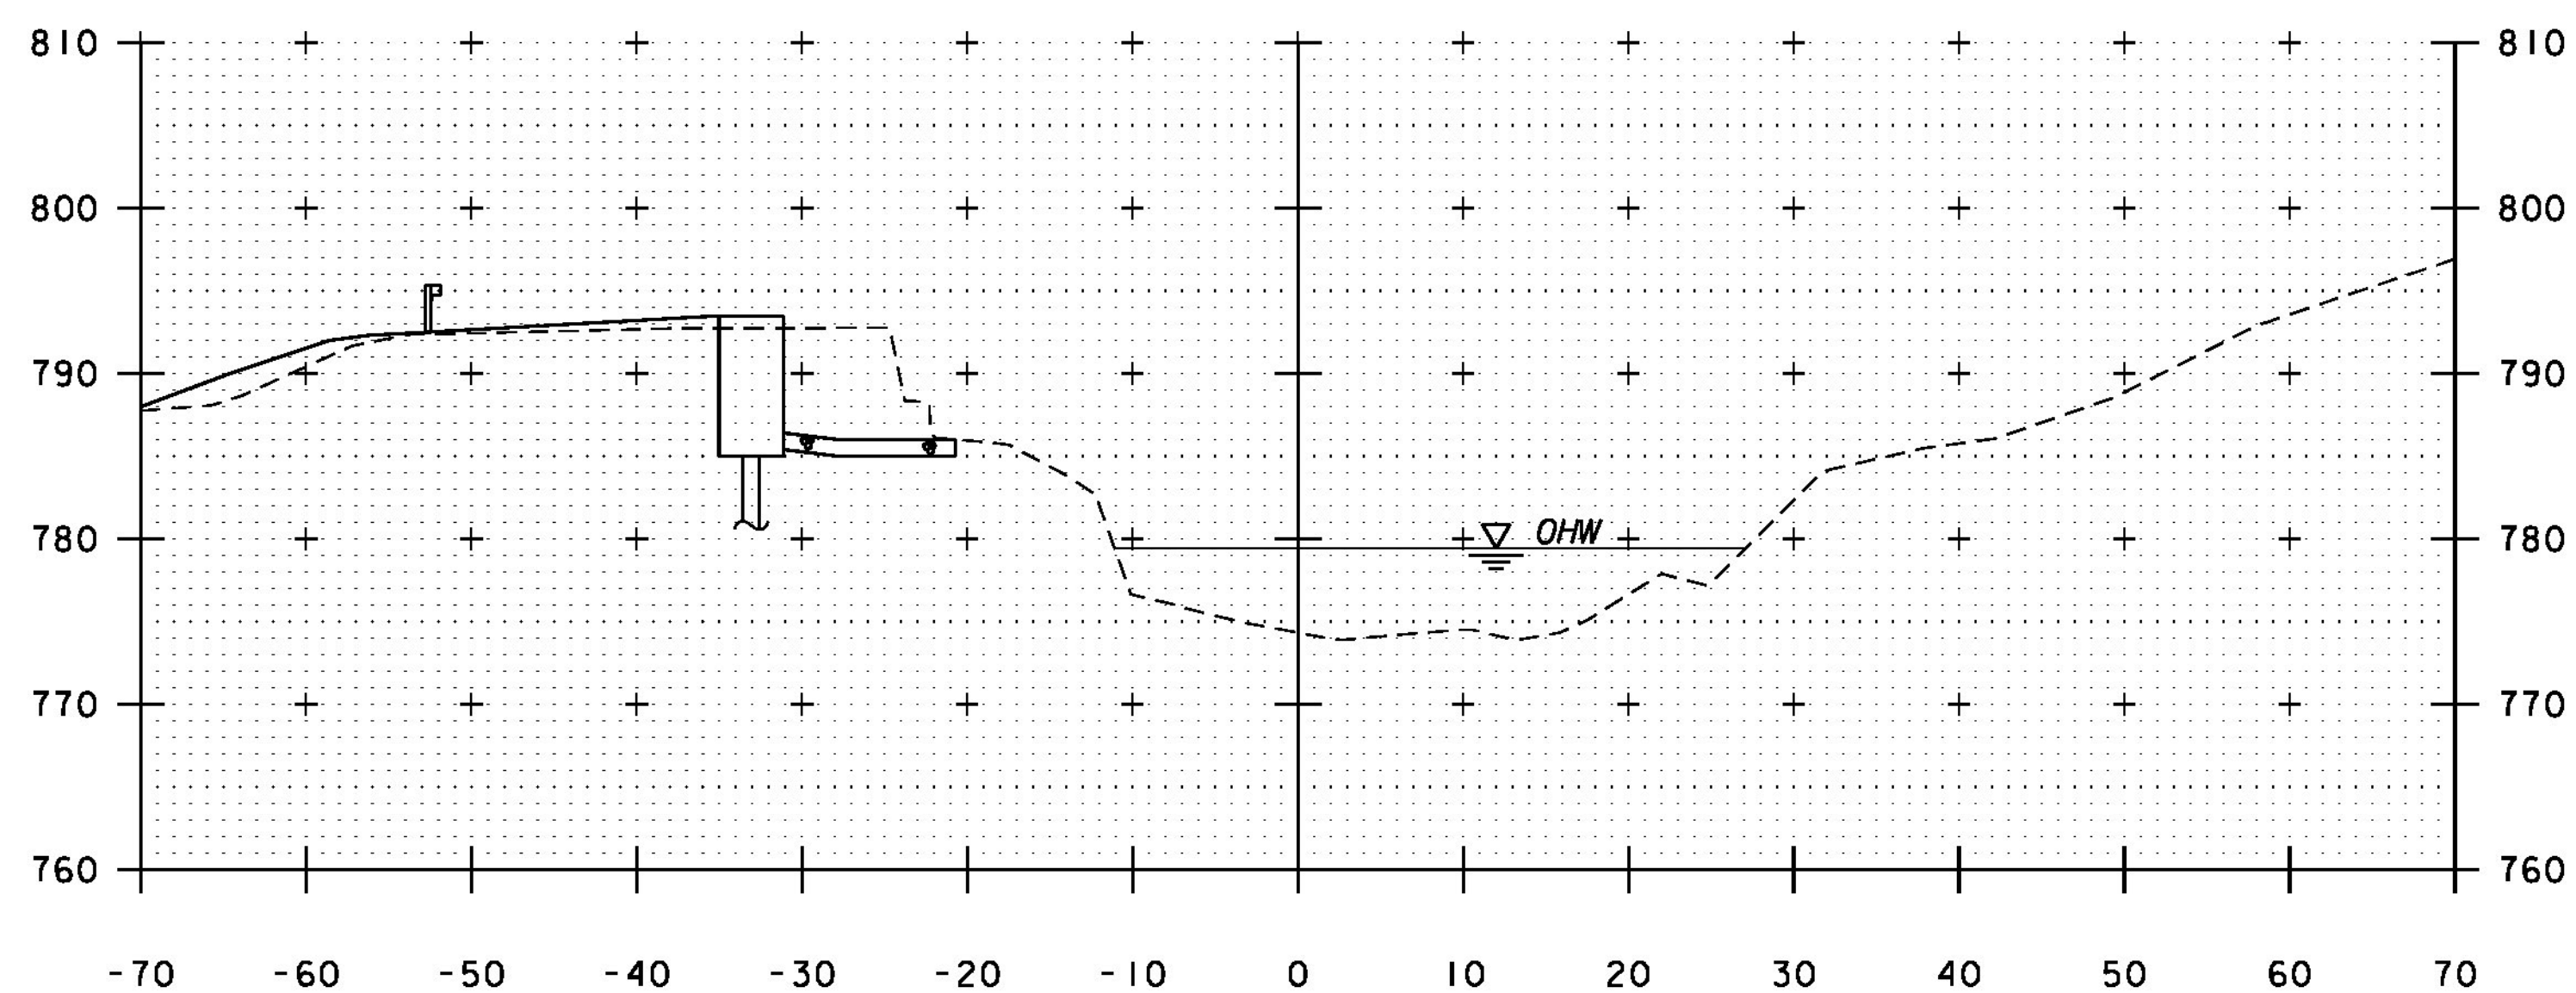

50+70

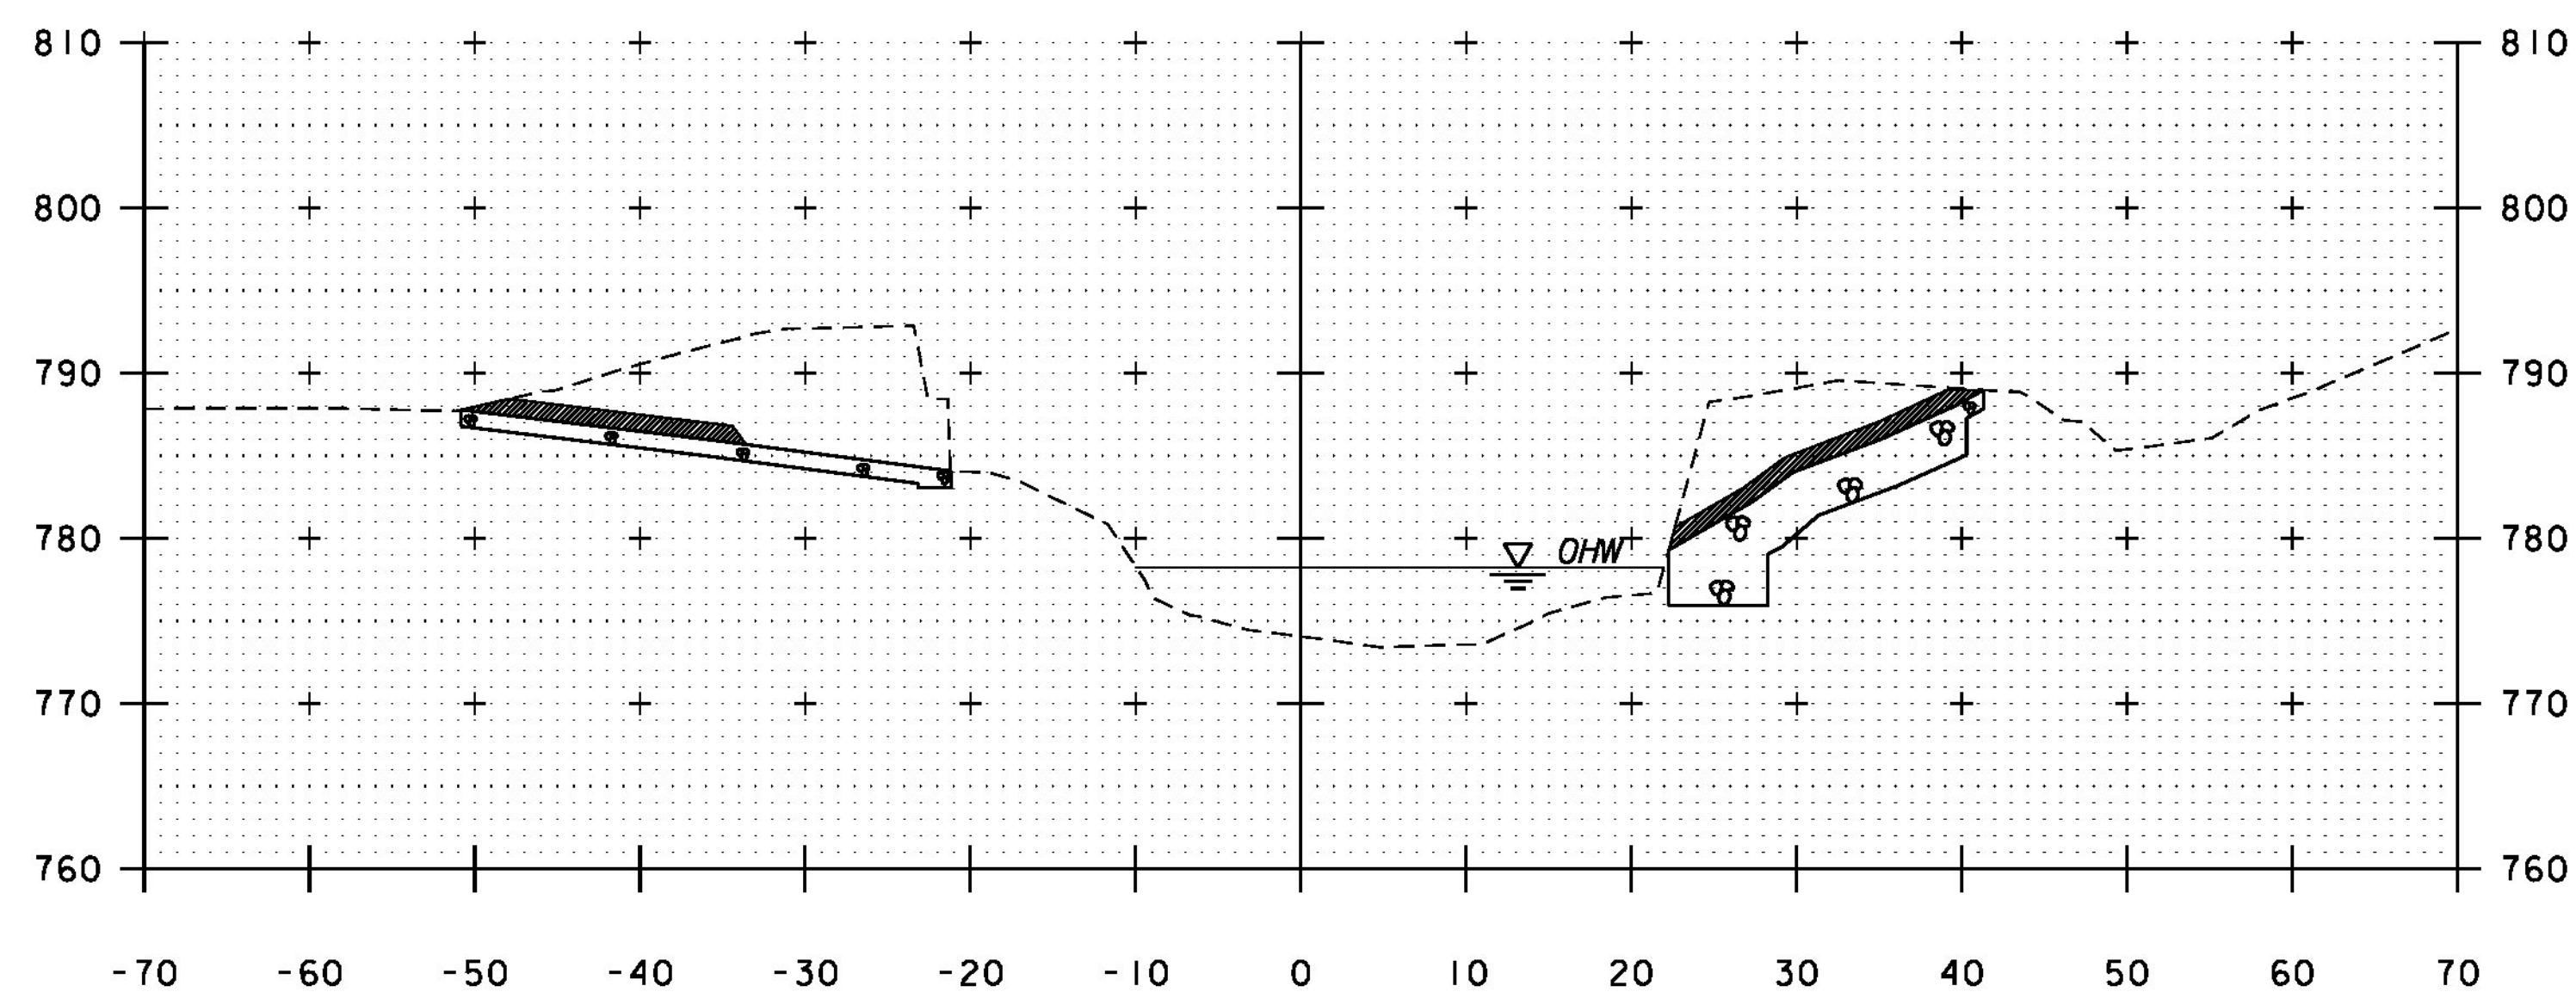

50+90

STA. 50+65, LT
END GRUBBING MATERIAL

STA. 50+85, LT
BEGIN GRUBBING MATERIAL

STA. 50+83, RT
BEGIN UNCLASSIFIED CHANNEL EXCAVATION
GEOTEXTILE UNDER STONE FILL
STONE FILL, TYPE III, & GRUBBING MATERIAL

CHANNEL CROSS SECTIONS

SCALE 1" = 10'-0"

STA. 50+70 - 51+00



PROJECT NAME:	HUNTINGTON	PLOT DATE:	8/15/2016
PROJECT NUMBER:	BR 0211(32)	DRAWN BY:	K.C. BARRY
FILE NAME:	z13J080xsl.dgn	CHECKED BY:	E.F. LAWES
PROJECT LEADER:	S.E. BURBANK	SHEET	54 OF 62
DESIGNED BY:	K.C. BARRY		
CHANNEL CROSS SECTIONS (2 OF 4)			