




51+20

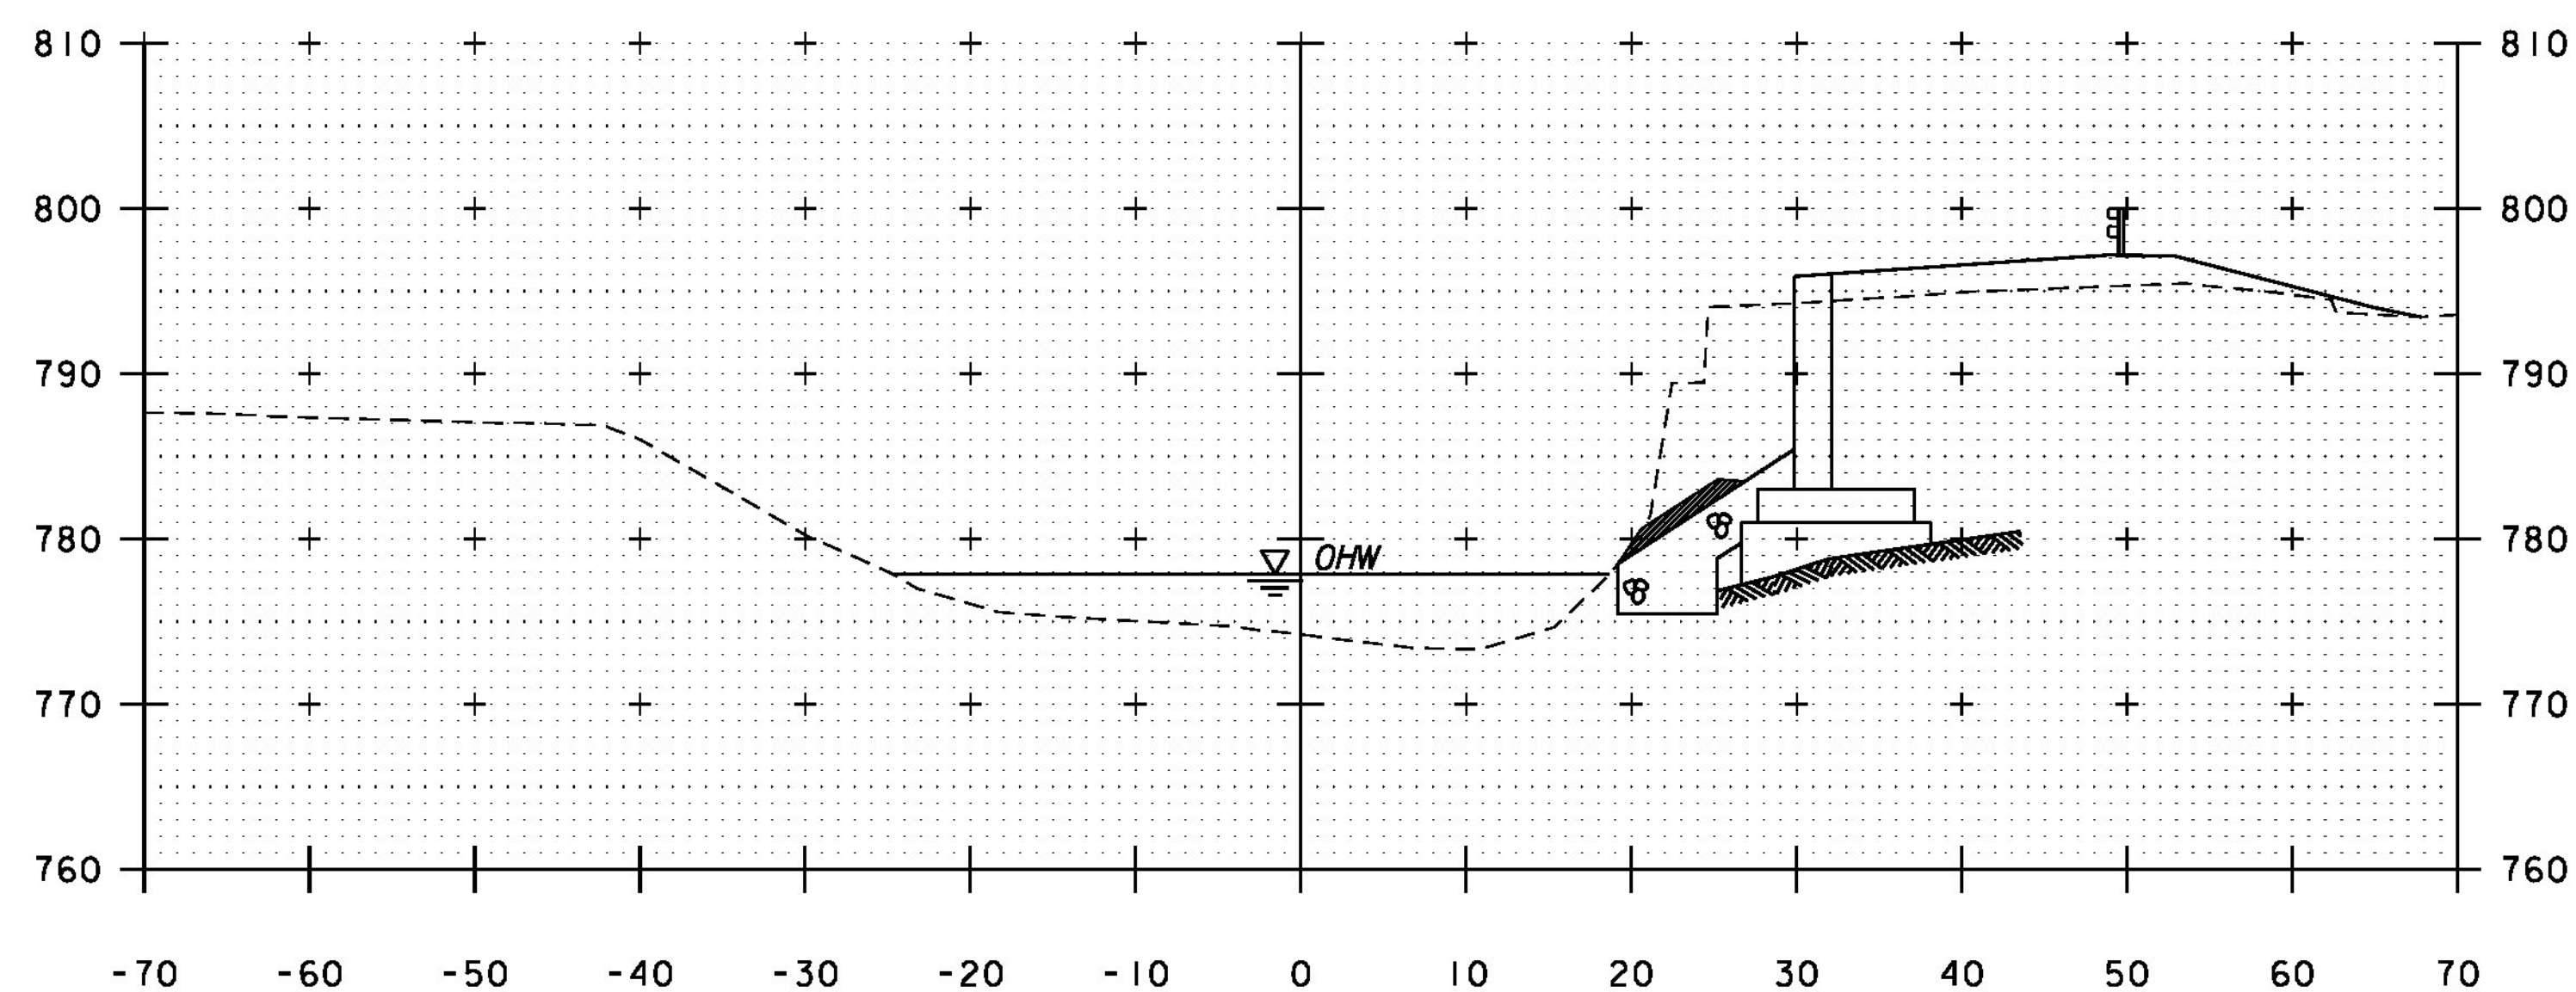

51+40

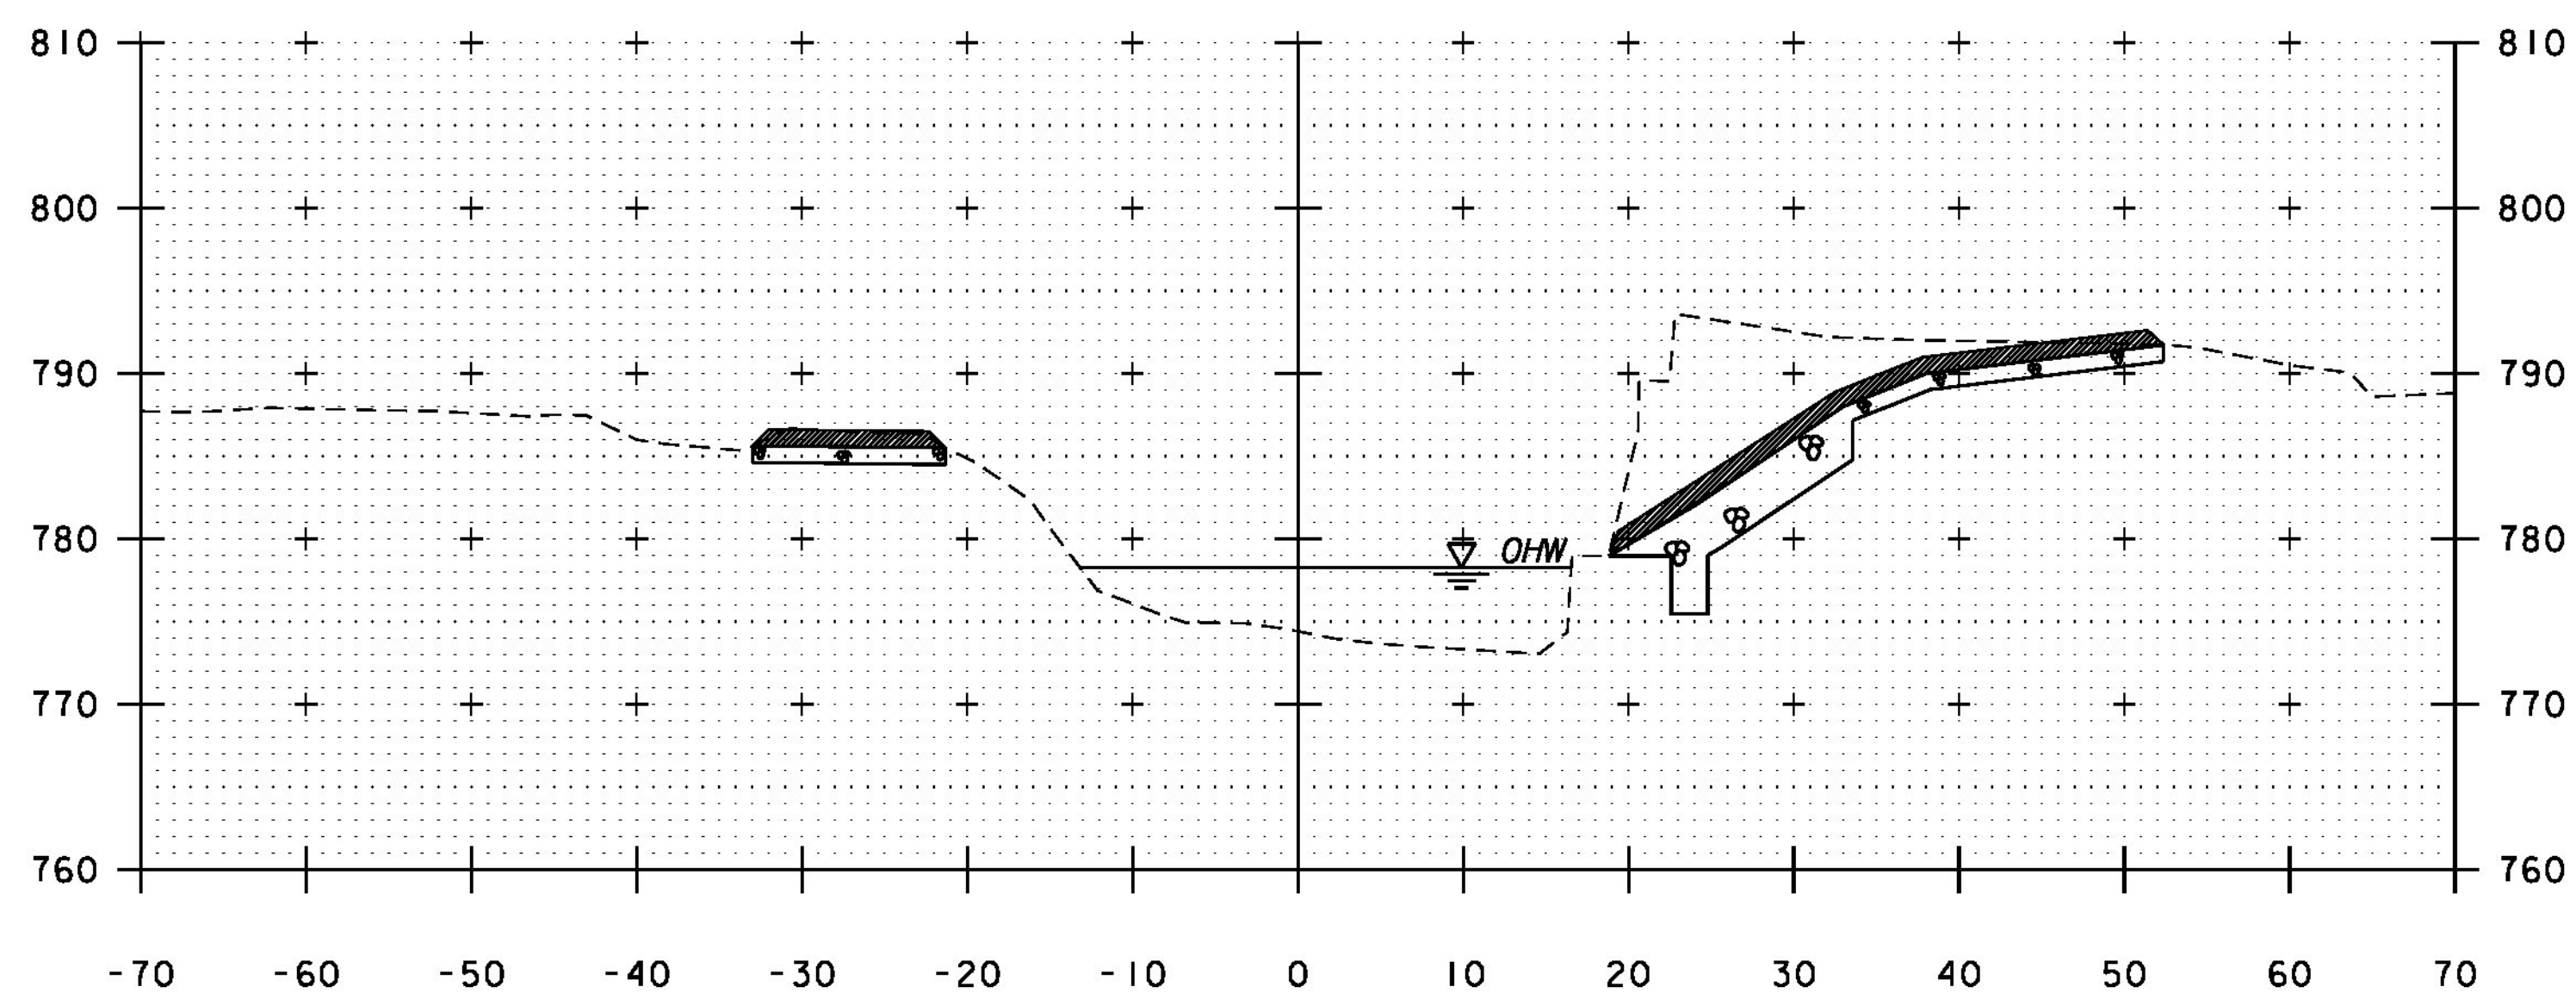

51+10

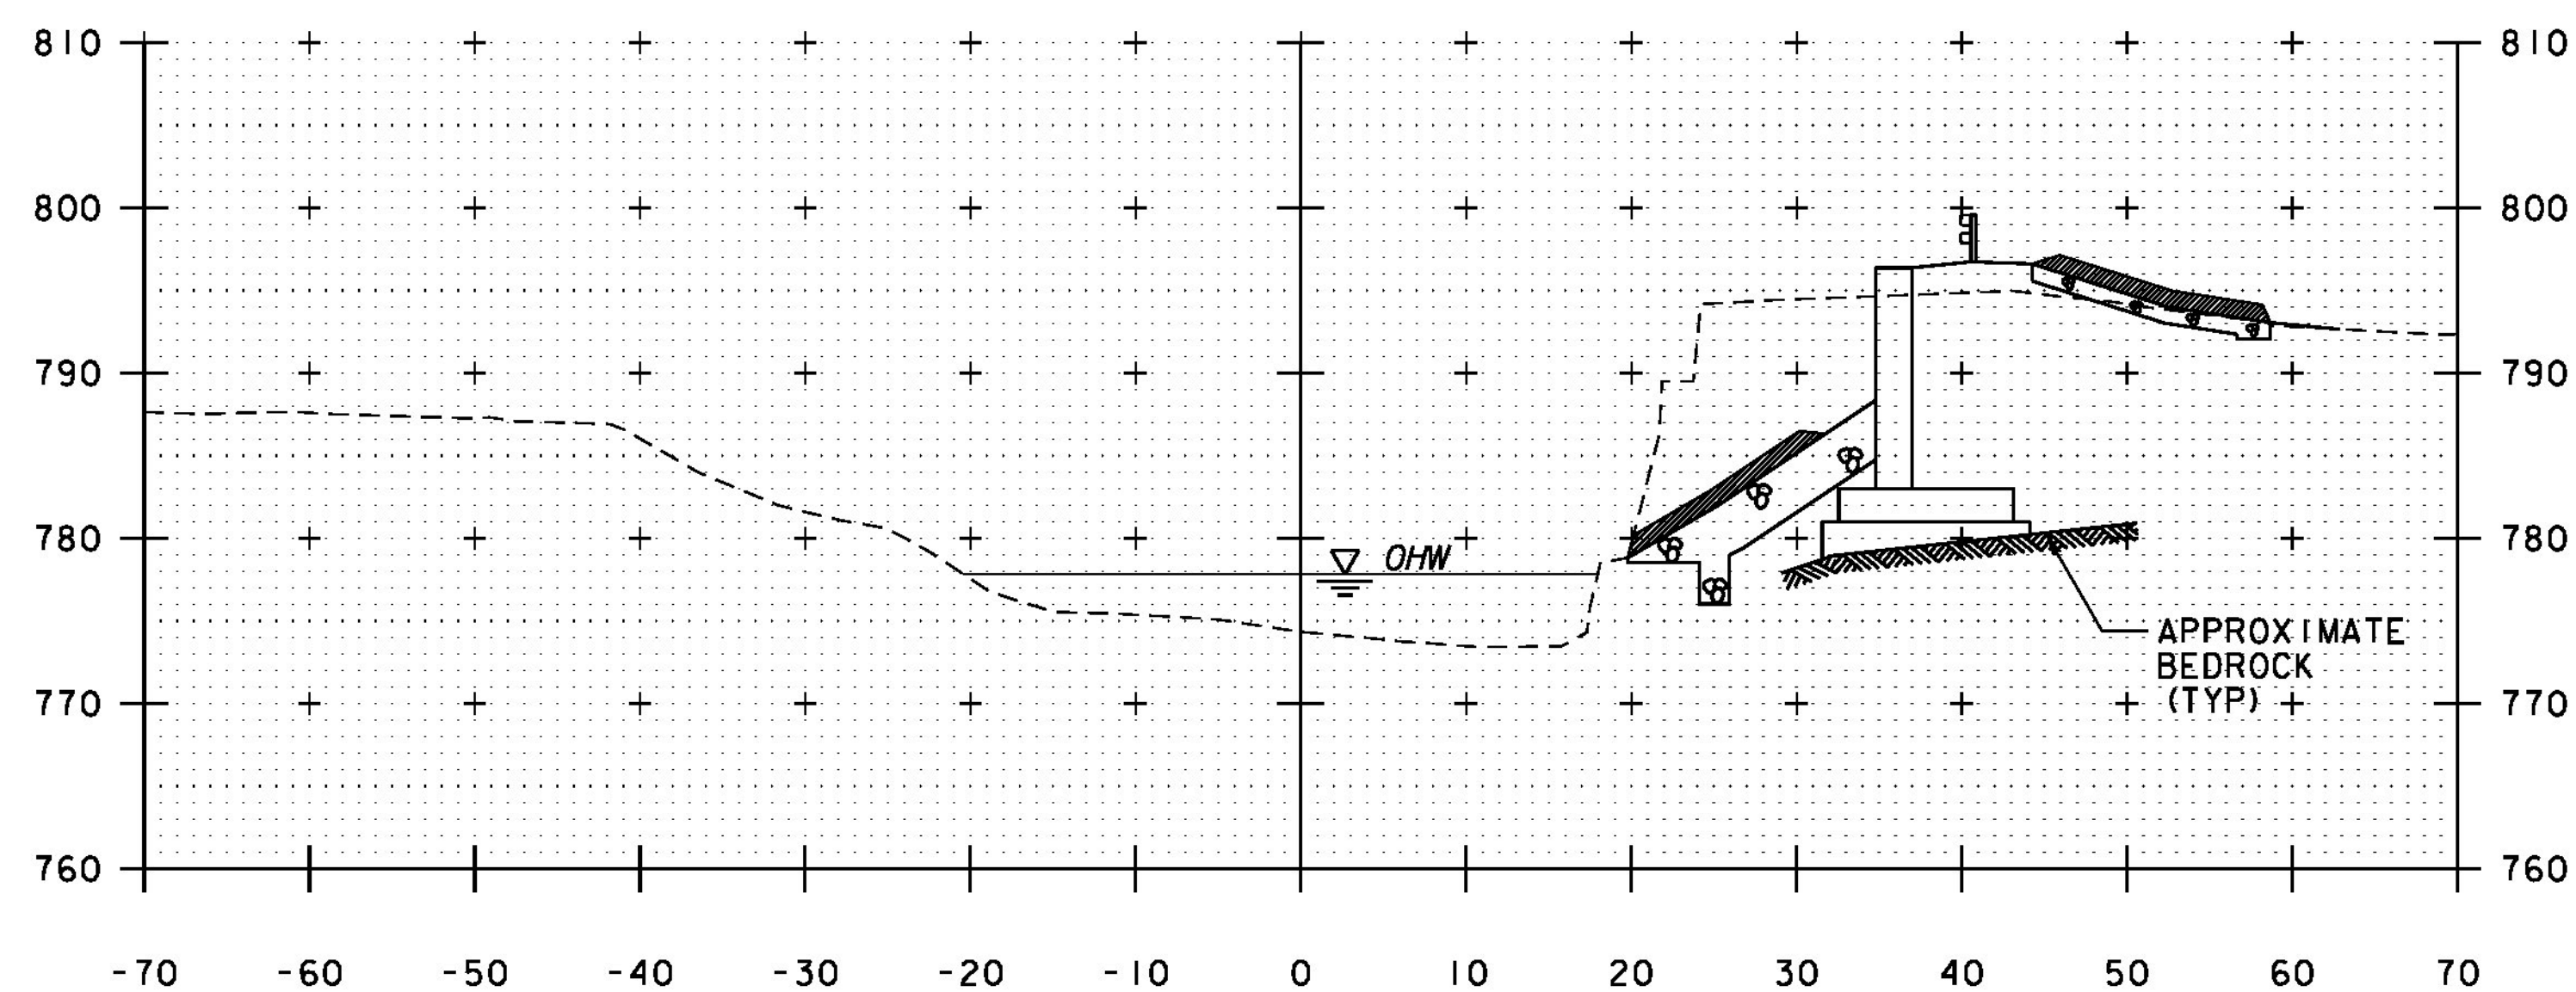

51+30

STA. 51+15, LT  
 END UNCLASSIFIED CHANNEL EXCAVATION  
 GEOTEXTILE UNDER STONE FILL  
 STONE FILL, TYPE I, & GRUBBING MATERIAL

CHANNEL CROSS SECTIONS  
 SCALE 1" = 10'-0"  
 STA. 51+10 - 51+40



PROJECT NAME: HUNTINGTON	PLOT DATE: 8/15/2016
PROJECT NUMBER: BR 0211(32)	DRAWN BY: K.C. BARRY
FILE NAME: z13J080xsl.dgn	CHECKED BY: E.F. LAWES
PROJECT LEADER: S.E. BURBANK	SHEET 55 OF 62
DESIGNED BY: K.C. BARRY	
CHANNEL CROSS SECTIONS (3 OF 4)	