



51+60

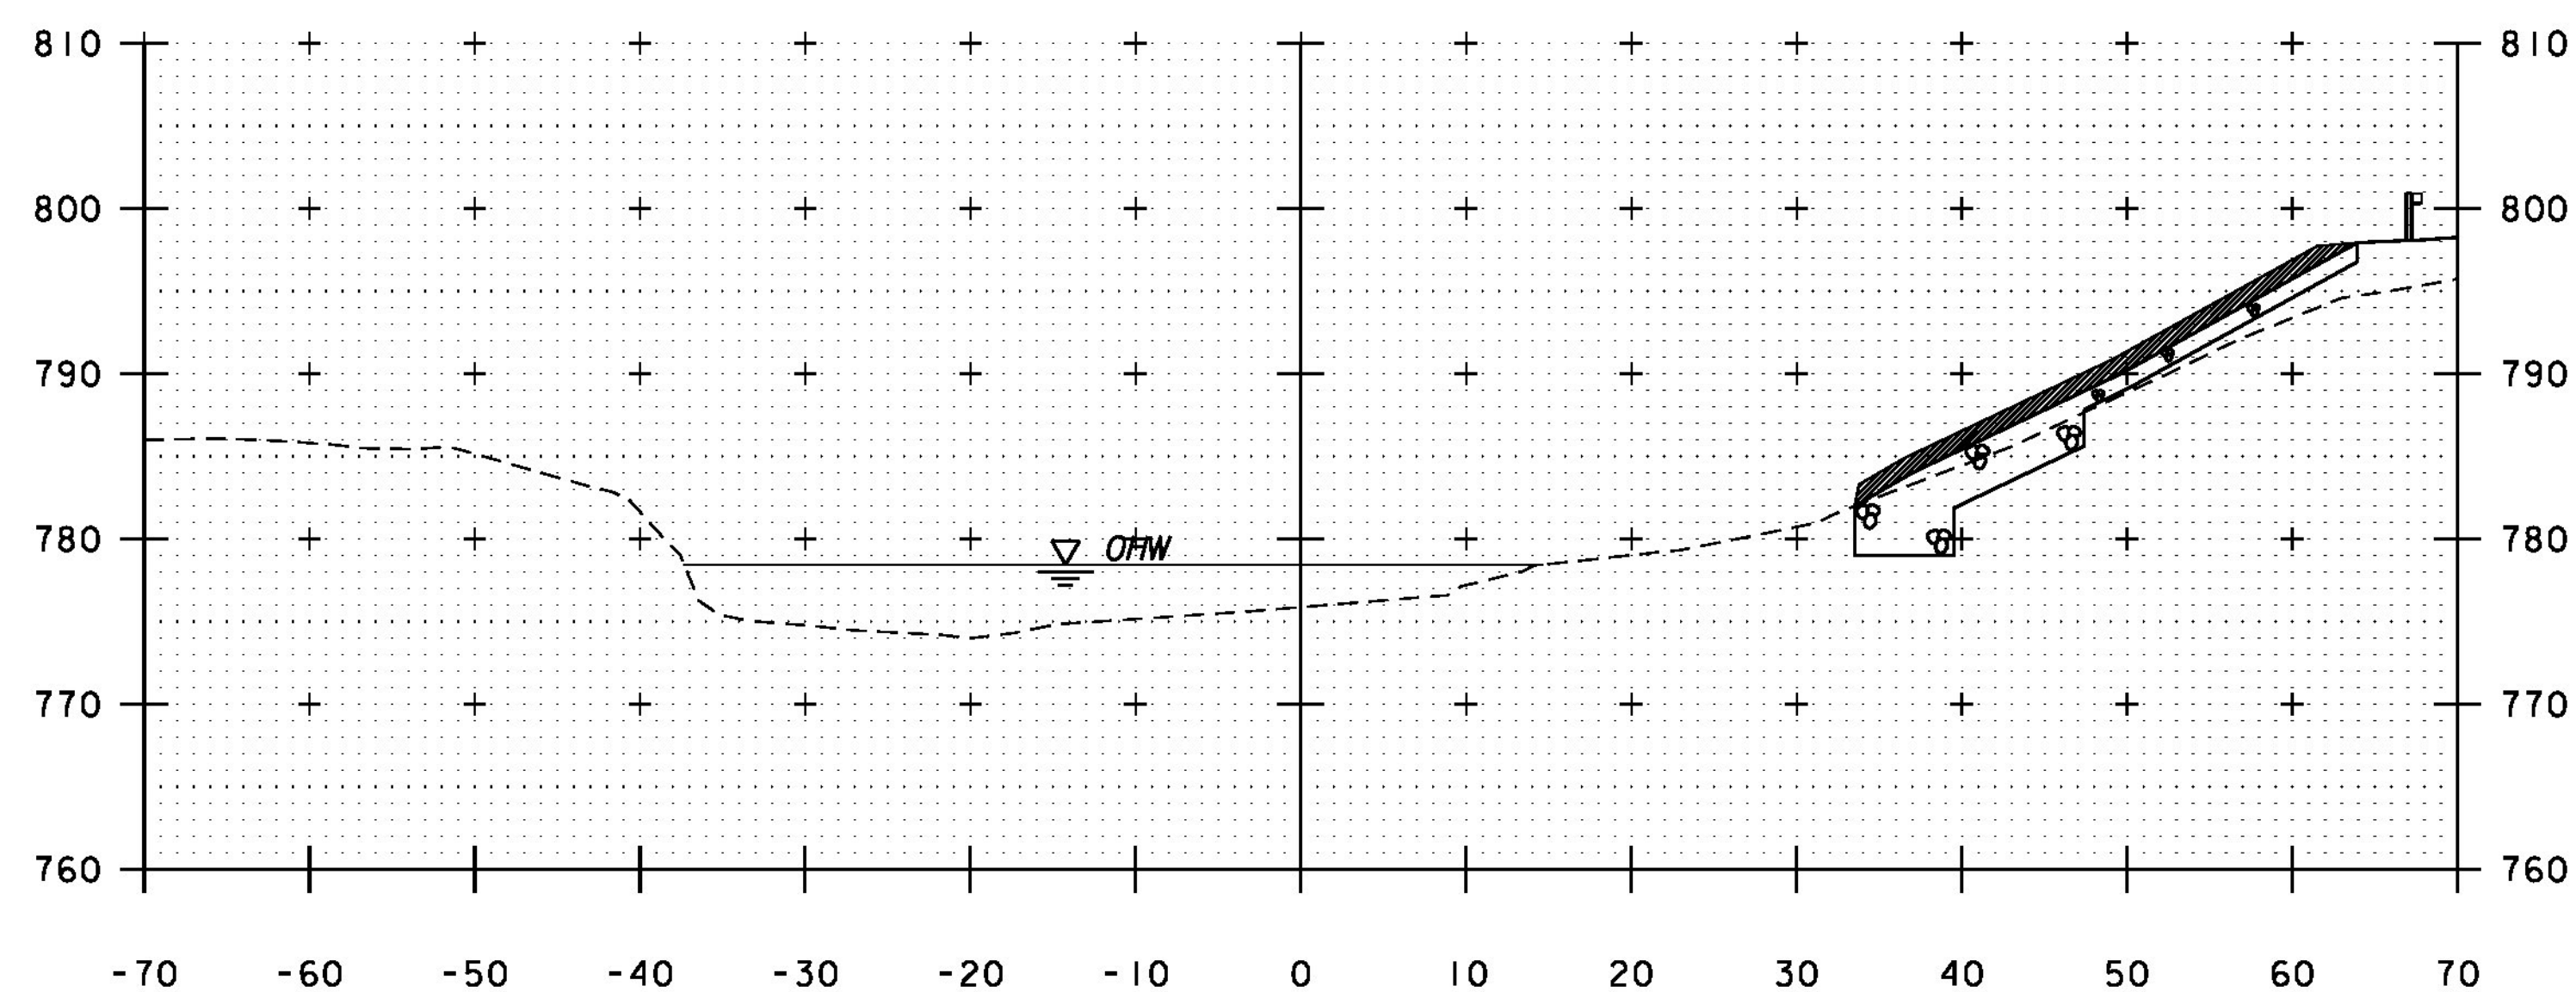


52+00

STA. 52+00, RT
 END UNCLASSIFIED CHANNEL EXCAVATION
 GEOTEXTILE UNDER STONE FILL
 STONE FILL, TYPE III, & GRUBBING MATERIAL

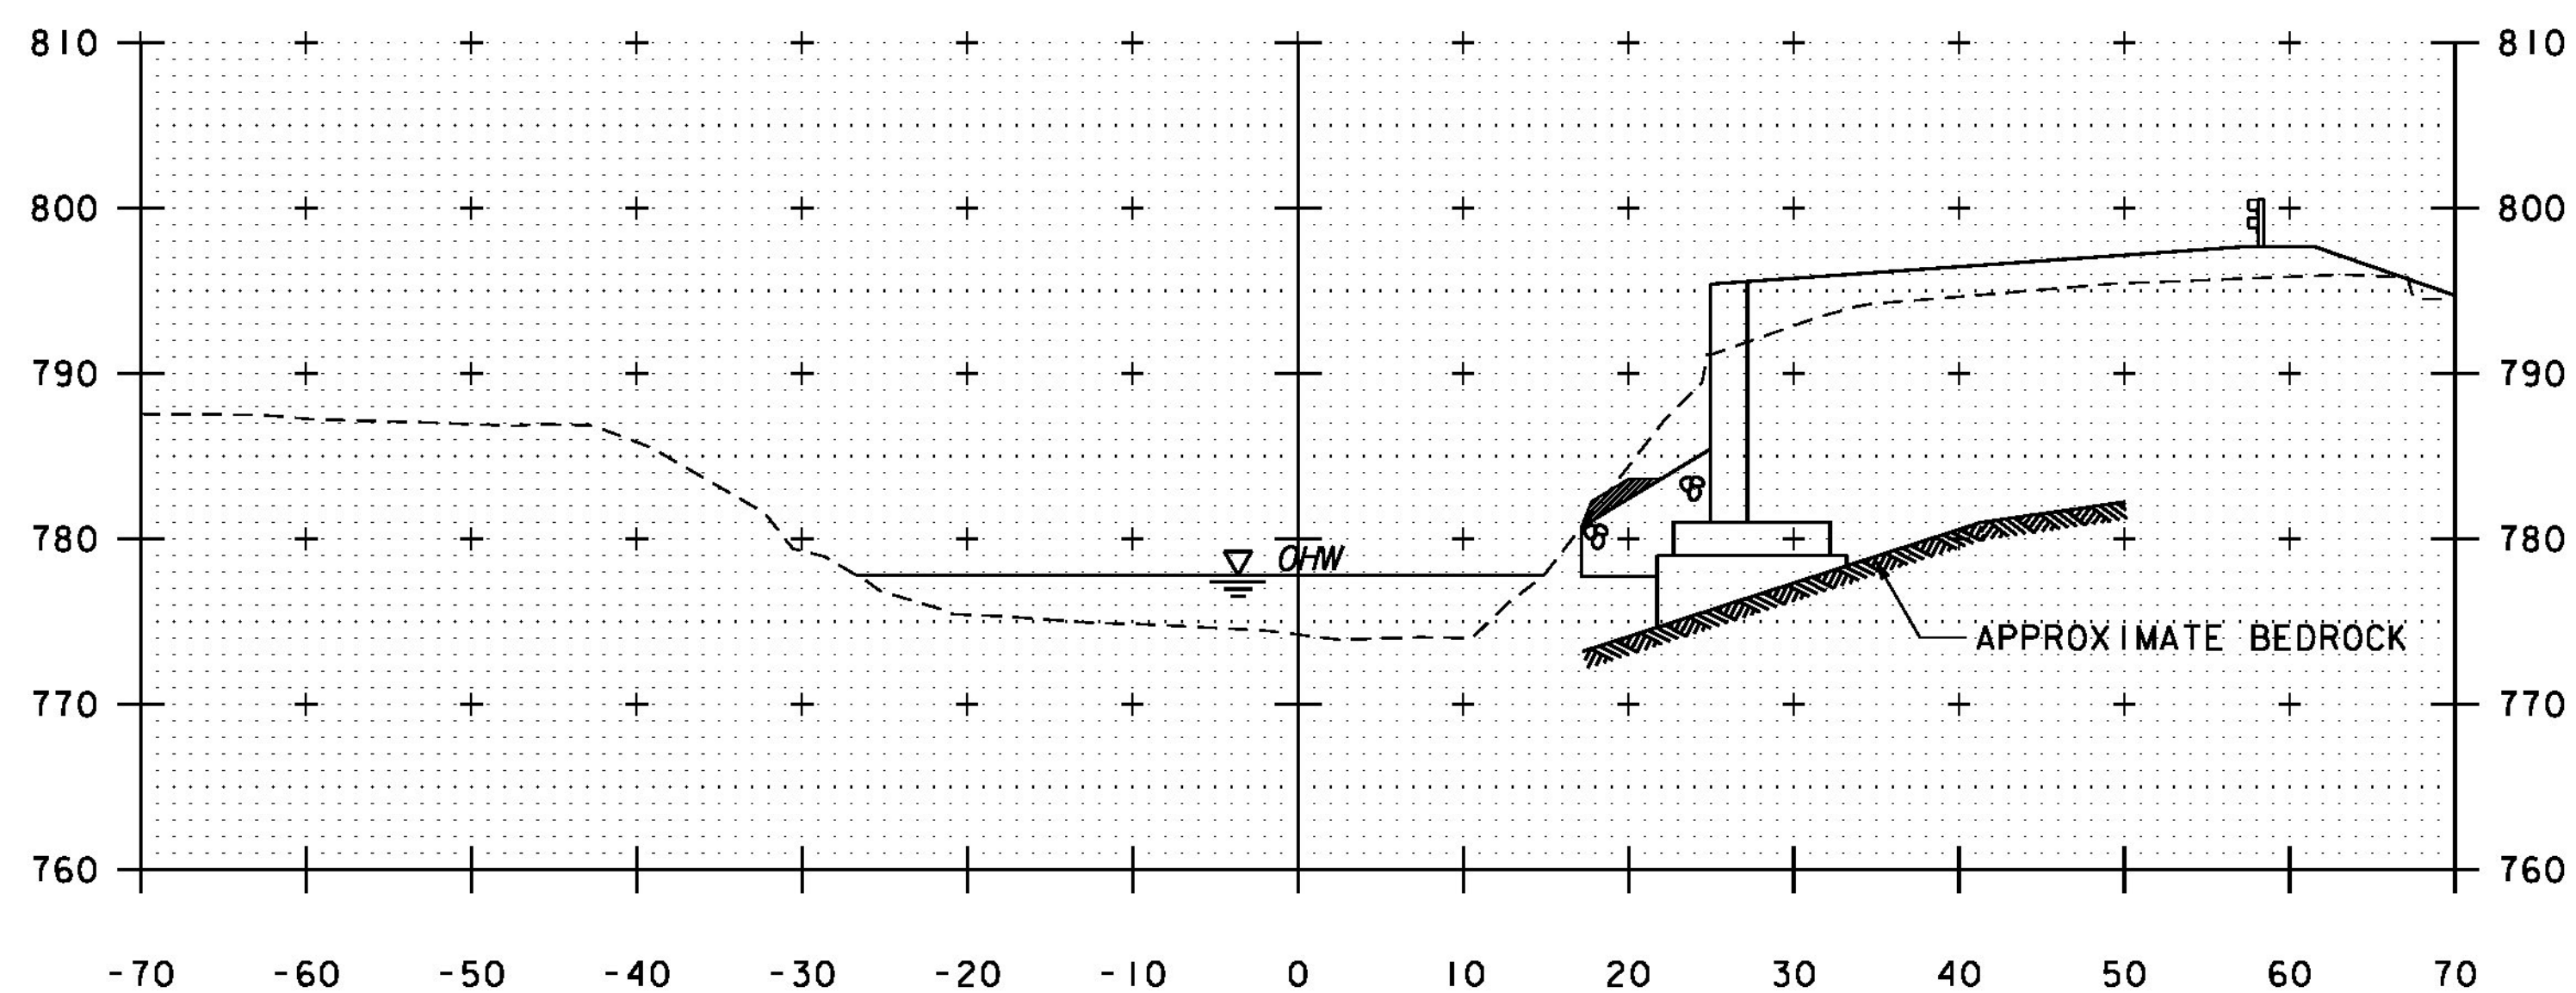

51+50

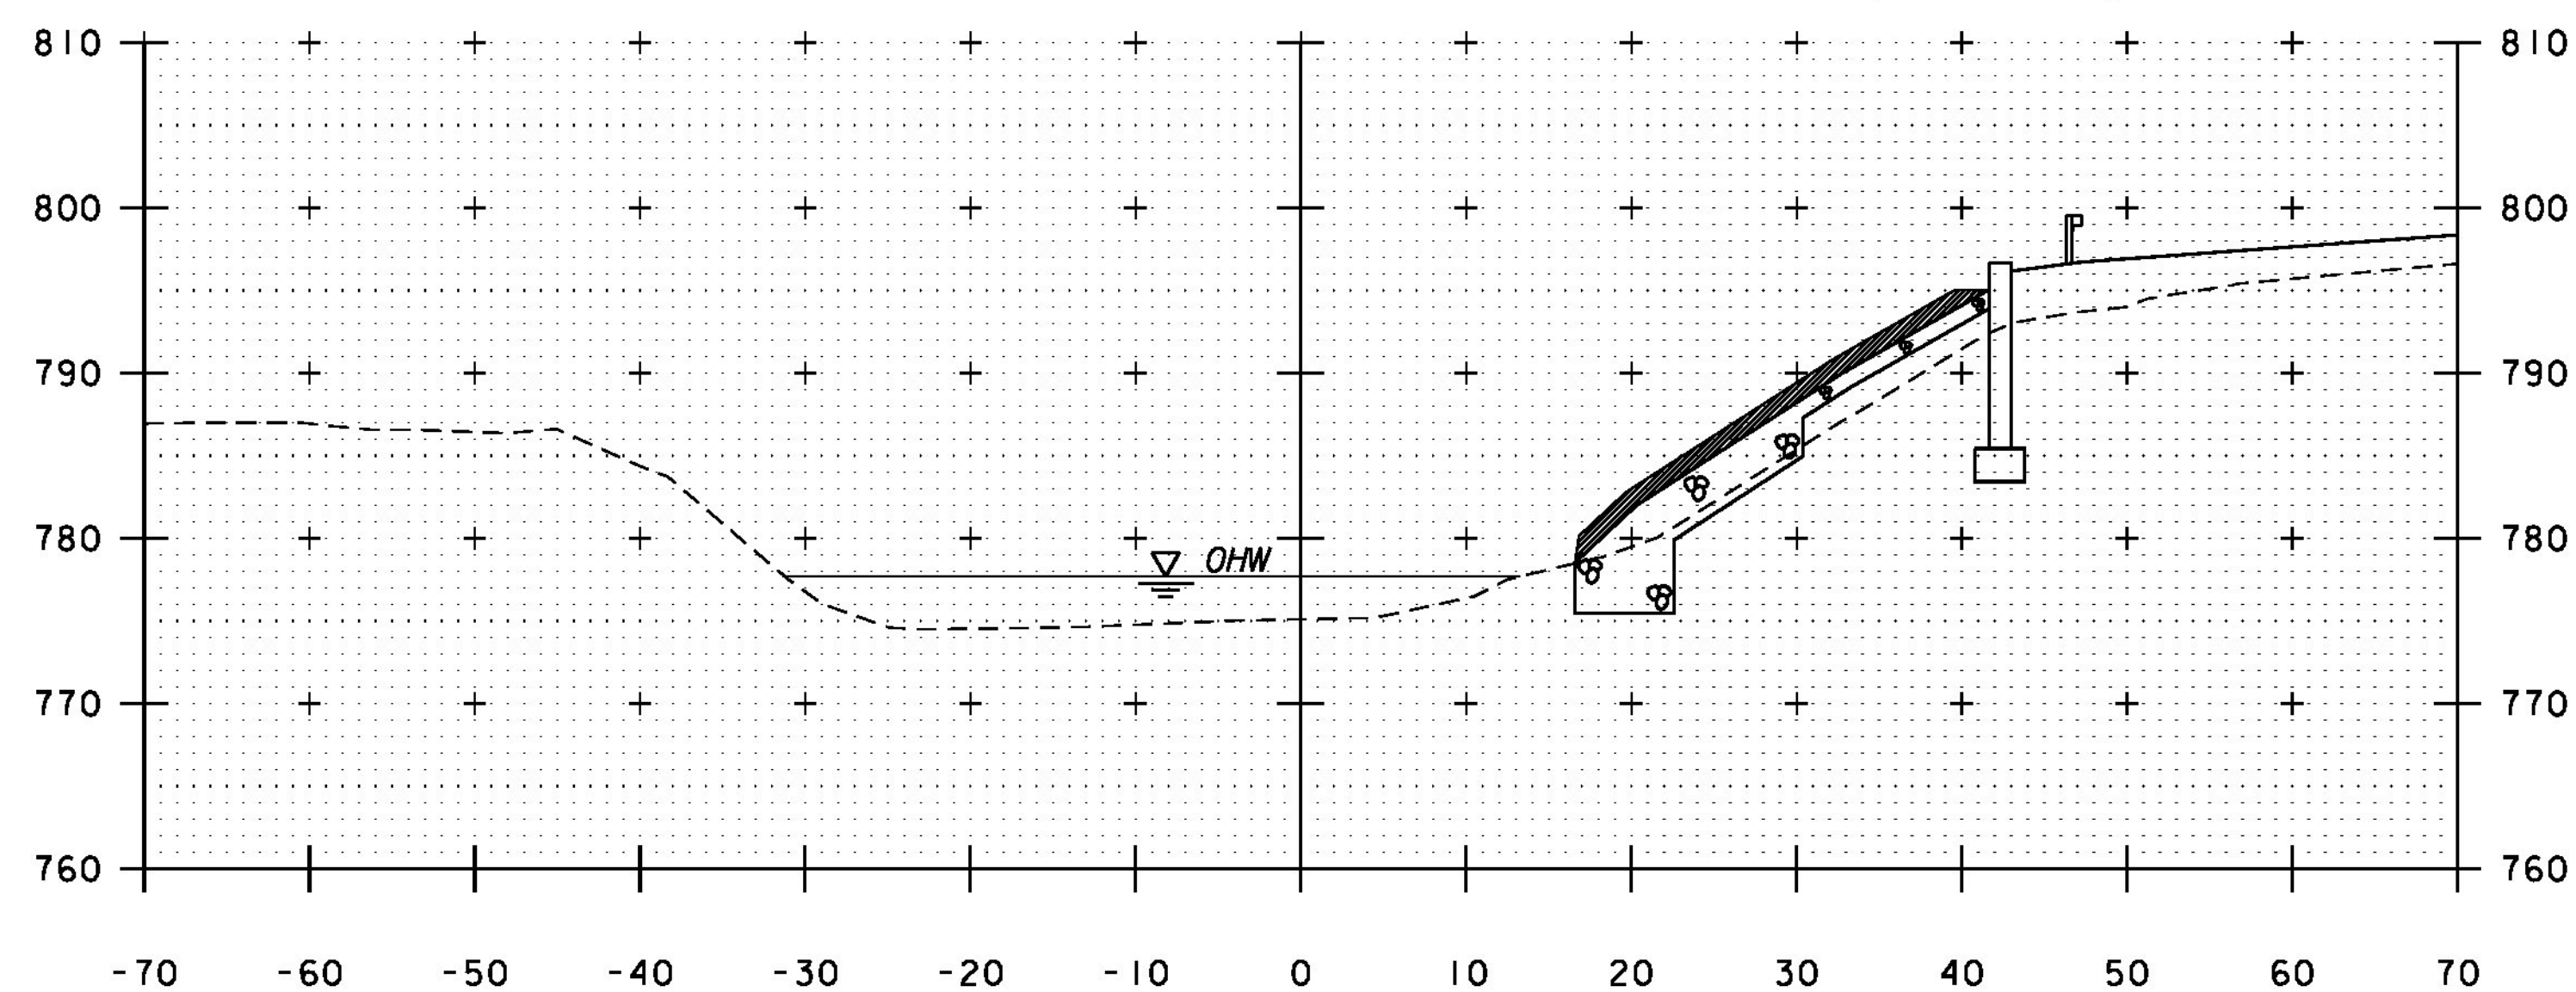

51+75

CHANNEL CROSS SECTIONS
 SCALE 1" = 10'-0"
 STA. 51+50 - 52+00



PROJECT NAME:	HUNTINGTON	PLOT DATE:	8/15/2016
PROJECT NUMBER:	BR 02II(32)	DRAWN BY:	K.C. BARRY
FILE NAME:	z13J080xsl.dgn	CHECKED BY:	E.F. LAWES
PROJECT LEADER:	S.E. BURBANK	SHEET	56 OF 62
DESIGNED BY:	K.C. BARRY	CHANNEL CROSS SECTIONS (4 OF 4)	