


STETSON GRAVELLY FINE SANDY LOAM  
 5% - 12% SLOPES  
 LOW EROSION POTENTIAL  
 K = 0.15

HADLEY VERY FINE SANDY LOAM  
 FREQUENTLY FLOODED  
 0% - 3% SLOPES  
 LOW EROSION POTENTIAL  
 K = 0.32

CABOT SILT LOAM  
 3% - 25% SLOPES  
 HIGH EROSION POTENTIAL  
 K = 0.49

PERU EXTREMELY STONY LOAM  
 20% - 60% SLOPES  
 MODERATE EROSION POTENTIAL  
 K = 0.28

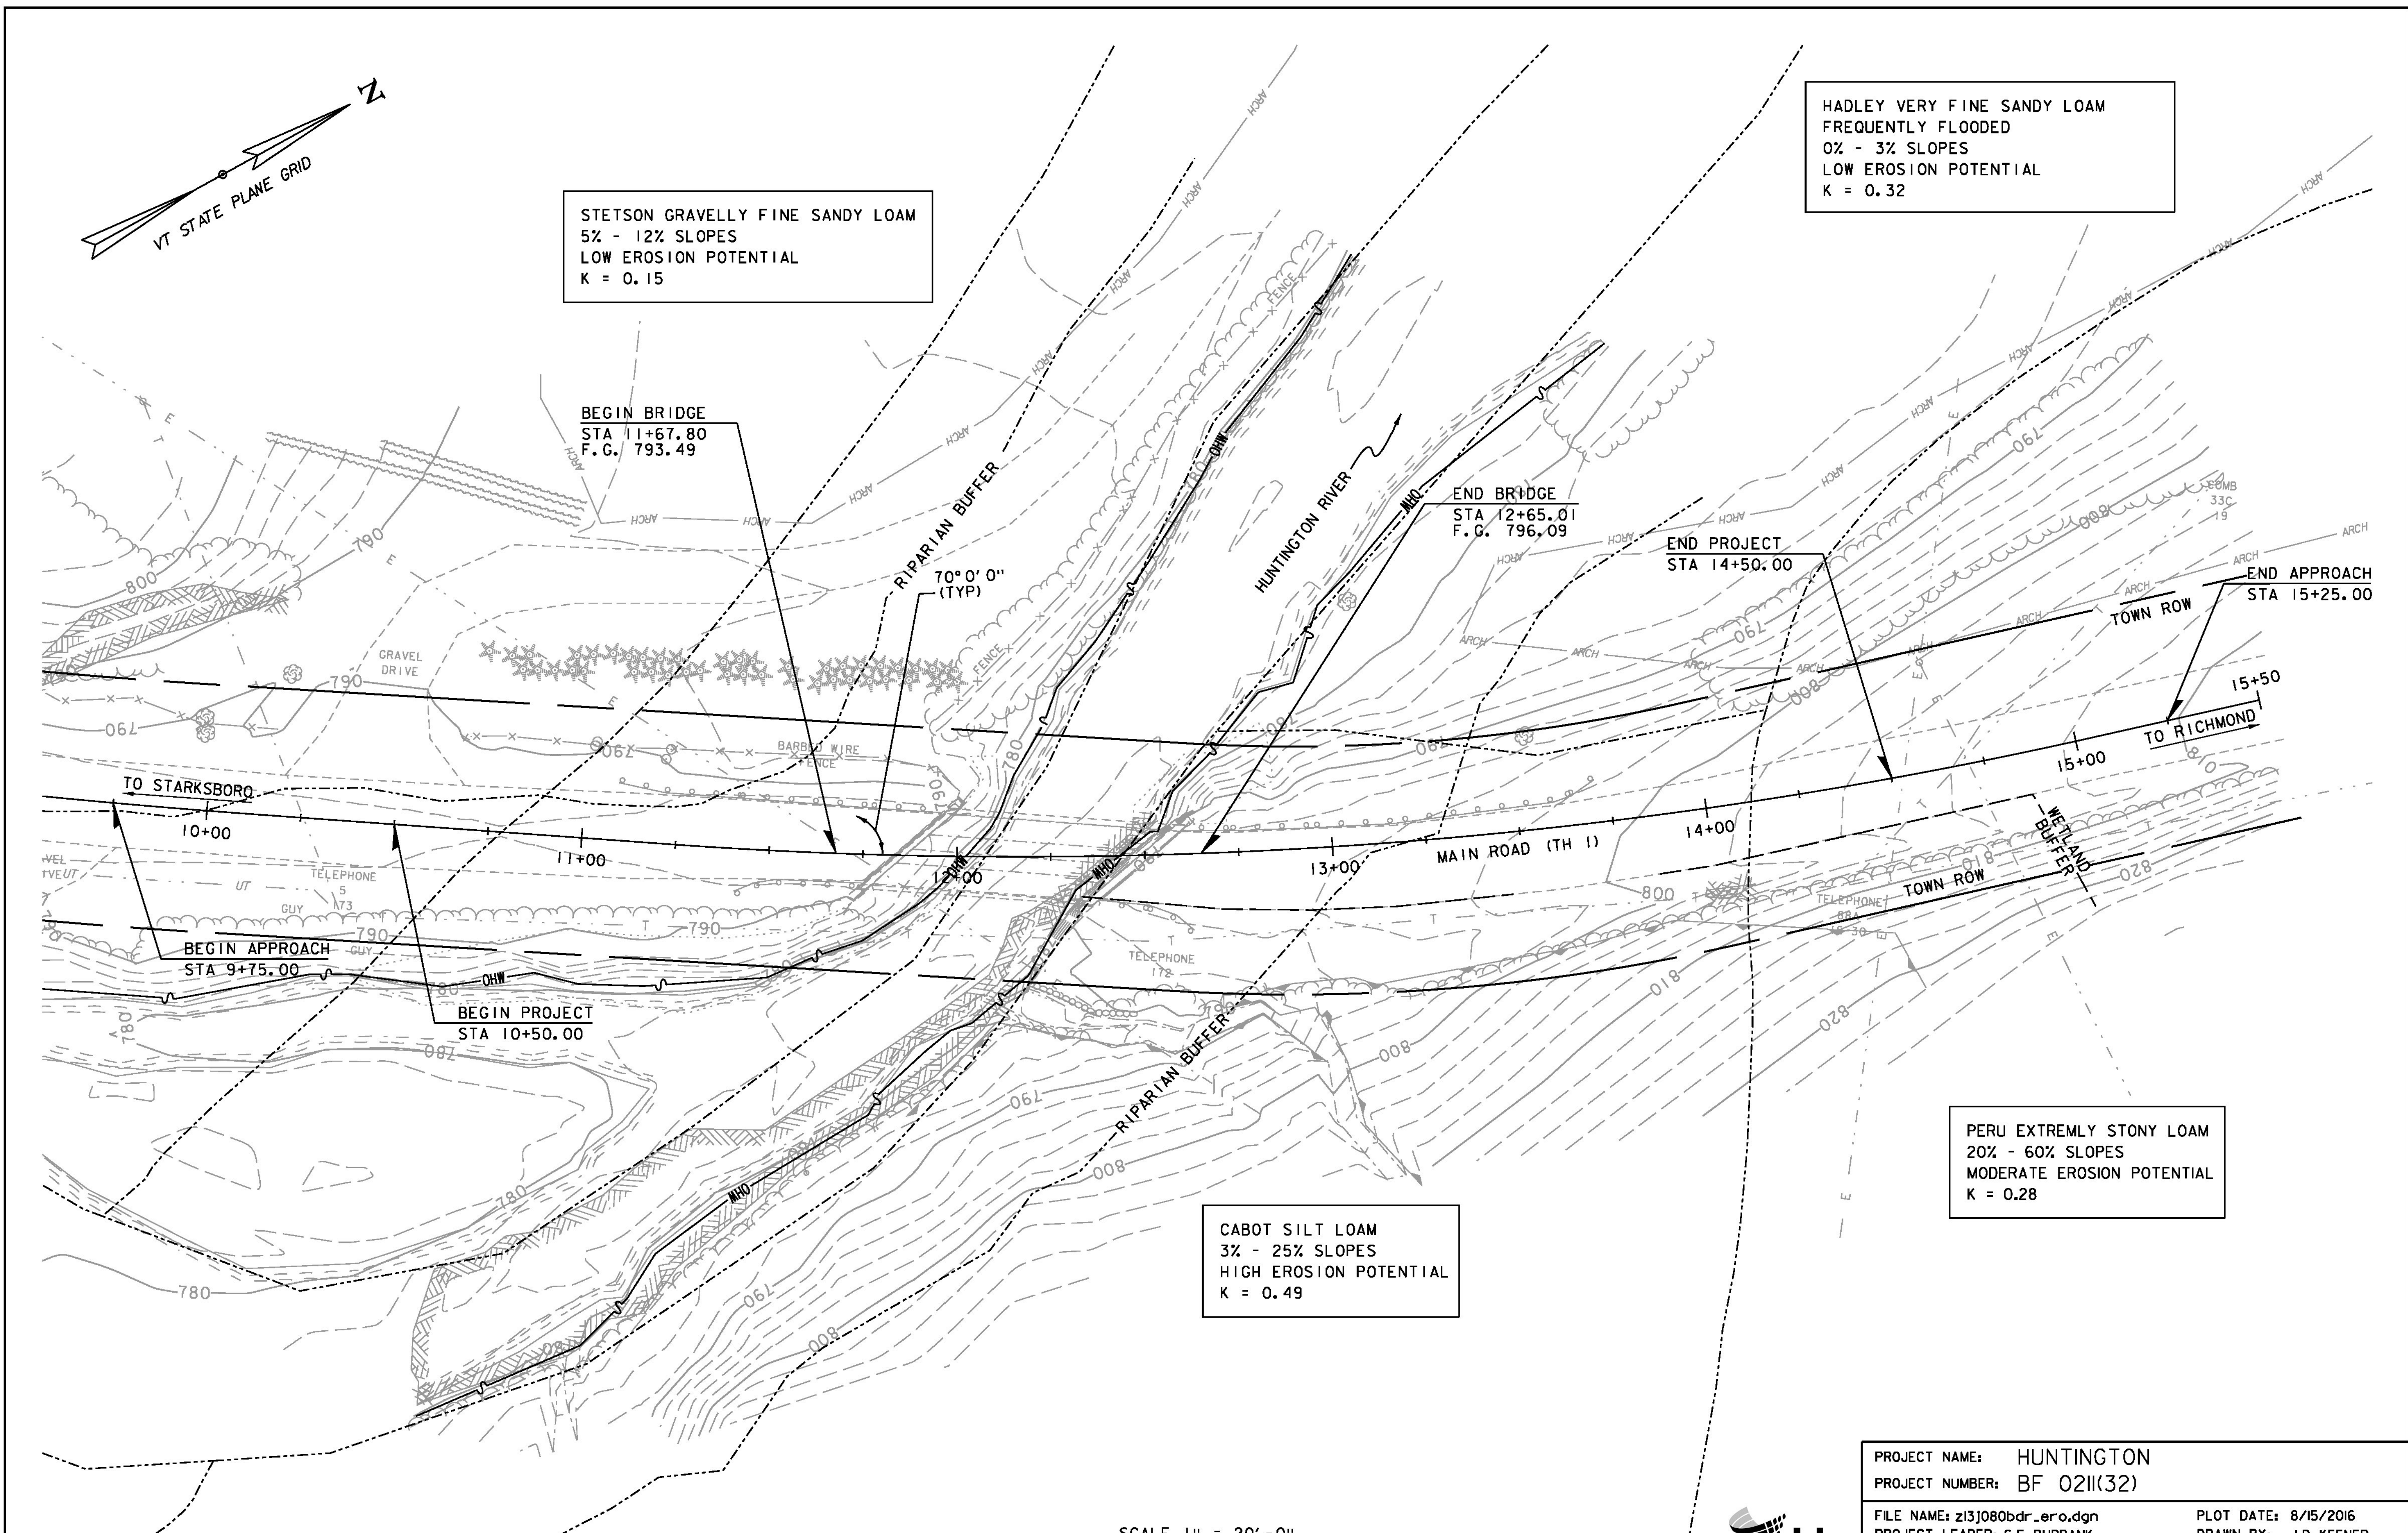

SCALE 1" = 20'-0"  
 20 0 20

PROJECT NAME: HUNTINGTON	FILE NAME: z13j080bdr_ero.dgn	PLOT DATE: 8/15/2016
PROJECT NUMBER: BF 0211(32)	PROJECT LEADER: S.E. BURBANK	DRAWN BY: J.D. KEENER
	DESIGNED BY: J.D. KEENER	CHECKED BY: E.F. LAWES
	EPSC EXISTING SITE PLAN	SHEET 58 OF 62

