
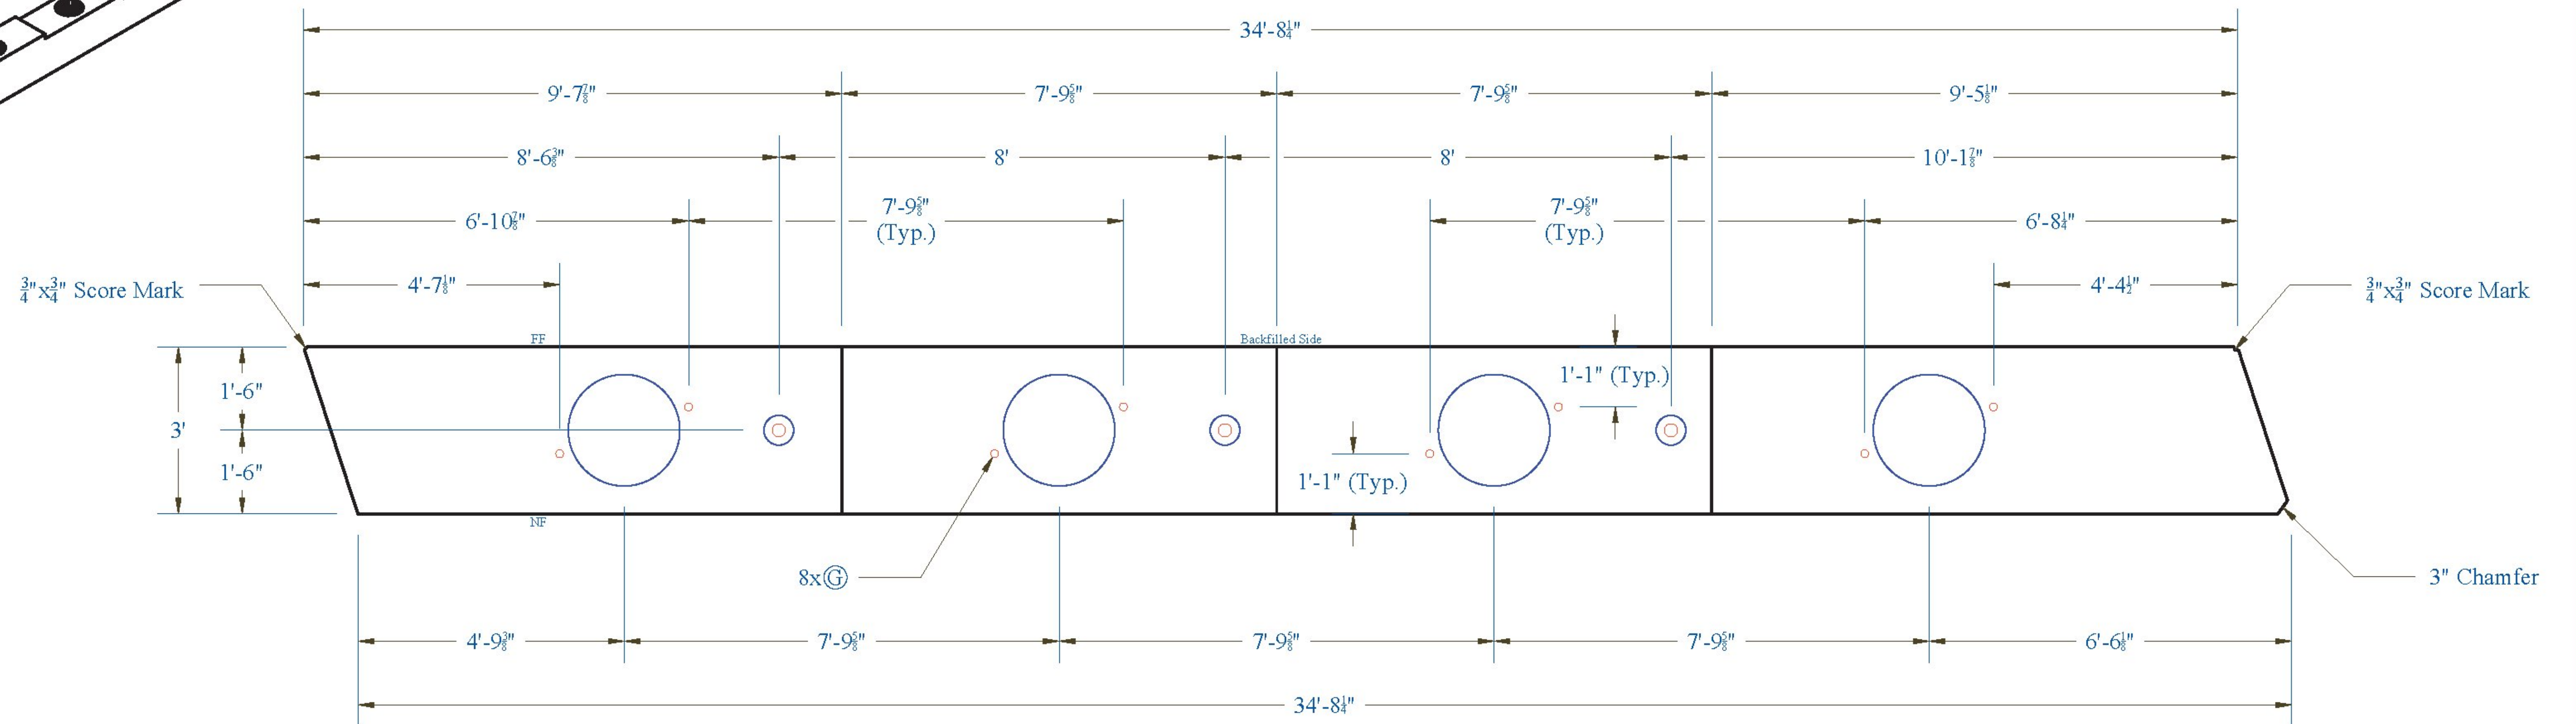



Abutment 1 Stem:

Weight: 46,960 lbs

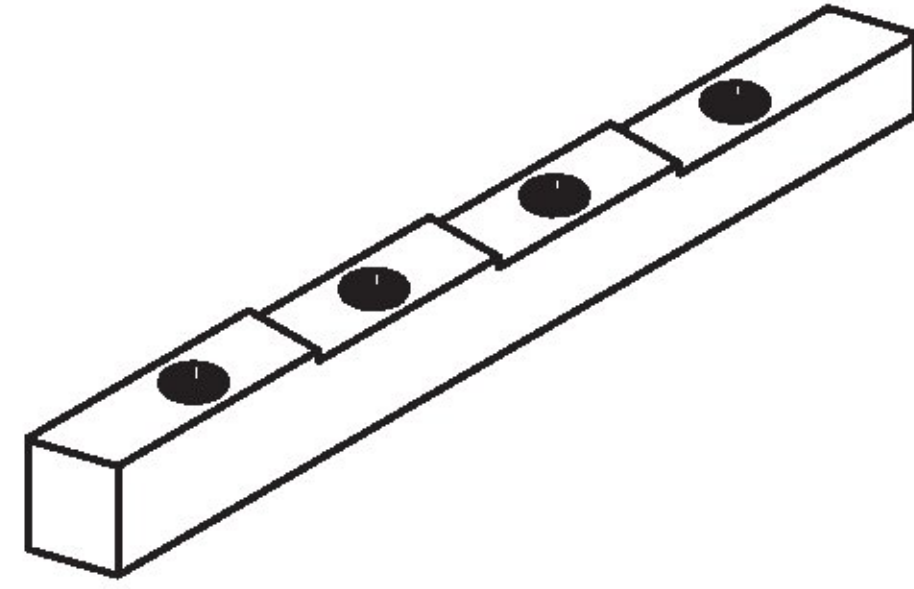

Plan View

Top 6" of Sleeves to be Formed with Removable Sonitube per State Note 2, Sheet 38 Cut Edge to Have Galvanized Coating Repaired (Typ. All Sleeves)

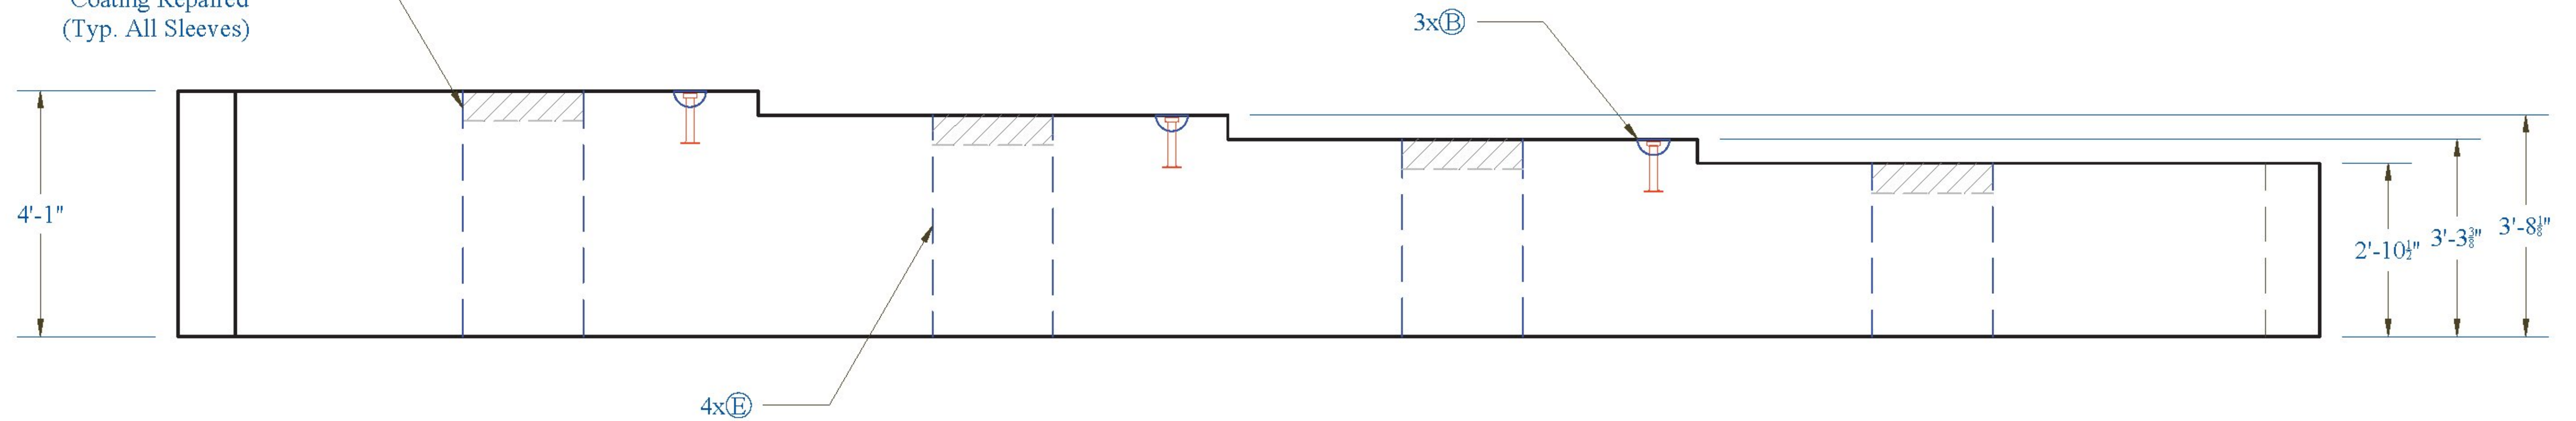

Section View

Vermont Agency of Transportation
RECEIVED
 CK'D BY _____ OK'D BY Rob Young
 April 21, 2017
 RESUBMIT NO Approved AsNoted
 BY Rob Young DATE 04/28/2017

CONTRACTORS VISPE:	LEGEND: (A) Oxford A750-7 (D) 3" Pipe (G) Ø 3" x 24" Plastic Corrugated Sleeve (B) P52:20T x 10" Lift (E) Ø 24" Galv. Corrugated Steel Pipe (H) P53 Lift w/ Tension Bar (C) 4" Pipe (F) Ø 15" Galv. Corrugated Steel Pipe (I) 1" Chamfer	PRECAST CONCRETE ABUTMENT SHOP DRAWINGS (SDI JOB #18544) SUPERVISOR: E. Barendse PROJ. NAME: HUNTINGTON DETAILER: I. ADAMS PROJECT #: BF 0211(32) CHECKER: E. Barendse LOCATION: HUNTINGTON, VT ENGINEER: CONCRETE ENG. SOLUTIONS		INSTALLER: S.D. IRELAND CONCRETE WILLISTON, VT 05495 Ph: (802) 863-6222 04/20/17	FABRICATOR: 193 INDUSTRIAL AVE. WILLISTON, VT 05495 Ph: (802) 863-6222 ABUTMENT_1_STEM		7/29
		CONTRACTORS VISPE:	S.D. Ireland PRECAST				