



Abutment 2: Overview

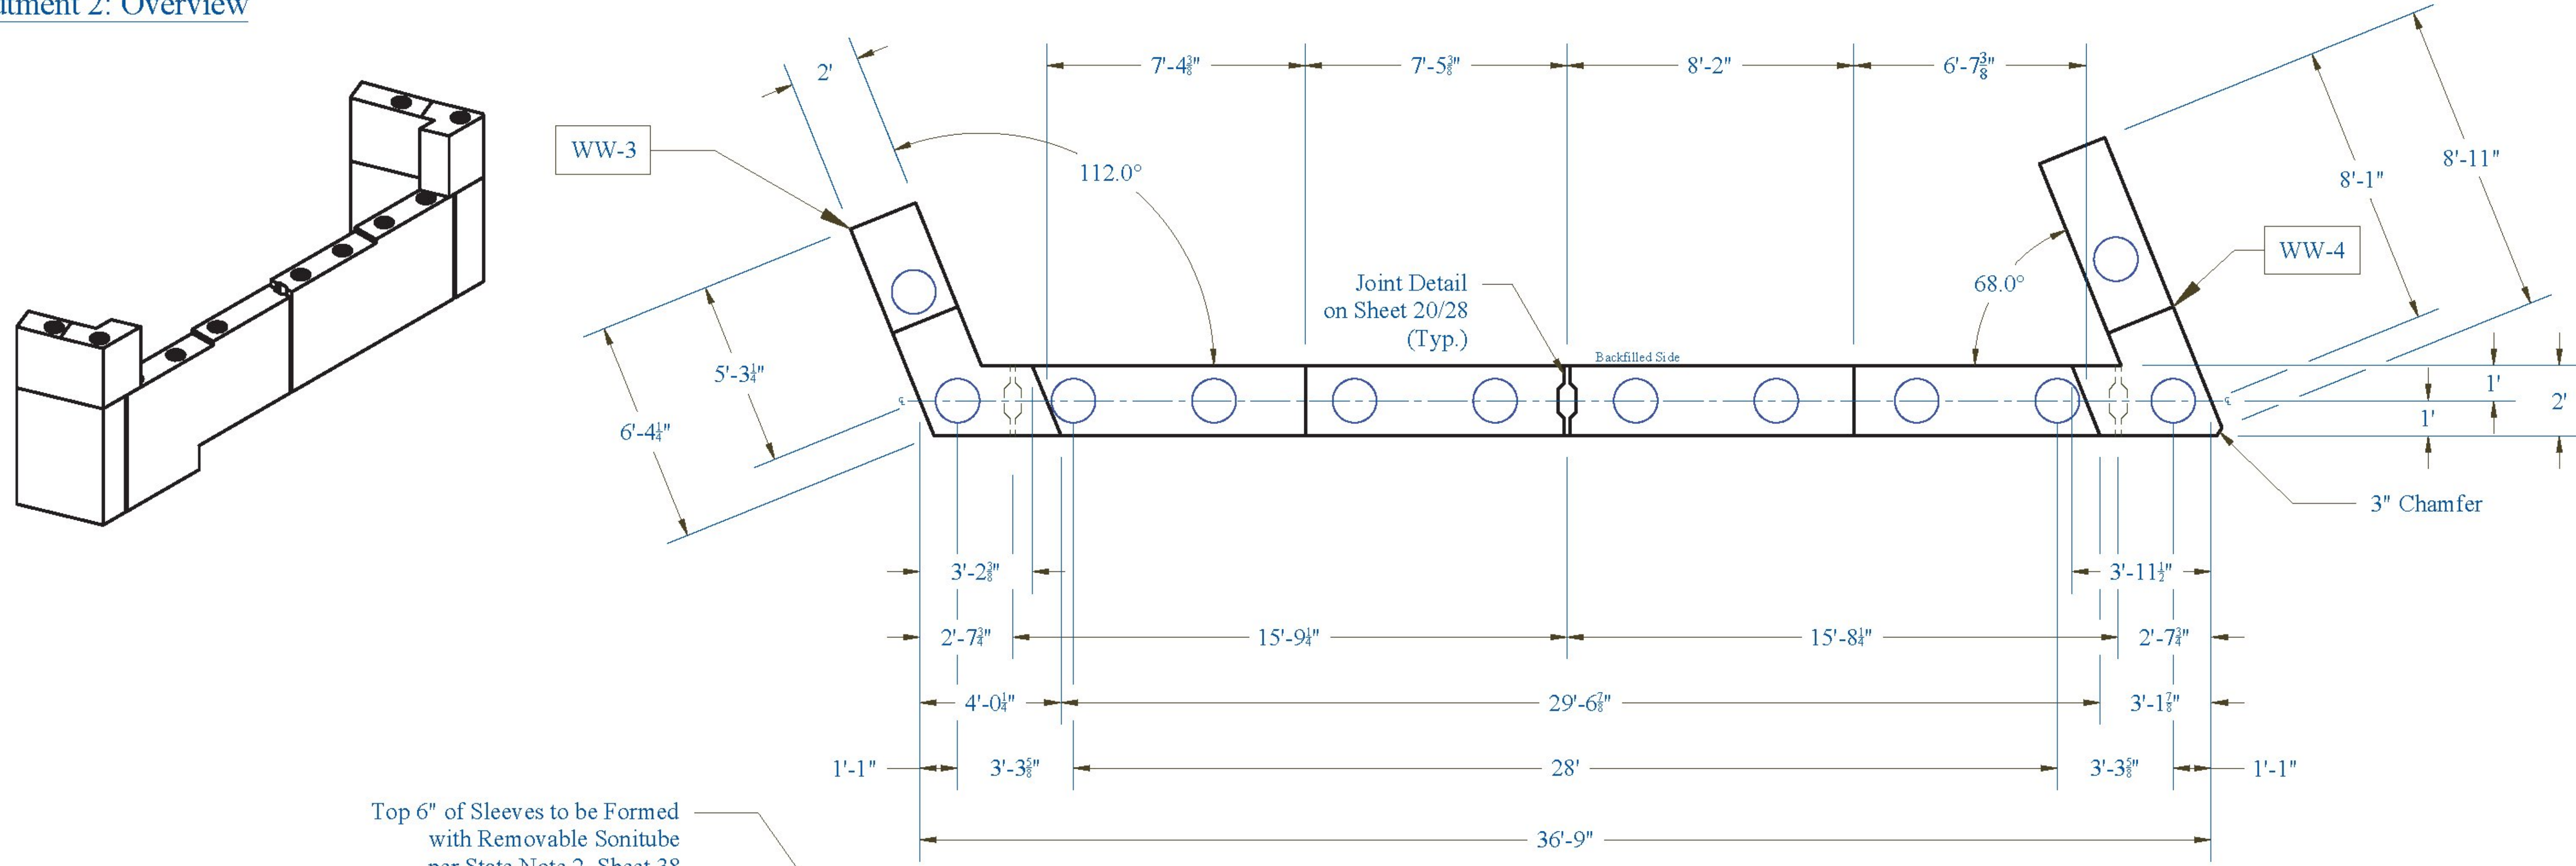

Plan View

Top 6" of Sleeves to be Formed with Removable Sonitube per State Note 2, Sheet 38 Cut Edge to Have Galvanized Coating Repaired (Typ. All Wing and Cap Sleeves)

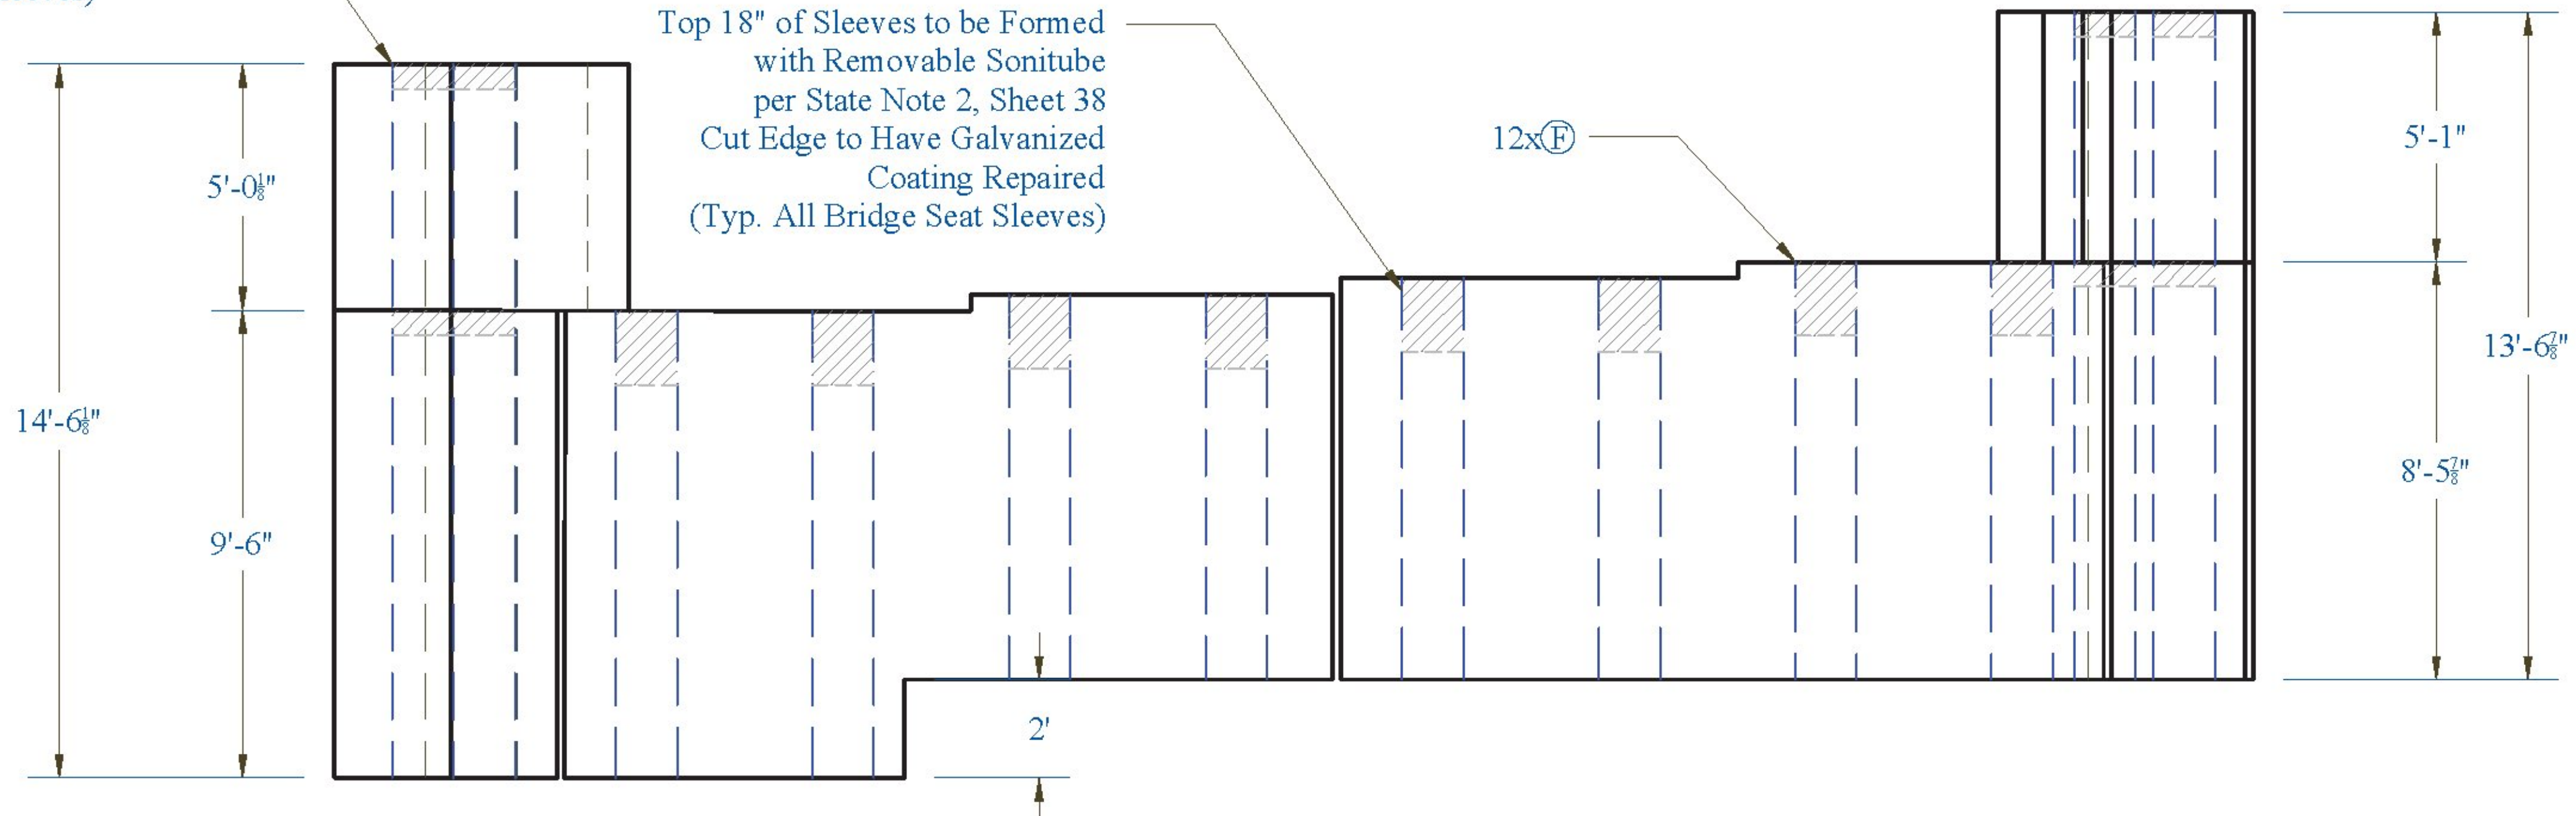

Section View

Vermont Agency of Transportation
RECEIVED
 CK'D BY _____ OK'D BY Rob Young
 April 21, 2017
 RESUBMIT NO. _____ Approved AsNoted
 BY Rob Young DATE 04/28/2017

| | | | | | |
|--------------------|--|--|--|--|---|
| CONTRACTORS VISPE: | LEGEND: (A) Oxford A750-7 (D) 3" Pipe (G) Ø 3" x 24" Plastic Corrugated Sleeve (B) P52:20T x 10" Lift (E) Ø 24" Galv. Corrugated Steel Pipe (H) P53 Lift w/ Tension Bar (C) 4" Pipe (F) Ø 15" Galv. Corrugated Steel Pipe (I) 1" Chamfer | PRECAST CONCRETE ABUTMENT SHOP DRAWINGS (SDI JOB #18544) | | INSTALLER: S.D. IRELAND CONCRETE WILLISTON, VT 05495 Ph: (802) 863-6222 | FABRICATOR: 193 INDUSTRIAL AVE. WILLISTON, VT 05495 Ph: (802) 863-6222 |
| | | SUPERVISOR: E. Barendse DETAILER: I. ADAMS CHECKER: E. Barendse ENGINEER: CONCRETE ENG. SOLUTIONS | PROJ. NAME: HUNTINGTON PROJECT #: BF 0211(32) LOCATION: HUNTINGTON, VT | 04/20/17 | ABUTMENT_2_STEM_OVERVIEW |

