


BILL OF MATERIAL							QTY	WEIGHT	REMARKS
QTY	DESC	SIZE	UNIT	WEIGHT	LENGTH	WEIGHT	WT	REMARKS	
1	GIRDER						18063		
1	E	PL 1/2 x 42	84	8 1/2		4829			
1	C	PL 1/2 x 42	32	3 1/2		2307			
1	L	PL 1/2 x 38	30	10 1/2		1854			
1	T	PL 1/2 x 38	84	8		3550			
1	C	PL 1/2 x 38	32	1 1/2		1959			
1	R	PL 1/2 x 38	84	8		3951			
4	B	PL 1/2 x 7	9	8		83			
2	C	PL 1/2 x 3	3	6		80			
2	E	PL 1/2 x 2	1	0		2			

APPROVER CONFIRMED FOR THE GIRDER ENDS, PLEASE CONFIRM WEB COPE SIZE AND THE POSITION OF SLOTTED HOLES ARE ACCEPTABLE (TYP).

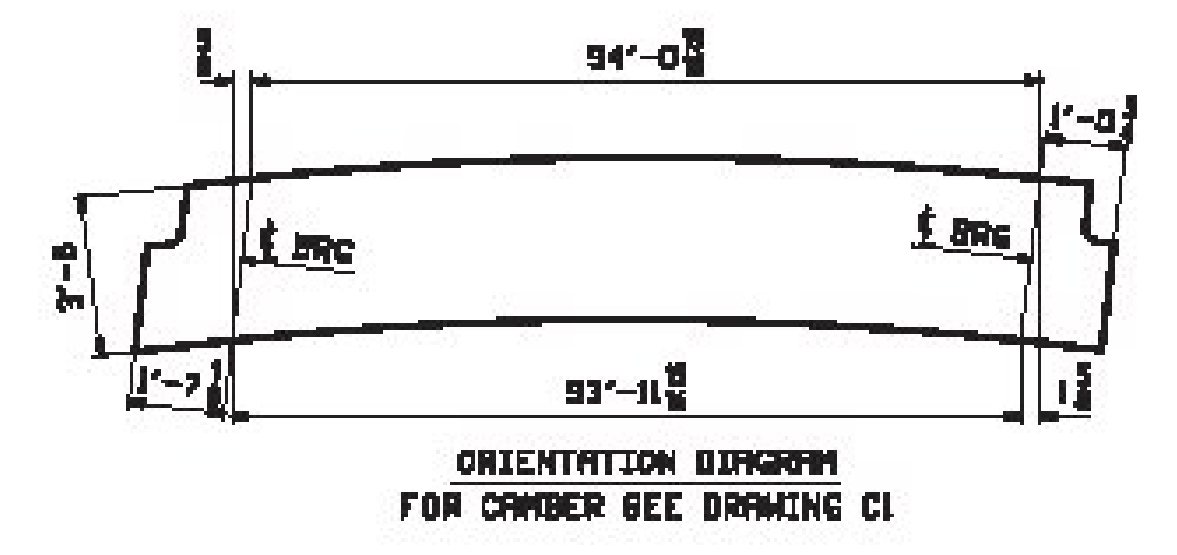

2/15/17	APPROVAL COMMENTS	JTB	DBH				
REV.	DATE	REMARKS	DWG	CHK	APPV	SHOP	
MATERIAL:	A270-50W (UN)	SURFACE PREP. & PAINT:	SEE DWG GN	HOLES:	6 1/8 (UN)	SHOP BOLTS:	NONE
DESCRIPTION: GIRDER IGI							
CASCO BAY STEEL STRUCTURES, INC. 1 MILLING AVE. PHONE 802-780-8782 SOUTH PORTLAND, ME 04861 FAX 802-780-8788							
STRUCTURE:	TH-1, FRS RT. 021 / HUNTINGTON RIVER	DRAWN:	JTB	DATE:	01/18		
	RURAL MAJOR COLLECTOR	CHKD:	DBH	DATE:	01/18		
	COUNTY OF CHITTENDEN						
LOCATION:	TOWN OF HUNTINGTON, VERMONT	JOB NO.	030132	DMC NO.	1		
PROJ. NO.	STATE PROJ. BF-021(32)	895-1					
CUSTOMER:	VERMONT AGENCY OF TRANSPORTATION	REV.					

Vermont Agency of Transportation
RECEIVED
 CK'D BY: Rob Young
 OK'D BY: Rob Young
 February 16, 2017
 RESUBMIT: Approved As Noted
 BY: Rob Young DATE: 03/05/2017