
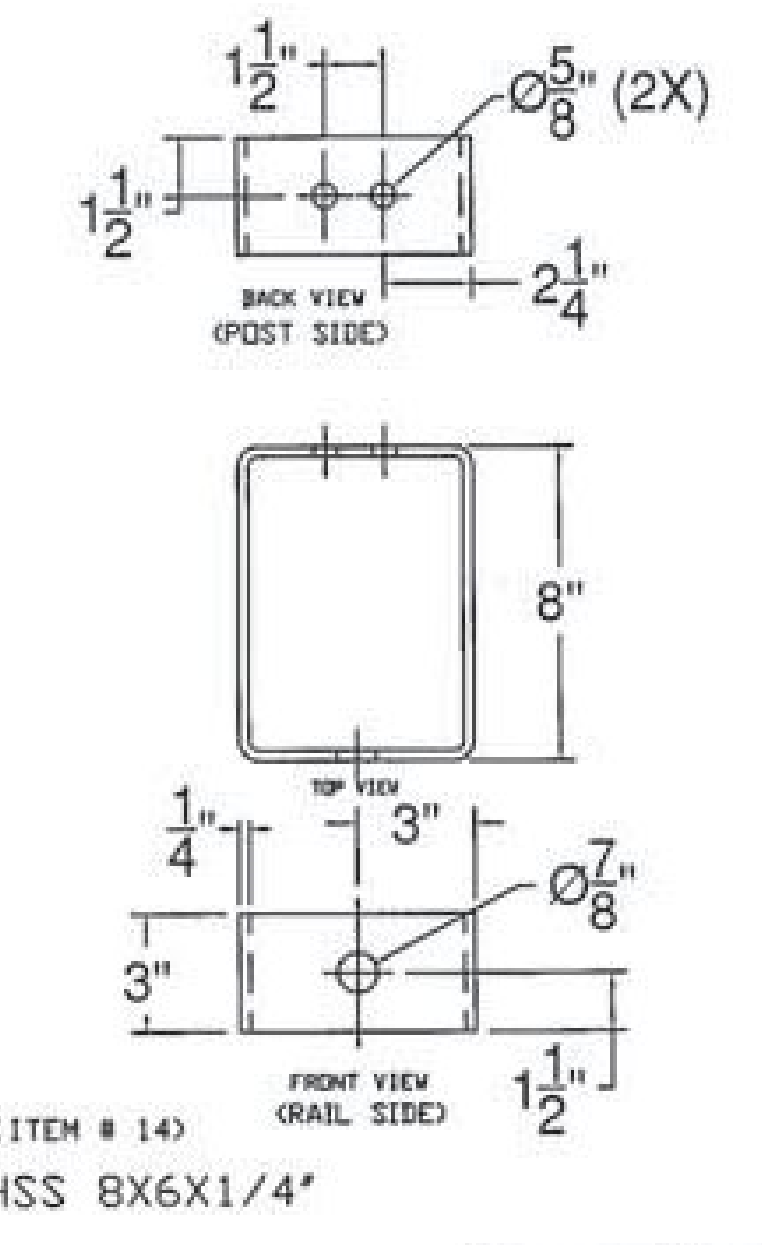
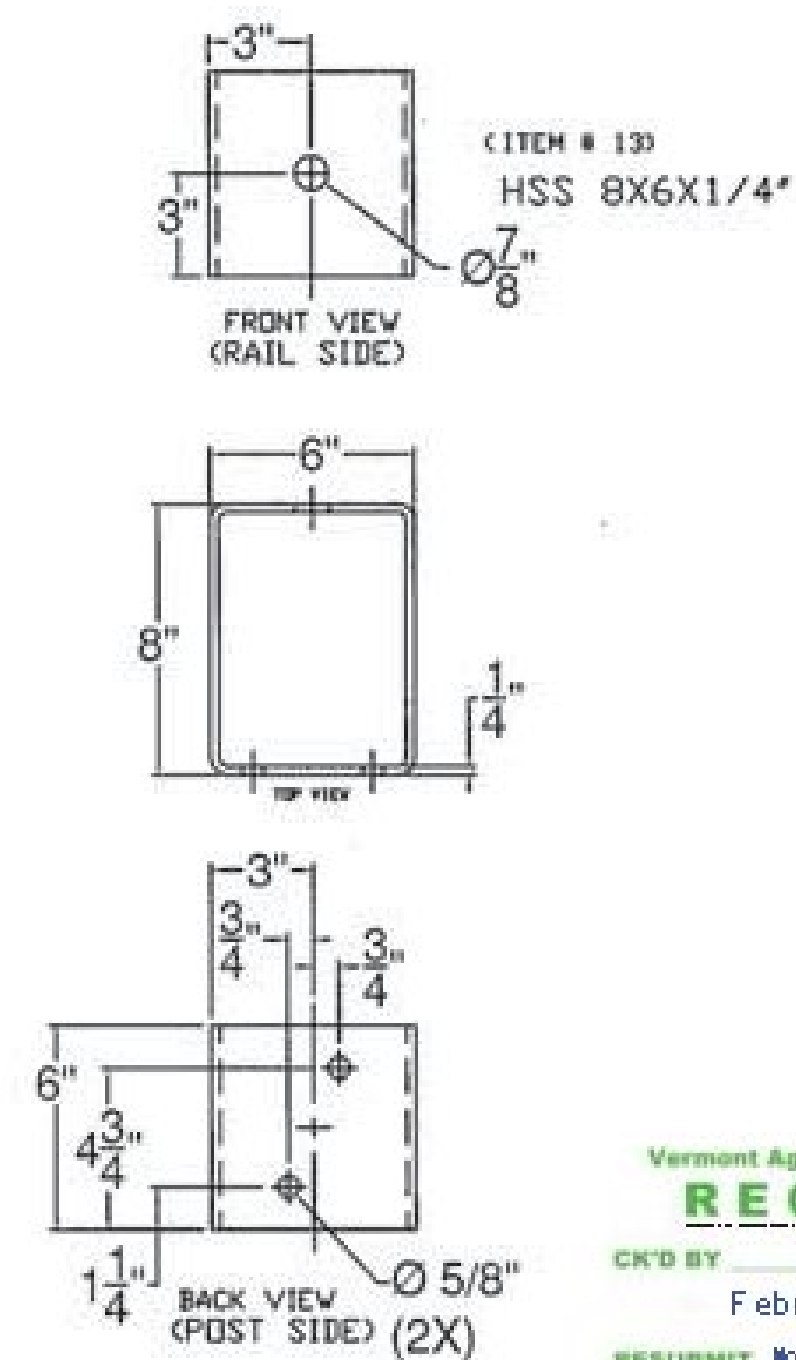
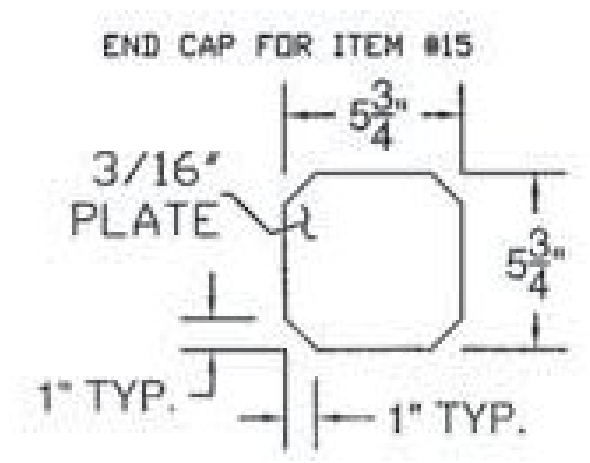


"A" - SEE PLAN FOR TURN BACK DISTANCE, SET ANGLE ACCORDINGLY.  
"B" - TURN DOWN ANGLE SET BY THE 9° MEASUREMENT AT THE END OF THE BOX BEAM.  
HARDWARE PER SHEET 2, HARDWARE NOTES

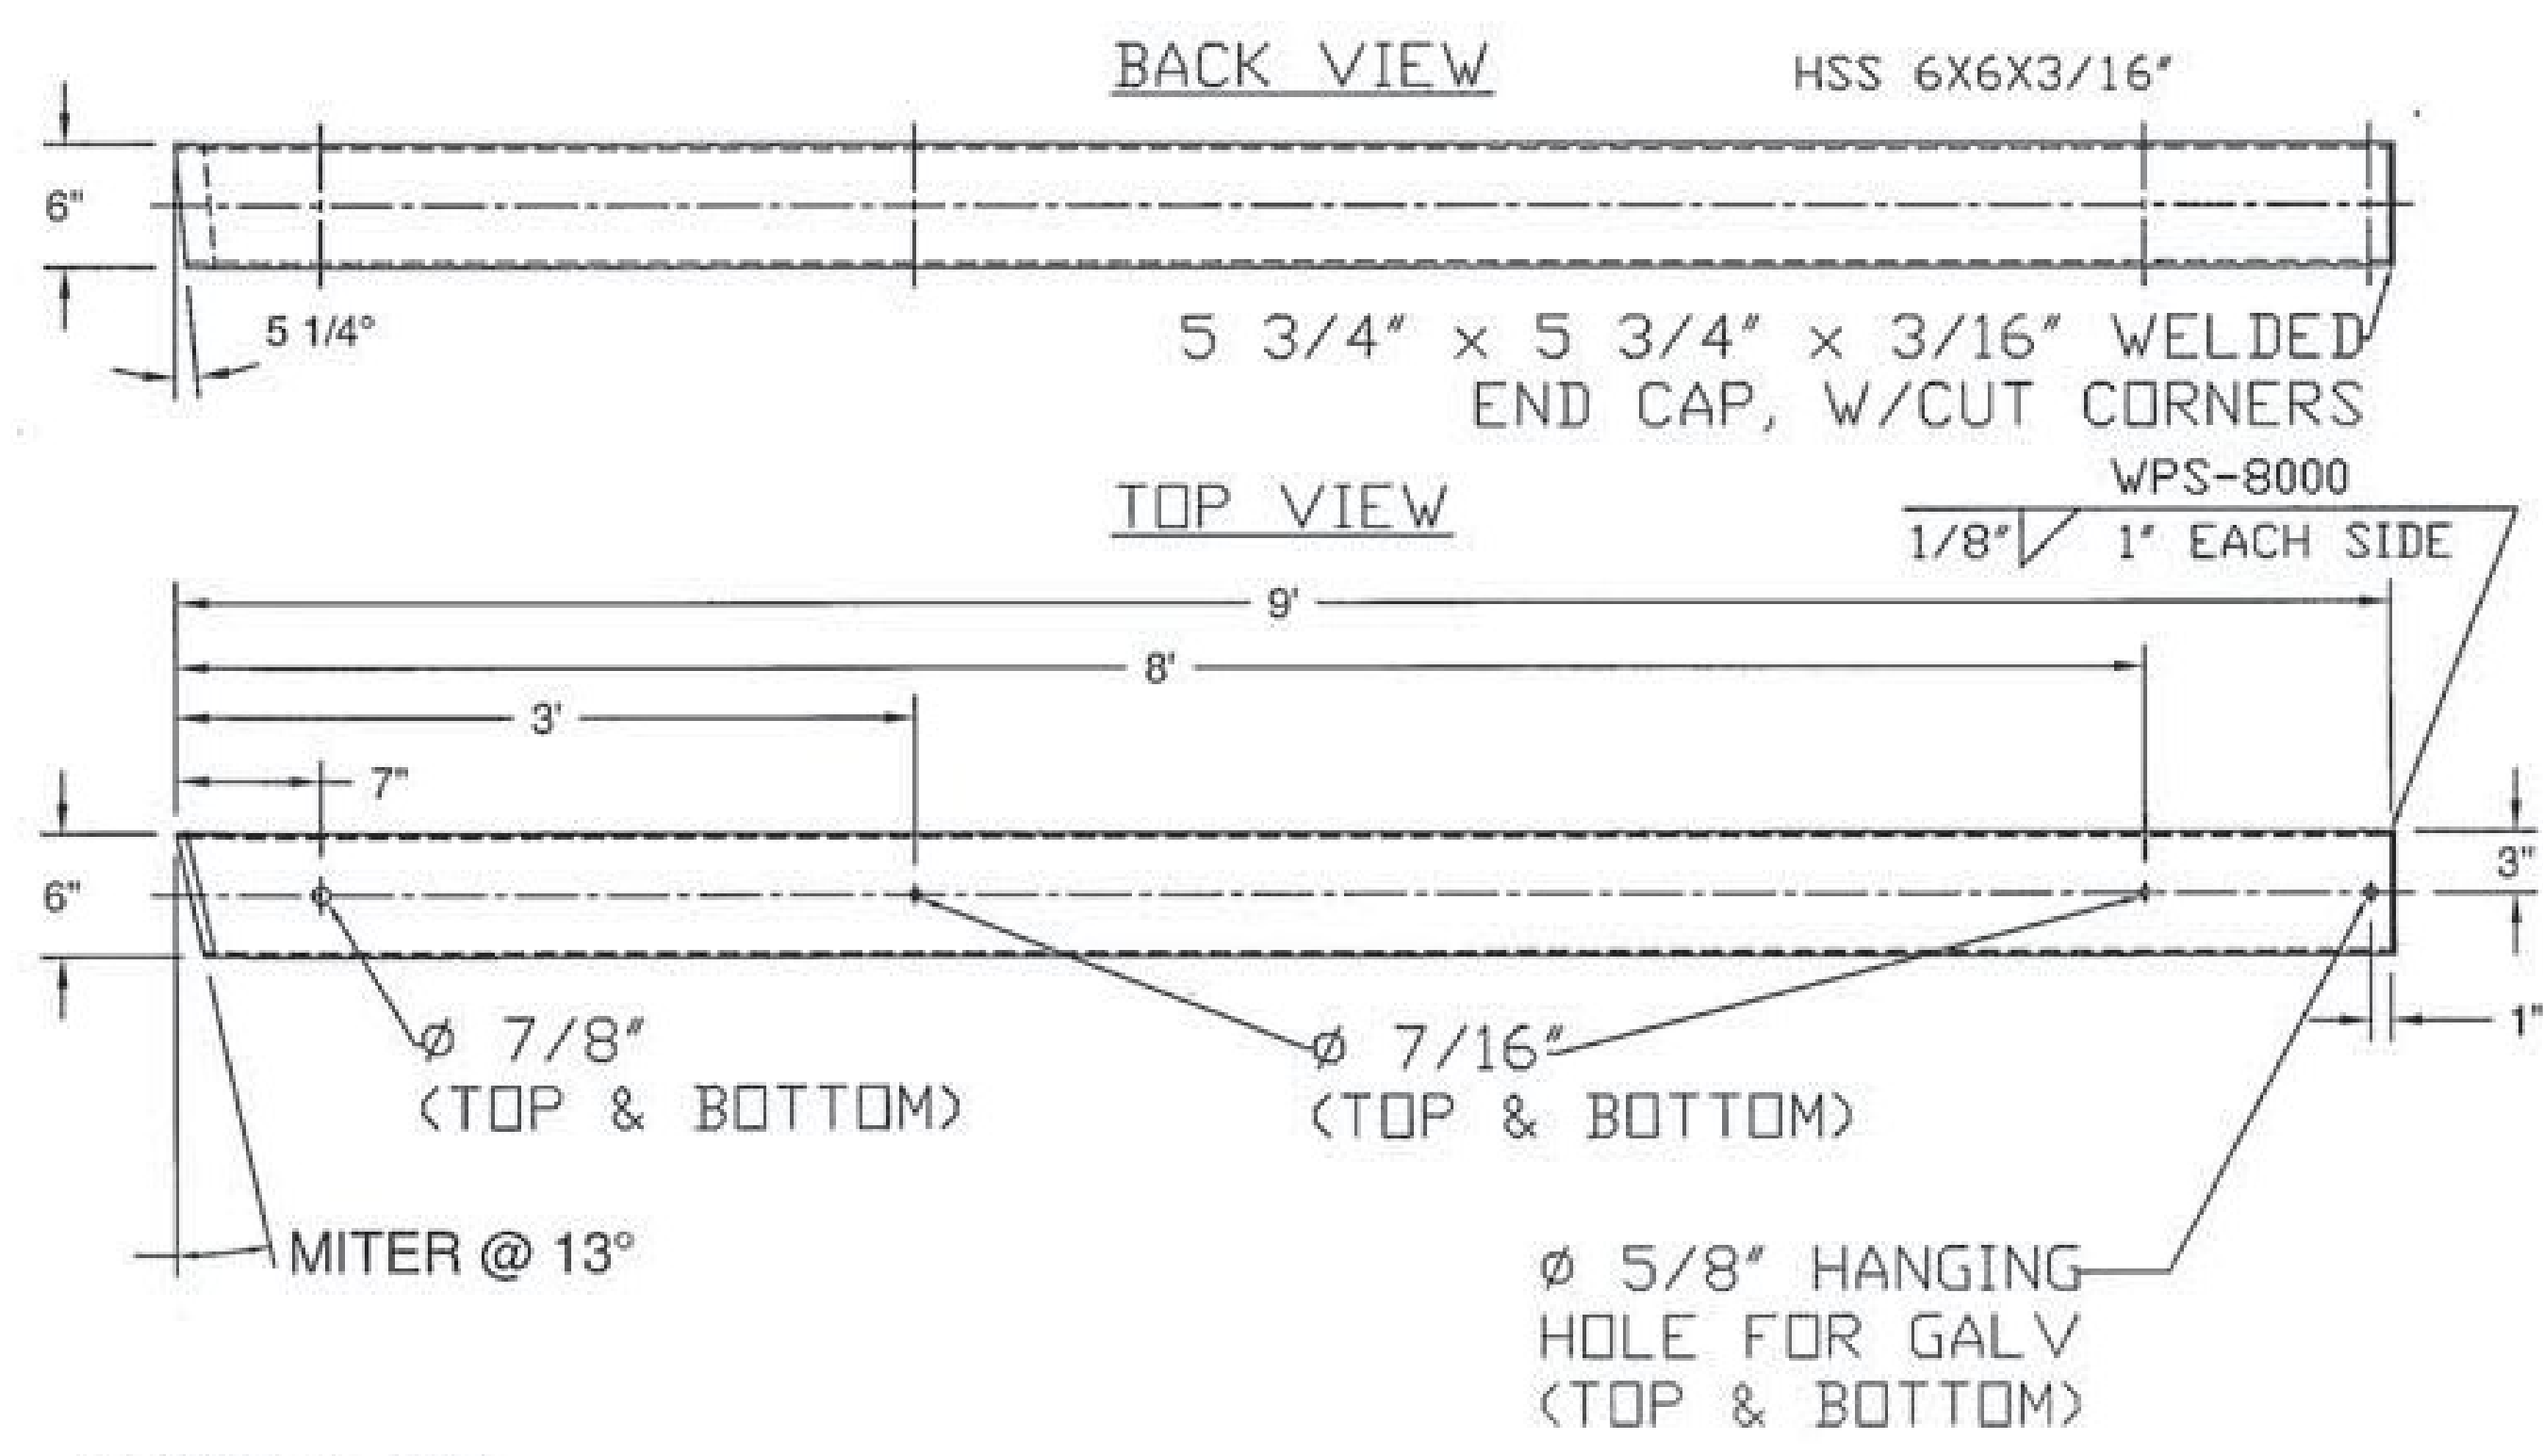

Vermont Agency of Transportation  
**RECEIVED**  
CR'D BY: OK'D BY: Rob Young  
February 15, 2017  
RESUBMIT No: Approved  
BY: Rob Young DATE: 02/22/2017

ITEM #: 621.725  
STRUCTURAL STEEL TO COMPLY W/ ASTM A6  
TOLERANCE UNLESS OTHERWISE NOTED:  
FRACTIONS = ± 1/16"  
ANGLES = ± 1/2"  
DIAMETERS = ± 1/32"

GUARD RAIL TO BRIDGE RAIL TRANSITION DETAILS SHEET  
TH-1, RURAL MAJOR COLLECTOR, FAS ROUTE 0211, BRIDGE # 8  
TOWN OF HUNTINGTON, COUNTY OF CHITTENDEN, VT.

R NO.	DATE	DESCRIPTION	BY	R NO.	DATE	DESCRIPTION	BY
E 1	2/8/17	REVISED PER 12/16/16 MARK-UP	EP				

DRAWN: E.P. 12/14/16  
CHECKED: D.L.  
APPROVED:  
SCALE: SCHEMATIC  
DRAWING NO. F.R.L. HUNTINGTON (22)-T

ELDERLEE, INC.  
OAKS CORNERS, NEW YORK 14518  
email: dlong@elderlee.com / epeek@elderlee.com  
Tel: 315-789-6670 Fax: 315-789-6615