

# STATE OF VERMONT AGENCY OF TRANSPORTATION



## PROPOSED IMPROVEMENT BRIDGE PROJECT


TOWN OF CRAFTSBURY  
COUNTY OF ORLEANS

ROUTE NO : TH-4, RURAL MINOR COLLECTOR, CLASS 2 TOWN HIGHWAY


PROJECT LOCATION: ON TH 4 (CREEK ROAD), BRIDGE 4 OVER WHITNEY BROOK APPROXIMATELY 0.9 MILES NORTH OF ITS JUNCTION WITH TH 33 (KETCHUM HILL ROAD)

PROJECT DESCRIPTION: REPLACEMENT OF THE EXISTING BRIDGE (BRIDGE NO. 4) INCLUDING MINOR APPROACH WORK

LENGTH OF STRUCTURE: 88.19 FEET  
LENGTH OF ROADWAY: 186.81 FEET  
LENGTH OF PROJECT: 275.00 FEET

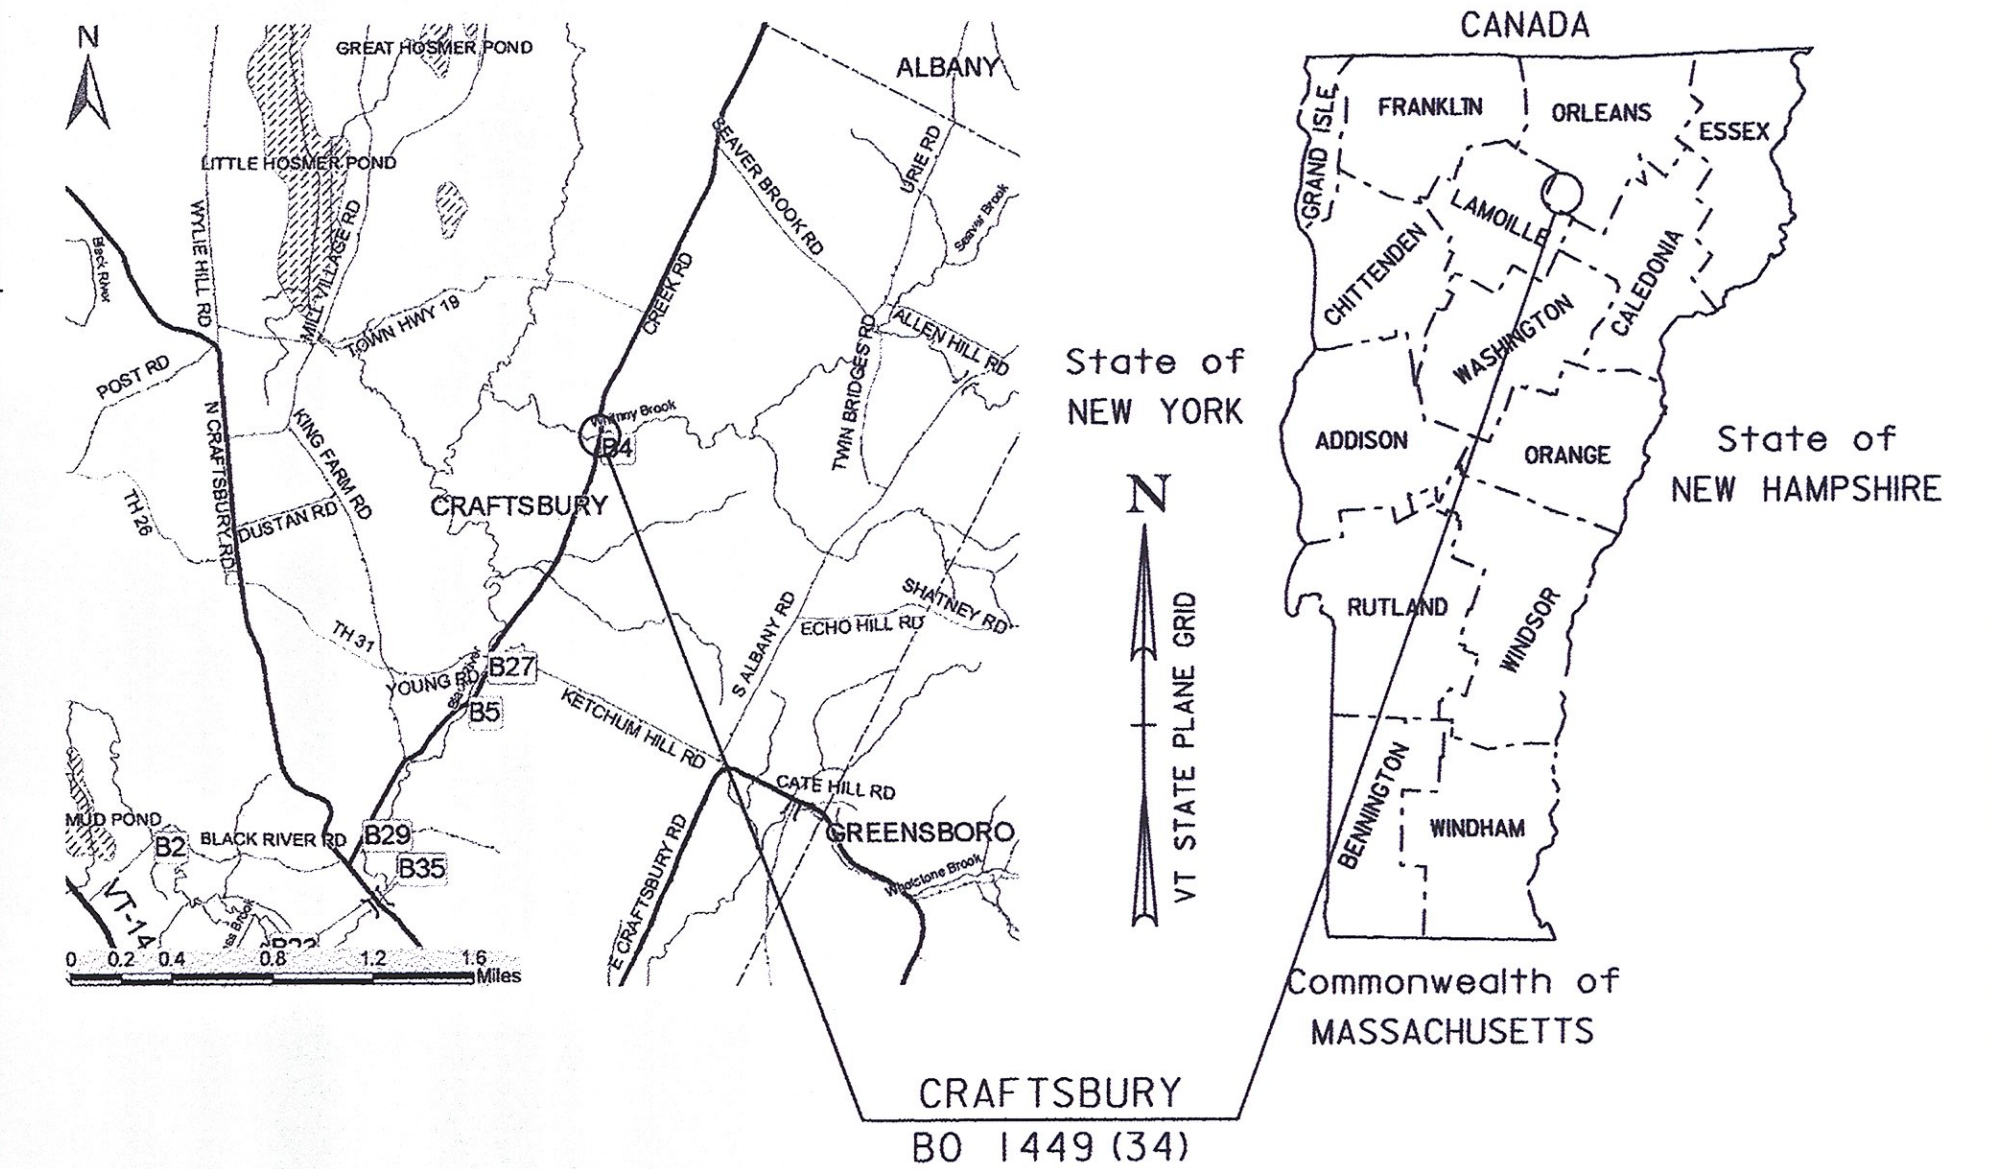

RECORD PLANS	
CONTRACTOR:	CCS CONSTRUCTORS LLC- MORRISVILLE, VT
RESIDENT ENGINEER:	SETH HISMAN
CONSTRUCTION BEGAN:	JULY 11, 2016
CONSTRUCTION COMPLETE:	SEPTEMBER 29, 2016
RECORD PLANS BY:	SETH HISMAN & JESSE IVES
I HEREBY CERTIFY THAT ALL THE CONSTRUCTION REQUIRED BY THIS SET OF DRAWINGS HAS BEEN ACCOMPLISHED AS INDICATED HEREIN.	
BY	RESIDENT ENGINEER
DATE 11/01/18	
NOTE: Any further information concerning final quantities, amounts or other details relative to this project may be found at Central Files in the electronic archives.	

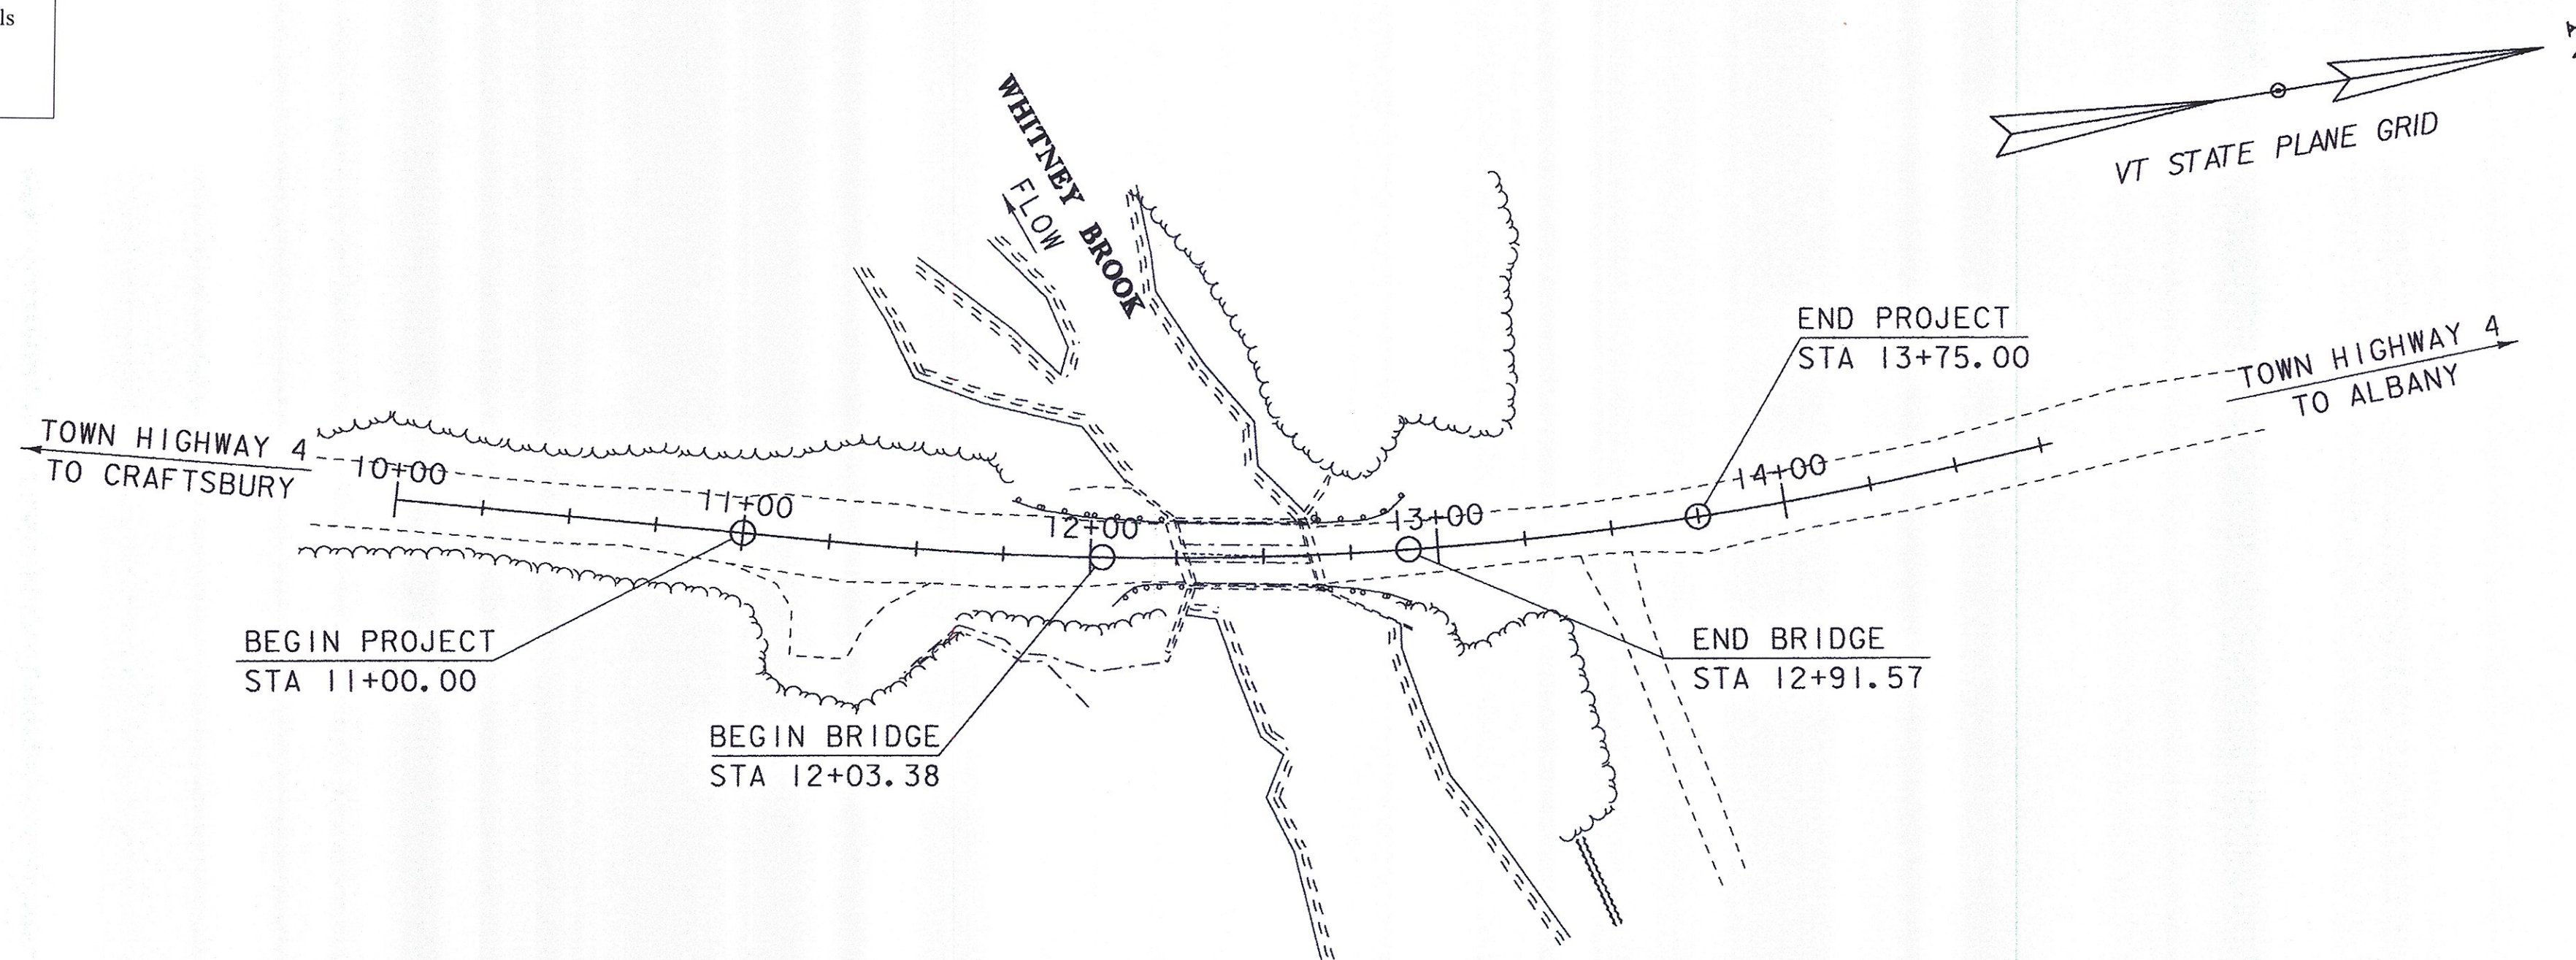

CONSTRUCTION IS TO BE CARRIED ON IN ACCORDANCE WITH THESE PLANS AND THE STANDARD SPECIFICATIONS FOR CONSTRUCTION DATED 2011, AS APPROVED BY THE FEDERAL HIGHWAY ADMINISTRATION ON JULY 20, 2011 FOR USE ON THIS PROJECT, INCLUDING ALL SUBSEQUENT REVISIONS AND SUCH REVISED SPECIFICATIONS AND SPECIAL PROVISIONS AS ARE INCORPORATED IN THESE PLANS.

QUALITY ASSURANCE PROGRAM : LEVEL 2	
SURVEYED BY :	R. GILMAN
SURVEYED DATE :	05/28/2013
DATUM	
VERTICAL	NAVD88
HORIZONTAL	NAD 83 (CONUS)

SCALE 1" = 40'-0"  
40 0 40

BUILT AS DESIGNED

DIRECTOR OF PROJECT DELIVERY	
APPROVED	DATE 10/19/18
PROJECT MANAGER : R. YOUNG	
PROJECT NAME :	CRAFTSBURY
PROJECT NUMBER :	BO 1449 (34)
SHEET 1 OF 42 SHEETS	