


SUPERSTRUCTURE PLAN

SCALE 1/4" = 1'-0"

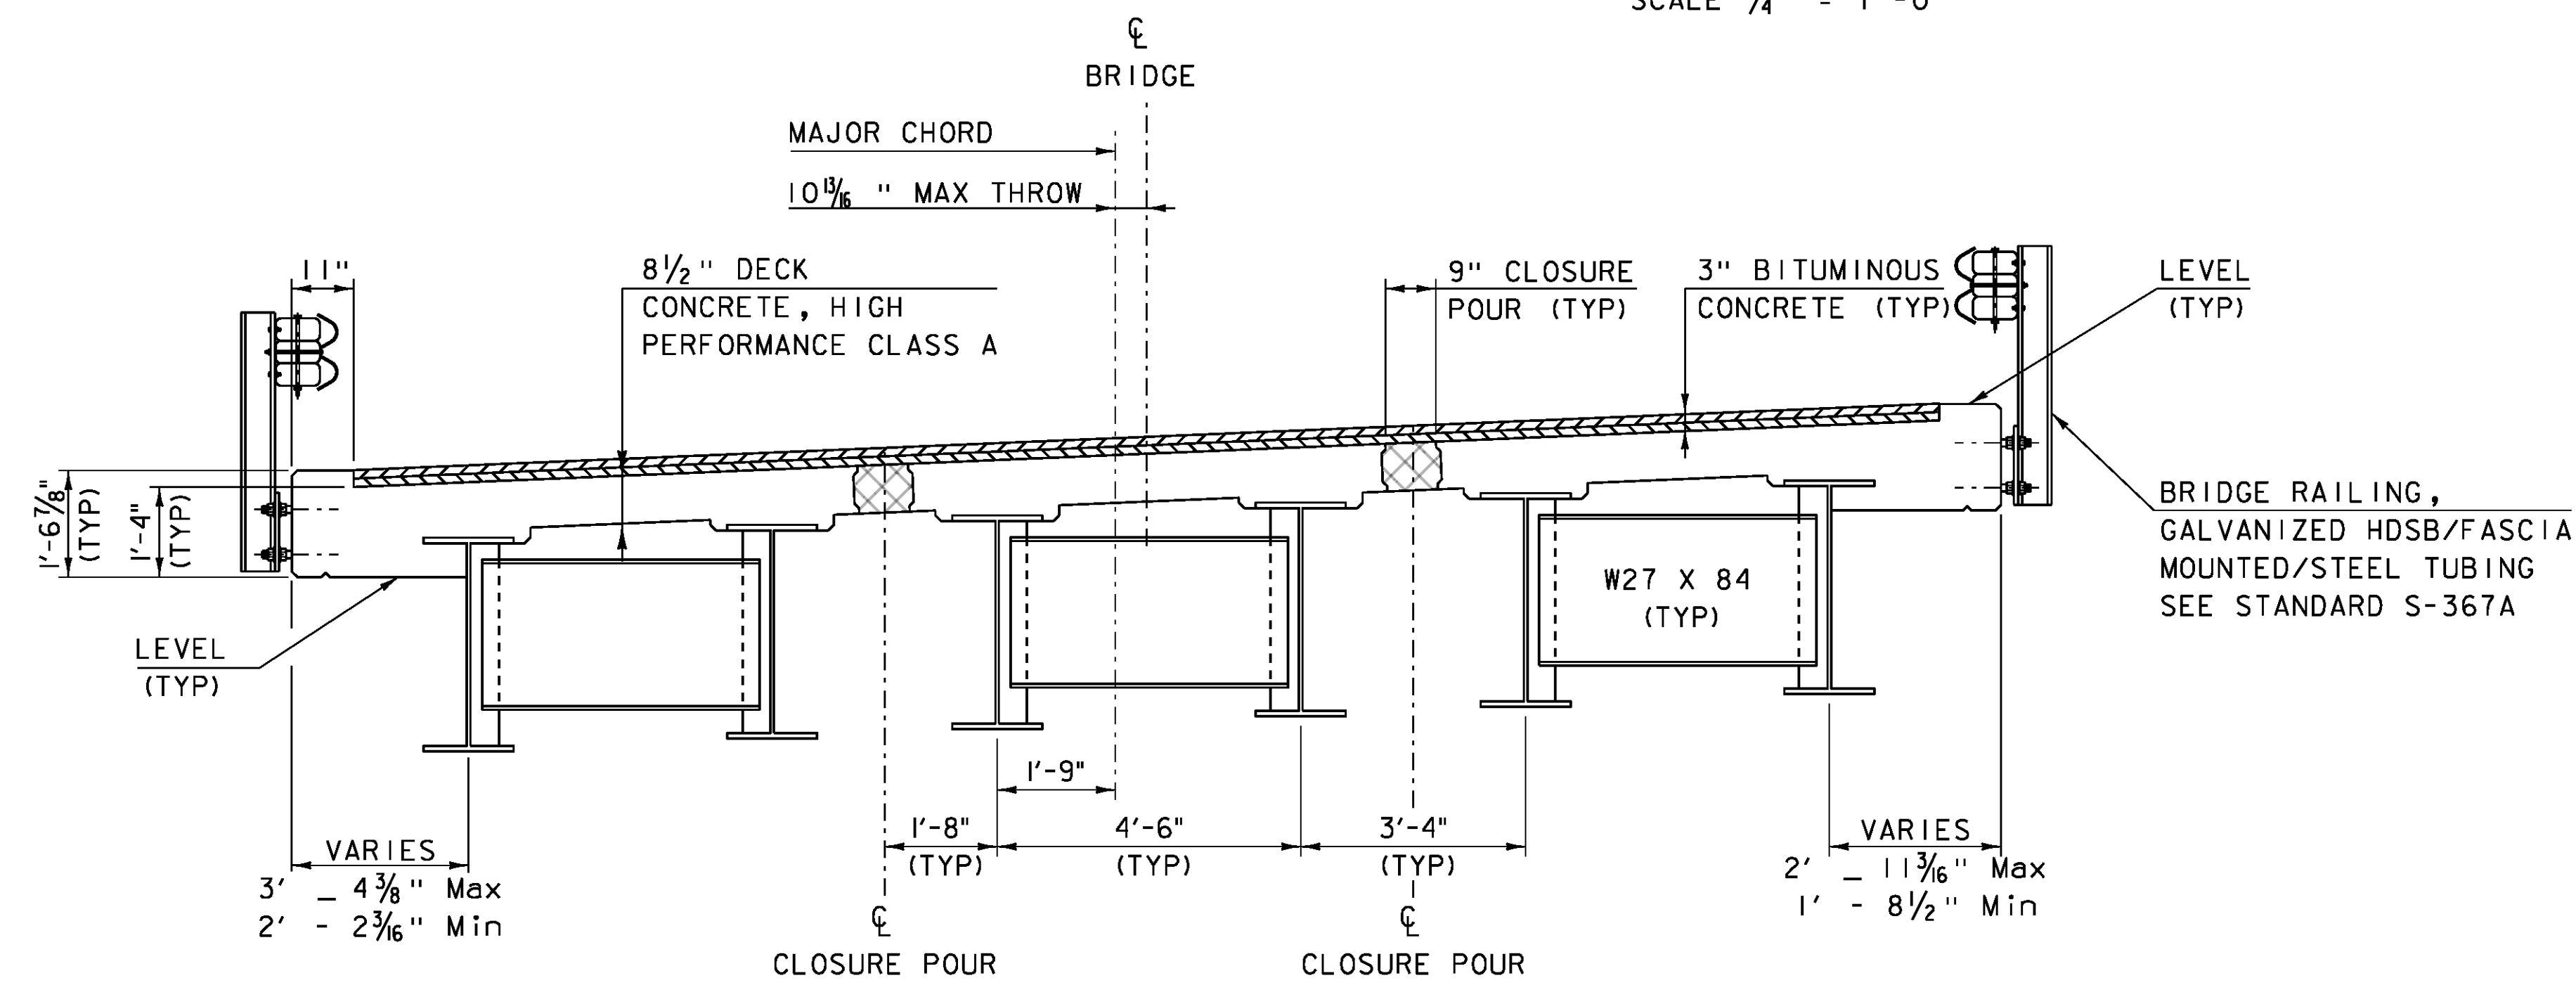

BRIDGE TYPICAL SECTION

SCALE 1/2" = 1'-0"

- SPECIAL PROVISION (HIGH PERFORMANCE CONCRETE, RAPID SET)
- BITUMINOUS CONCRETE PAVEMENT

PROJECT NAME: CRAFTSBURY	PLOT DATE: 14-OCT-2015
PROJECT NUMBER: BO 1449(34)	DRAWN BY: W. LAMMER
FILE NAME: s13j100sup.dgn	CHECKED BY: S. COLEY
PROJECT LEADER: R. YOUNG	SHEET 17 OF 42
DESIGNED BY: W. LAMMER	
SUPERSTRUCTURE PLAN	