


**CLOSURE POUR PLAN**

SCALE 1/2" = 1'-0

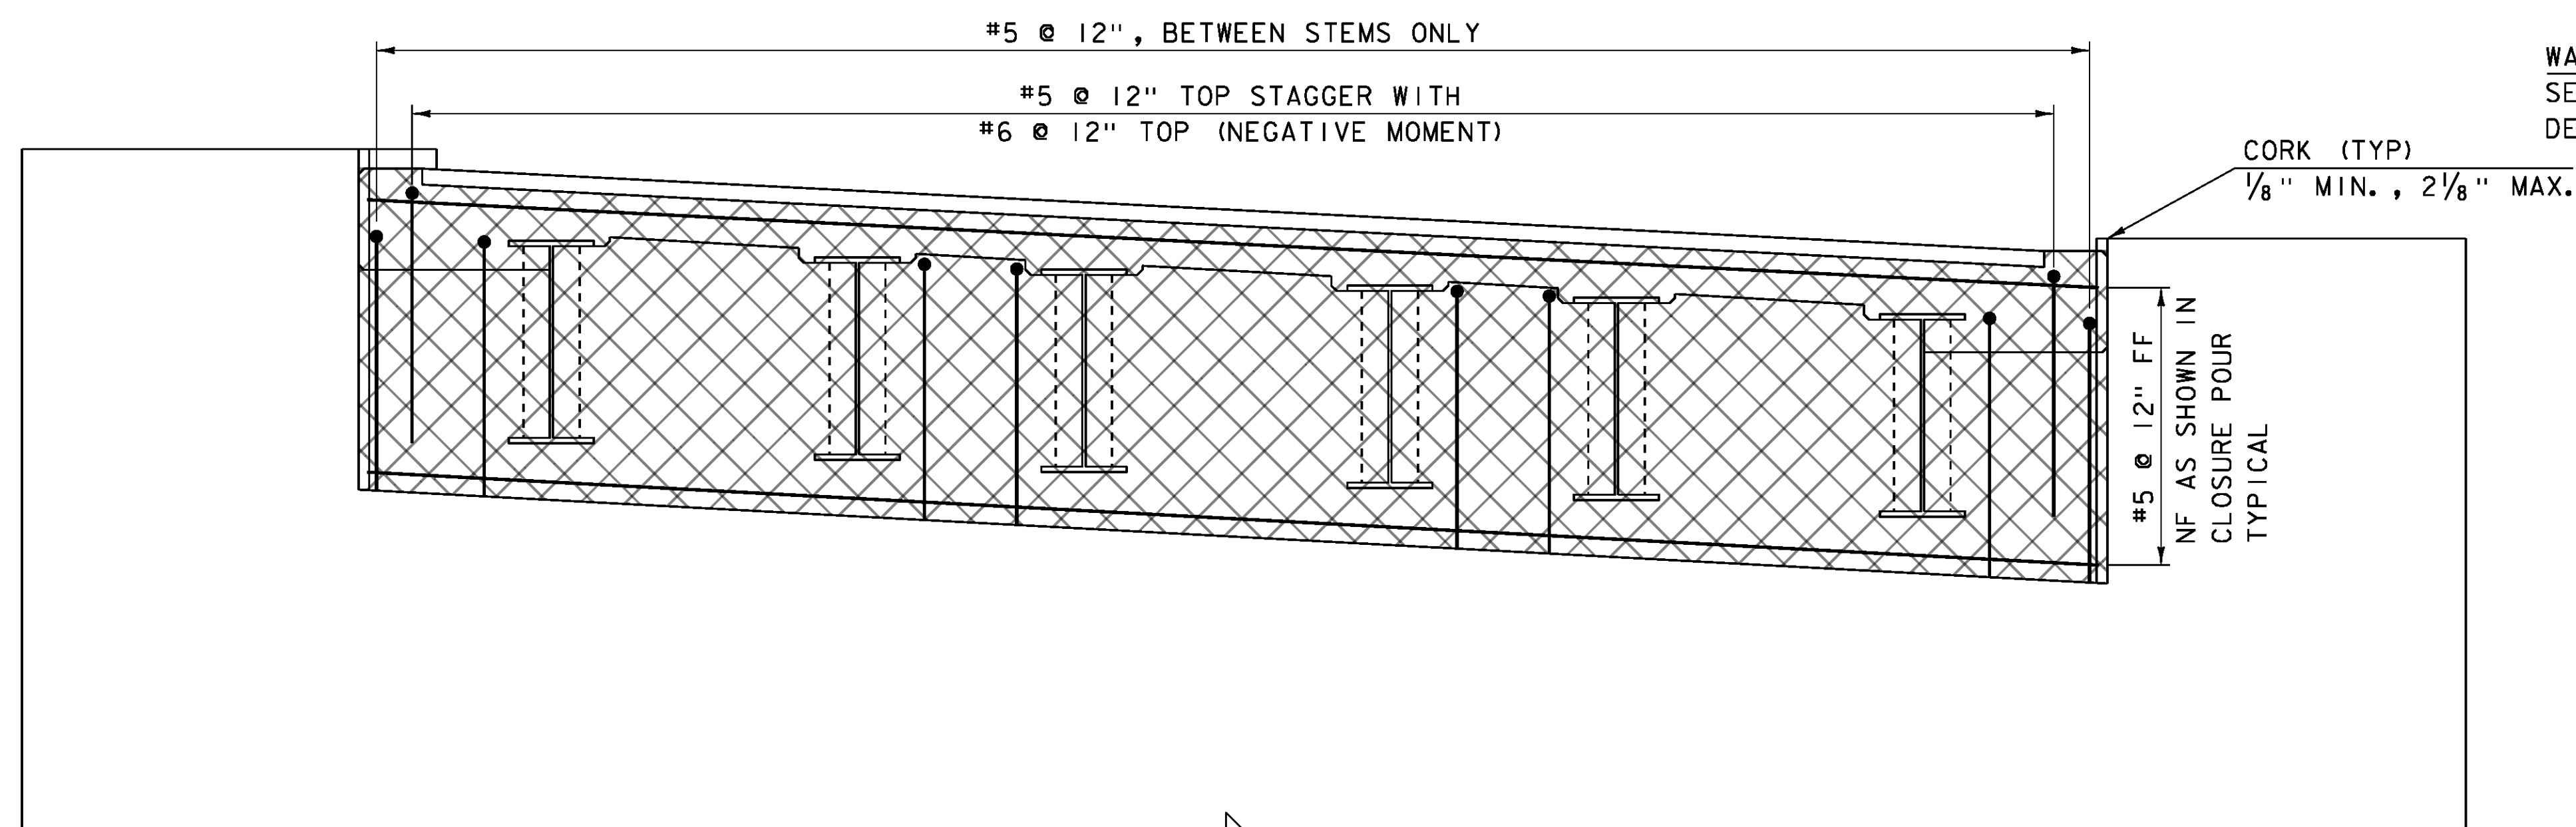


**CLOSURE POUR ELEVATION**

SCALE 1/2" = 1'-0

**NOTE:**

- NF = NEAR FACE
- FF = FAR FACE
- EF = EACH FACE
- ▲ = CUT TO FIT IN FIELD
- 3" CLEAR, UNLESS OTHERWISE SPECIFIED ON THE PLANS.
- 2'-2" BAR LAP UNLESS OTHERWISE SPECIFIED ON THE PLANS.

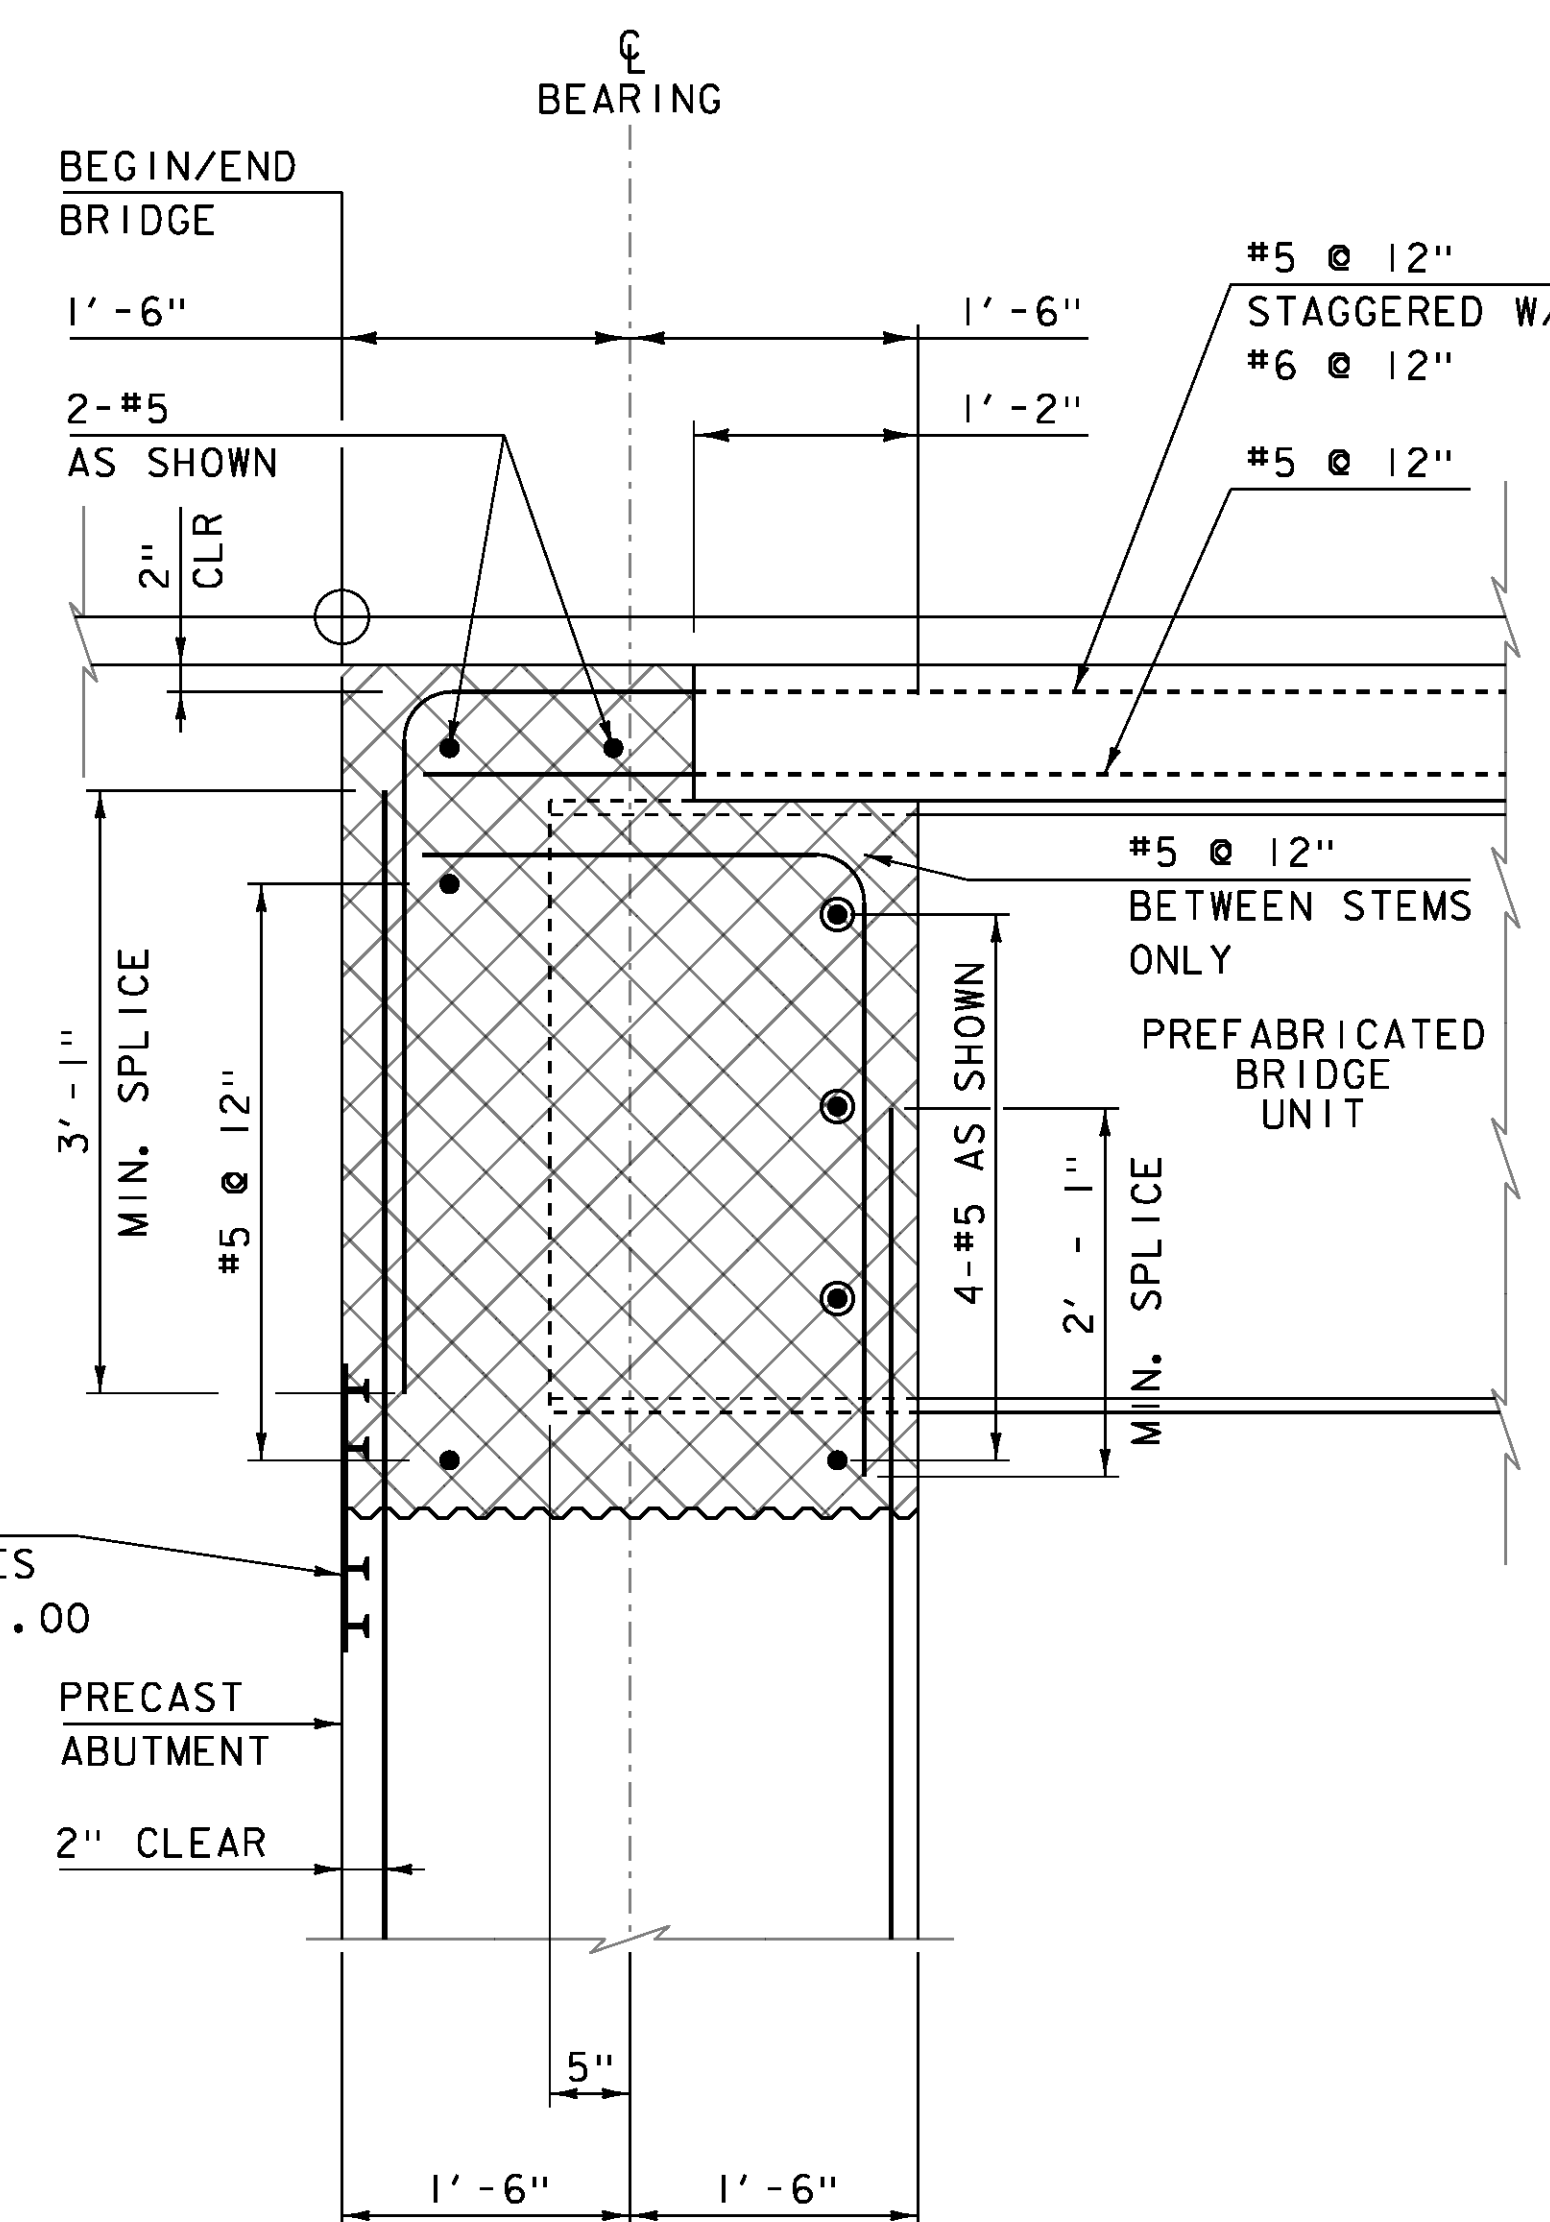

**CLOSURE POUR TYPICAL**

SCALE 1" = 1'-0

**NOTE:**

1. ABUTMENT 1 REINFORCING SHOWN. ABUTMENT 2 REINFORCING SIMILAR.
2. SEE ABUTMENT REINFORCING FOR ADDITIONAL REINFORCING IN THE CLOSURE POUR.

PROJECT NAME: CRAFTSBURY	PLOT DATE: 14-OCT-2015
PROJECT NUMBER: BO 1449(34)	DRAWN BY: W. LAMMER
FILE NAME: s13j100sub.dgn	CHECKED BY: S. COLEY
PROJECT LEADER: R. YOUNG	SHEET 23 OF 42
DESIGNED BY: W. LAMMER	
ABUTMENT CLOSURE POUR DETAILS	