



10+25

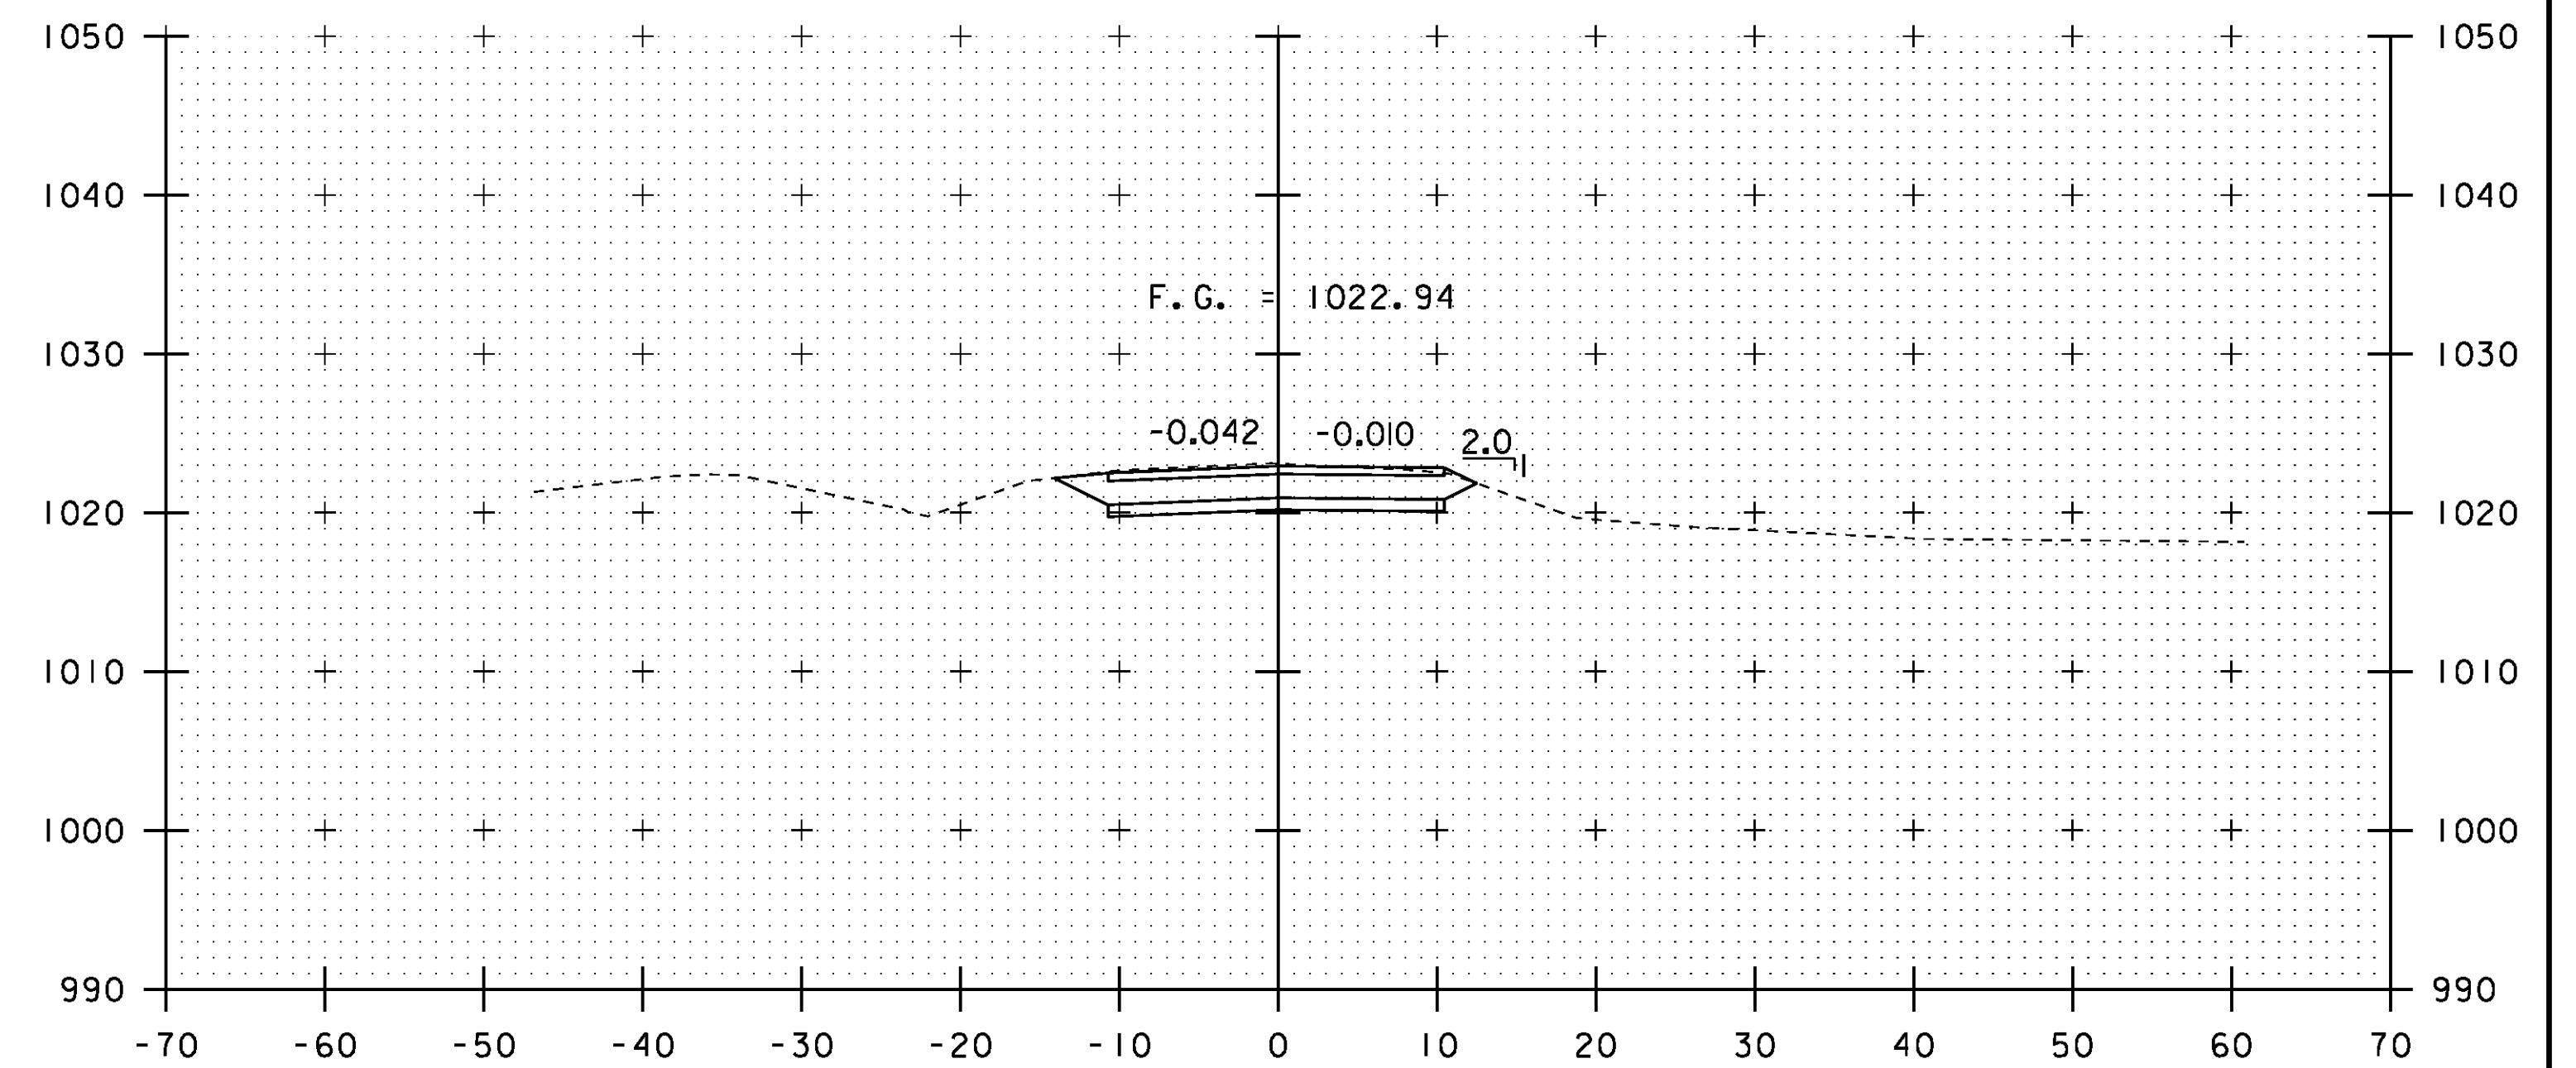


10+75

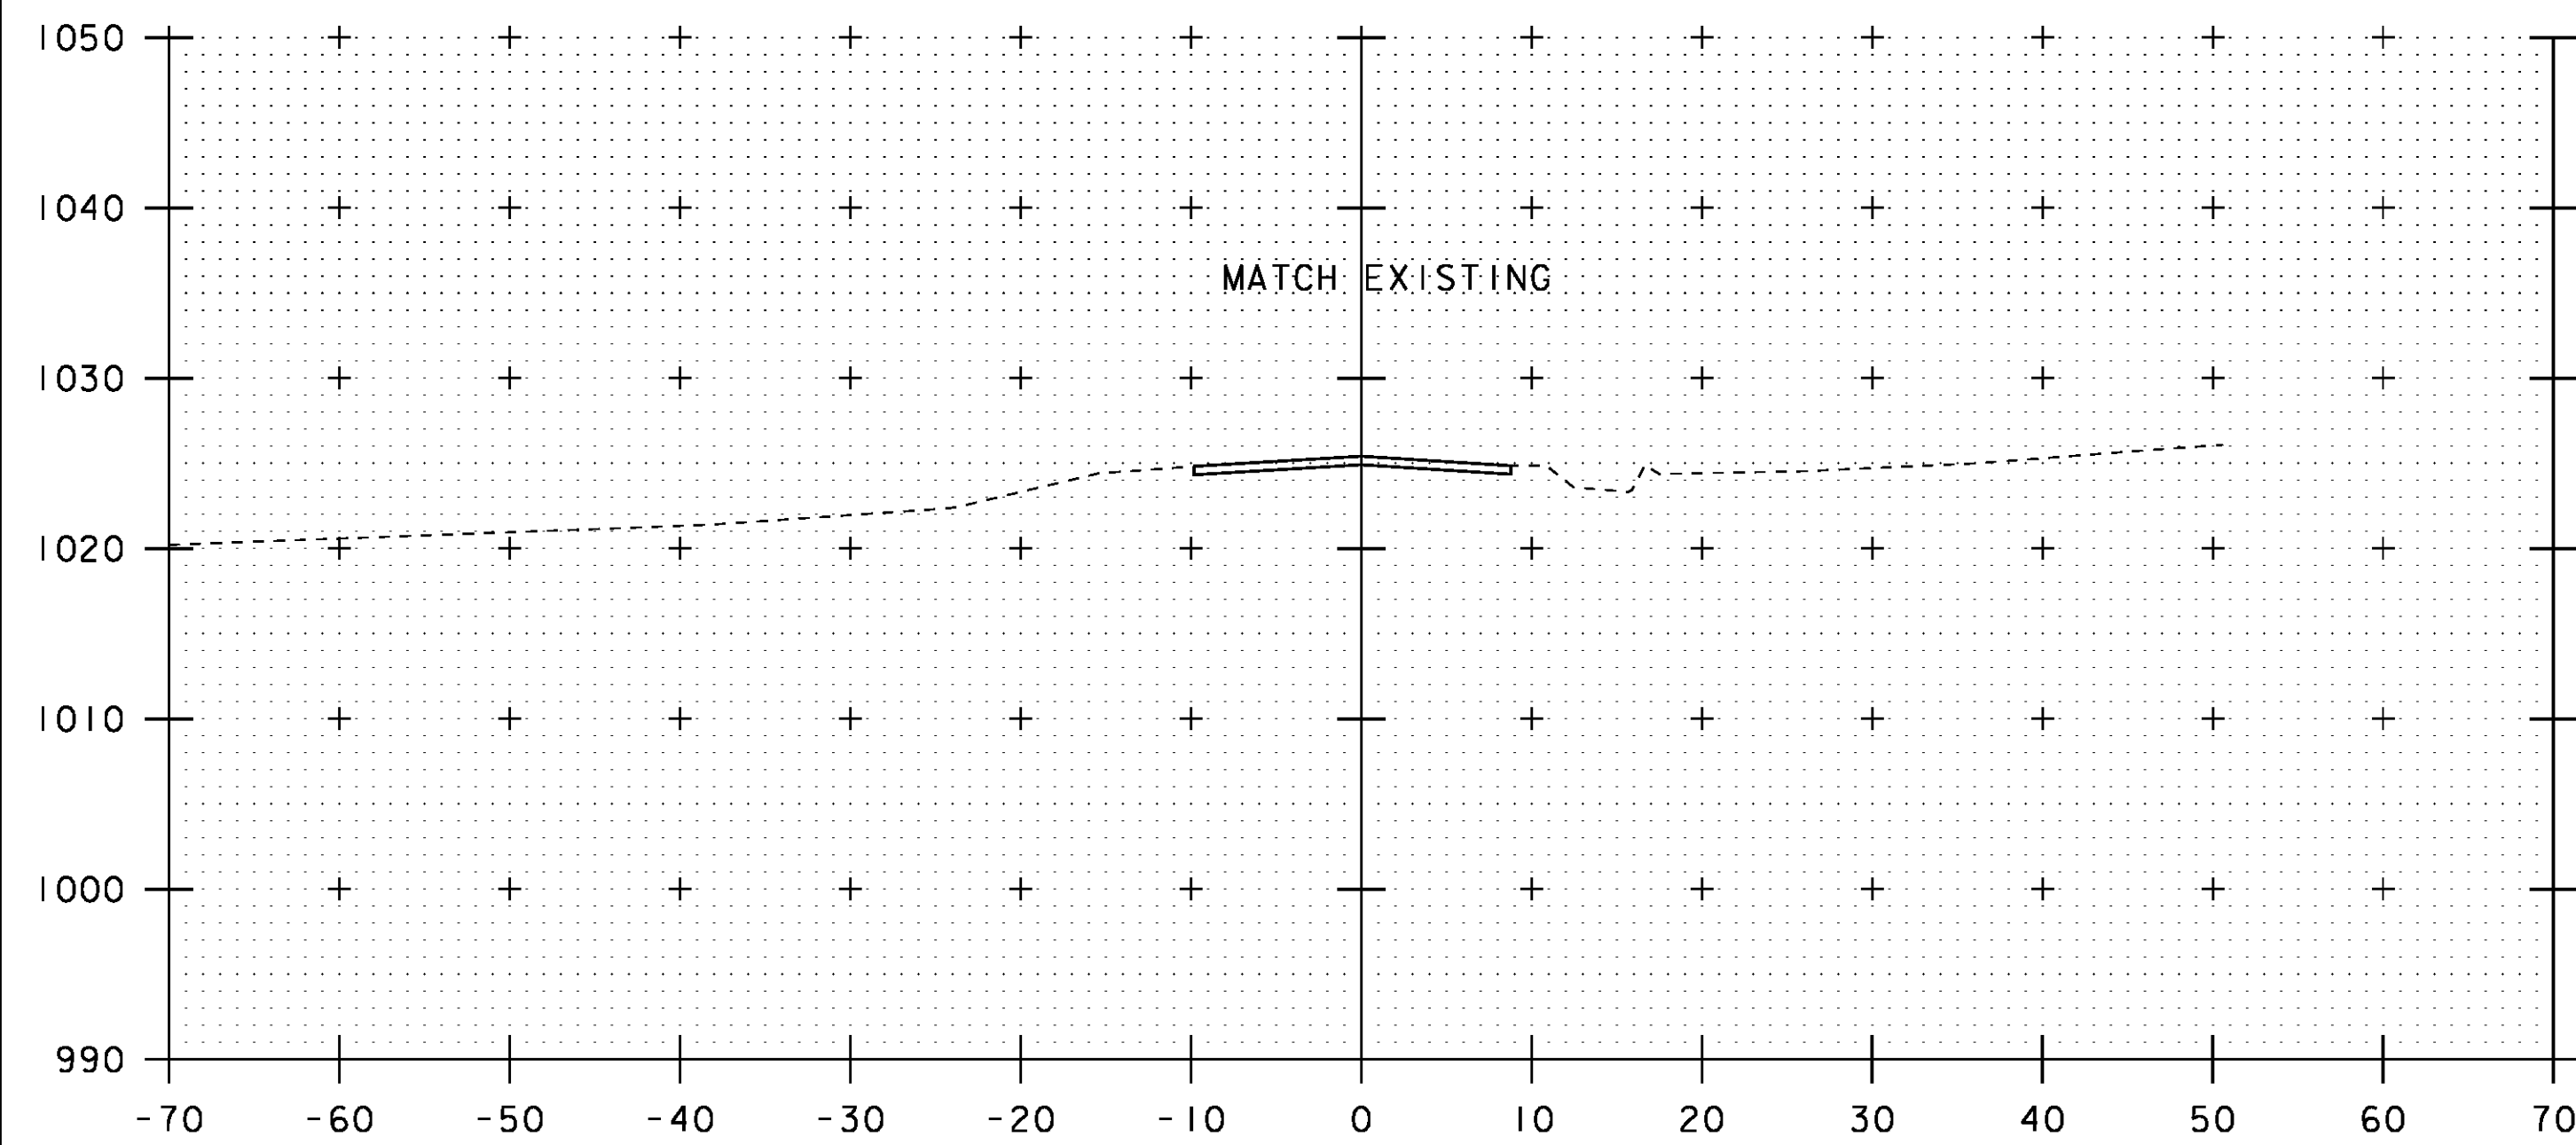

10+00

STA 10+00.00
BEGIN APPROACH

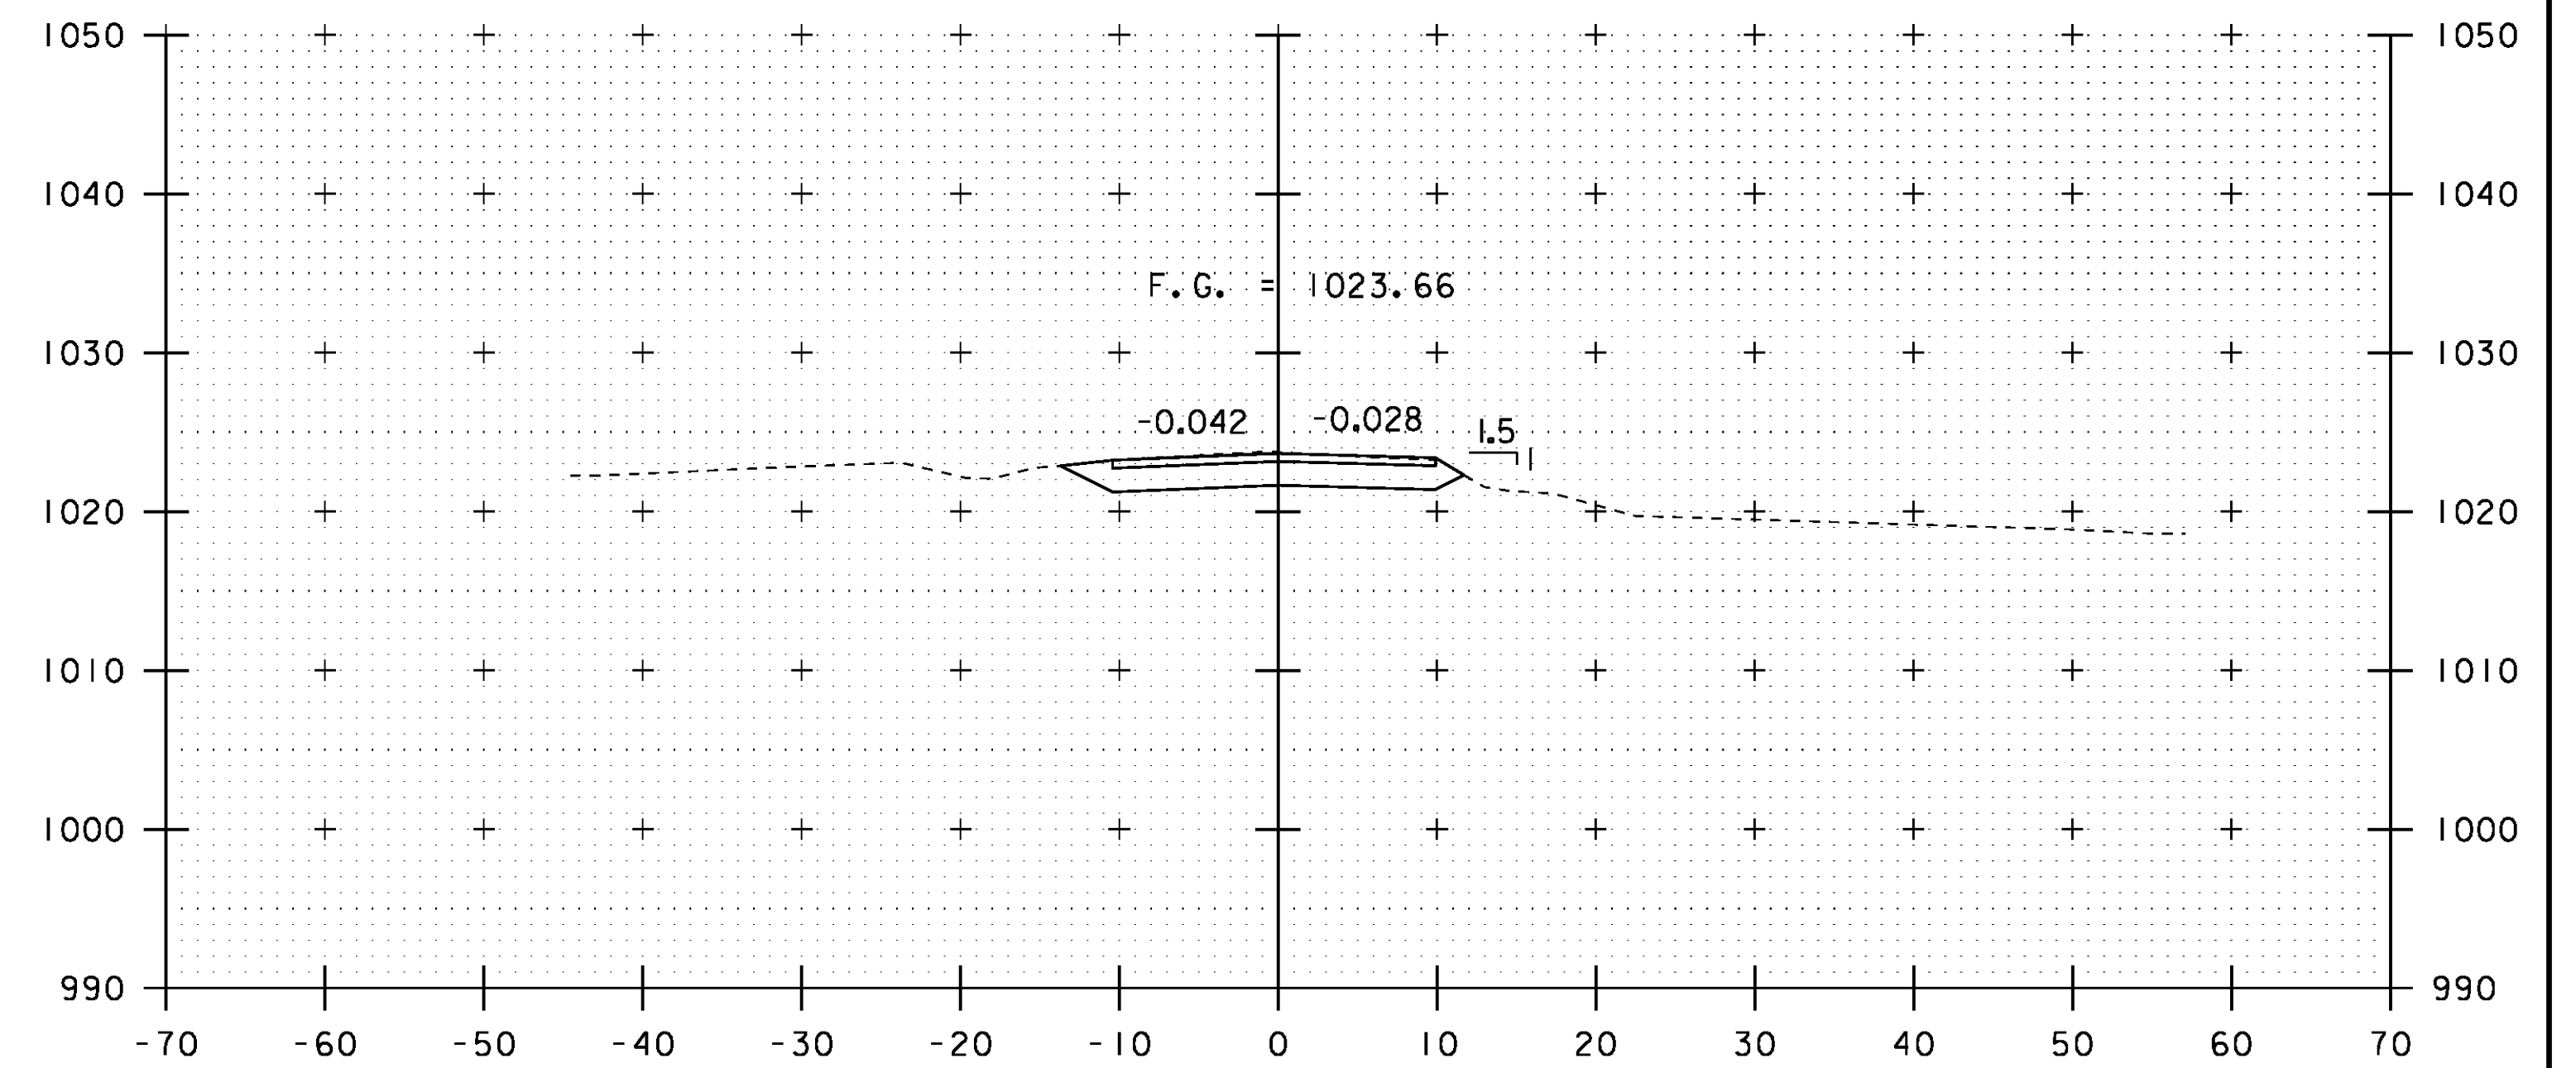

10+50

PROJECT NAME:	CRAFTSBURY
PROJECT NUMBER:	BO 1449(34)
FILE NAME:	s13j100xs.dgn
PROJECT LEADER:	R. YOUNG
DESIGNED BY:	W. LAMMER
MAINLINE CROSS SECTIONS 1	
PLOT DATE:	14-OCT-2015
DRAWN BY:	S. COLEY
CHECKED BY:	W. LAMMER
SHEET	25 OF 42

STA. 10+00 TO STA. 10+75