



11+25

STA 11+28.50 RT  
RECONSTRUCT 12' DRIVE (PULL-OFF AREA)

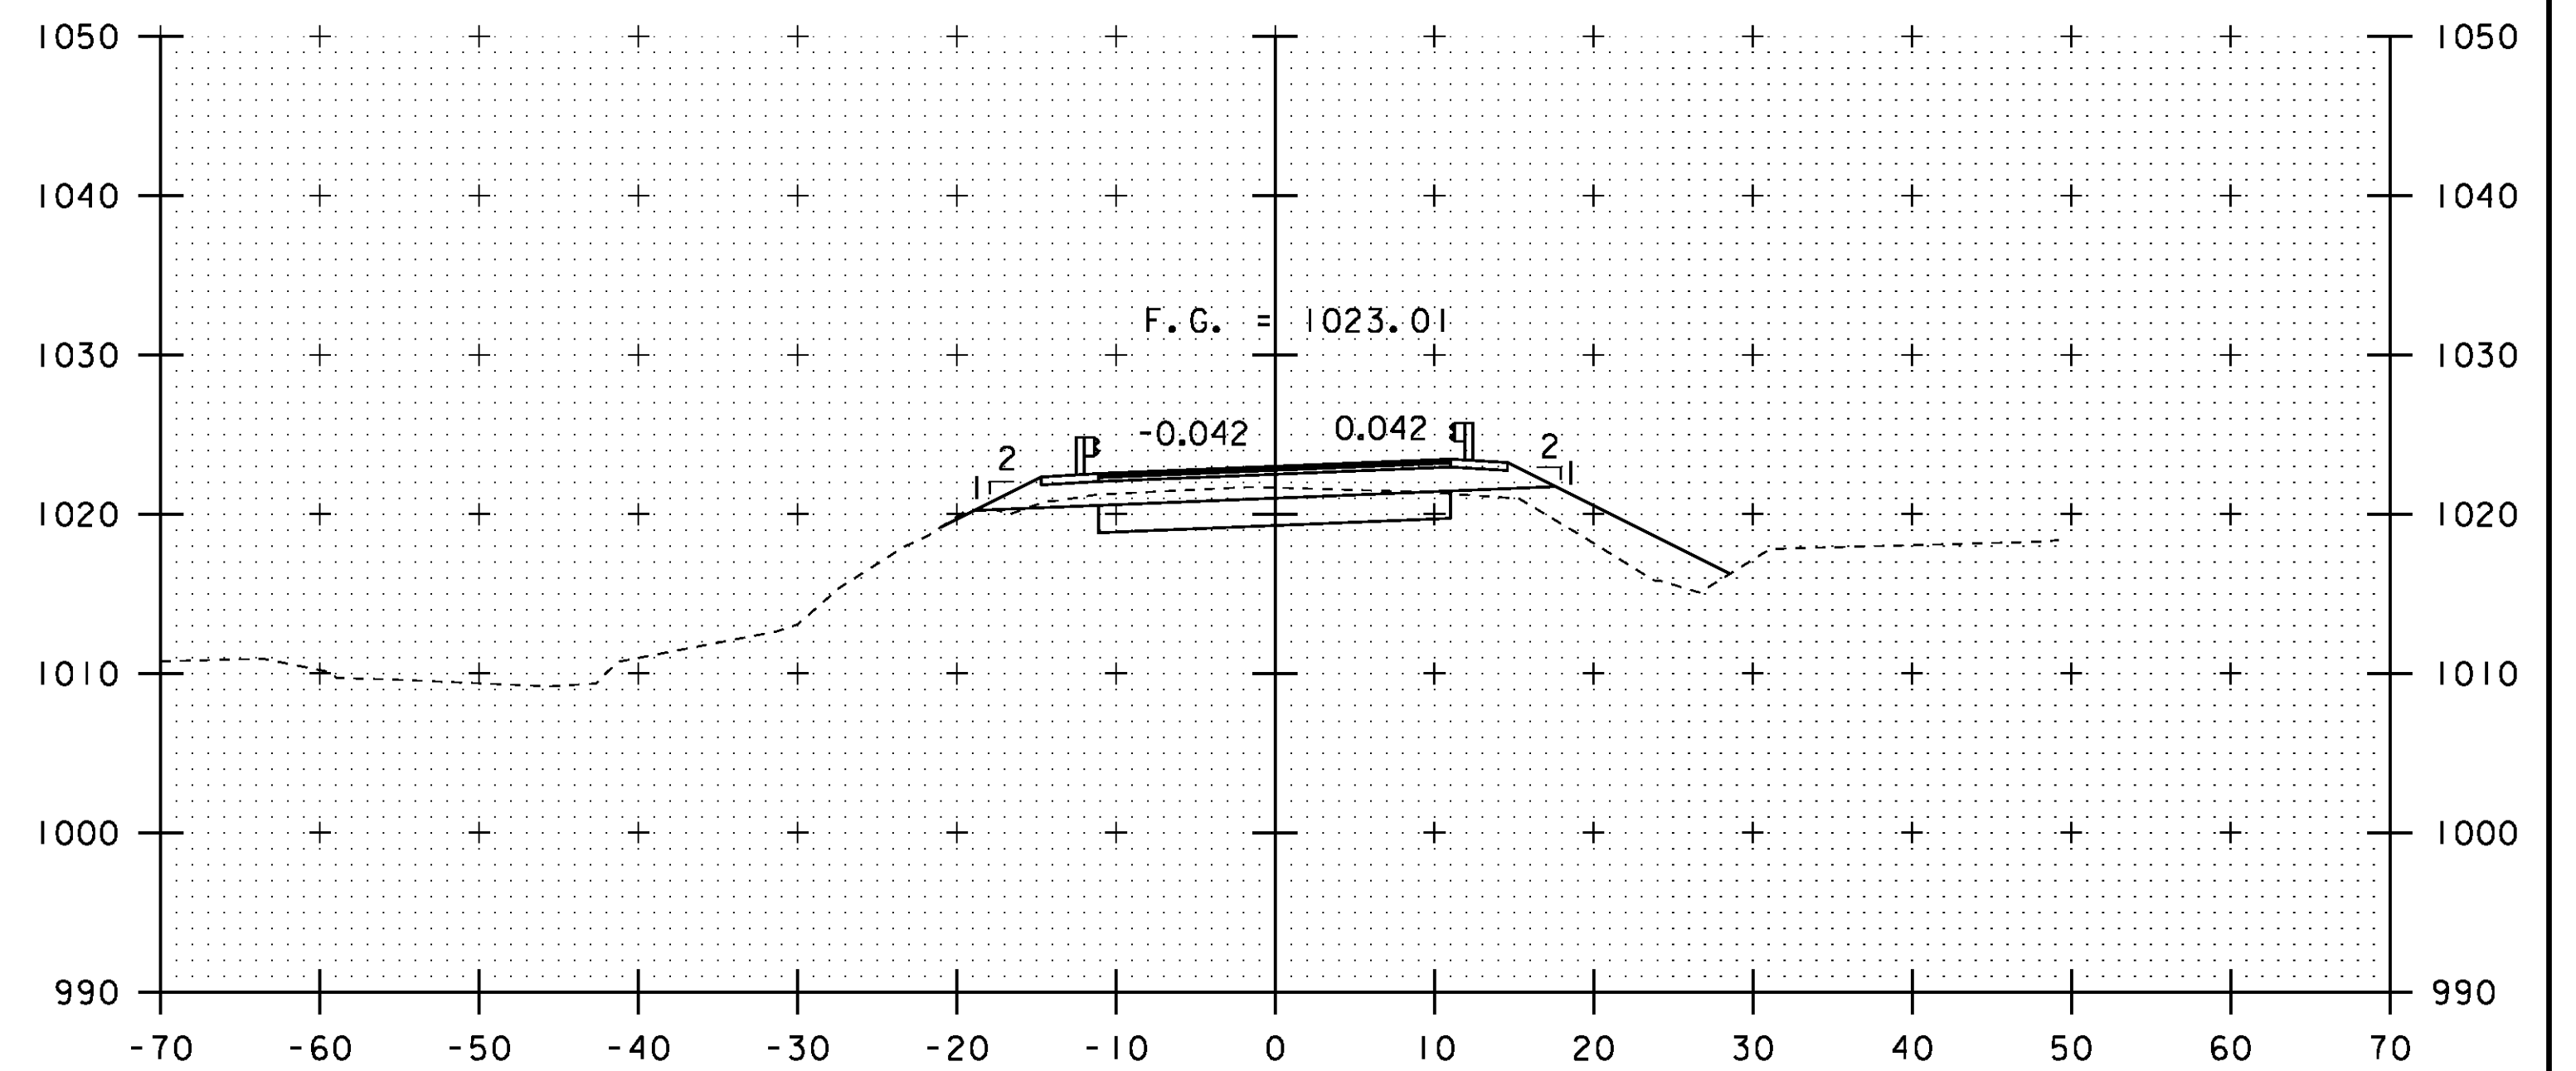


11+75

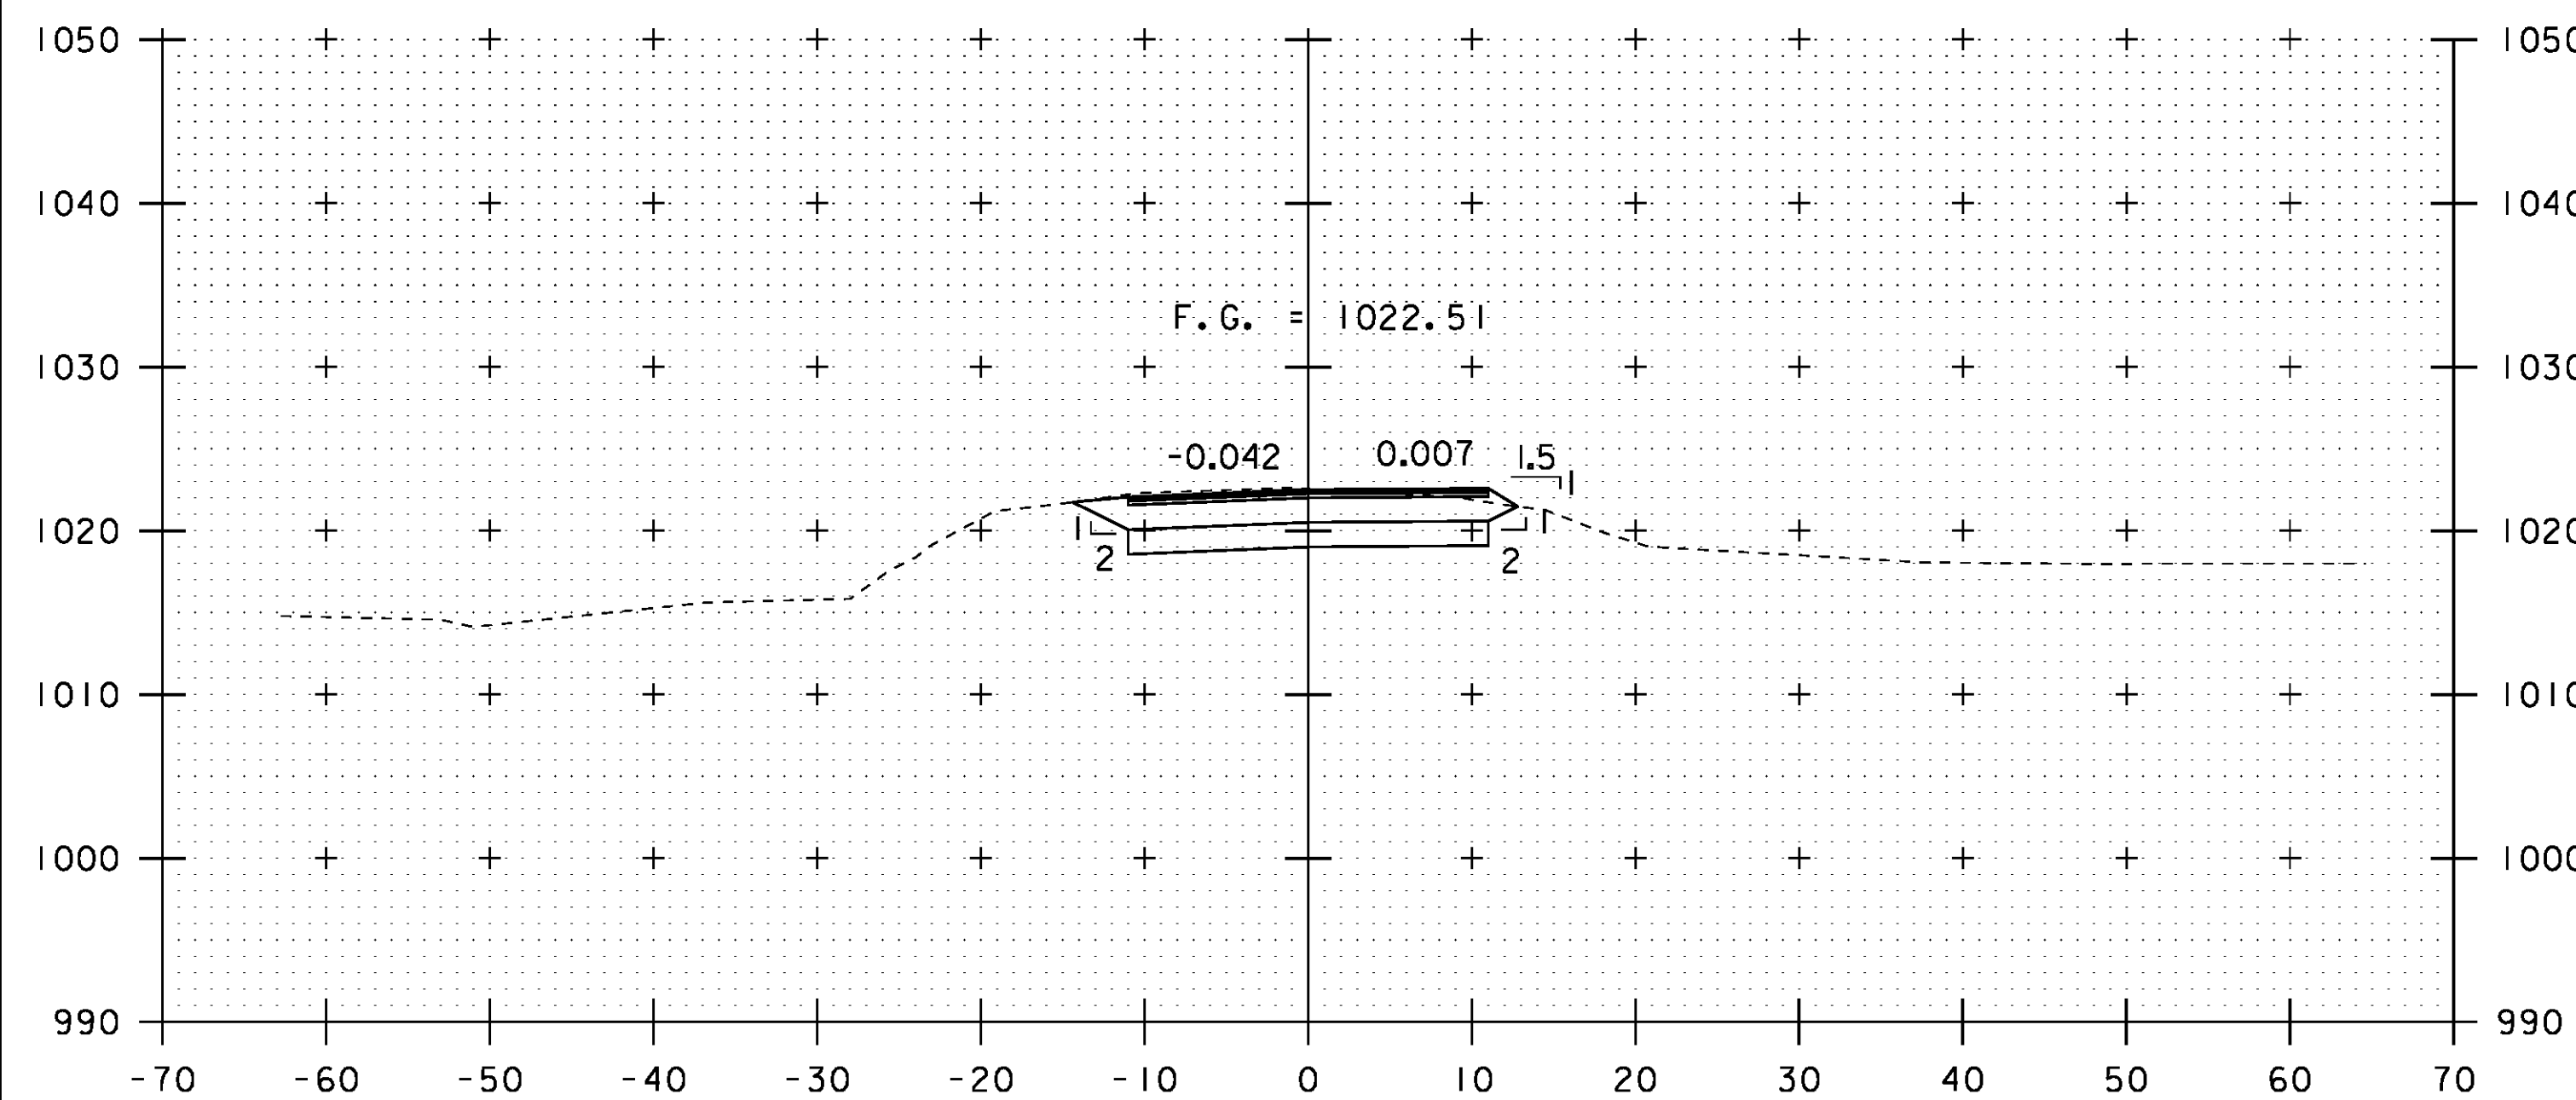

11+00

STA 11+00.00  
BEGIN PROJECT

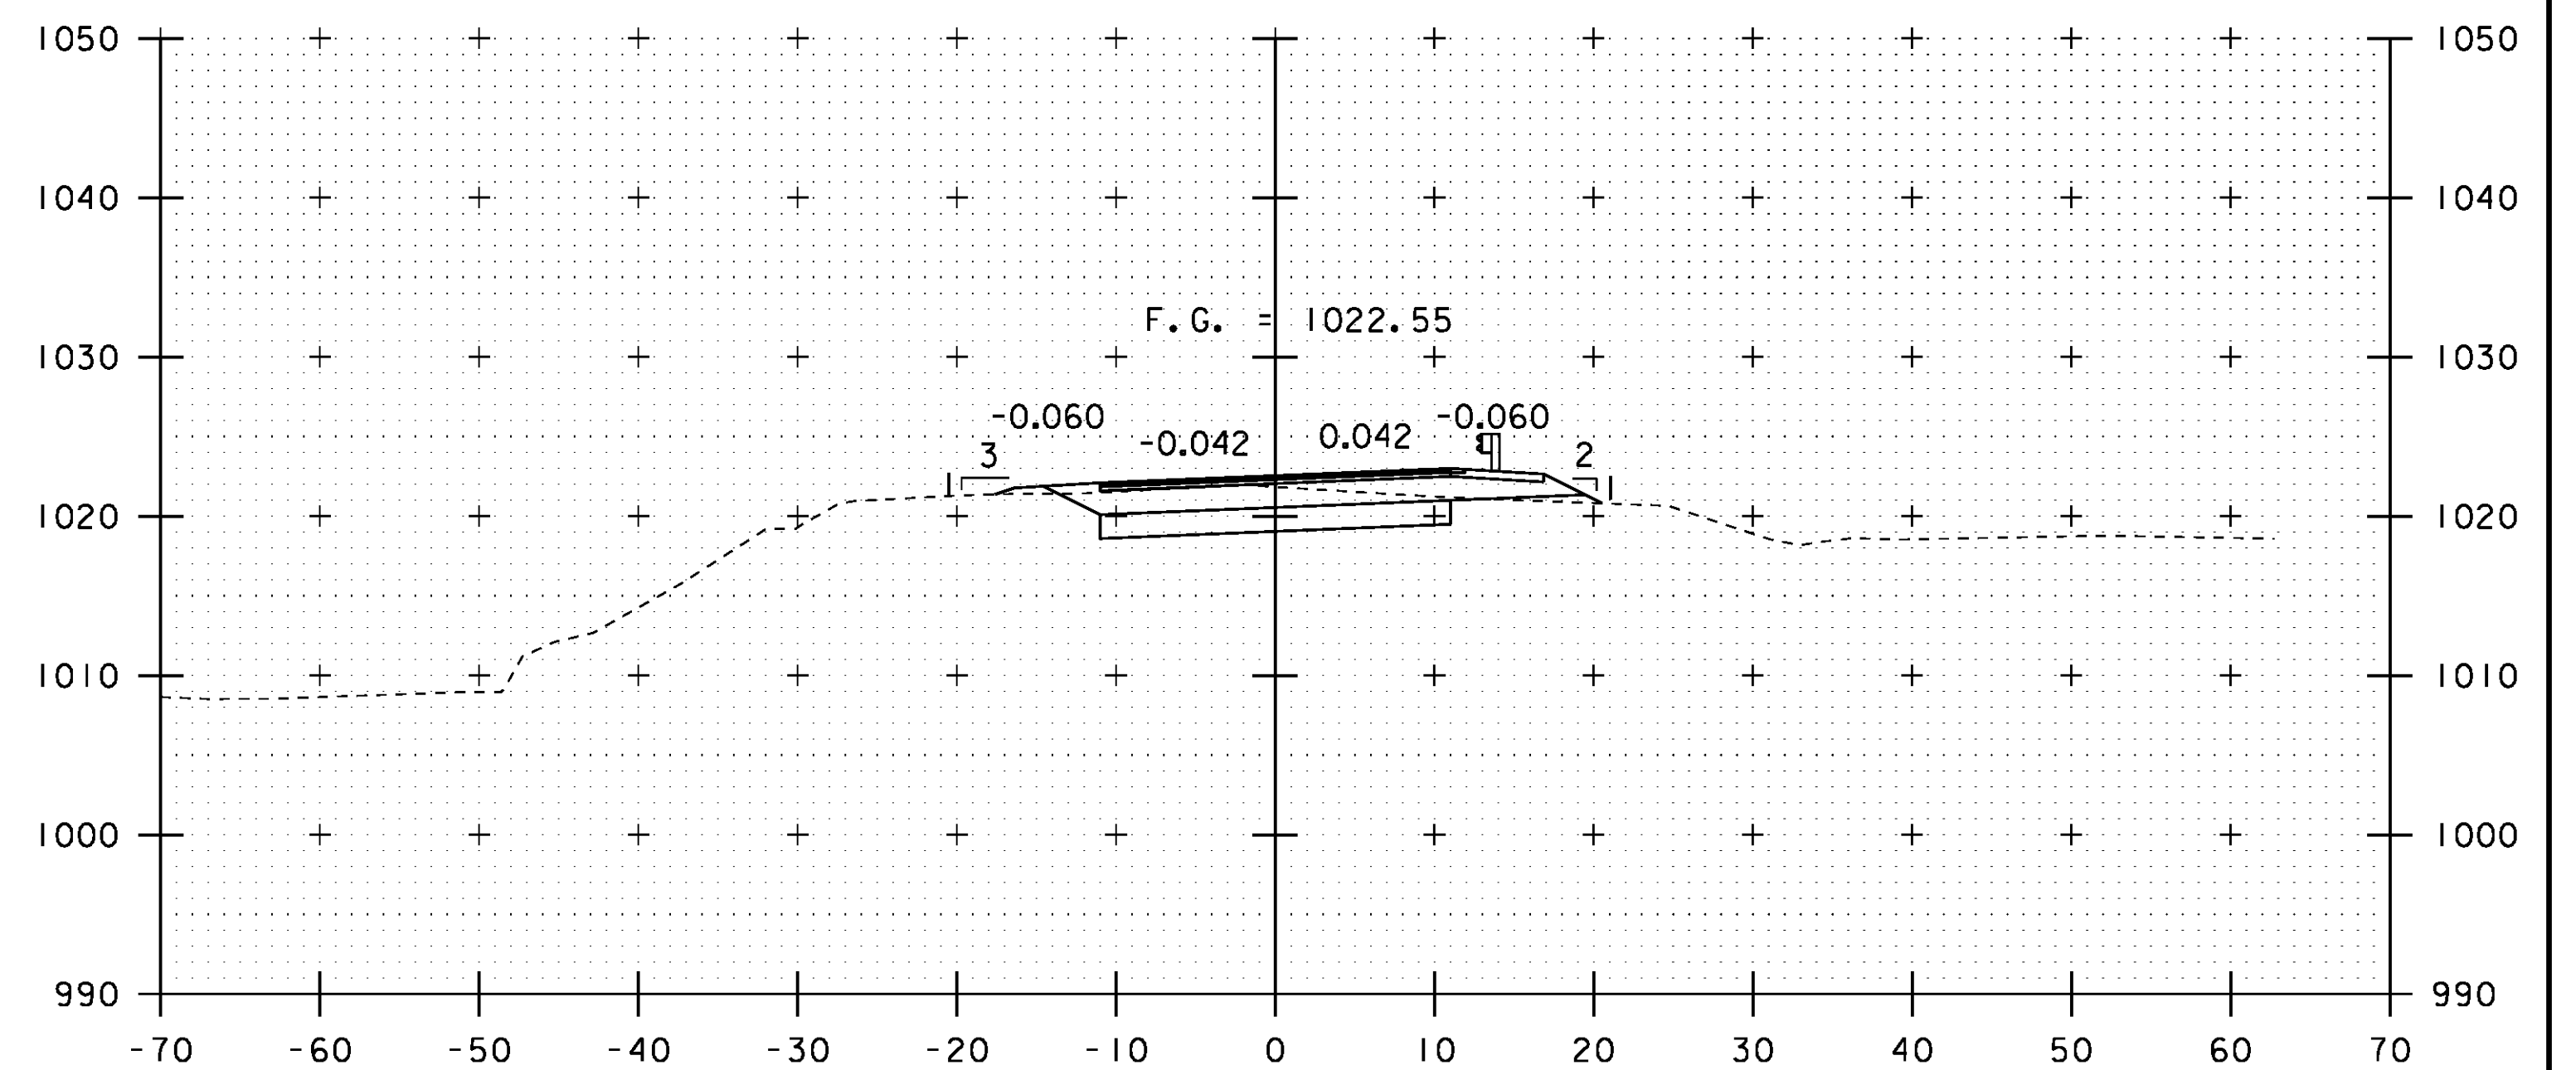

11+50

PROJECT NAME:	CRAFTSBURY
PROJECT NUMBER:	BO 1449(34)
FILE NAME:	sl3j100xs.dgn
PROJECT LEADER:	R. YOUNG
DESIGNED BY:	W. LAMMER
MAINLINE CROSS SECTIONS 2	
PLOT DATE:	14-OCT-2015
DRAWN BY:	S. COLEY
CHECKED BY:	W. LAMMER
SHEET	26 OF 42

STA. 11+00 TO STA. 11+75