



13+25

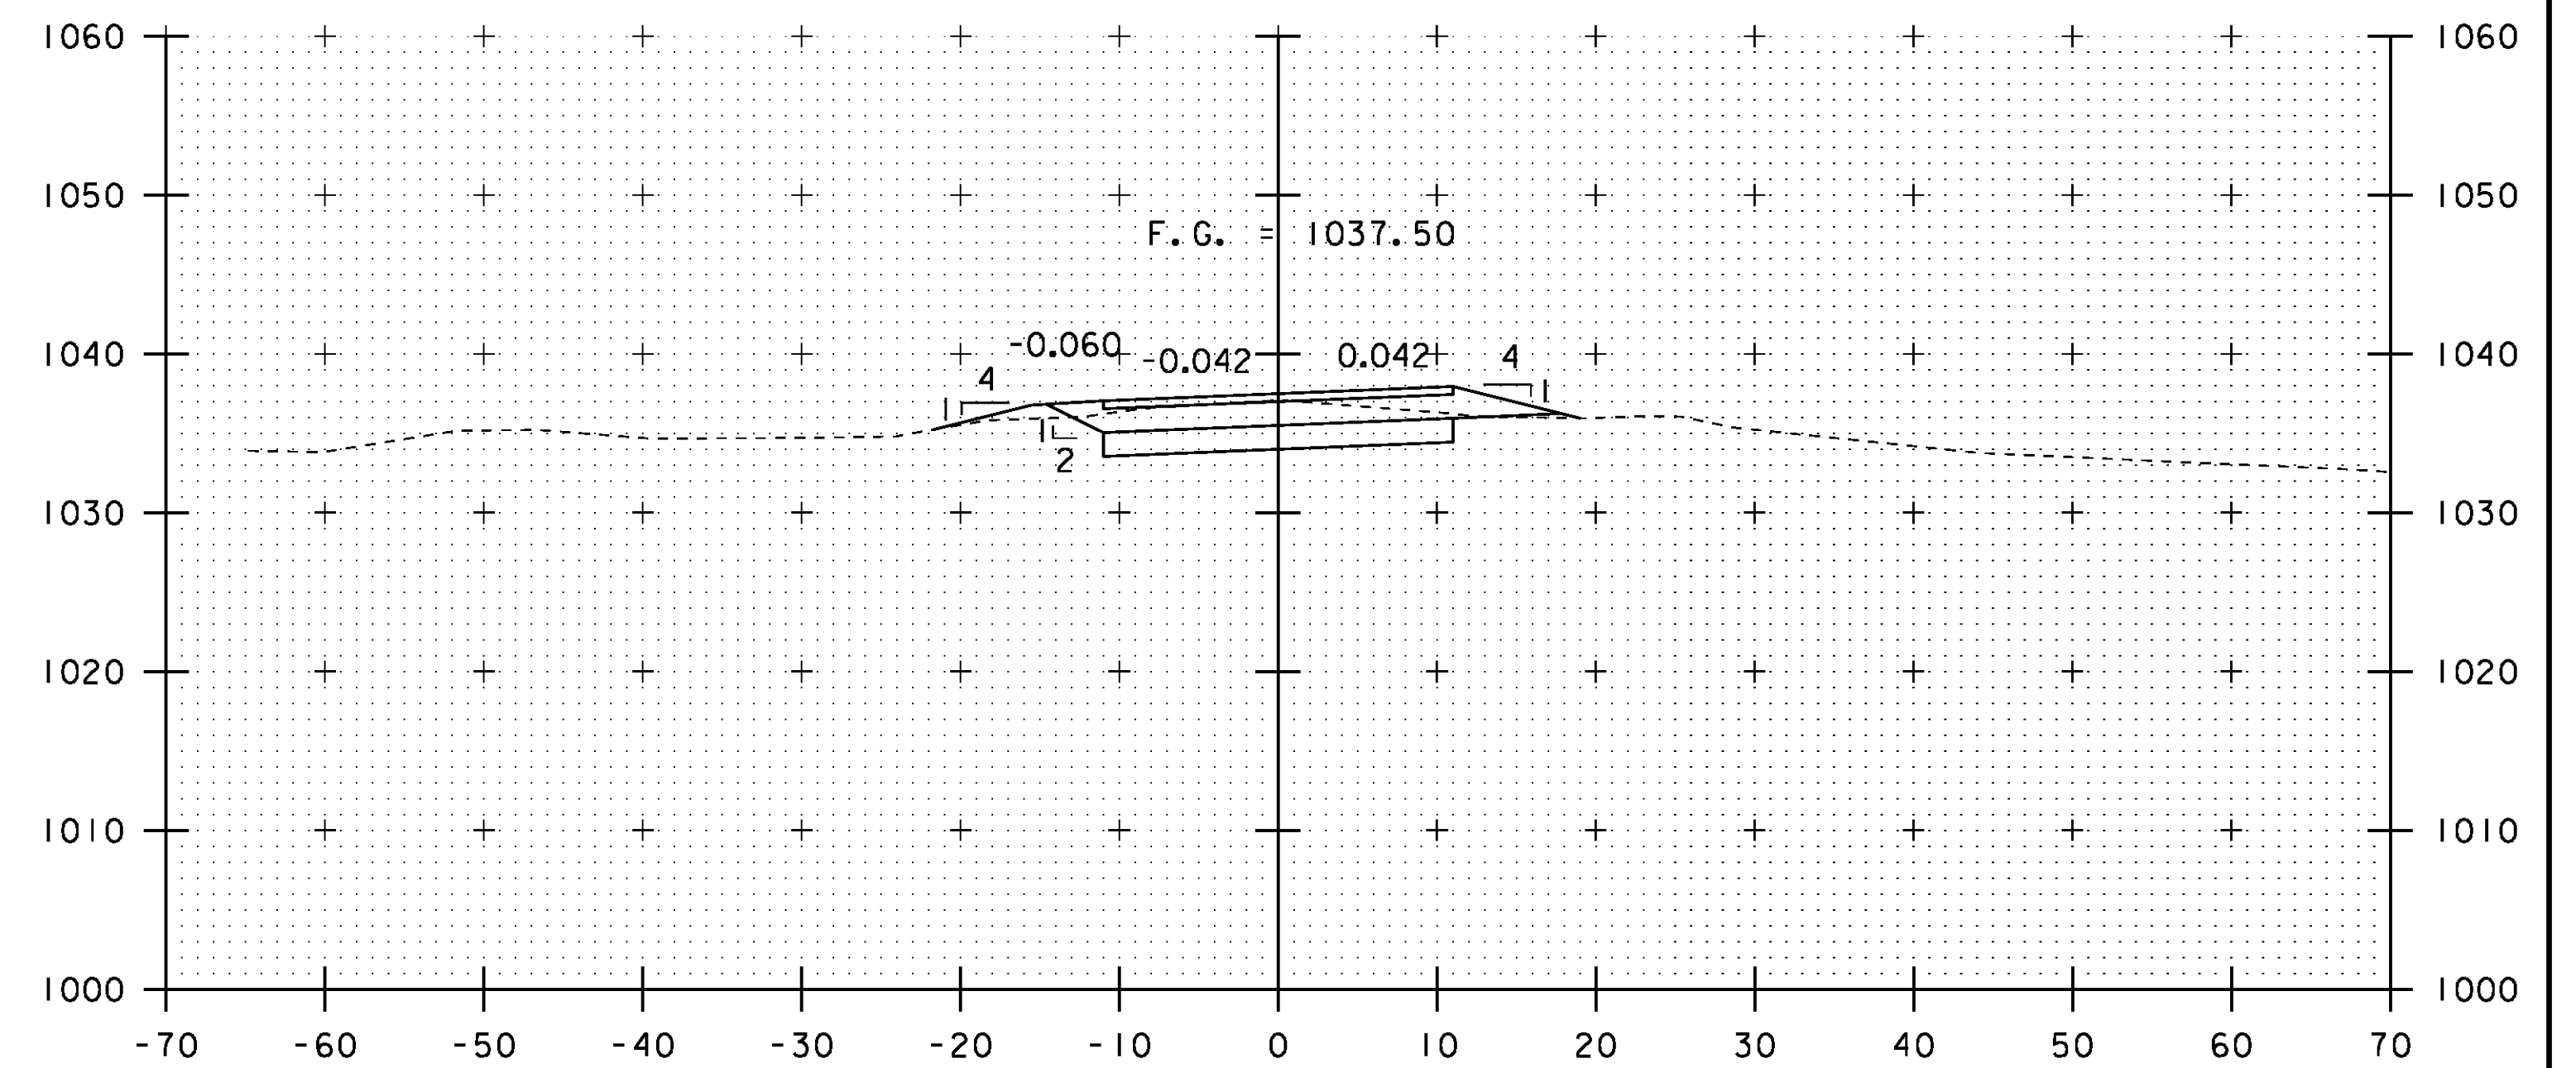


STA 13+75.00
END PROJECT

13+75

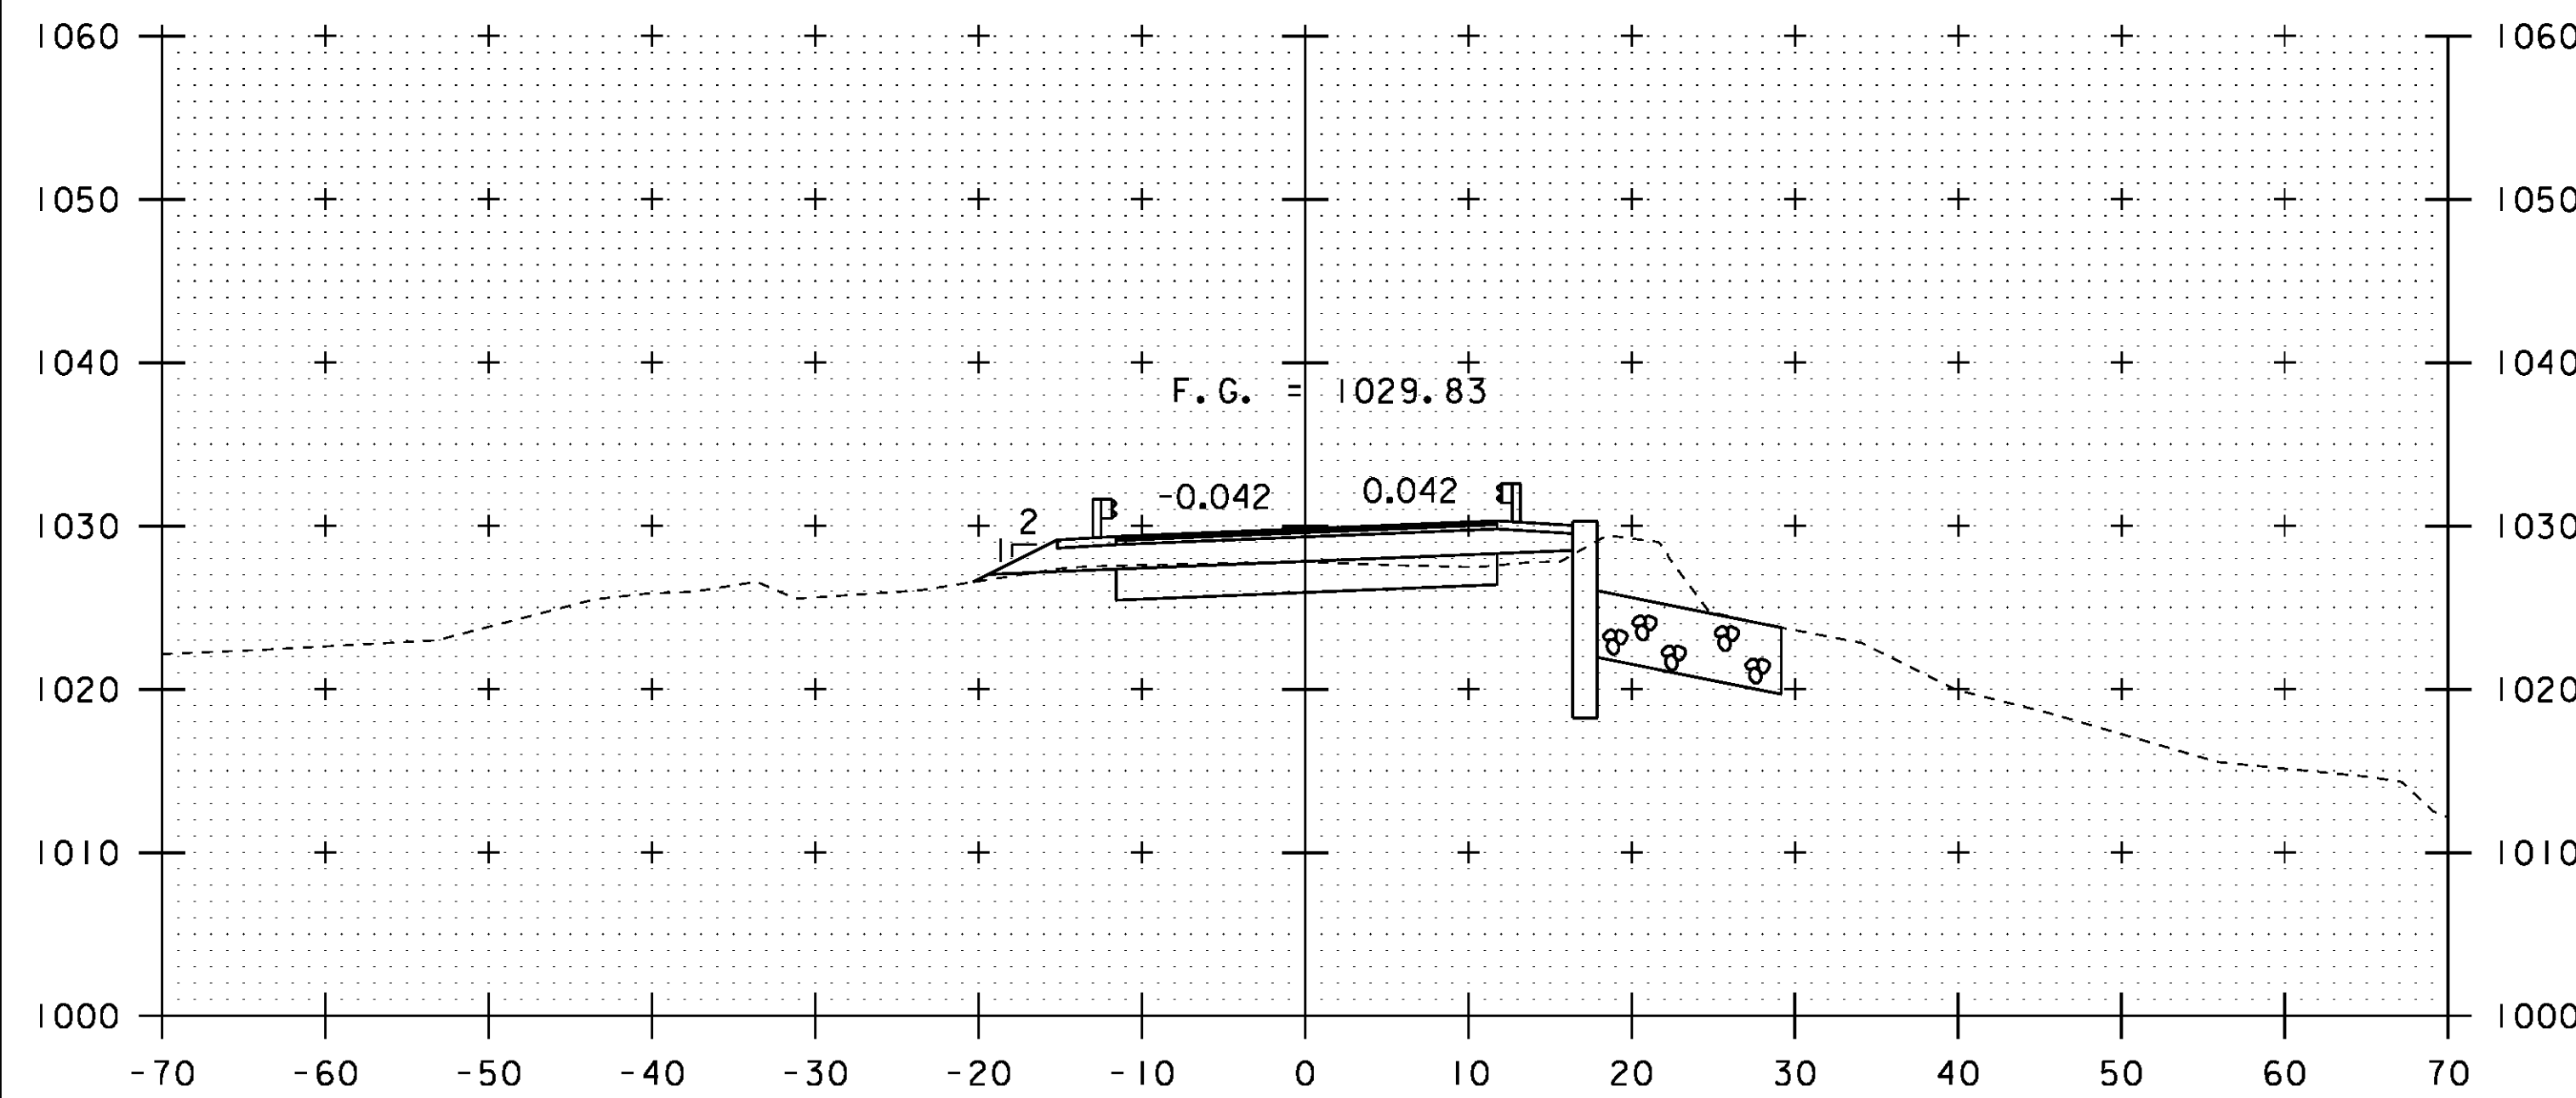

END BRIDGE
STA 12+91.57

13+00

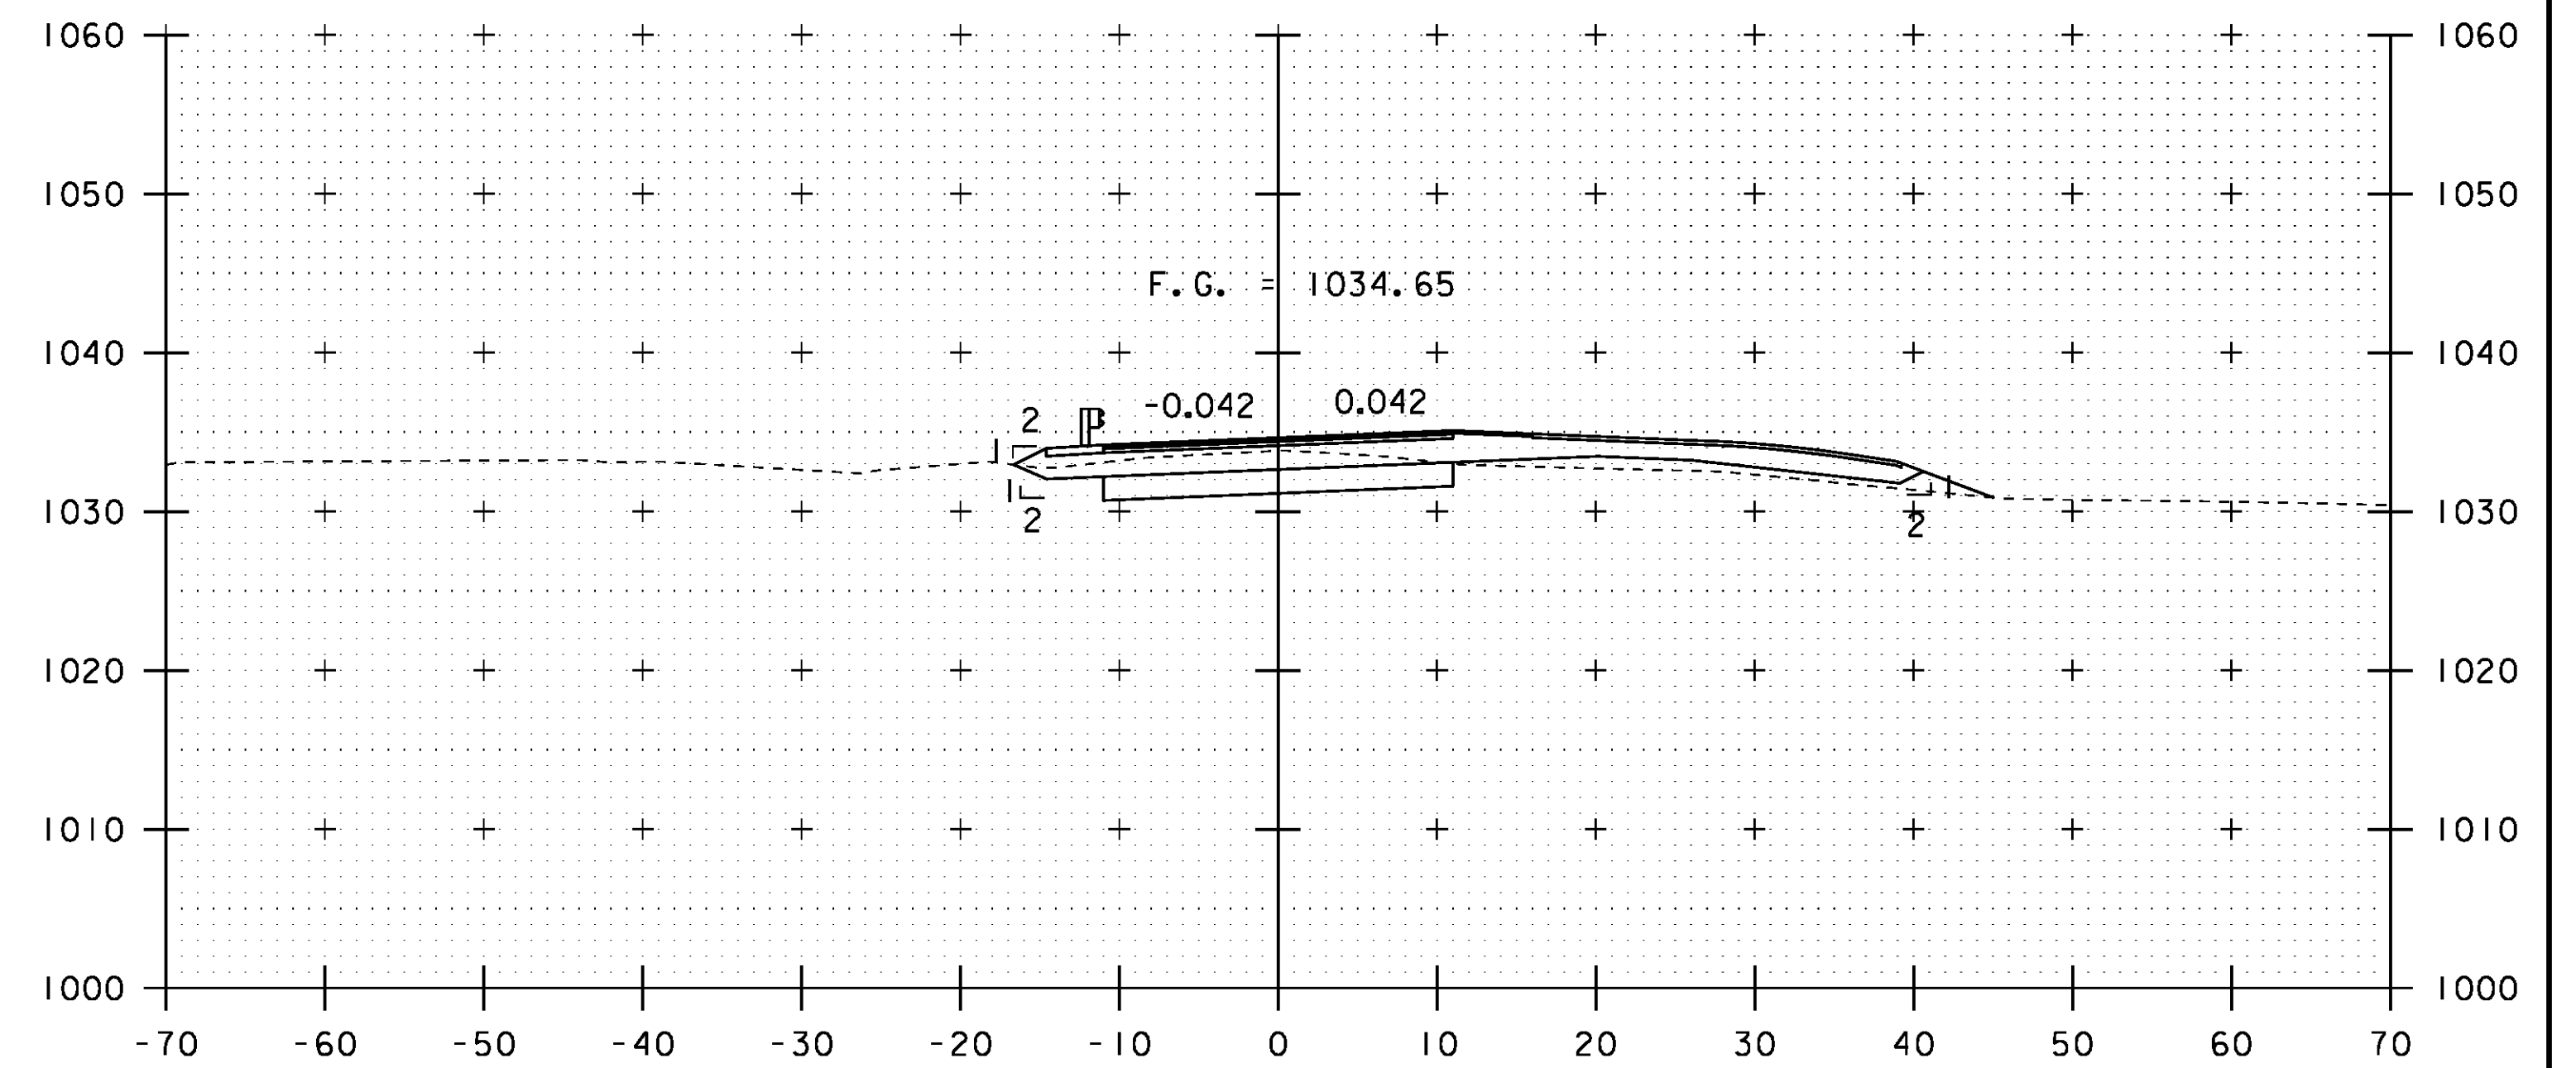

STA 13+46.30 RT
RECONSTRUCT DRIVE
12' WIDE

13+50

PROJECT NAME: CRAFTSBURY
PROJECT NUMBER: BO 1449(34)

FILE NAME: s13j100xs.dgn
PROJECT LEADER: R. YOUNG
DESIGNED BY: W. LAMMER
MAINLINE CROSS SECTIONS 4

PLOT DATE: 14-OCT-2015
DRAWN BY: S. COLEY
CHECKED BY: W. LAMMER
SHEET 28 OF 42

STA. 13+00 TO STA. 13+75