




50+25

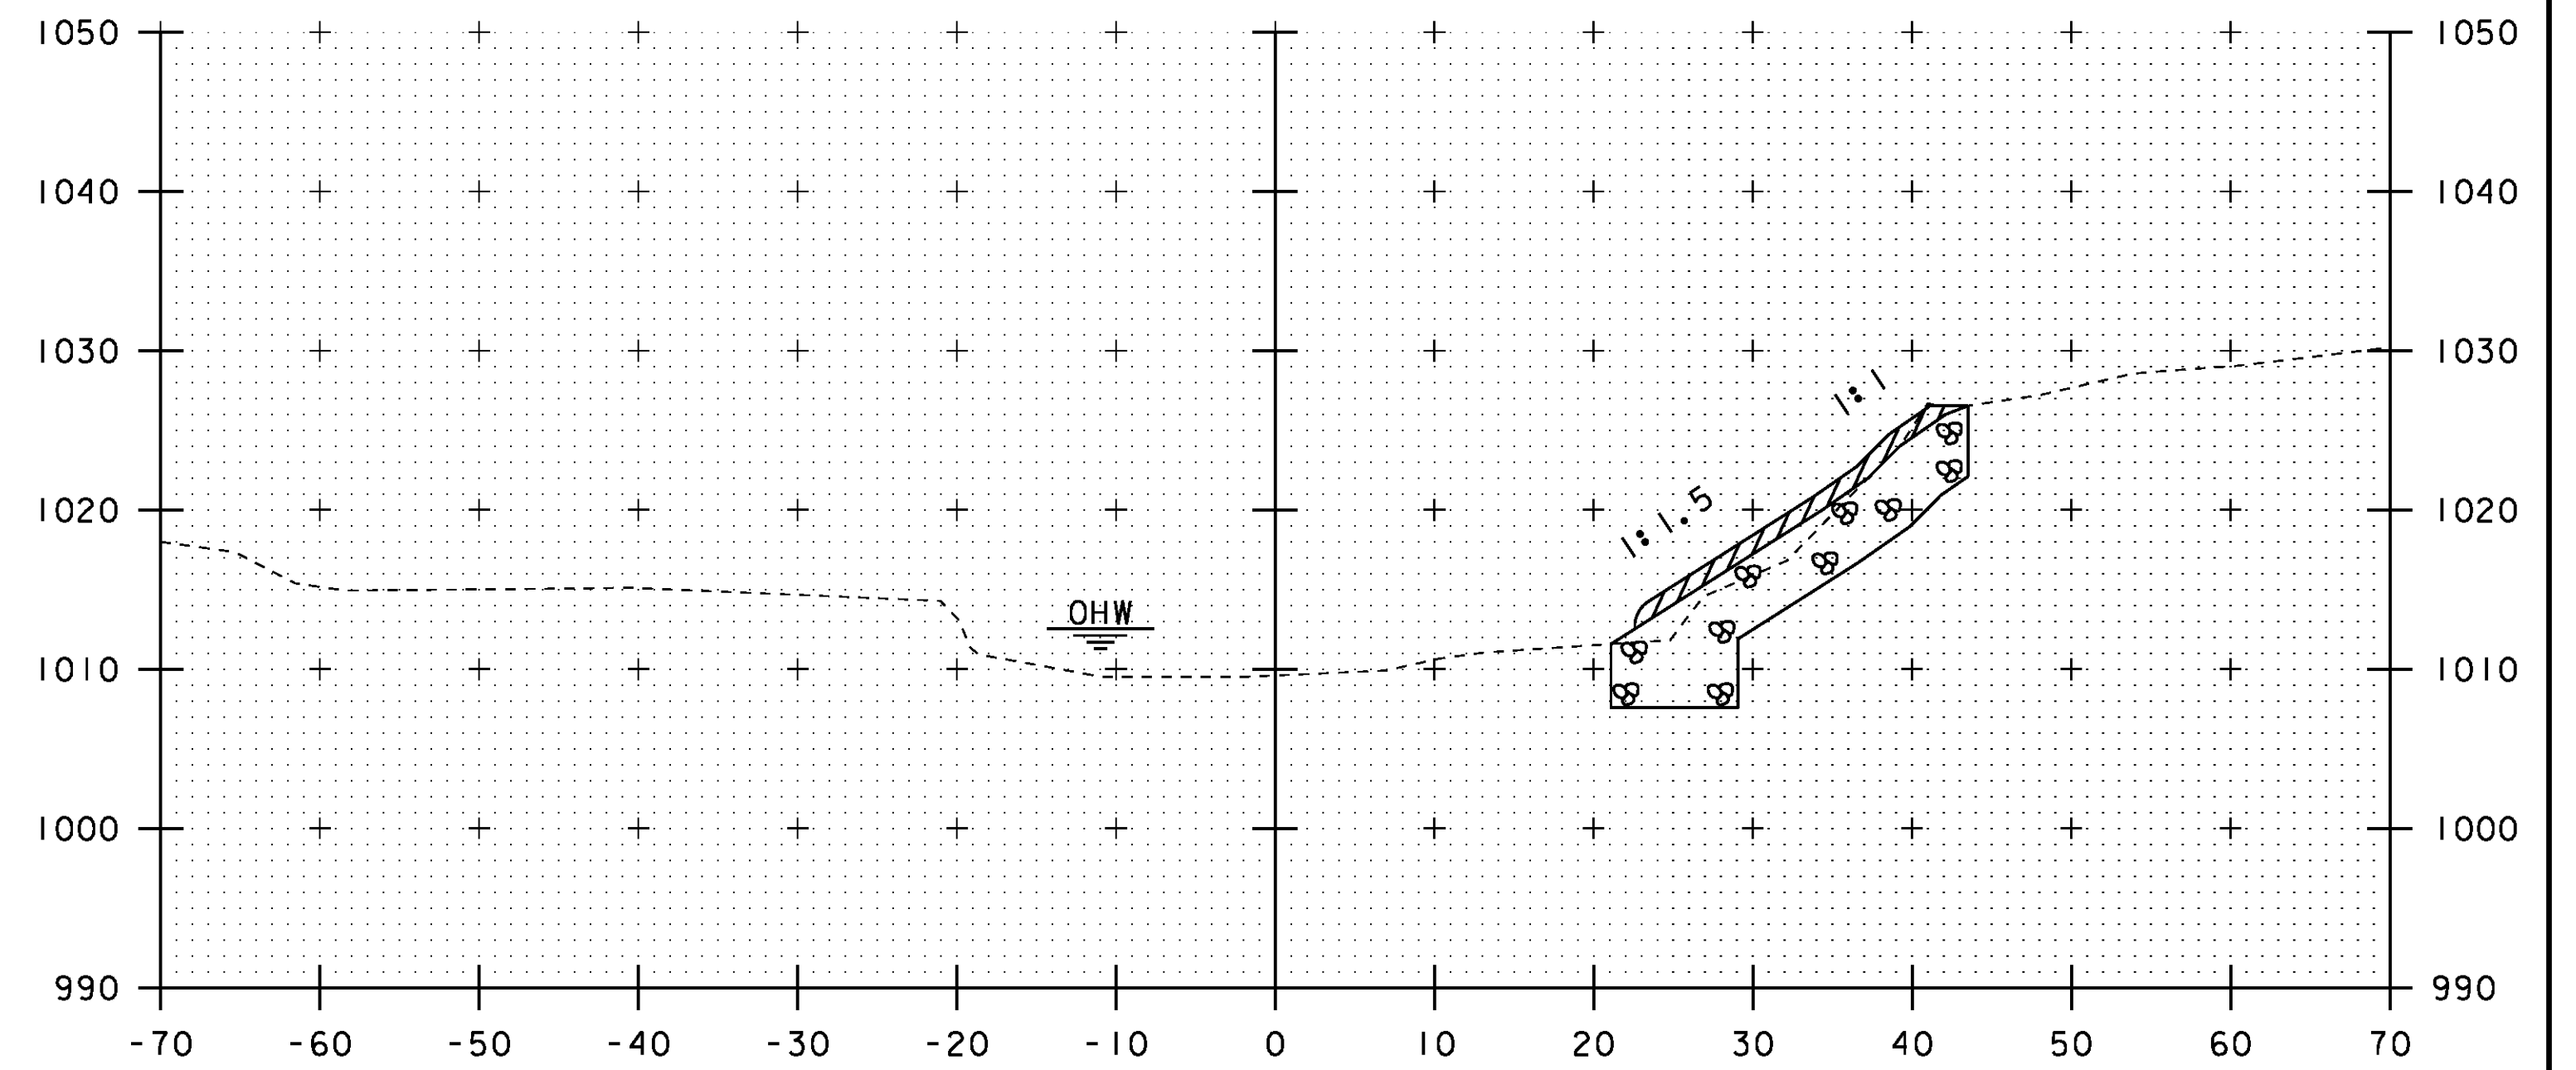

50+60

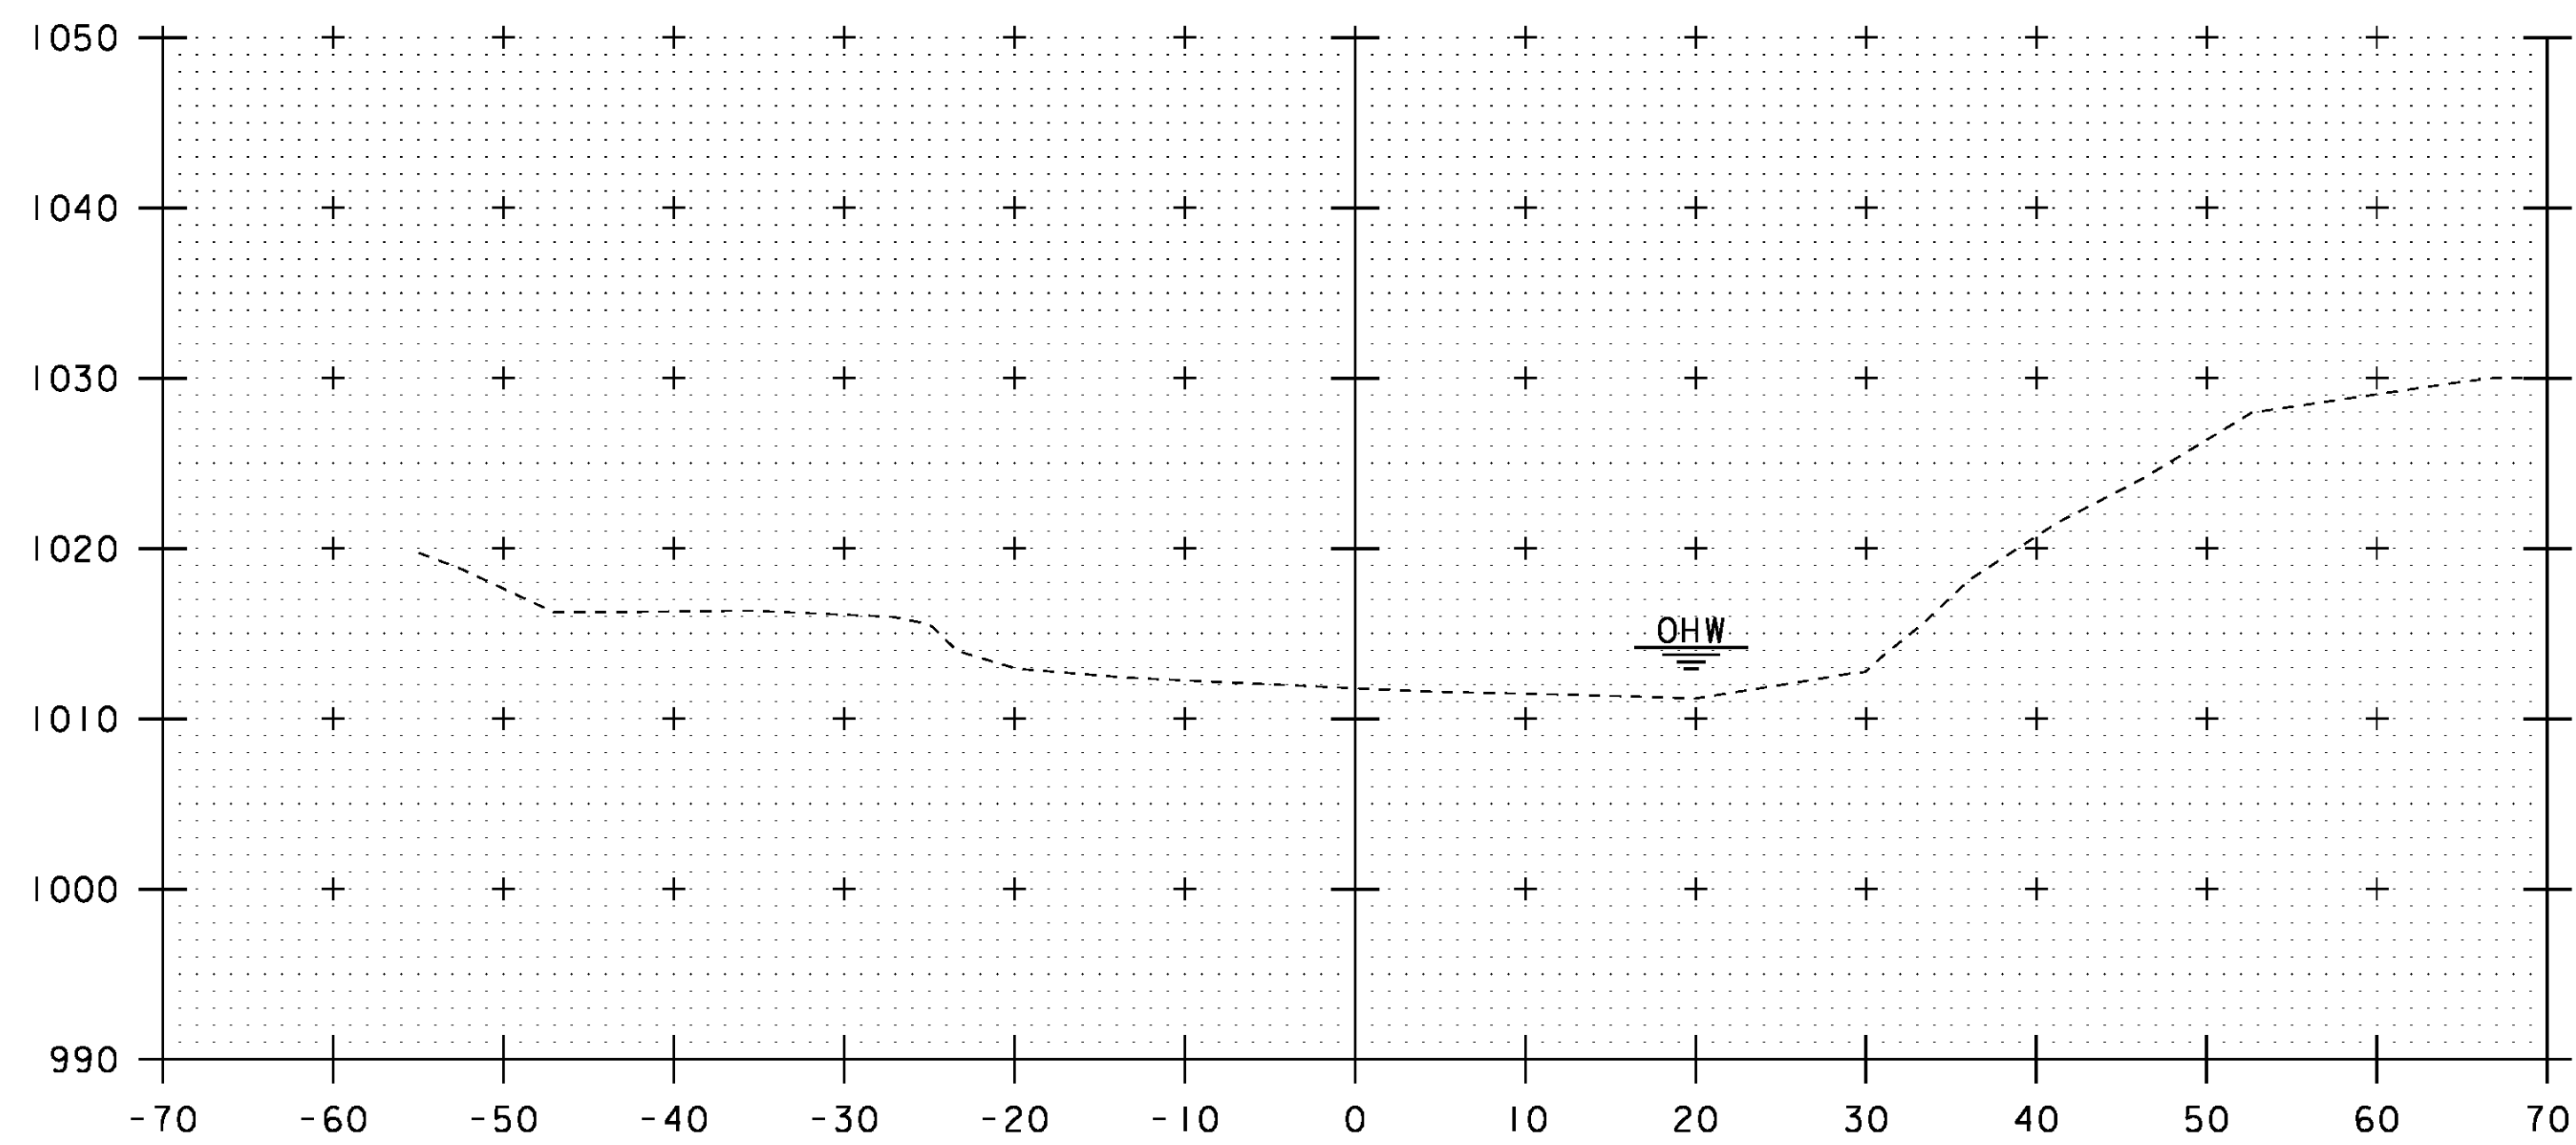

50+00

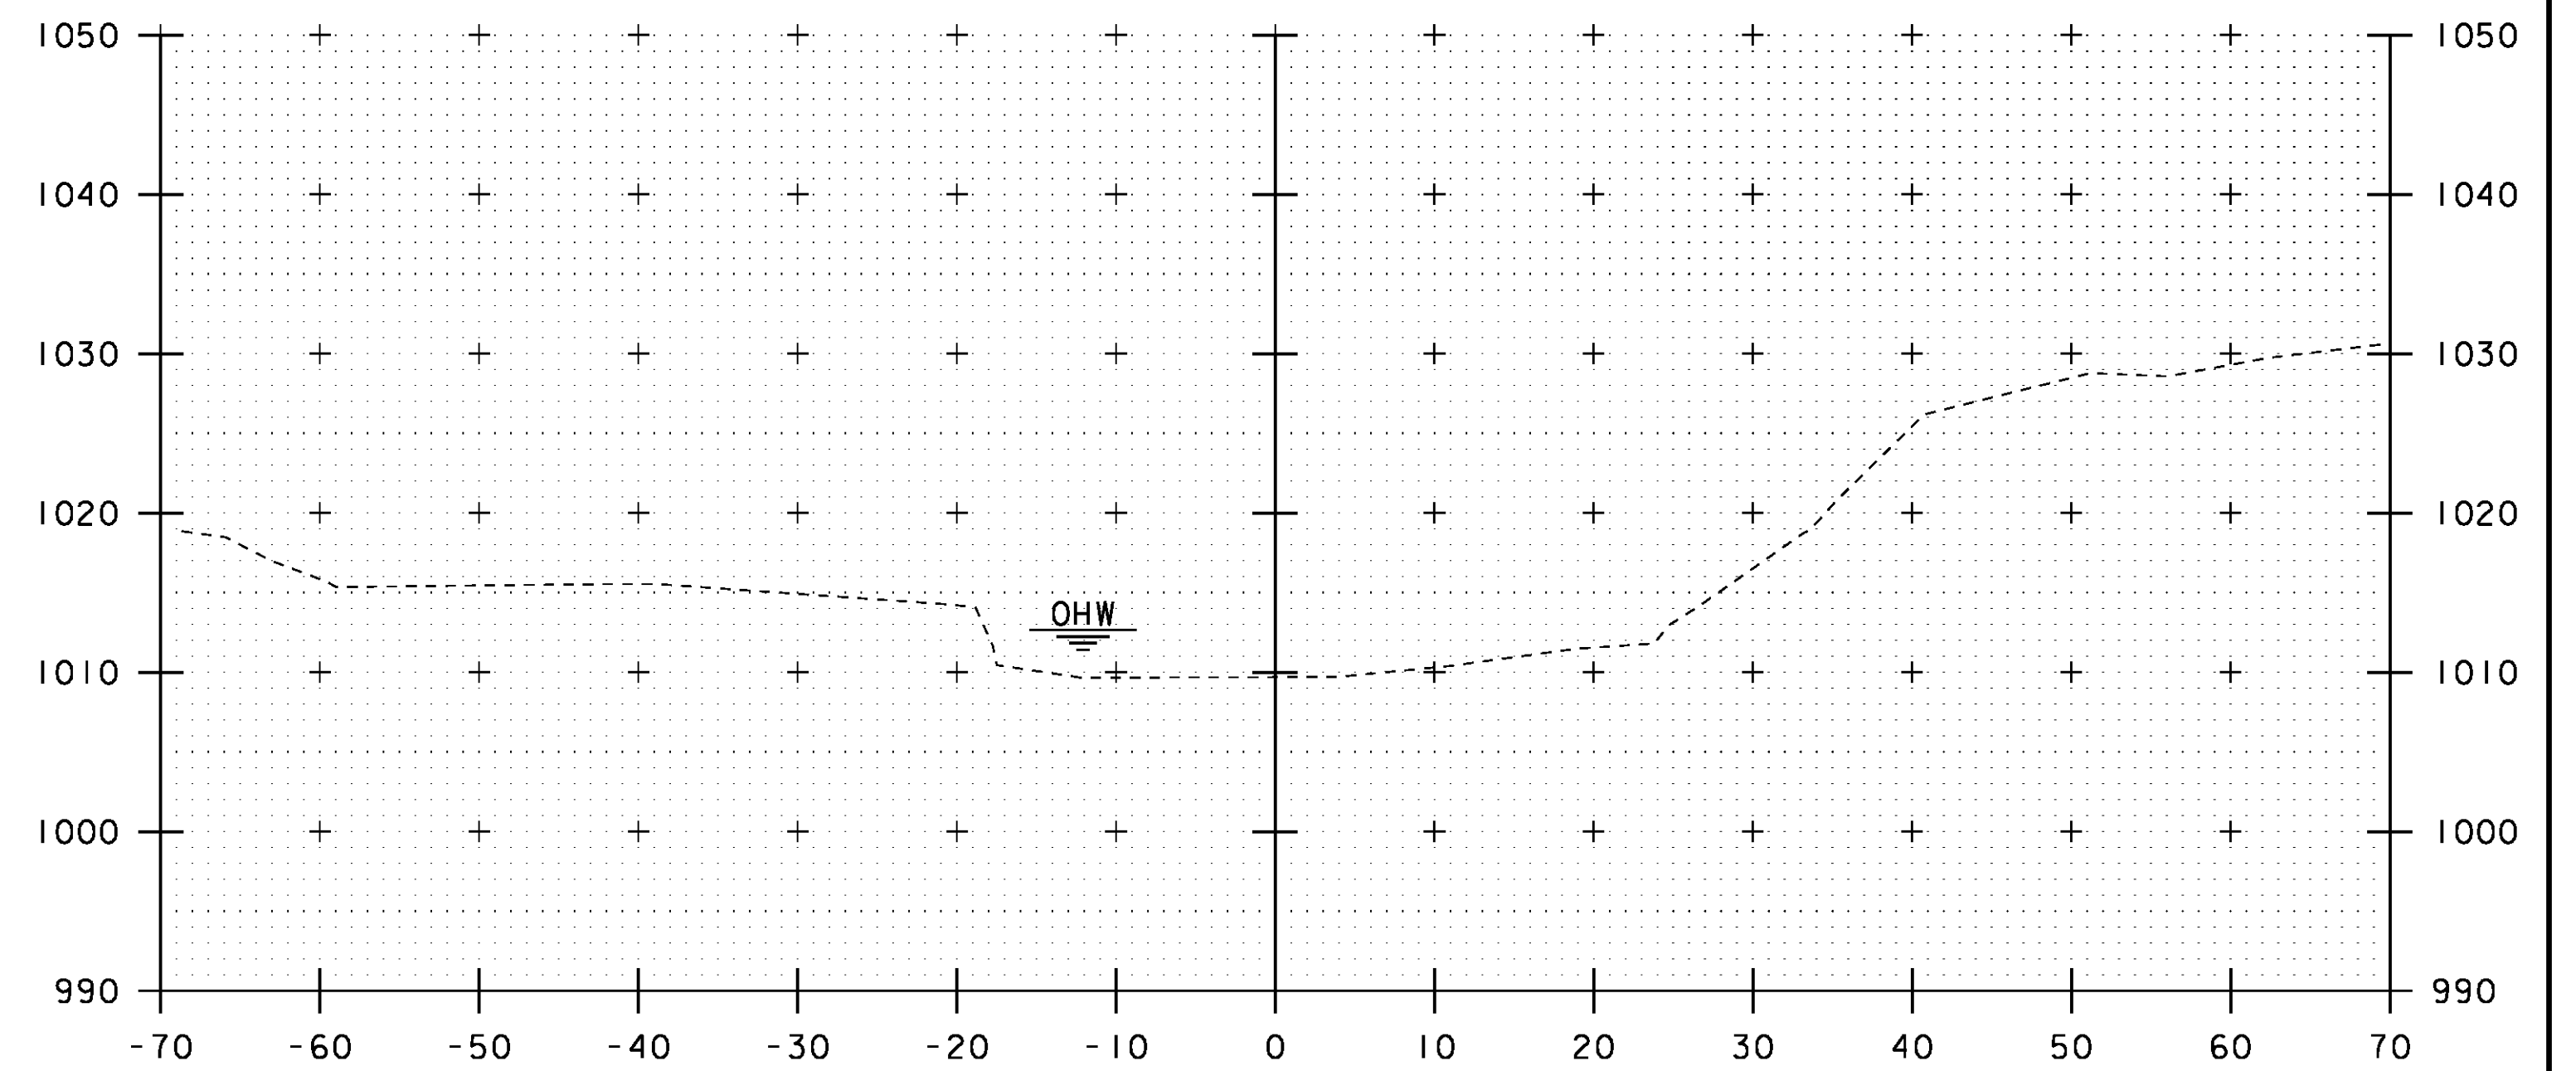

50+50

BEGIN STONE FILL, TYPE IV  
 GEOTEXTILE UNDER STONE FILL  
 GRUBBING MATERIAL  
 UNCLASSIFIED CHANNEL EXCAVATION  
 STA 50+55.40 RT

PROJECT NAME:	CRAFTSBURY	PLOT DATE:	14-OCT-2015
PROJECT NUMBER:	BO 1449(34)	DRAWN BY:	S. COLEY
FILE NAME:	sl3j100xs.dgn	DESIGNED BY:	W. LAMMER
PROJECT LEADER:	R. YOUNG	CHECKED BY:	W. LAMMER
CHANNEL CROSS SECTIONS:	1		SHEET 30 OF 42

STA. 50+00 TO STA. 50+50