



BEGIN STONE FILL, TYPE IV
 GEOTEXTILE UNDER STONE FILL
 GRUBBING MATERIAL
 UNCLASSIFIED CHANNEL EXCAVATION
 STA 50+80.29 LT


50+80

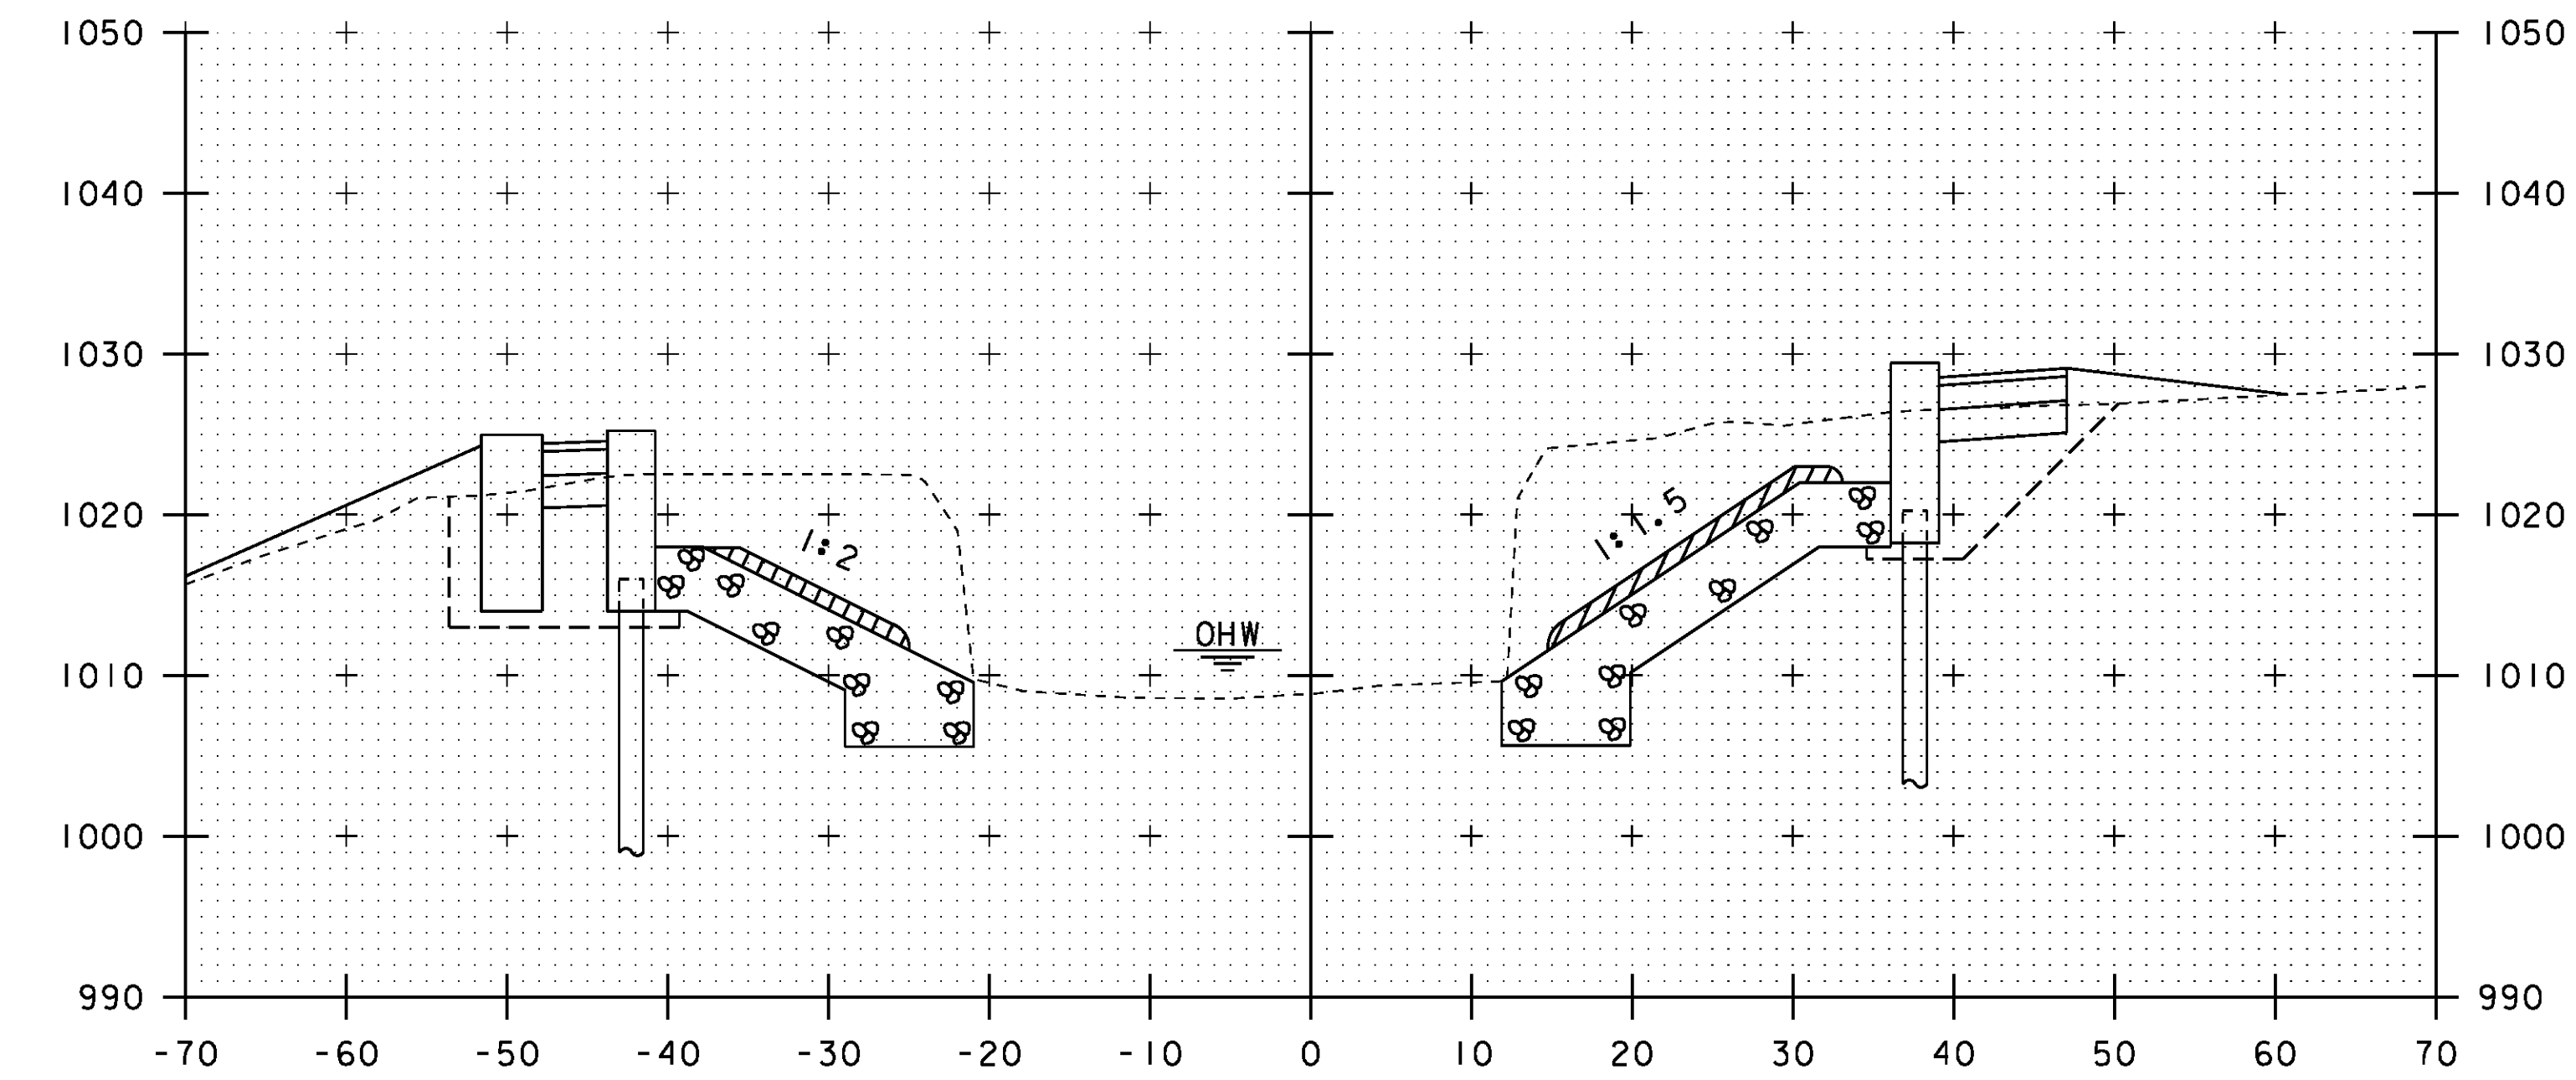

51+00

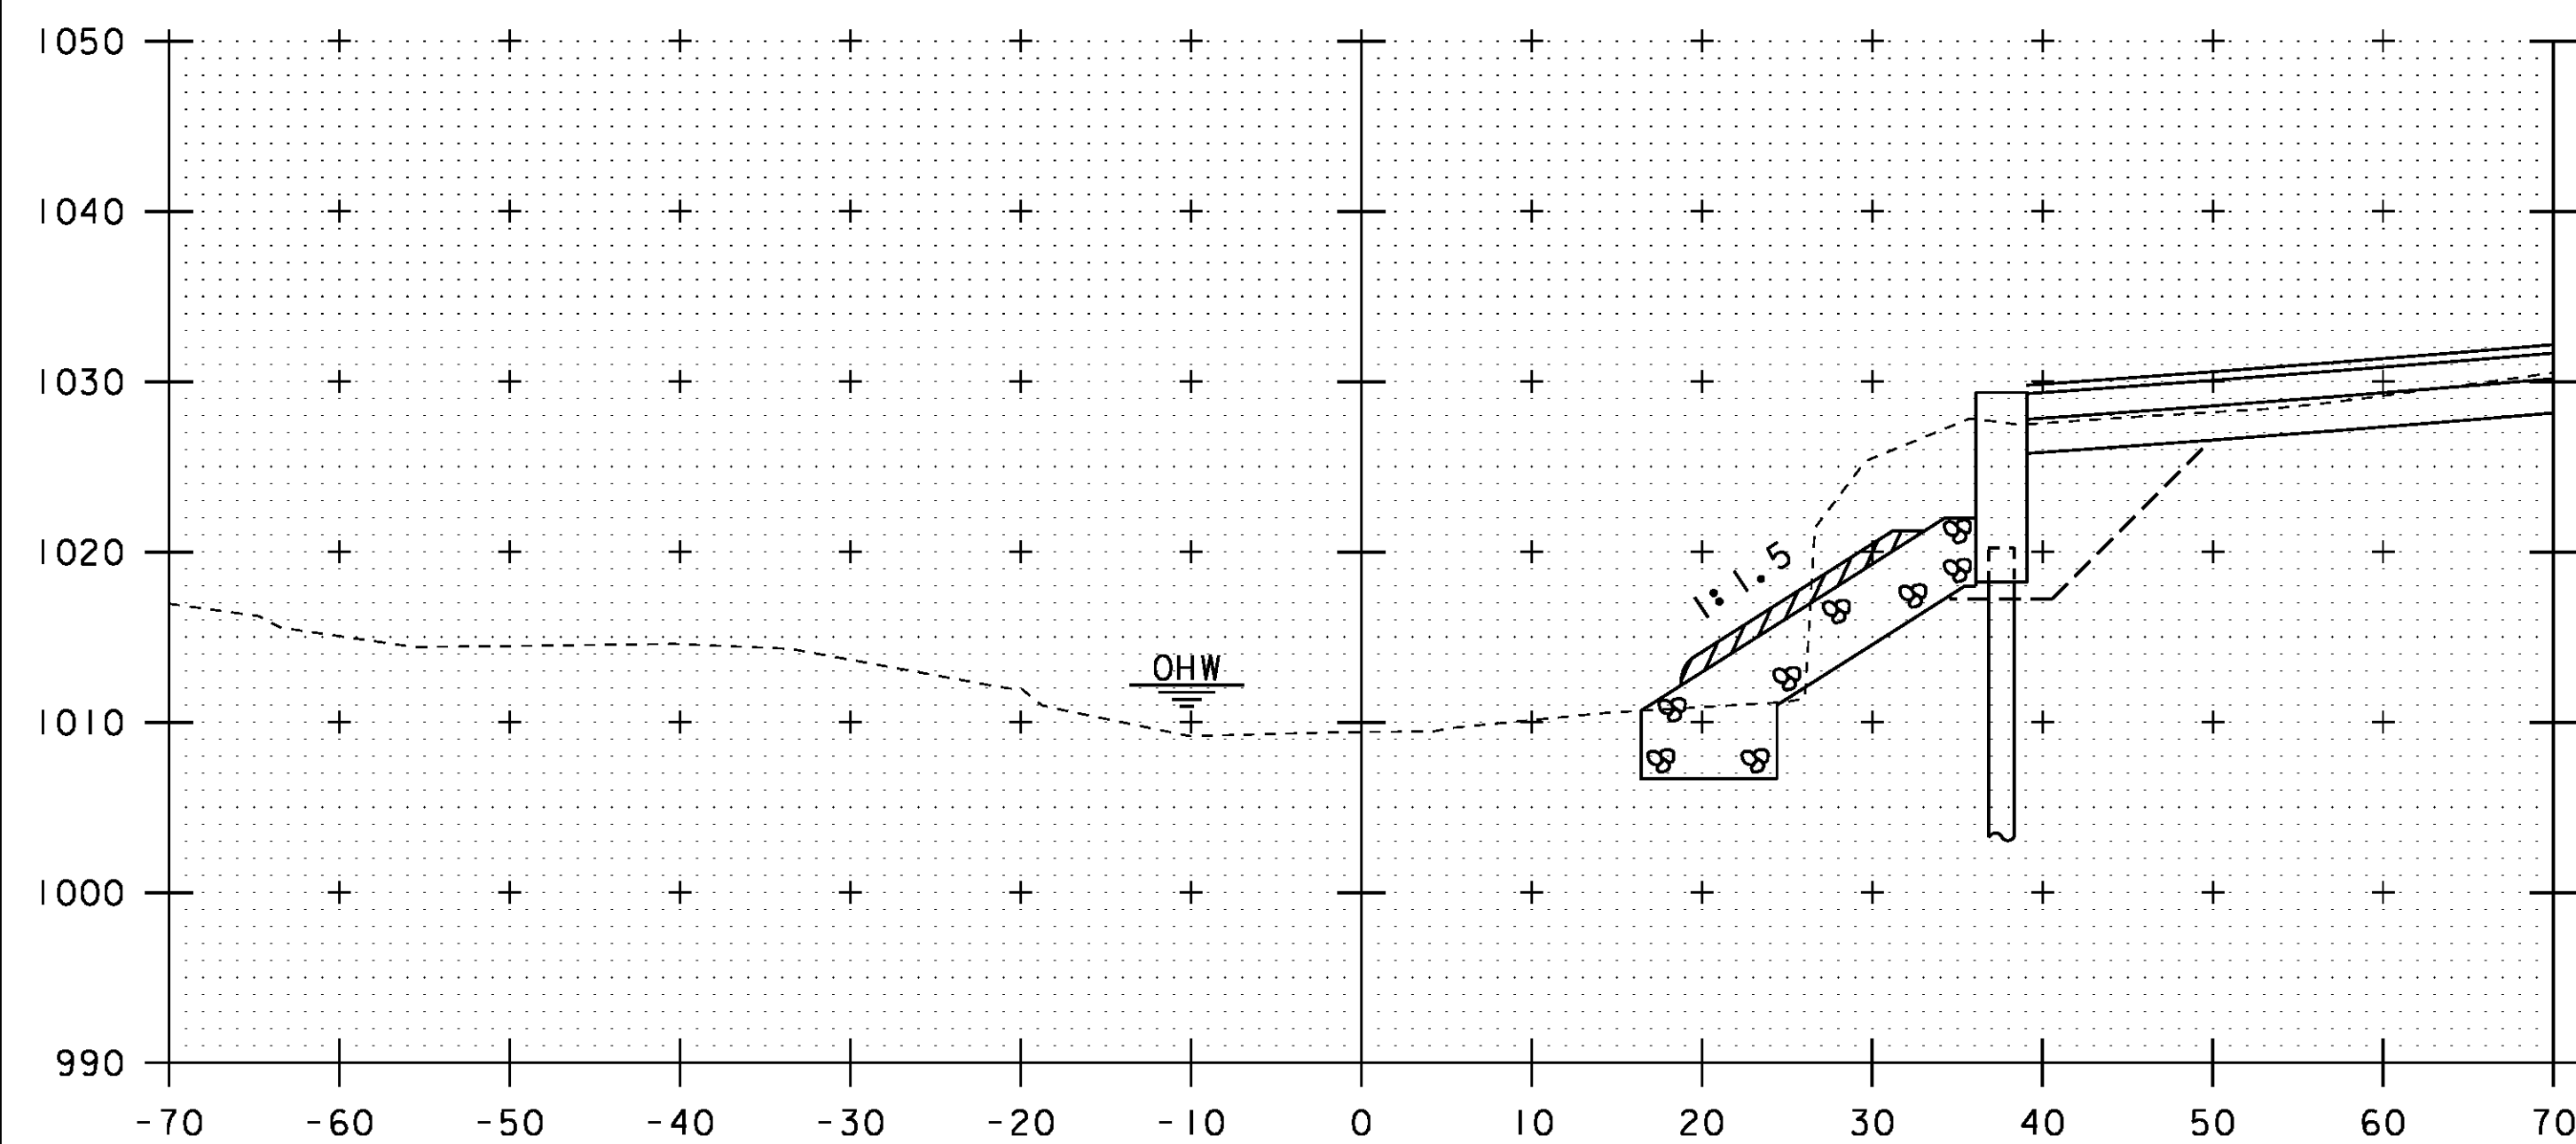

50+70

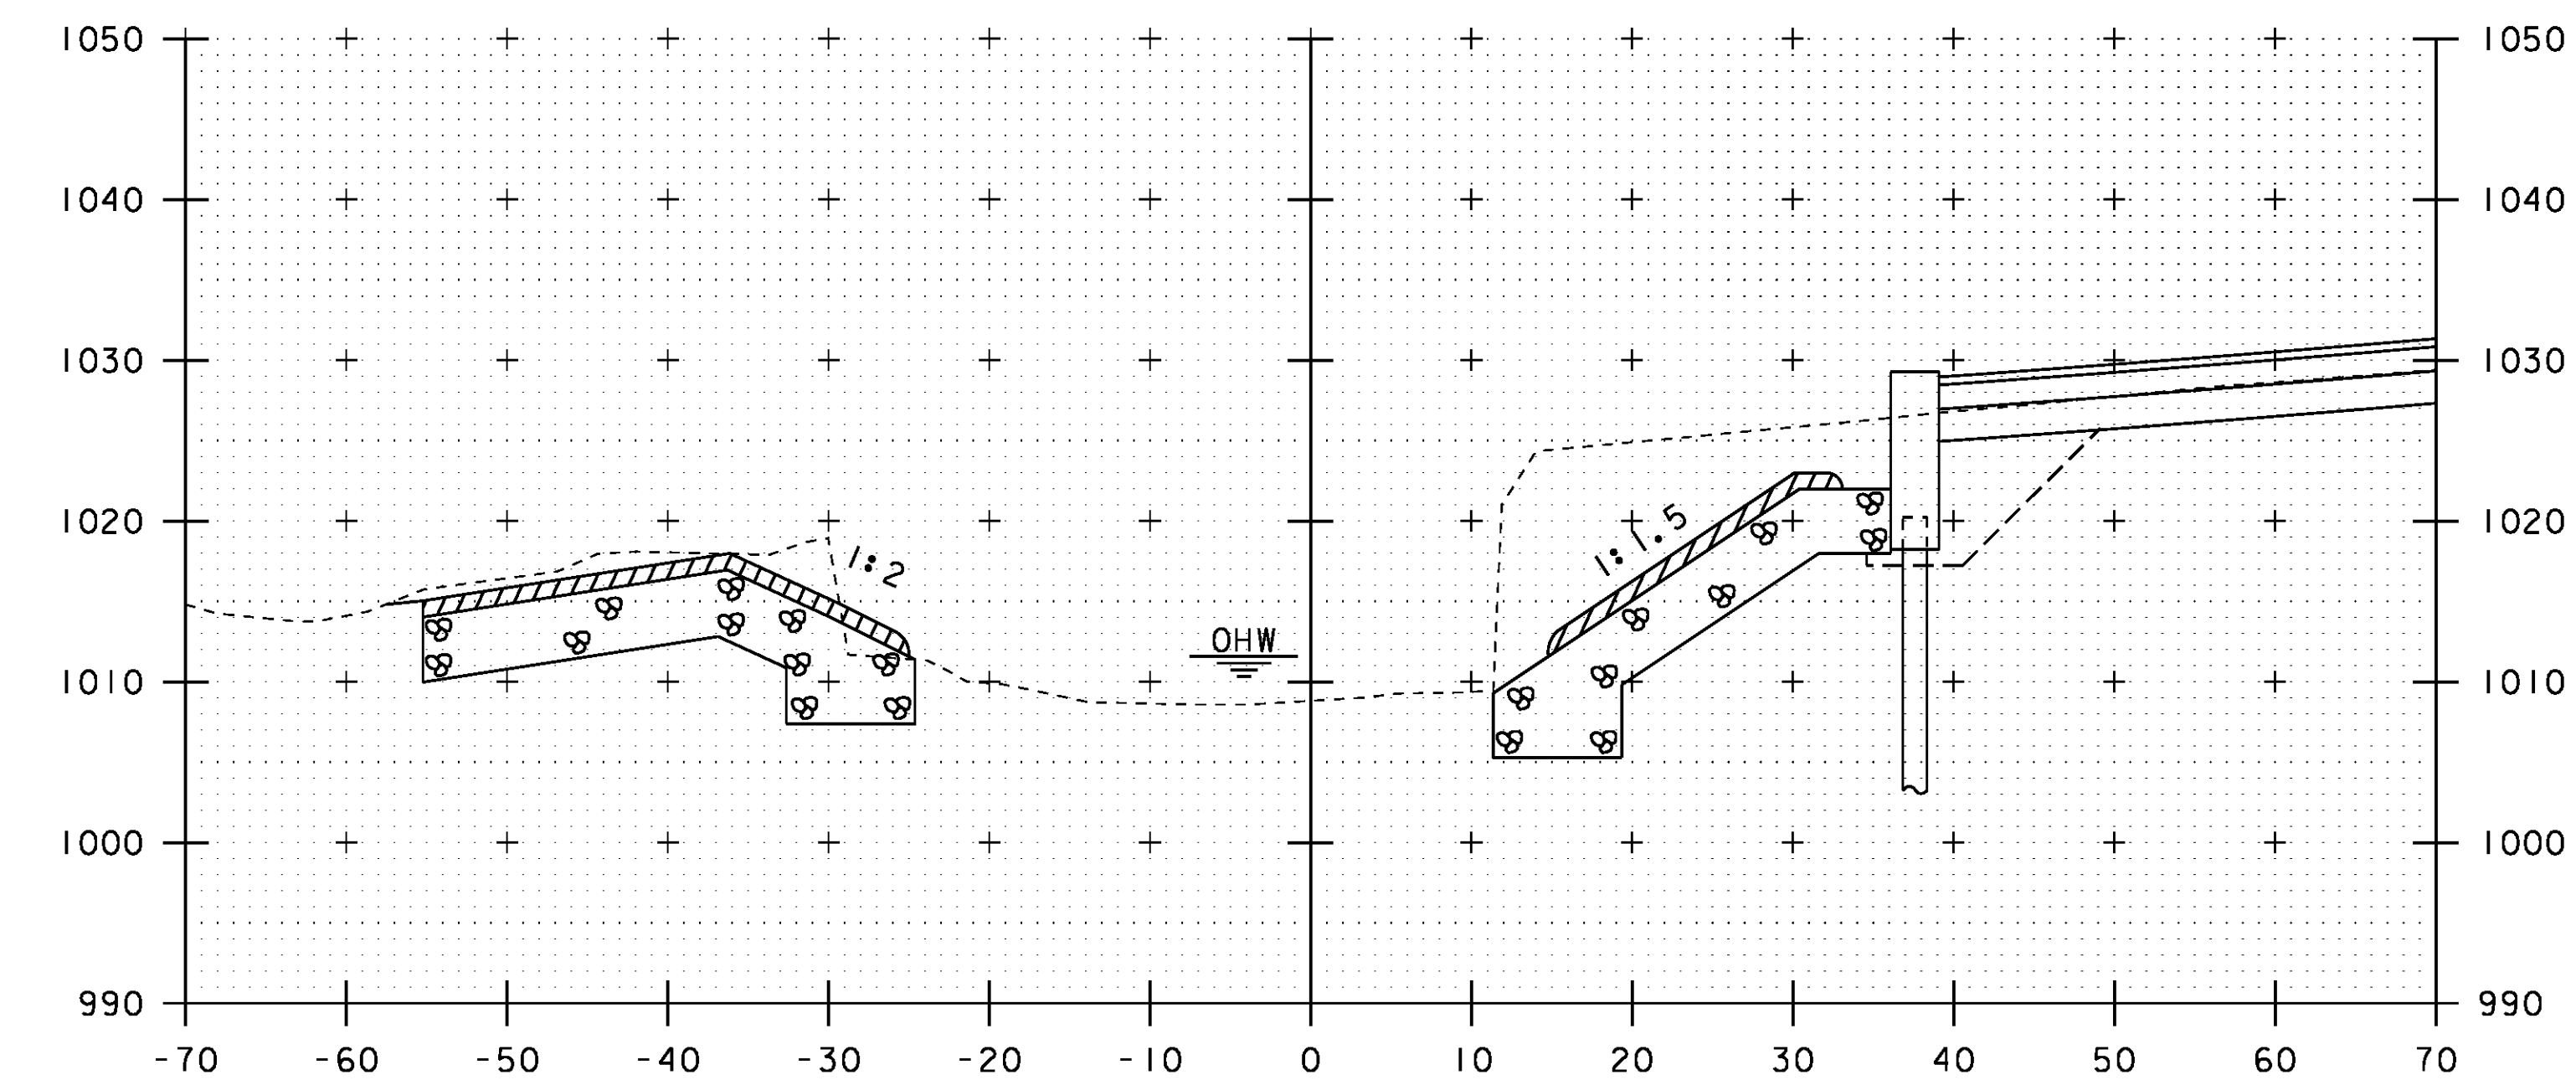

50+90

STA. 50+70 TO STA. 51+00

PROJECT NAME:	CRAFTSBURY	PLOT DATE:	14-OCT-2015
PROJECT NUMBER:	BO 1449(34)	DRAWN BY:	S. COLEY
FILE NAME:	sl3j100xs.dgn	DESIGNED BY:	W. LAMMER
PROJECT LEADER:	R. YOUNG	CHECKED BY:	W. LAMMER
CHANNEL CROSS SECTIONS 2		SHEET	31 OF 42