




I+20

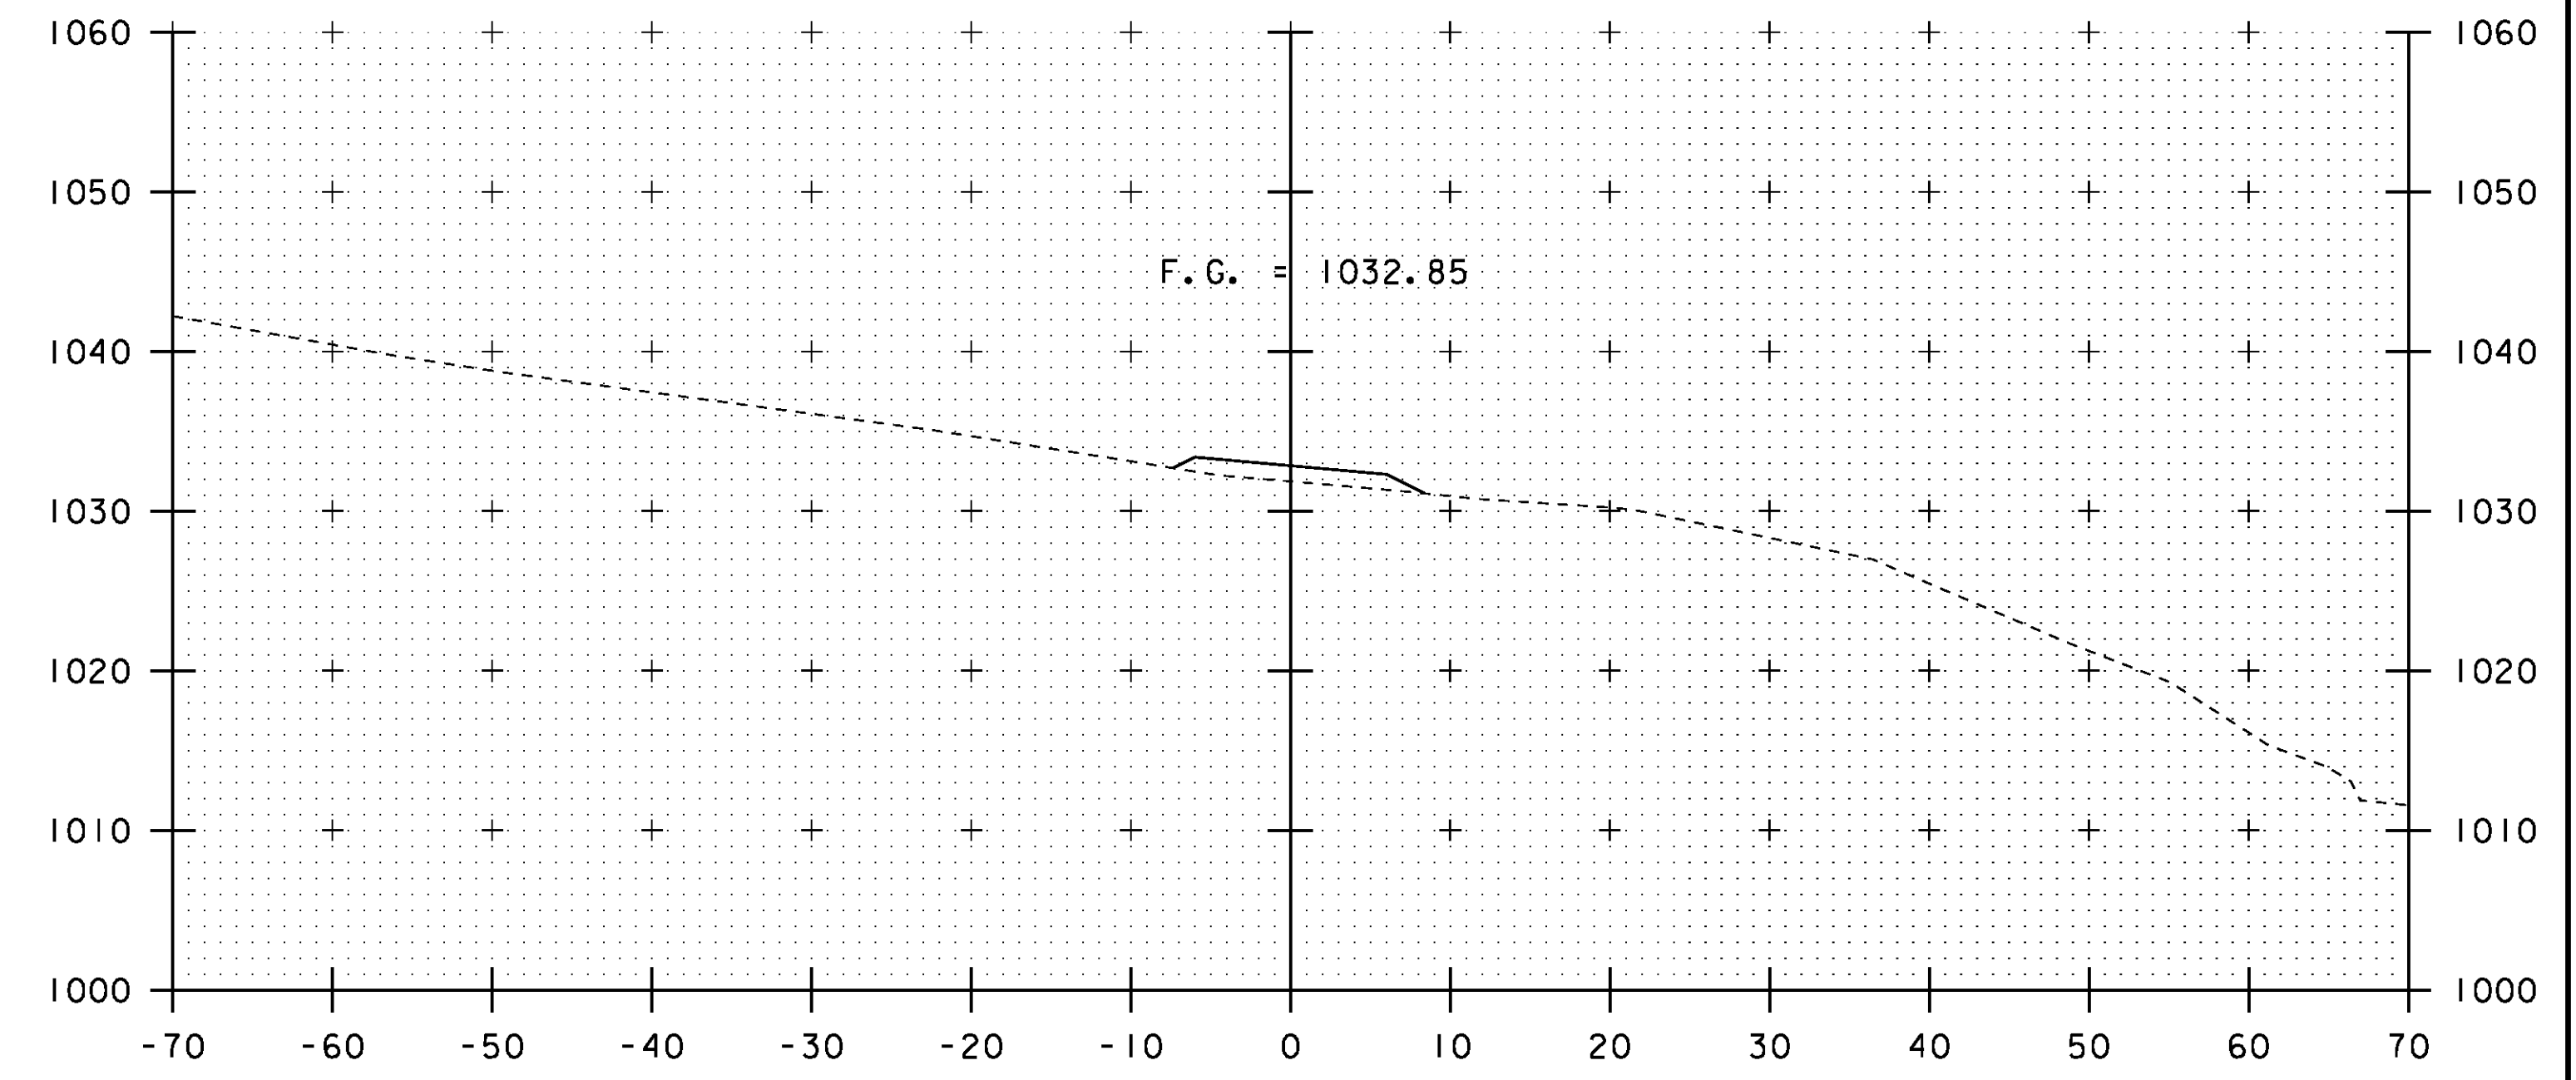

I+40

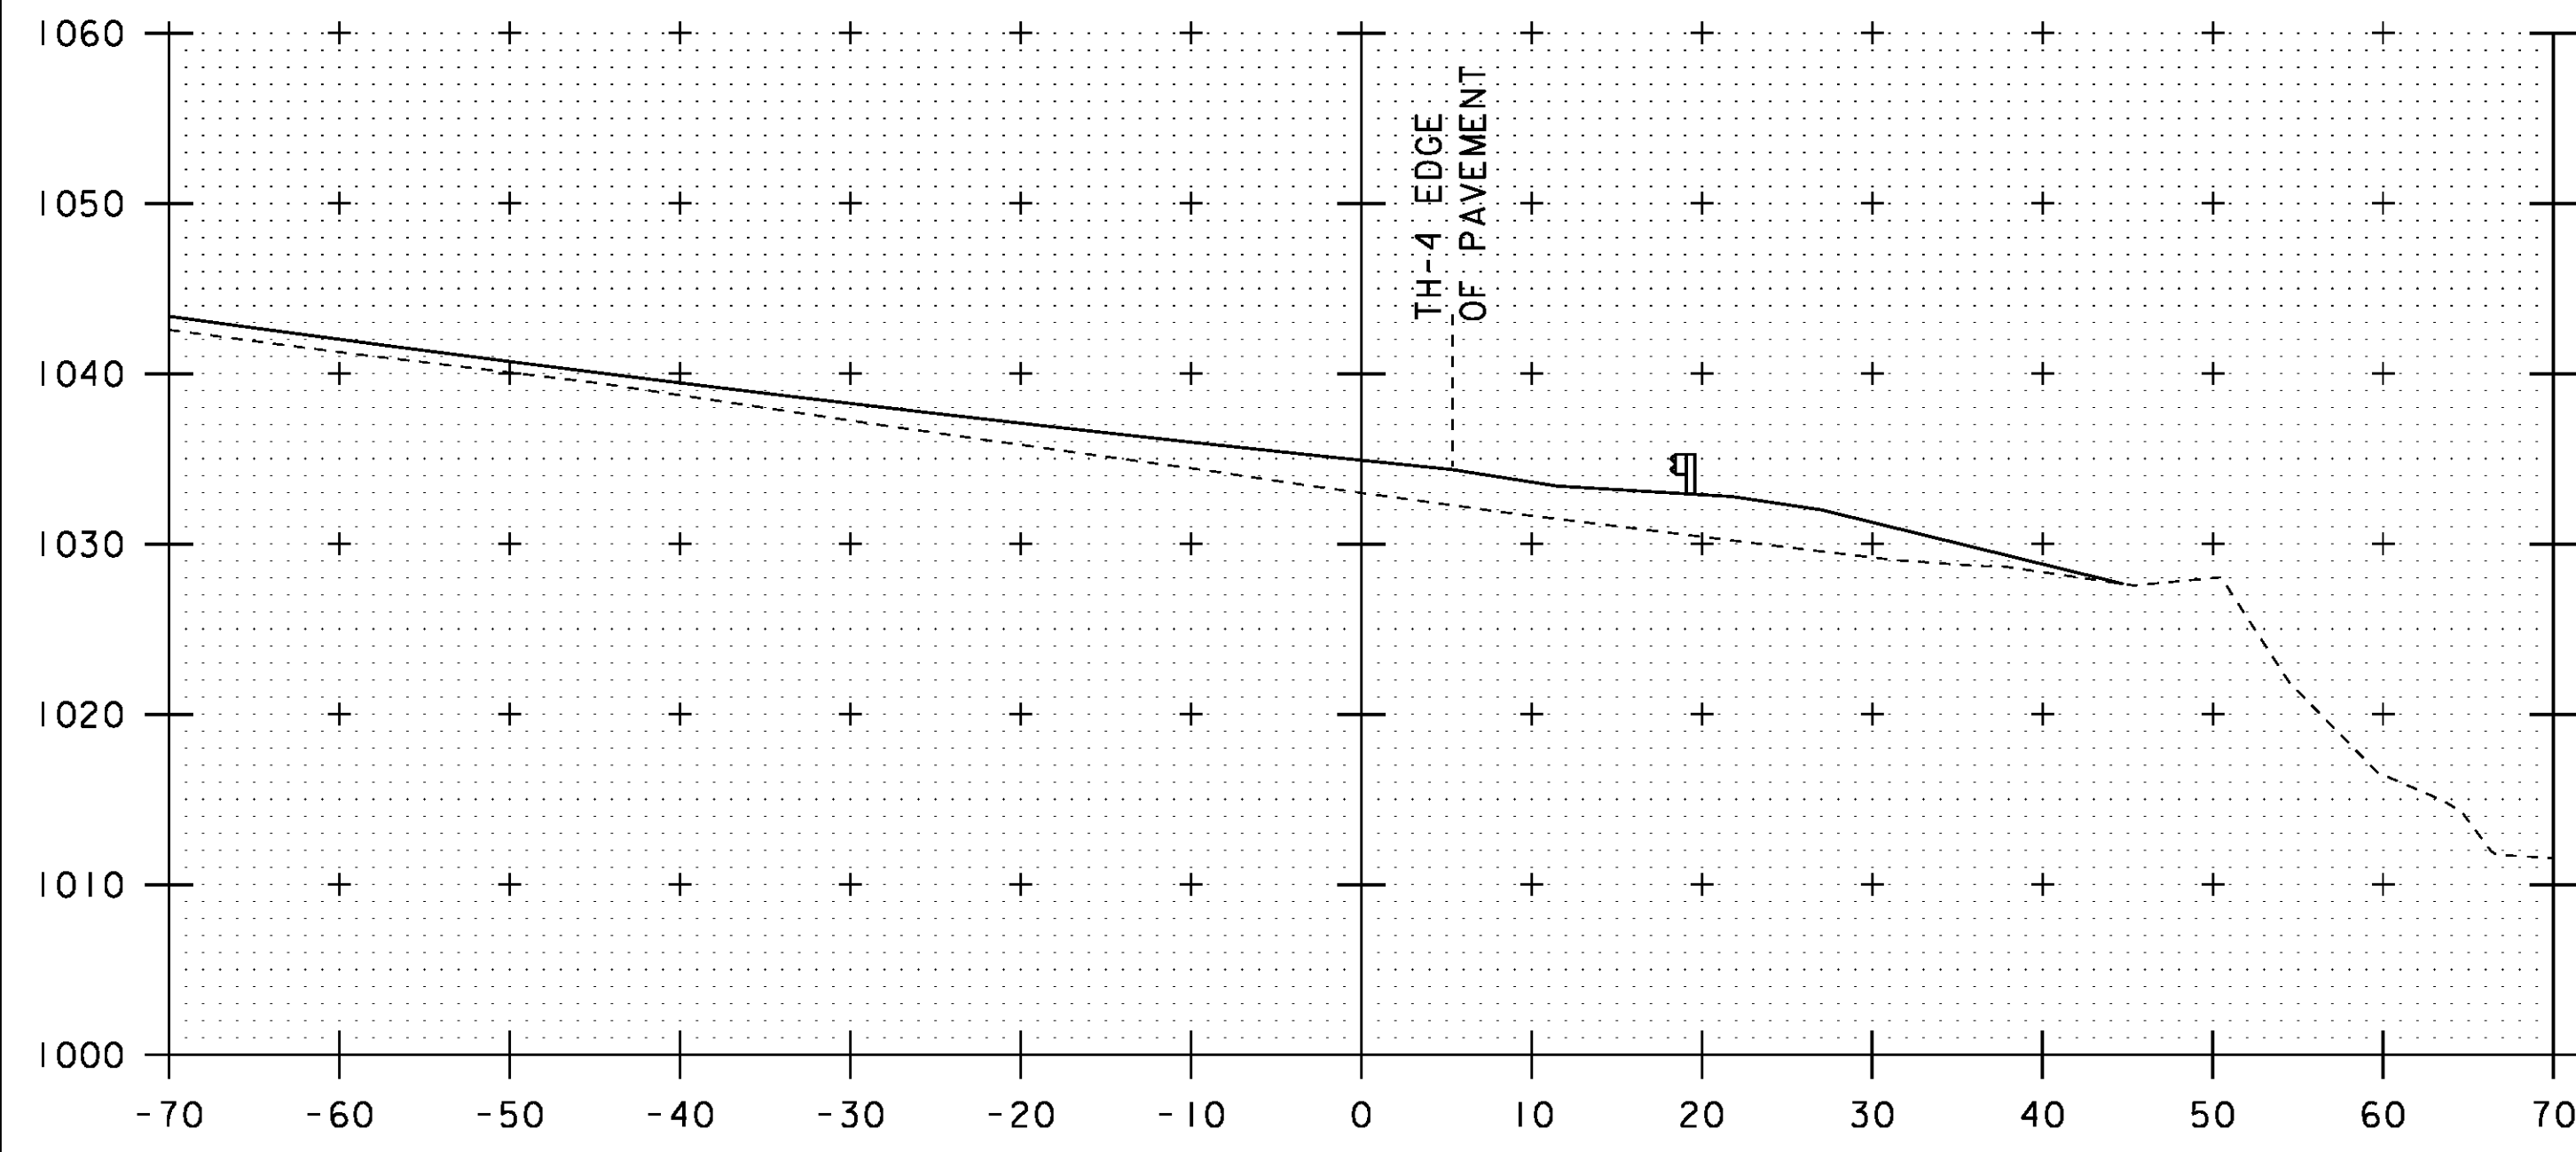

I+10

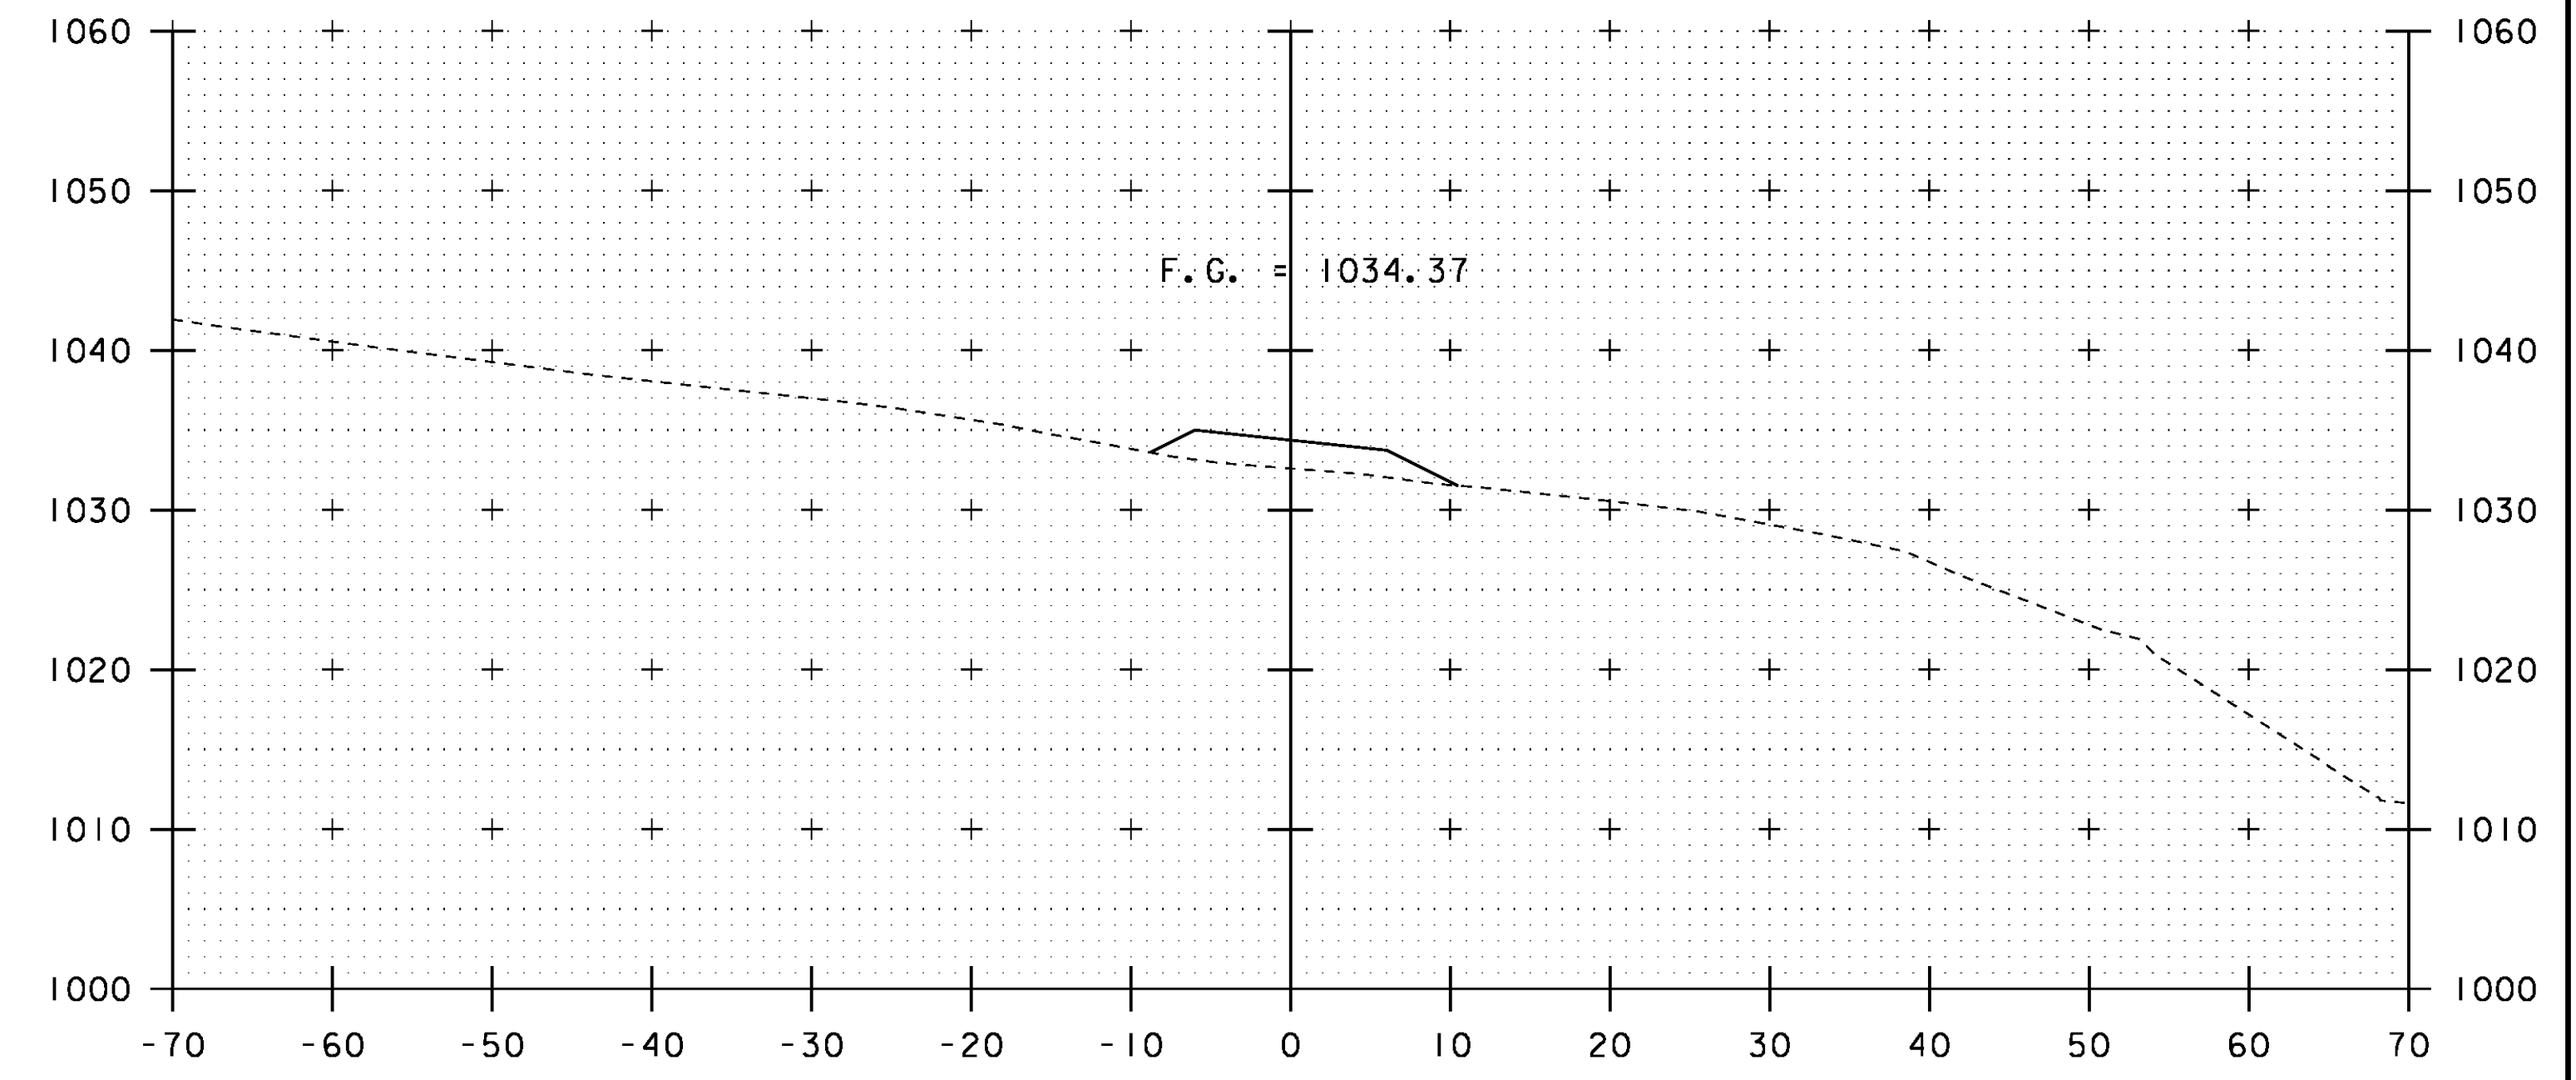

I+30

STA. I+10 TO STA. I+40

PROJECT NAME:	CRAFTSBURY	PLOT DATE:	14-OCT-2015
PROJECT NUMBER:	BO 1449(34)	DRAWN BY:	S. COLEY
FILE NAME:	sl3j100xs.dgn	DESIGNED BY:	W. LAMMER
PROJECT LEADER:	R. YOUNG	CHECKED BY:	W. LAMMER
DRIVE CROSS SECTIONS I		SHEET	34 OF 42